


BENTON IRRIGATION DISTRICT

IRRIGATION SYSTEM IMPROVEMENTS


PHASE I

2009

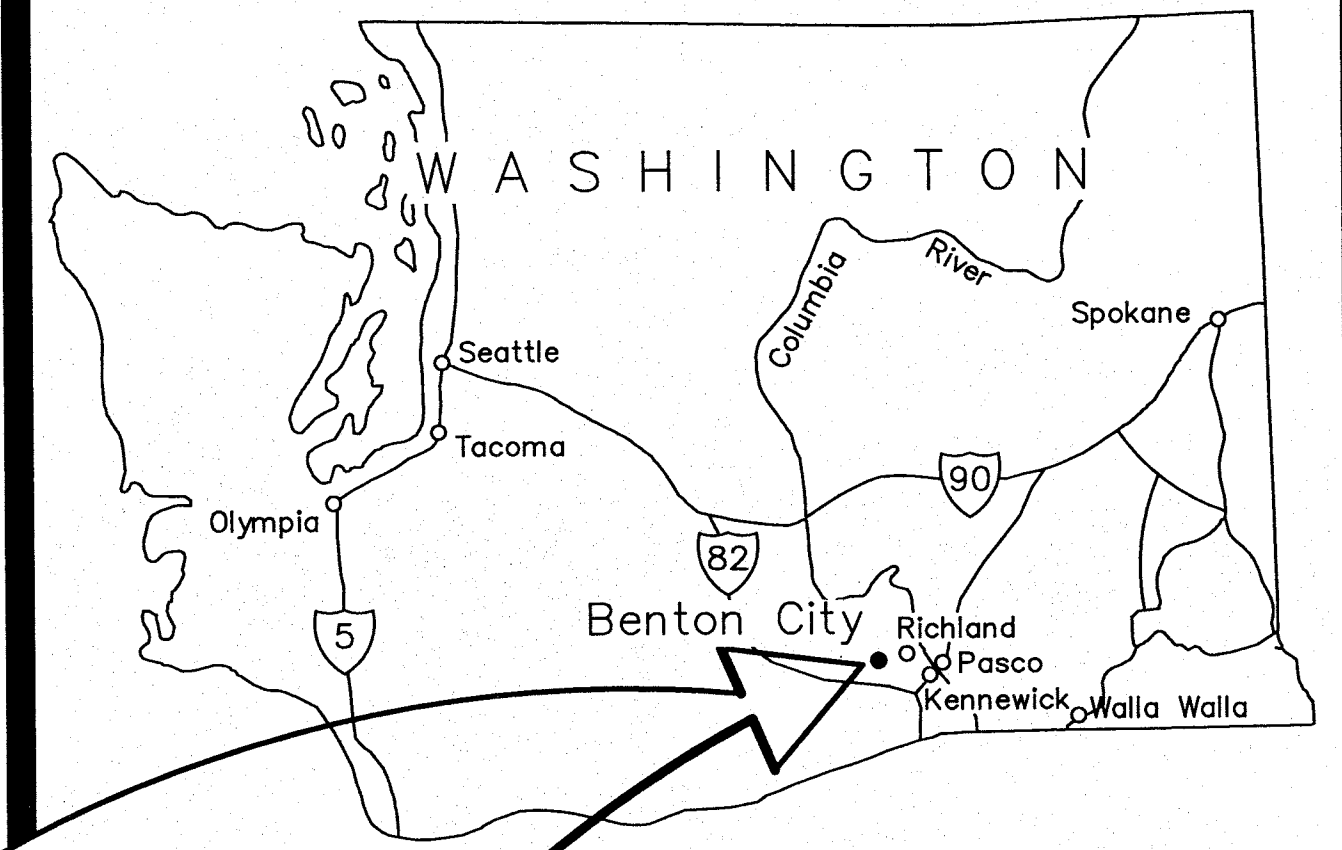


INDEX

<ul style="list-style-type: none"> — COVER 1 LEGEND, NOTES, AND QUANTITIES 2 SHEET INDEX 3 BID ALTERNATIVES PLAN WHAN ROAD PIPING 4 PLAN AND PROFILE - STA. 4+00 TO 8+00 5 PLAN AND PROFILE - STA. 8+00 TO 22+00 6 PLAN AND PROFILE - STA. 22+00 TO 36+00 7 PLAN AND PROFILE - STA. 36+00 TO 43+26 CORRAL CREEK ROAD PIPING 8 PLAN AND PROFILE - STA. 1+21 TO 15+00 9 PLAN AND PROFILE - STA. 15+00 TO 29+00 10 PLAN AND PROFILE - STA. 29+00 TO 42+39 EAST ROZA NORTH PIPING 11 PLAN AND PROFILE - STA. 1+00 TO 14+00 12 PLAN AND PROFILE - STA. 14+00 TO 27+00 13 PLAN AND PROFILE - STA. 27+00 TO 30+90 14 PLAN AND PROFILE - STA. 1+00 TO 4+85 15 PLAN AND PROFILE - STA. 1+00 TO 8+60 EAST ROZA ROAD PIPING 16 PLAN AND PROFILE - STA. 1+00 TO 15+50 17 PLAN AND PROFILE - STA. 15+50 TO 26+75 18 LINE II PLAN AND PROFILE - STA. 1+00 TO 7+20 WHITMORE STREET PIPING 19 PLAN AND PROFILE - STA. 1+00 TO 15+00 20 PLAN AND PROFILE - STA. 15+00 TO 24+86 116TH STREET PIPING 21 PLAN AND PROFILE - STA. 1+00 TO 10+26 114TH STREET PIPING 22 PLAN AND PROFILE - STA. 1+00 TO 15+00 23 PLAN AND PROFILE - STA. 15+00 TO 29+00 24 PLAN AND PROFILE - STA. 29+00 TO 35+61 25 PLAN AND PROFILE - STA. 1+00 TO 4+90 26 PLAN AND PROFILE - STA. 1+00 TO 5+15 108TH STREET PIPING 27 PLAN AND PROFILE - STA. 1+00 TO 13+00 28 PLAN AND PROFILE - STA. 13+00 TO 18+24 29 PLAN AND PROFILE - STA. 1+00 TO 4+50 WILLIAMS ROAD TO WHITMORE ROAD PIPING 30 PLAN AND PROFILE - STA. 1+40 TO 12+00 31 PLAN AND PROFILE - STA. 12+00 TO 21+00 32 PLAN AND PROFILE - STA. 21+00 TO 34+00 33 PLAN AND PROFILE - STA. 34+00 TO 48+00 34 PLAN AND PROFILE - STA. 48+00 TO 60+60 WHITMORE ROAD TO CORRAL CREEK ROAD PIPING 35 PLAN AND PROFILE - STA. 1+00 TO 7+00 36 PLAN AND PROFILE - STA. 7+00 TO 20+00 37 PLAN AND PROFILE - STA. 20+00 TO 31+35 464TH STREET PIPING 38 PLAN AND PROFILE - STA. 1+00 TO 10+94 EMPIRE DRIVE PIPING 39 PLAN AND PROFILE - STA. 1+00 TO 11+48 	<ul style="list-style-type: none"> WEST MAIN LINE 40 PLAN AND PROFILE - STA. 28+00 TO 41+00 41 PLAN AND PROFILE - STA. 41+00 TO 55+00 42 PLAN AND PROFILE - STA. 55+00 TO 68+00 43 CROSS SECTIONS HIGHLAND EXTENSION ROAD PIPING 44 PLAN AND PROFILE - STA. 1+00 TO 14+00 45 PLAN AND PROFILE - STA. 14+00 TO 26+00 46 PLAN AND PROFILE - STA. 26+00 TO 39+00 47 PLAN AND PROFILE - STA. 39+00 TO 52+00 48 PLAN AND PROFILE - STA. 52+00 TO 65+28 49 PLAN AND PROFILE - STA. 1+00 TO 5+00 50 PLAN AND PROFILE - STA. 1+00 TO 14+00 CORRAL CREEK (EAST) ROAD PIPING 51 PLAN AND PROFILE - STA. 1+00 TO 14+42 WHAN ROAD TO EVERT ROAD PIPING 52 PLAN AND PROFILE - STA. 1+00 TO 11+00 53 PLAN AND PROFILE - STA. 11+00 TO 22+00 54 PLAN AND PROFILE - STA. 22+00 TO 30+00 55 PLAN AND PROFILE - STA. 30+00 TO 40+00 56 PLAN AND PROFILE - STA. 40+00 TO 51+59 57 PLAN AND PROFILE - STA. 1+26 TO 11+00 58 PLAN AND PROFILE - STA. 11+00 TO 17+21 59 PLAN AND PROFILE - STA. 1+00 TO 5+00 60 PLAN AND PROFILE - STA. 1+00 TO 8+30 61 PLAN AND PROFILE - STA. 1+50 TO 5+46 62 PLAN AND PROFILE - STA. 0+98 TO 8+28 DAVIS ROAD TO EVERT ROAD PIPING 63 PLAN AND PROFILE - STA. 0+51 TO 15+00 64 PLAN AND PROFILE - STA. 15+00 TO 27+00 65 PLAN AND PROFILE - STA. 27+00 TO 40+00 66 PLAN AND PROFILE - STA. 40+00 TO 48+71 67 PLAN AND PROFILE - STA. 1+00 TO 9+13 WILLIAMS ROAD PIPING 68 PLAN AND PROFILE - STA. 1+00 TO 14+00 69 PLAN AND PROFILE - STA. 14+00 TO 28+00 70 PLAN AND PROFILE - STA. 28+00 TO 41+35 WILLIAMS ROAD SOUTH PIPING 71 PLAN AND PROFILE - STA. 0+49 TO 15+00 72 PLAN AND PROFILE - STA. 15+00 TO 29+00 73 PLAN AND PROFILE - STA. 29+00 TO 39+15 74 PLAN AND PROFILE - STA. 1+00 TO 5+45 75 PLAN AND PROFILE - STA. 1+00 TO 5+75 HIGHLAND ROAD TO ACORD ROAD PIPING 76 PLAN AND PROFILE - STA. 1+00 TO 15+00 77 PLAN AND PROFILE - STA. 15+00 TO 29+00 78 PLAN AND PROFILE - STA. 29+00 TO 43+00 79 PLAN AND PROFILE - STA. 43+00 TO 57+00 80 PLAN AND PROFILE - STA. 57+00 TO 71+00 81 PLAN AND PROFILE - STA. 71+00 TO 85+00 82 PLAN AND PROFILE - STA. 85+00 TO 95+55 83 PLAN AND PROFILE - STA. 1+00 TO 7+80 84 PLAN AND PROFILE - STA. 1+00 TO 5+25 85 PLAN AND PROFILE - STA. 1+00 TO 8+95 86 PLAN AND PROFILE - STA. 1+00 TO 6+10 87 PLAN AND PROFILE - STA. 1+00 TO 7+75 88 PLAN AND PROFILE - STA. 1+00 TO 10+00 	<ul style="list-style-type: none"> HIGHLAND ROAD TO ACORD ROAD PIPING (CONT.) 88 PLAN AND PROFILE - STA. 1+00 TO 10+00 89 PLAN AND PROFILE - STA. 10+00 TO 16+55 90 PLAN AND PROFILE - STA. 1+00 TO 6+00 91 PLAN AND PROFILE - STA. 6+00 TO 18+50 92 PLAN AND PROFILE - STA. 1+00 TO 9+30 HIGHLAND ROAD TO FRAZIER ROAD PIPING 93 PLAN AND PROFILE - STA. 1+00 TO 13+00 94 PLAN AND PROFILE - STA. 13+00 TO 20+17 EVERT ROAD TO HORNE ROAD PIPING 95 PLAN AND PROFILE - STA. 1+00 TO 15+00 96 PLAN AND PROFILE - STA. 15+00 TO 30+00 97 PLAN AND PROFILE - STA. 30+00 TO 45+00 98 PLAN AND PROFILE - STA. 45+00 TO 59+00 98A PLAN AND PROFILE - STA. 1+00 TO 7+55 99 PLAN AND PROFILE - STA. 59+00 TO 72+00 100 PLAN AND PROFILE - STA. 72+00 TO 84+00 101 PLAN AND PROFILE - STA. 84+00 TO 95+68 102 PLAN AND PROFILE - STA. 1+00 TO 12+15 103 PLAN AND PROFILE - STA. 1+00 TO 12+88 104 PLAN AND PROFILE - STA. 1+00 TO 14+65 105 PLAN AND PROFILE - STA. 1+00 TO 7+10 WAGONWHEEL TO MONTANA ROAD PIPING 106 PLAN AND PROFILE - STA. 1+00 TO 15+00 107 PLAN AND PROFILE - STA. 15+00 TO 25+00 107A PLAN AND PROFILE - STA. 1+00 TO 6+25 108 PLAN AND PROFILE - STA. 25+00 TO 31+00 SUNRISE ROAD PIPING 109 PLAN AND PROFILE - STA. 1+00 TO 10+12 WAGON WHEEL ROAD PIPING 110 PLAN AND PROFILE - STA. 1+00 TO 9+55 111 PLAN AND PROFILE - STA. 1+00 TO 4+95 DETAILS 112 PIPE CONNECTION DETAILS I 113 PIPE CONNECTION DETAILS II 114 PIPE CONNECTION DETAILS III 115 PIPE CONNECTION DETAILS IV 116 PIPE CONNECTION DETAILS V 117 SERVICE DETAILS I 118 SERVICE DETAILS II 118A SERVICE DETAILS III 118B SERVICE DETAILS IV 118C SERVICE DETAILS V 119 PRESSURE REDUCER VAULT DETAILS 119A PRV/FCV AND FCV STATIONS 119B PRV/FCV STATION DETAIL 119C PRV/FCV VAULT DETAIL 120 MISCELLANEOUS DETAILS I 121 MISCELLANEOUS DETAILS II 122 MISCELLANEOUS DETAILS III 123 MISCELLANEOUS DETAILS IV 124 MISCELLANEOUS DETAILS V 125 FLOWMETER DETAILS 126 CORRAL CREEK CROSSING DETAILS 127 TRENCH DETAILS 128 THRUST BLOCK DETAILS
--	---	---

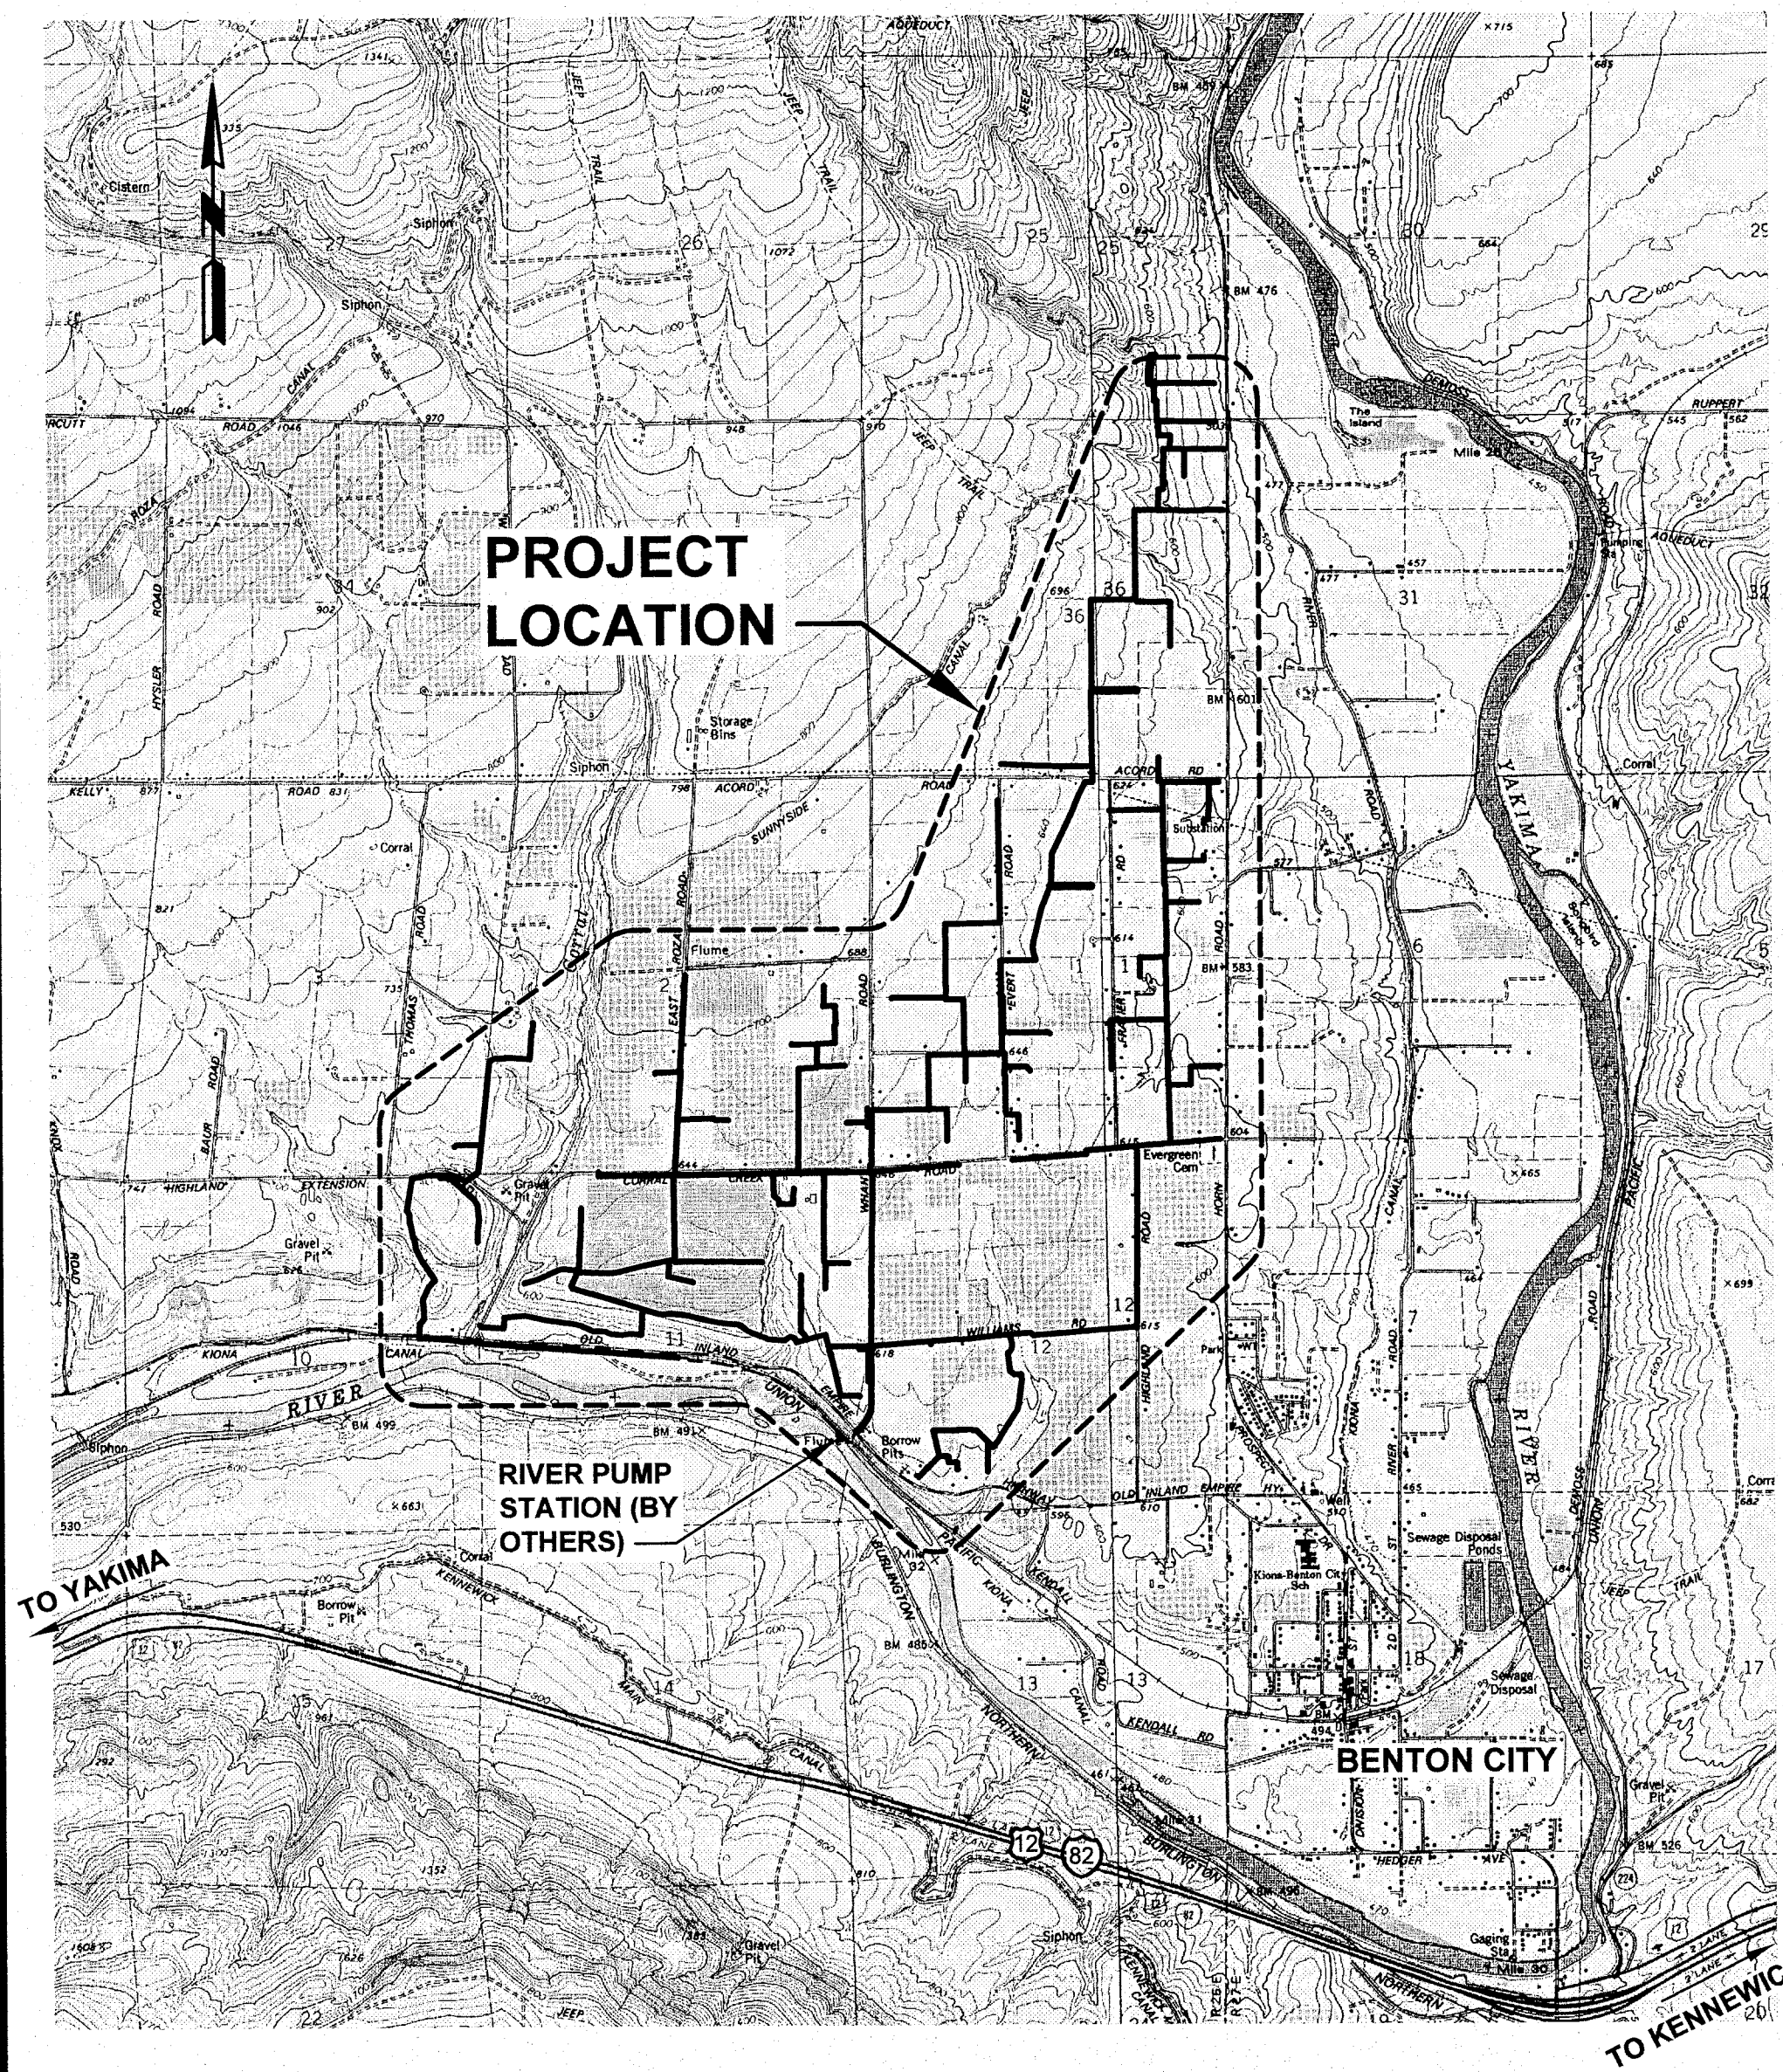

VICINITY MAP
NTS

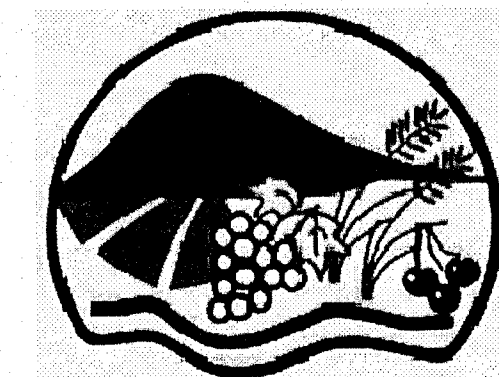


DISTRICT BOARD OF DIRECTORS

TONYA GARBERG
SHAWN GAY
ROBERT BUOY

RECORD DRAWINGS

These record drawings have been prepared, in part, on the basis of information compiled and furnished by others. They may contain some discrepancies and omissions, and do not necessarily represent "exact" field conditions. The Owner and the Engineer accept no responsibility for their accuracy.

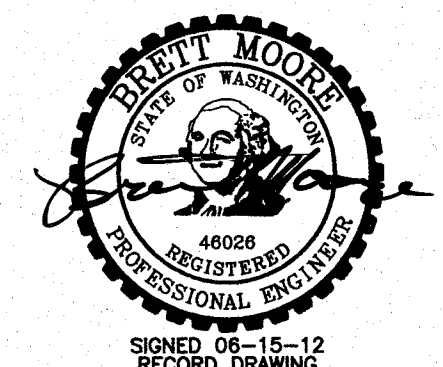

ap anderson perry & associates, inc.
engineering • surveying • natural resources
1901 N. Fir Street - La Grande, OR 97850 Ph: (541)963-8309 Fax: (541)963-5456
LA GRANDE, OR WALLA WALLA, WA

PLAN LEGEND


IRRIGATION

EXISTING		PROPOSED	
IRRIGATION LINE	IRR	6" PVC	
VALVE	⊠	⊠	
CAP	⌈	⌈	
COUPLING	⊕	⊕	
REDUCER	▷	▷	
AIR/VAC VALVE	↑	↑	
BLOW OFF ASSEMBLY		⊙	
SERVICE		⊙	
IRRIGATION CONTROL STRUCTURE	IRR	IRR	
SPRINKLER HEAD	☀		

SITE SURVEY

EXISTING	
INDEX CONTOUR	750
INTERMEDIATE CONTOUR	749
PROPERTY LINE/ RIGHT-OF-WAY	---
CENTERLINE	---
EASEMENT	---
SECTION LINE	---
CULVERT	---
BENCH MARK	⊙
MONUMENT	△
CONTROL POINT	⊙
TEST PIT (SEE CONTRACT DOCUMENT APPENDIX FOR LOGS)	⊙
SPOT ELEVATION	592.3 X

DRAFTING

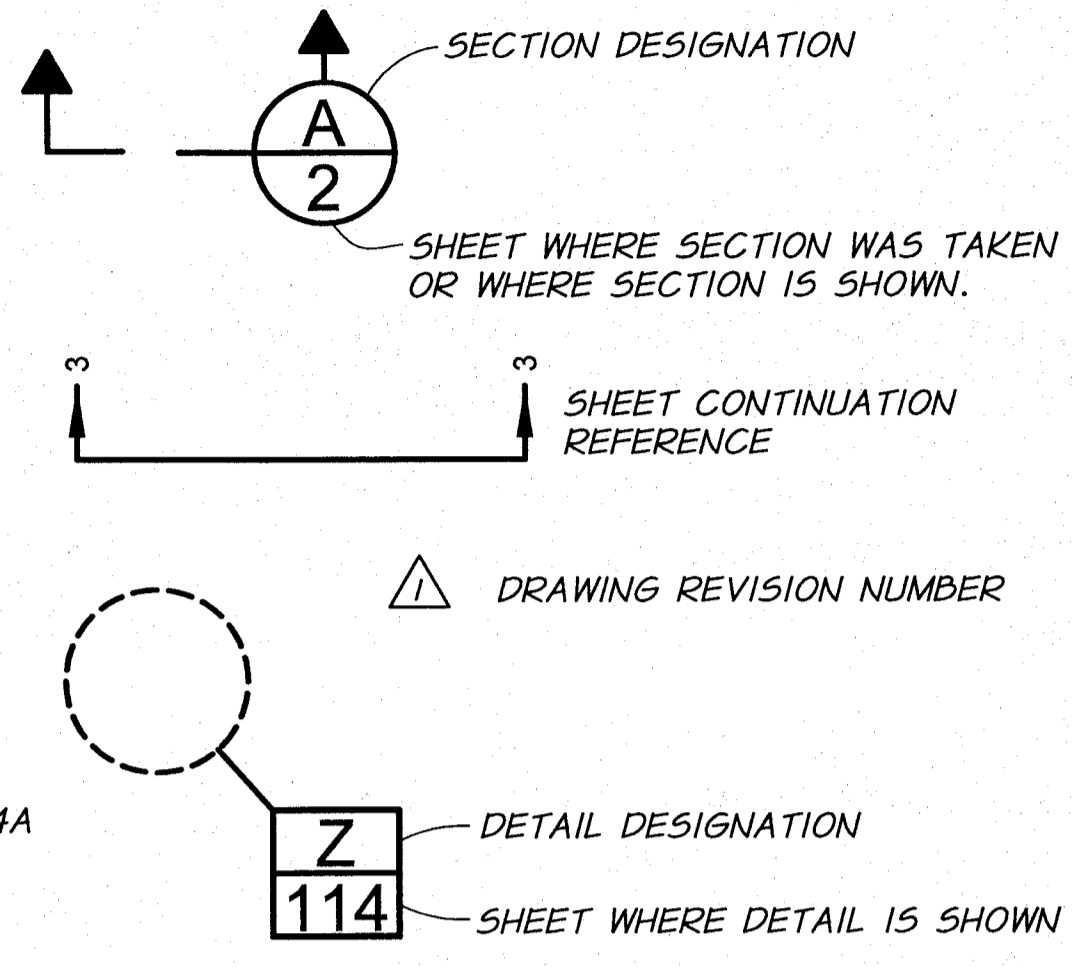


MISCELLANEOUS UTILITIES

EXISTING	
WATER LINE	W
BURIED POWER	P
OVERHEAD POWER	OHP
BURIED TELEPHONE	UT
FIBER OPTIC	FO
GAS SERVICE	G
SIGNAL CABLE IN CONDUIT	SC
UTILITY POLE	⊙
GUY WIRE	—
TELEPHONE RISER	◇
STREET LIGHT	☀


GENERAL

EXISTING	
FENCE LINE/GATE	— X —
CHAINLINK FENCE	— ○ —
CREEK/DITCH CENTERLINE	---
RIVERBANK/ SHORELINE	---
SIGN	⊠
CONIFER TREE	⊙
DECIDUOUS TREE	⊙
SHRUB	⊙
BUILDING	⊠

STREET AND CURB

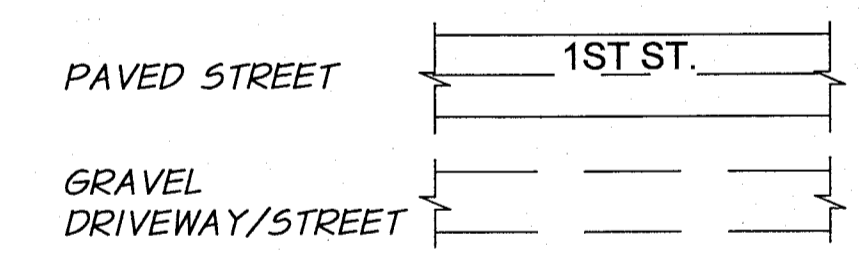

PROFILE LEGEND

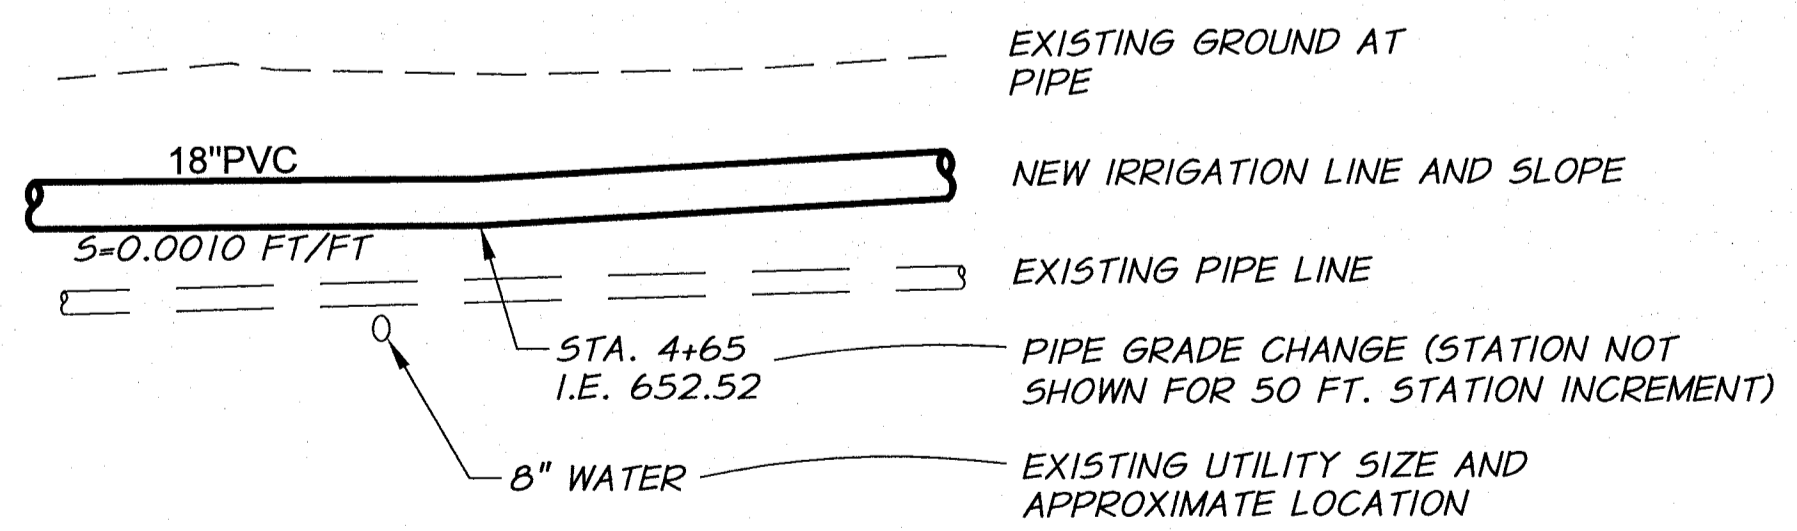

ESTIMATED QUANTITIES FOR ROCK EXCAVATION

BASE BID:	±650 CUBIC YARDS
ADDITIVE ALTERNATIVE A:	±2,200 CUBIC YARDS
ADDITIVE ALTERNATIVE B:	±2,000 CUBIC YARDS

NOTE: REFER TO THE SPECIFICATIONS FOR DESCRIPTION OF ROCK EXCAVATION. THE QUANTITIES SHOWN ARE ESTIMATES PREPARED BY THE ENGINEER AND ARE BASED UPON FIELD SURVEY DATA PERFORMED BY THE ENGINEER, AND THE IMPROVEMENTS SHOWN ON THE DRAWINGS. THE CONTRACTOR SHALL MAKE HIS OWN DETERMINATION OF THE ACTUAL QUANTITIES TO COMPLETE THE WORK AS SHOWN ON THE DRAWINGS AND AS SPECIFIED FOR PREPARING HIS BID FOR THE PROJECT. ~~NO MEASUREMENT WILL BE MADE FOR ROCK EXCAVATION. ROCK EXCAVATION WILL BE PAID FOR UNDER A LUMP SUM BID ITEM.~~

TEST PIT NOTES

- THE TEST PIT LOCATIONS ARE SHOWN ON THE DRAWINGS AND THE TEST PIT LOGS ARE PROVIDED IN THE APPENDIX OF THE SPECIFICATIONS.
- THE SOIL DATA, ROCK DATA, AND GROUND WATER CONDITIONS WHEN SHOWN ON THE DRAWINGS AND LOGS ARE PROVIDED SOLELY FOR THE CONTRACTOR'S INFORMATION. SUCH DATA IS NOT GUARANTEED AS TO ACCURACY OR COMPLETENESS WITH RESPECT TO THE ACTUAL SUBSURFACE CONDITIONS. INFORMATION SHOWN SHALL NOT RELIEVE THE CONTRACTOR FROM MAKING SUCH ADDITIONAL INVESTIGATIONS AS HE MAY ELECT TO FAMILIARIZE HIMSELF WITH THE ACTUAL CONDITIONS TO BE ENCOUNTERED IN EXECUTING THE WORK AND PREPARING HIS BID FOR THE PROJECT.


CONSTRUCTION NOTES

- ALL ASPHALT RESTORATION REQUIRED OUTSIDE OF AREAS SPECIFIED SHALL BE COMPLETED AT THE CONTRACTOR'S EXPENSE AND AT NO COST TO THE OWNER.
- REMOVE EXISTING DRAINAGE CULVERTS TO CONSTRUCT IRRIGATION LINE. EXISTING CULVERTS TO BE REINSTALLED AFTER PIPELINE INSTALLATION IS COMPLETED. CULVERTS DAMAGED BY CONSTRUCTION TO BE REPLACED WITH NEW SAME TYPE AND SIZE AT CONTRACTOR'S EXPENSE AND AT NO COST TO THE OWNER UNLESS THE CULVERT AGE AND CONDITION ENSUED THE DAMAGE AS DETERMINED BY THE ENGINEER. THE ENGINEER MAY REQUIRE REPLACEMENT OF CULVERTS DUE TO AGE OF CULVERT AND EXISTING CONDITION. REPLACEMENT REQUIRED BY THE ENGINEER SHALL BE PAID UNDER THE "CULVERT REPLACEMENT" BID ITEM AND MUST HAVE PRIOR APPROVAL BEFORE REPLACEMENT.
- MAILBOXES, SIGNS, ETC., IN CONFLICT WITH WORK SHALL BE TEMPORARILY RELOCATED, AS REQUIRED BY THE ENGINEER, AND REINSTALLED TO THE ORIGINAL LOCATION AFTER THE IRRIGATION LINE IS CONSTRUCTED, UNLESS OTHERWISE DIRECTED BY THE ENGINEER. DAMAGED MAILBOXES, SIGNS, POSTS, ETC., CAUSED BY THE CONSTRUCTION SHALL BE REPLACED WITH NEW LIKE KIND AS REQUIRED BY THE ENGINEER AT THE CONTRACTOR'S EXPENSE AND AT NO COST TO THE OWNER UNLESS THE AGE AND CONDITION ENSUED THE DAMAGE AS DETERMINED BY THE ENGINEER. THE ENGINEER MAY REQUIRE REPLACEMENT OF POST DUE TO AGE OF POST AND EXISTING CONDITION. REPLACEMENT REQUIRED BY THE ENGINEER SHALL BE PAID UNDER THE "POST REPLACEMENT" BID ITEM.
- REMOVE EXISTING FENCING TO CONSTRUCT IRRIGATION LINES AS REQUIRED. EXISTING FENCING TO BE REINSTALLED TO THE SATISFACTION OF THE PROPERTY OWNERS AFTER PIPELINE INSTALLATION IS COMPLETED. FENCING DAMAGED BY CONSTRUCTION TO BE REPLACED WITH NEW SAME TYPE AND SIZE TO THE SATISFACTION OF THE PROPERTY OWNERS AT CONTRACTOR'S EXPENSE AND AT NO COST TO THE OWNER.
- LOCATION FOR ALL SERVICES, AIR/VAC VALVES AND BLOW OFF ASSEMBLIES TO BE FIELD VERIFIED WITH THE ENGINEER PRIOR TO CONSTRUCTION.
- FOR IRRIGATION LINE CONSTRUCTION DIRECTLY ADJACENT TO ORCHARDS, THE CONTRACTOR SHALL PROTECT ORCHARD LIMBS FROM DAMAGE AS REQUIRED DURING CONSTRUCTION. COMPENSATION FOR DAMAGED TREES AND/OR LIMBS CAUSED BY THE CONTRACTOR SHALL BE AT THE CONTRACTOR'S EXPENSE AND AT NO COST TO THE OWNER. SEE TECHNICAL SPECIFICATION FOR DETAIL.
- VERIZON UNDERGROUND FIBER OPTIC LINES ARE LOCATED WITHIN THE PROJECT. THE CONTRACTOR SHALL COORDINATE HIS WORK WITH VERIZON PRIOR TO CONSTRUCTION. FOR NEW IRRIGATION LINES THAT WILL CROSS FIBER OPTIC LINES, THE NEW IRRIGATION LINES SHALL BE INSTALLED UNDERNEATH THE FIBER OPTIC LINES, MAINTAINING A MINIMUM OF 12 INCHES CLEARANCE. ADJUSTMENTS TO THE IRRIGATION LINE VERTICAL GRADE MAY BE REQUIRED, INCLUDING FITTINGS AS REQUIRED. THIS ADJUSTMENT SHALL BE INCIDENTAL TO THE WORK.
- EXISTING GROUND ELEVATIONS SHOWN ON THE PROFILES ARE APPROXIMATE AND MAY VARY FROM ACTUAL EXISTING GROUND ELEVATIONS ENCOUNTERED DURING CONSTRUCTION. THERE SHALL BE NO ADDITIONAL PAYMENT MADE TO THE CONTRACTOR FOR EXCAVATION AND BACKFILL VARIATIONS CAUSED BY ELEVATION OF EXISTING GROUND DIFFERENCES FROM WHAT IS SHOWN ON THE DRAWINGS.
- BOTH HORIZONTAL DEFLECTIONS AND CHANGES OF VERTICAL GRADE ARE SHOWN ON THE DRAWINGS. IN SOME LOCATIONS FITTINGS ARE CALLED FOR ON THE DRAWINGS AT HORIZONTAL DEFLECTIONS AND CHANGES IN VERTICAL GRADE, BUT NOT AT ALL LOCATIONS THAT MAY REQUIRE FITTINGS. IF PIPE JOINT DEFLECTION OR BENDING THE PIPE AS DESCRIBED AND ALLOWED IN THE TECHNICAL SPECIFICATIONS DOES NOT MAINTAIN ALIGNMENT OR GRADE, FITTINGS SHALL BE USED WITH APPROPRIATE THRUST BLOCKING AND SHALL BE INCIDENTAL TO THE PIPELINE WORK. ADDITIONALLY, THE CONTRACTOR SHALL MAINTAIN THE 2.5-FOOT MINIMUM COVER OVER THE TOP OF PIPE DURING CONSTRUCTION.
- THE CONTRACTOR SHALL PERFORM EXPLORATORY WORK PRIOR TO CONSTRUCTION INCLUDING POTHOLING OF UTILITIES SUCH AS TELEPHONE, FIBER OPTIC, ELECTRICAL, WATER, ETC., AND IRRIGATION MAINS AND SERVICE LINES THAT LAY ADJACENT TO OR CROSS THE IMPROVEMENTS TO BE CONSTRUCTED. THIS WORK SHALL BE PERFORMED IN ORDER TO ACCURATELY LOCATE AND DETERMINE SIZES OF THE LINES AND TO DETERMINE ANY CONFLICTS THAT MAY EXIST THAT WILL REQUIRE ADJUSTMENT OF UTILITIES, COORDINATION WITH UTILITIES, OR ADJUSTMENT OF IMPROVEMENTS. SEE THE TECHNICAL SPECIFICATIONS FOR ADDITIONAL DETAILS. PAYMENT FOR EXPLORATORY WORK SHALL BE PAID UNDER THE BID ITEM "POTHOLING."
- THRUST BLOCKING REQUIRED FOR ALL TEES AND ELBOWS 11-1/4 DEGREES OR GREATER FOR PIPE SIZES 3-INCH OR GREATER.
- INSTALL MARKER POST AT END OF LINE FOR THE BASE BID TO BE CONNECTED TO ADDITIVE ALTERNATIVE A AND END OF LINE FOR ADDITIVE ALTERNATIVE B TO BE CONNECTED TO ADDITIVE ALTERNATIVE B. WORK SHALL BE INCIDENTAL TO THE PIPELINE WORK.
- THE CONTRACTOR'S WORK SHALL BE LIMITED TO THE WIDTH OF THE IRRIGATION EASEMENT PLUS ANY ADDITIONAL TEMPORARY EASEMENT PROVIDED AND COUNTY ROAD RIGHT-OF-WAY AS SPECIFIED IN THE TECHNICAL SPECIFICATIONS. SEE THE TECHNICAL SPECIFICATIONS FOR DETAILS.
- SMUDGE POTS ARE TO BE MOVED BY PROPERTY OWNERS.



RECORD DRAWING		E.H.	12/11
DESIGNED BY	R. HARRIS	XREFS:	TB-BID.dwg
DRAWN BY	D. CHRISTMAN	ACAD FILE:	LEGEND-ConvSys.dwg
REVIEWED BY	H. PERRY	COPYRIGHT 2009 BY ANDERSON-PERRY & ASSOC., INC.	



RECORD DRAWINGS
These record drawings have been prepared, in part, on the basis of information compiled and furnished by others. They may contain some discrepancies and omissions, and do not necessarily represent "exact" field conditions. The Owner and the Engineer accept no responsibility for their accuracy.

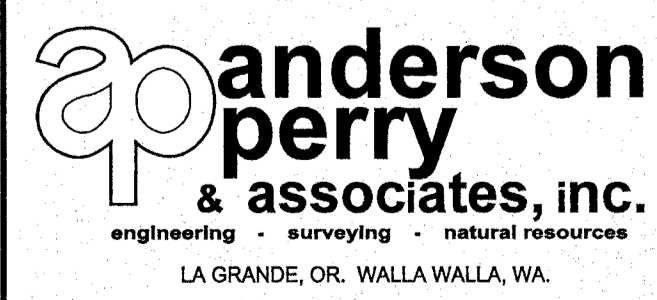

BENTON IRRIGATION DISTRICT
IRRIGATION SYSTEM IMPROVEMENTS
PHASE I
LEGEND, NOTES, AND QUANTITIES

SHEET
1

ARCHIVED

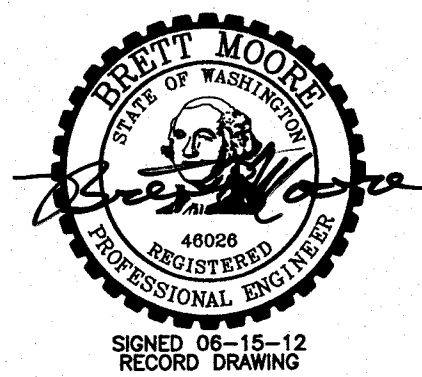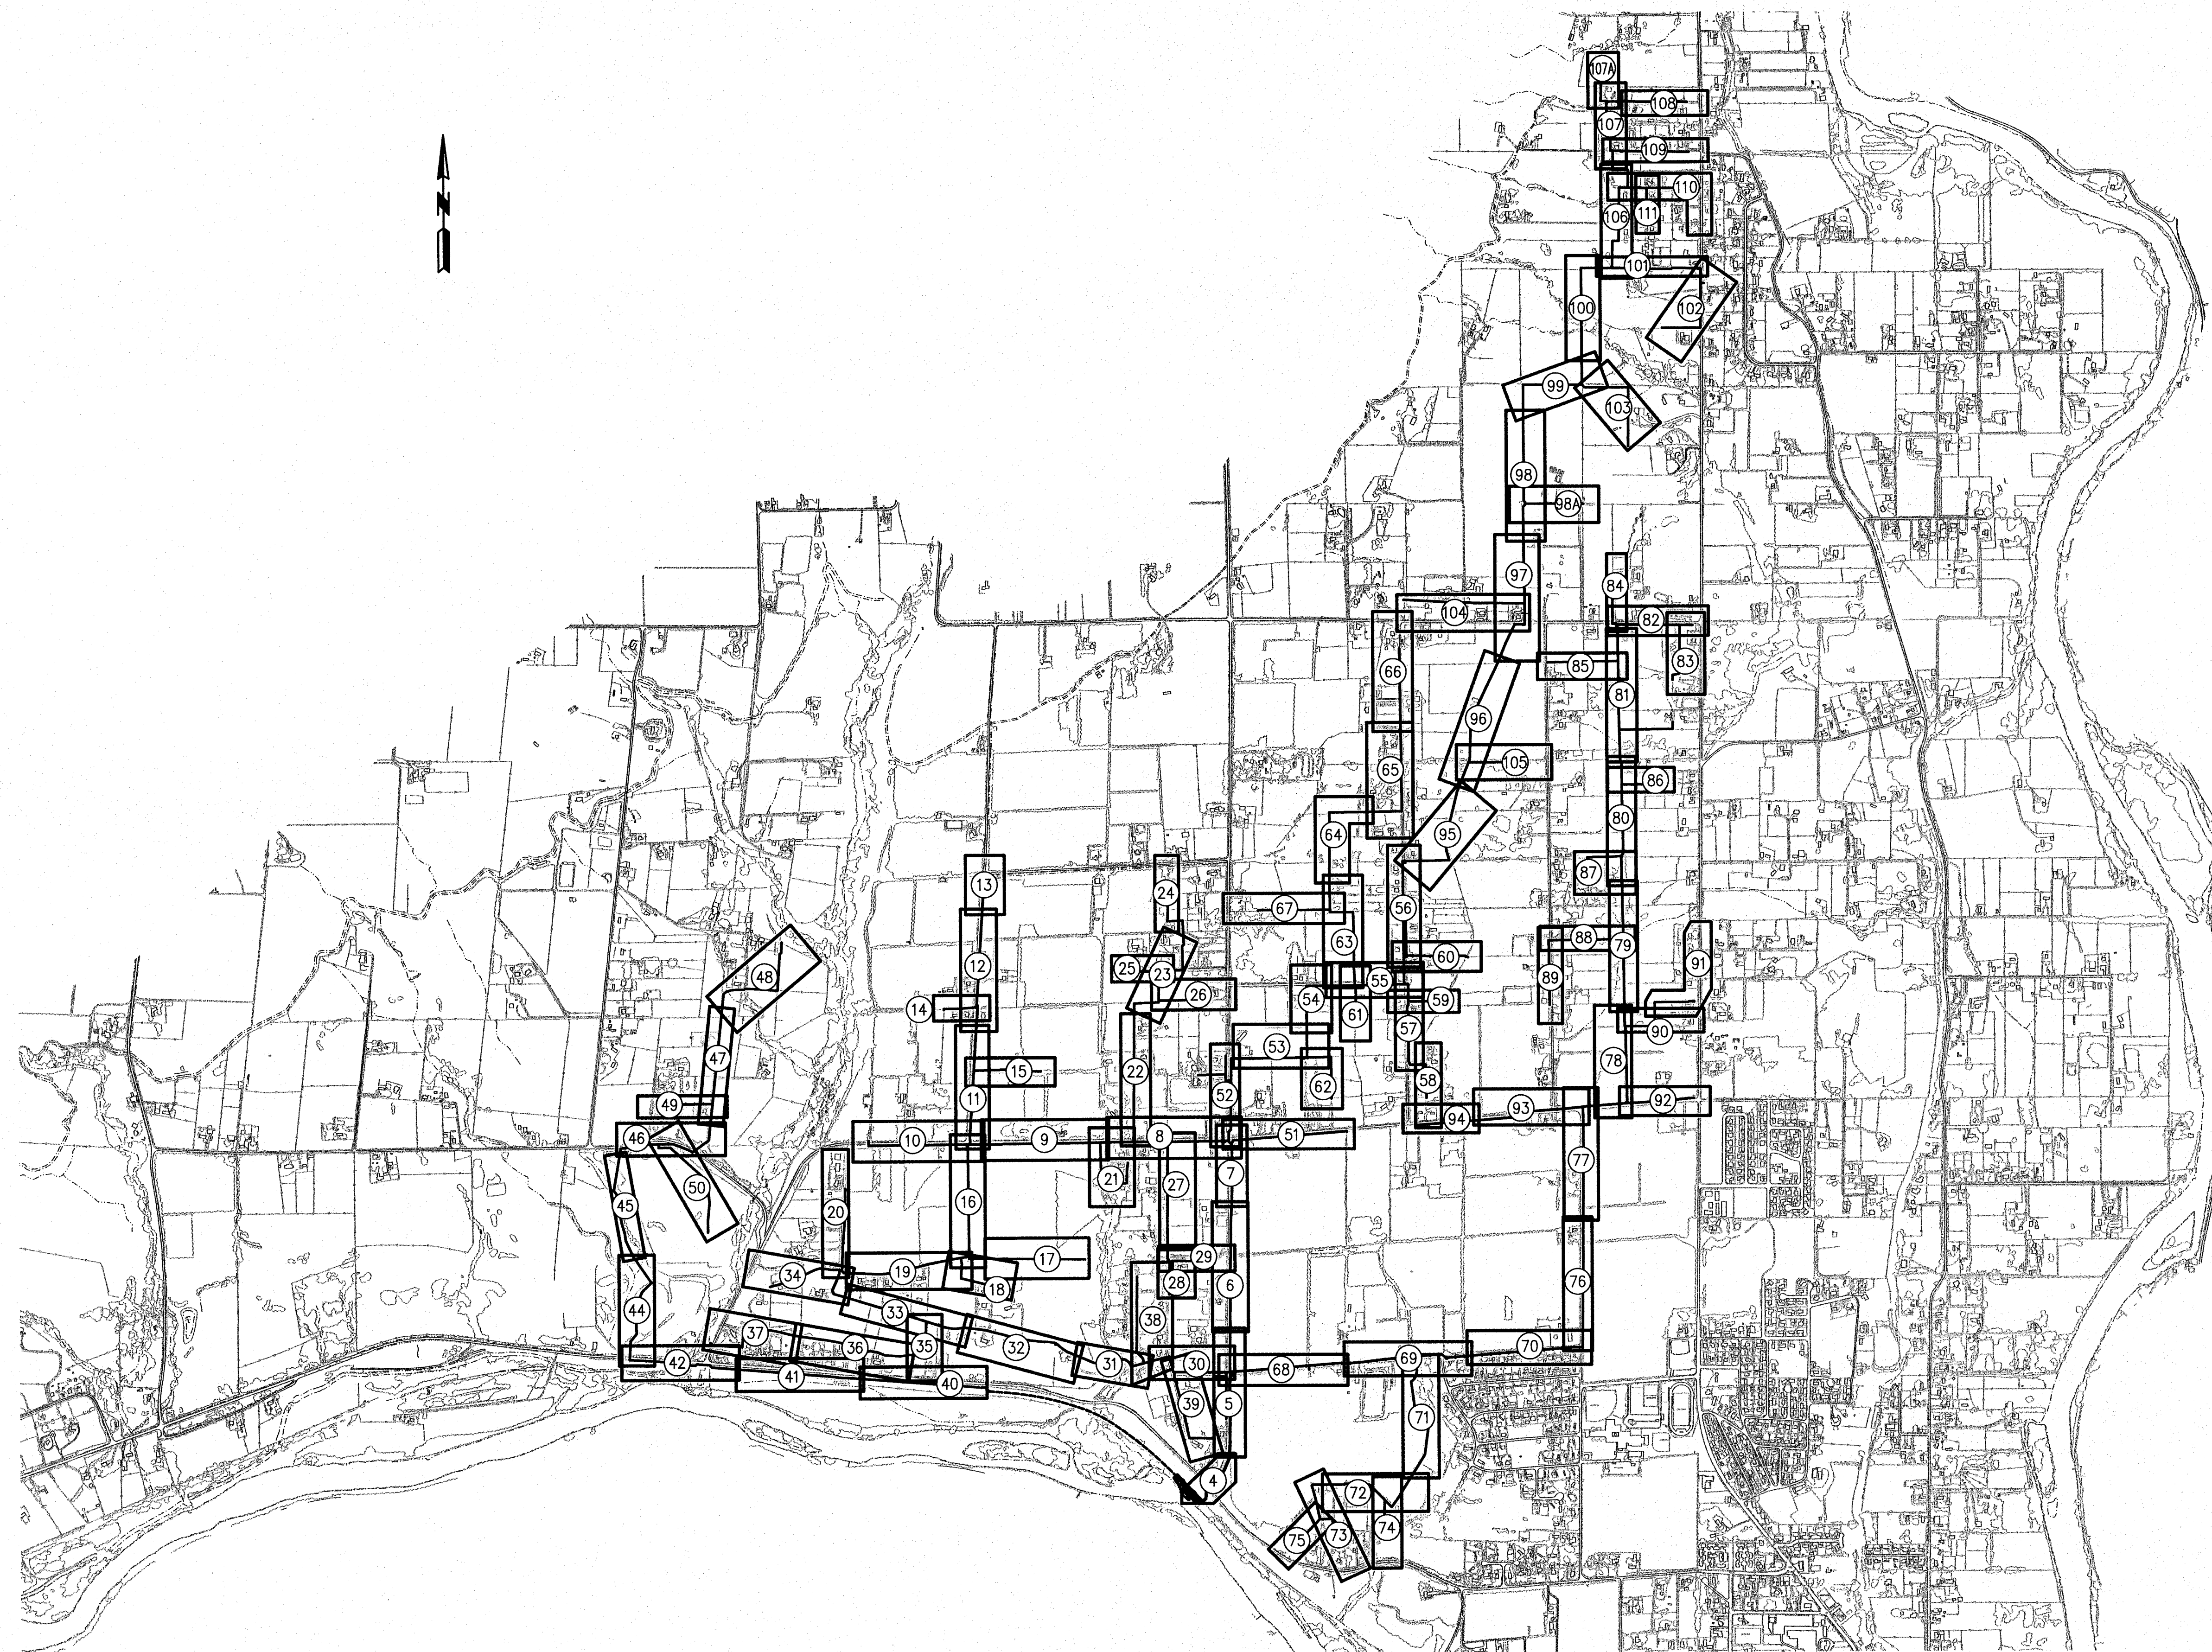


REVISION	BY	DATE
DESIGNED BY <i>R. HARRIS</i>	XREFS: TB-BID.dwg	
DRAWN BY <i>D. CHRISTMAN</i>		
REVIEWED BY <i>H. PERRY</i>		

<p>SCALE IN FEET</p>	
HORIZ. SCALE 1"=1000'	VERT. SCALE
JOB NUMBER 1199-336	DATE 2009
ACAD FILE SheetIndex.dwg	
COPYRIGHT 2009 BY ANDERSON-PERRY & ASSOC., INC.	

RECORD DRAWINGS

These record drawings have been prepared in part, on the basis of information compiled and furnished by others. They may contain some discrepancies and omissions, and do not necessarily represent "exact" field conditions. The Owner and the Engineer accept no responsibility for their accuracy.

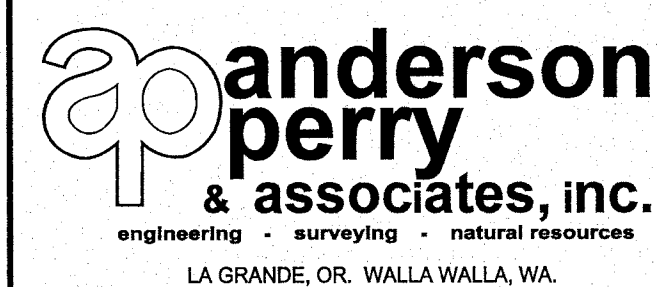

**BENTON IRRIGATION DISTRICT
IRRIGATION SYSTEM IMPROVEMENTS
PHASE I**




SHEET INDEX



SHEET

2



LEGEND


-  BASE BID PIPING
-  ADDITIVE ALTERNATIVE A PIPING
-  ADDITIVE ALTERNATIVE B PIPING

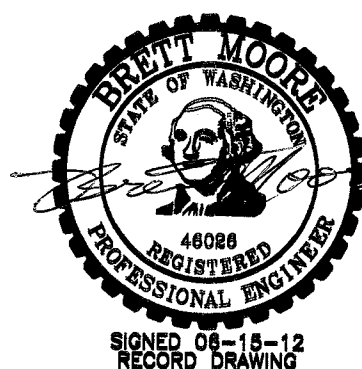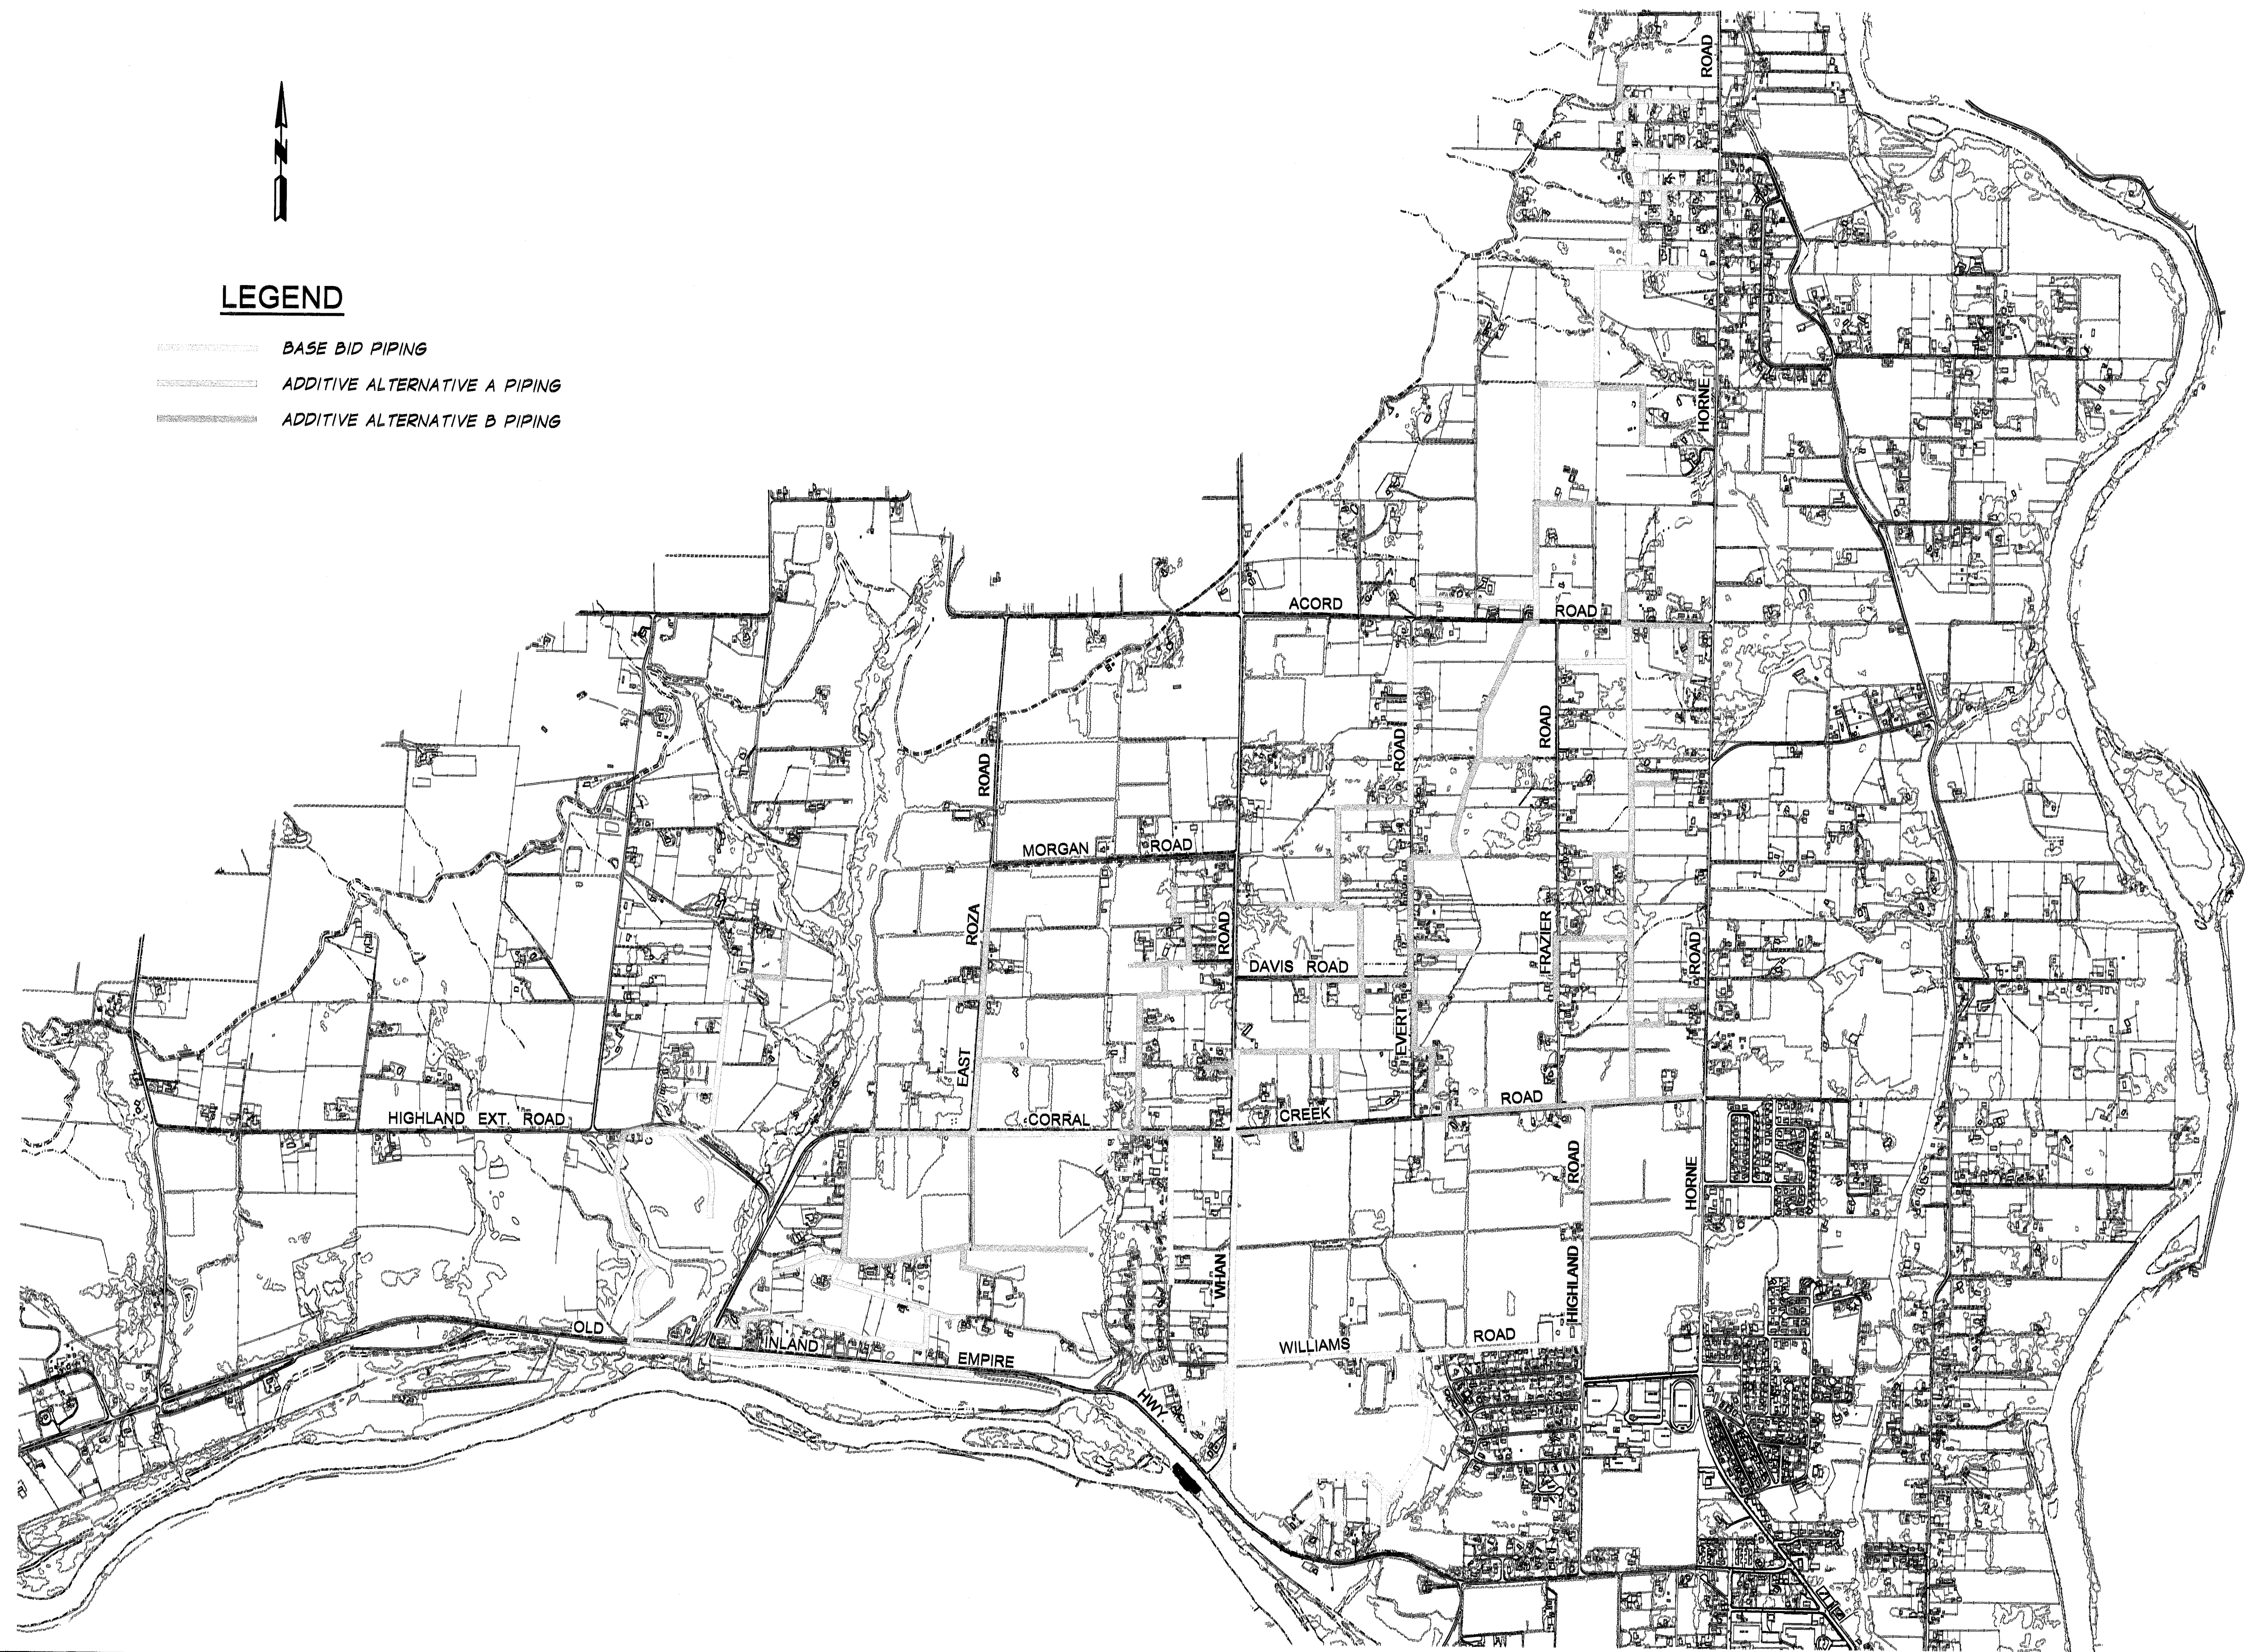

REVISION	BY	DATE
DESIGNED BY <i>R. HARRIS</i>	XREFS: TB-BID.dwg	
DRAWN BY <i>D. CHRISTMAN</i>		
REVIEWED BY <i>H. PERRY</i>		






1000 0 1000 2000 3000 SCALE IN FEET	
HORIZ. SCALE 1" = 1000'	VERT. SCALE
JOB NUMBER 1199-336	DATE 2009
ACAD FILE: BidAlternatives.dwg	
COPYRIGHT 2009 BY ANDERSON-PERRY & ASSOC., INC.	

RECORD DRAWINGS
 These record drawings have been prepared, in part, on the basis of information compiled and furnished by others. They may contain some discrepancies and omissions, and do not necessarily represent "exact" field conditions. The Owner and the Engineer accept no responsibility for their accuracy.

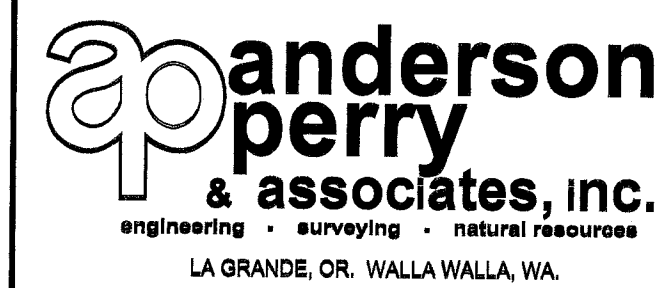







BENTON IRRIGATION DISTRICT
IRRIGATION SYSTEM IMPROVEMENTS
PHASE I
BID ALTERNATIVES PLAN

SHEET
3

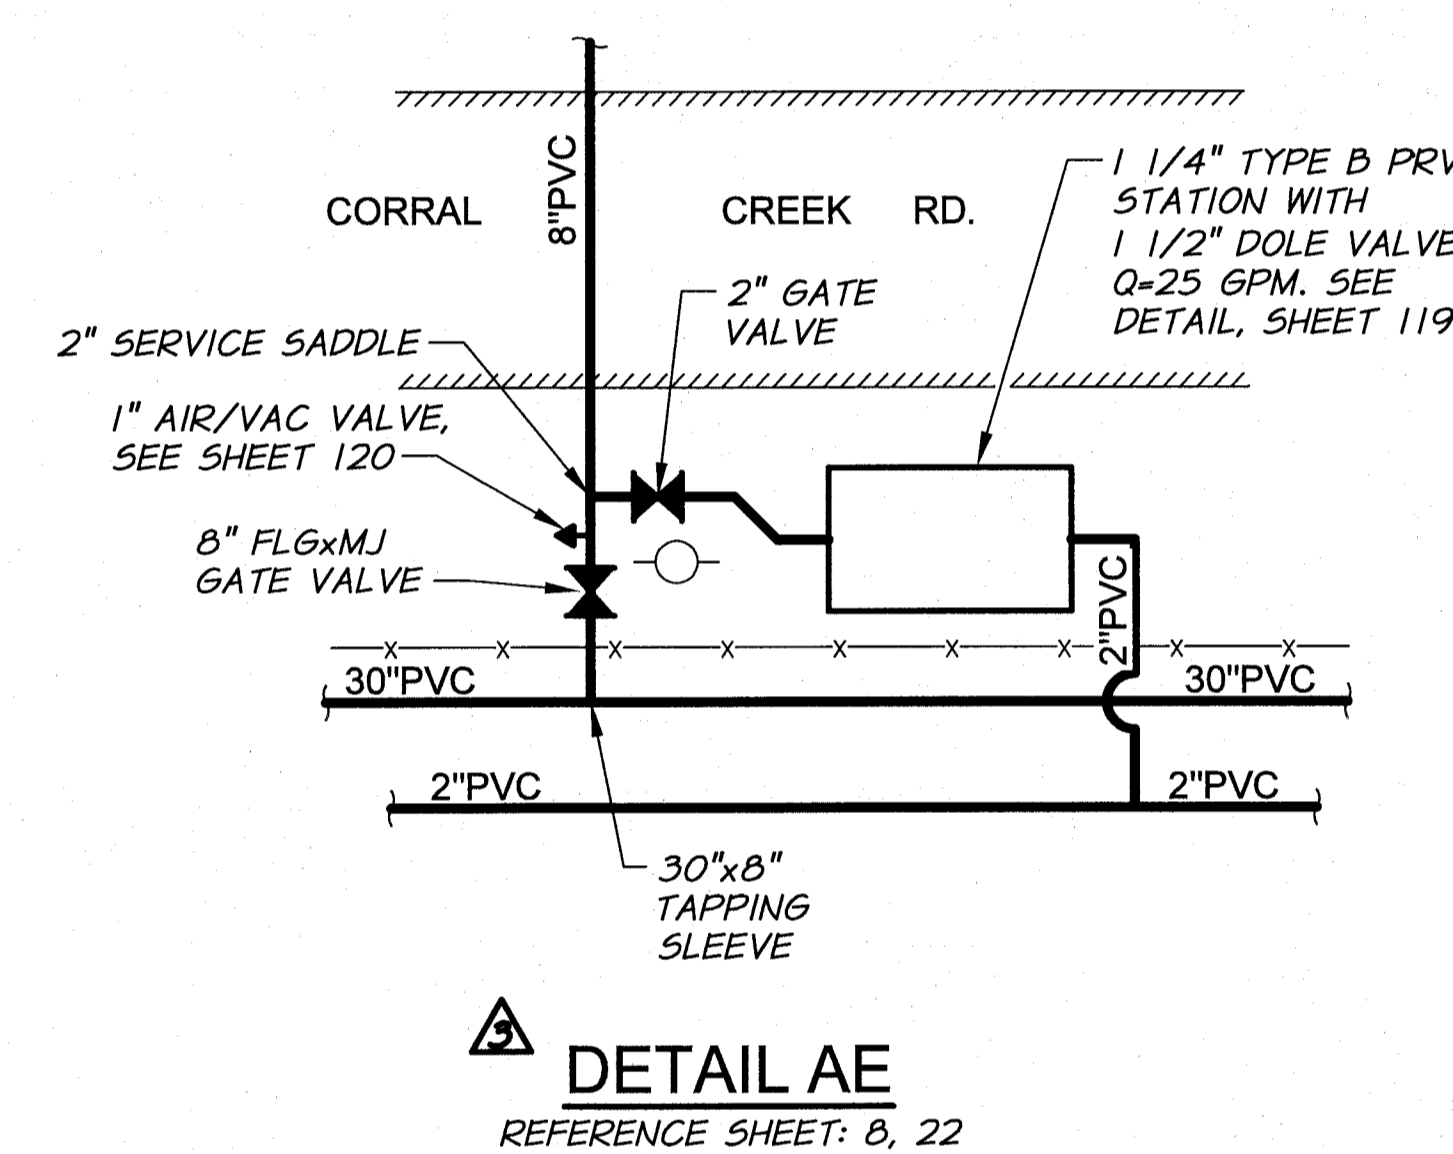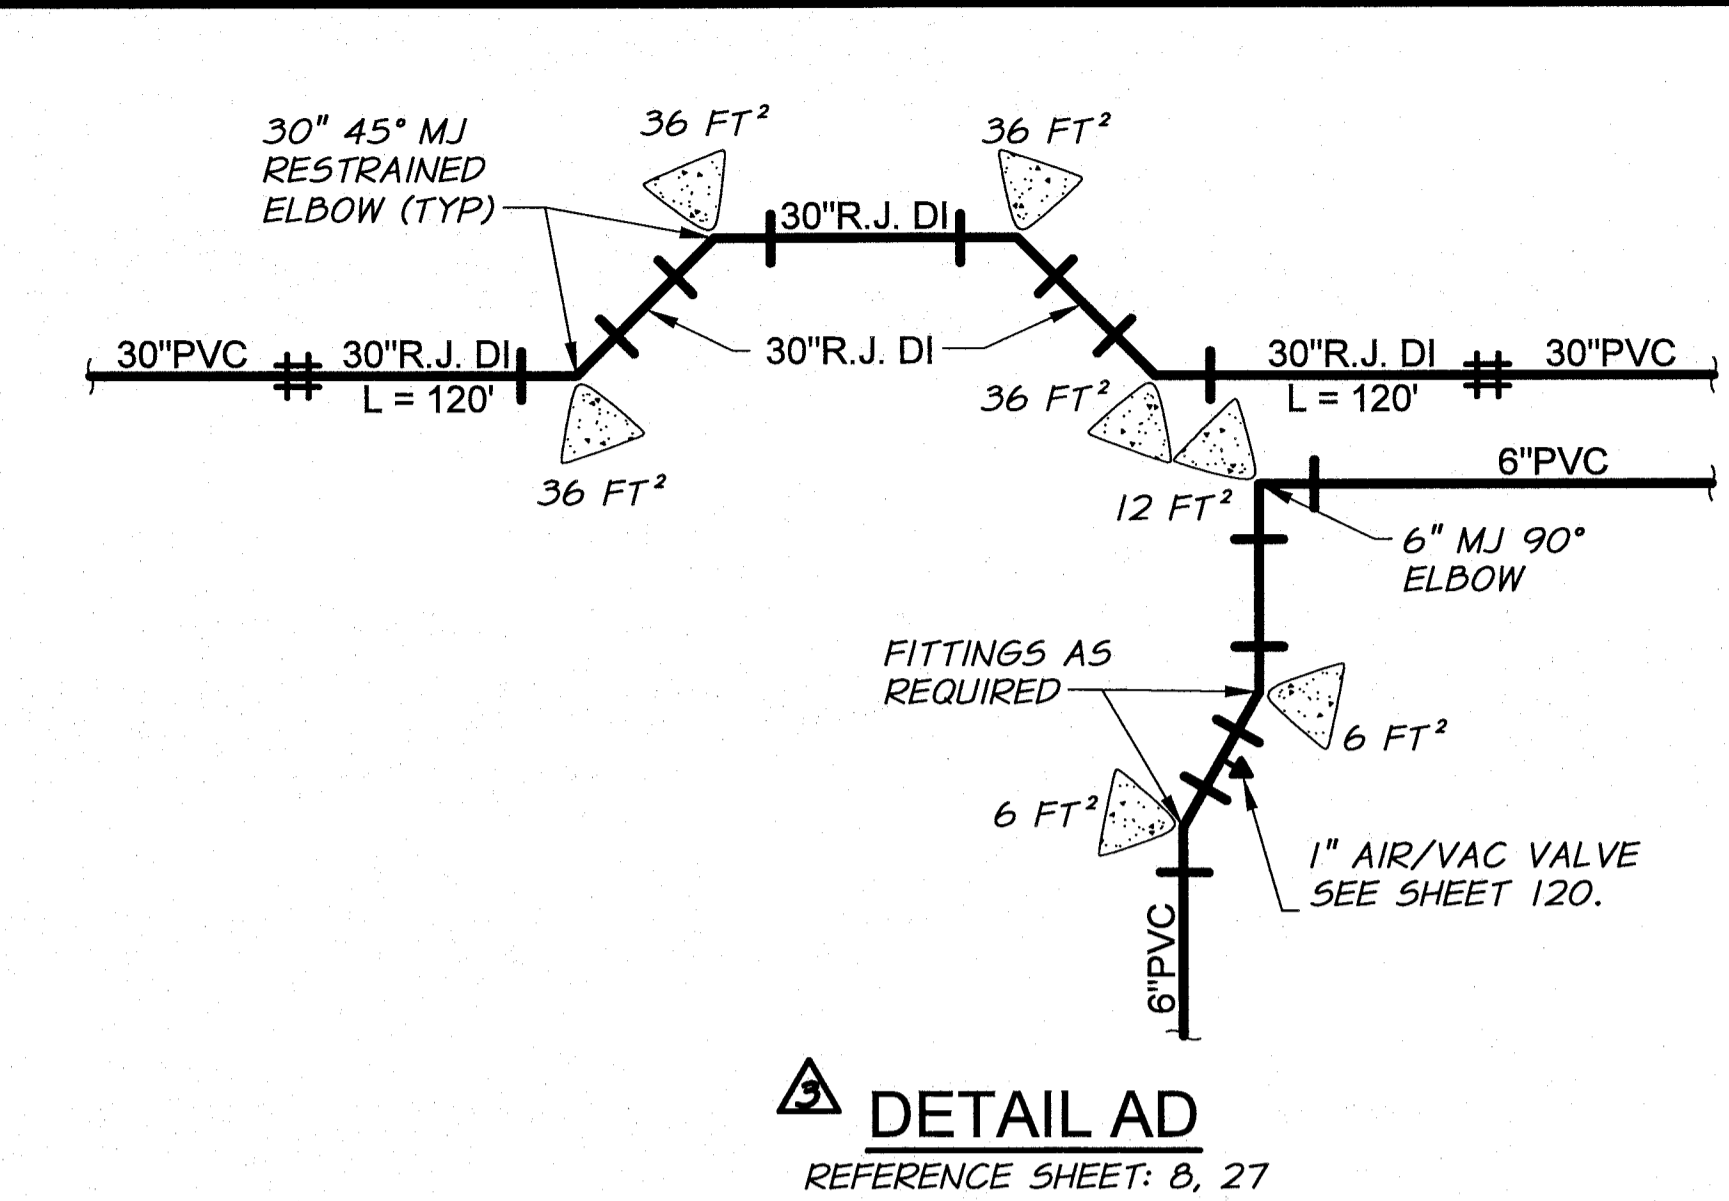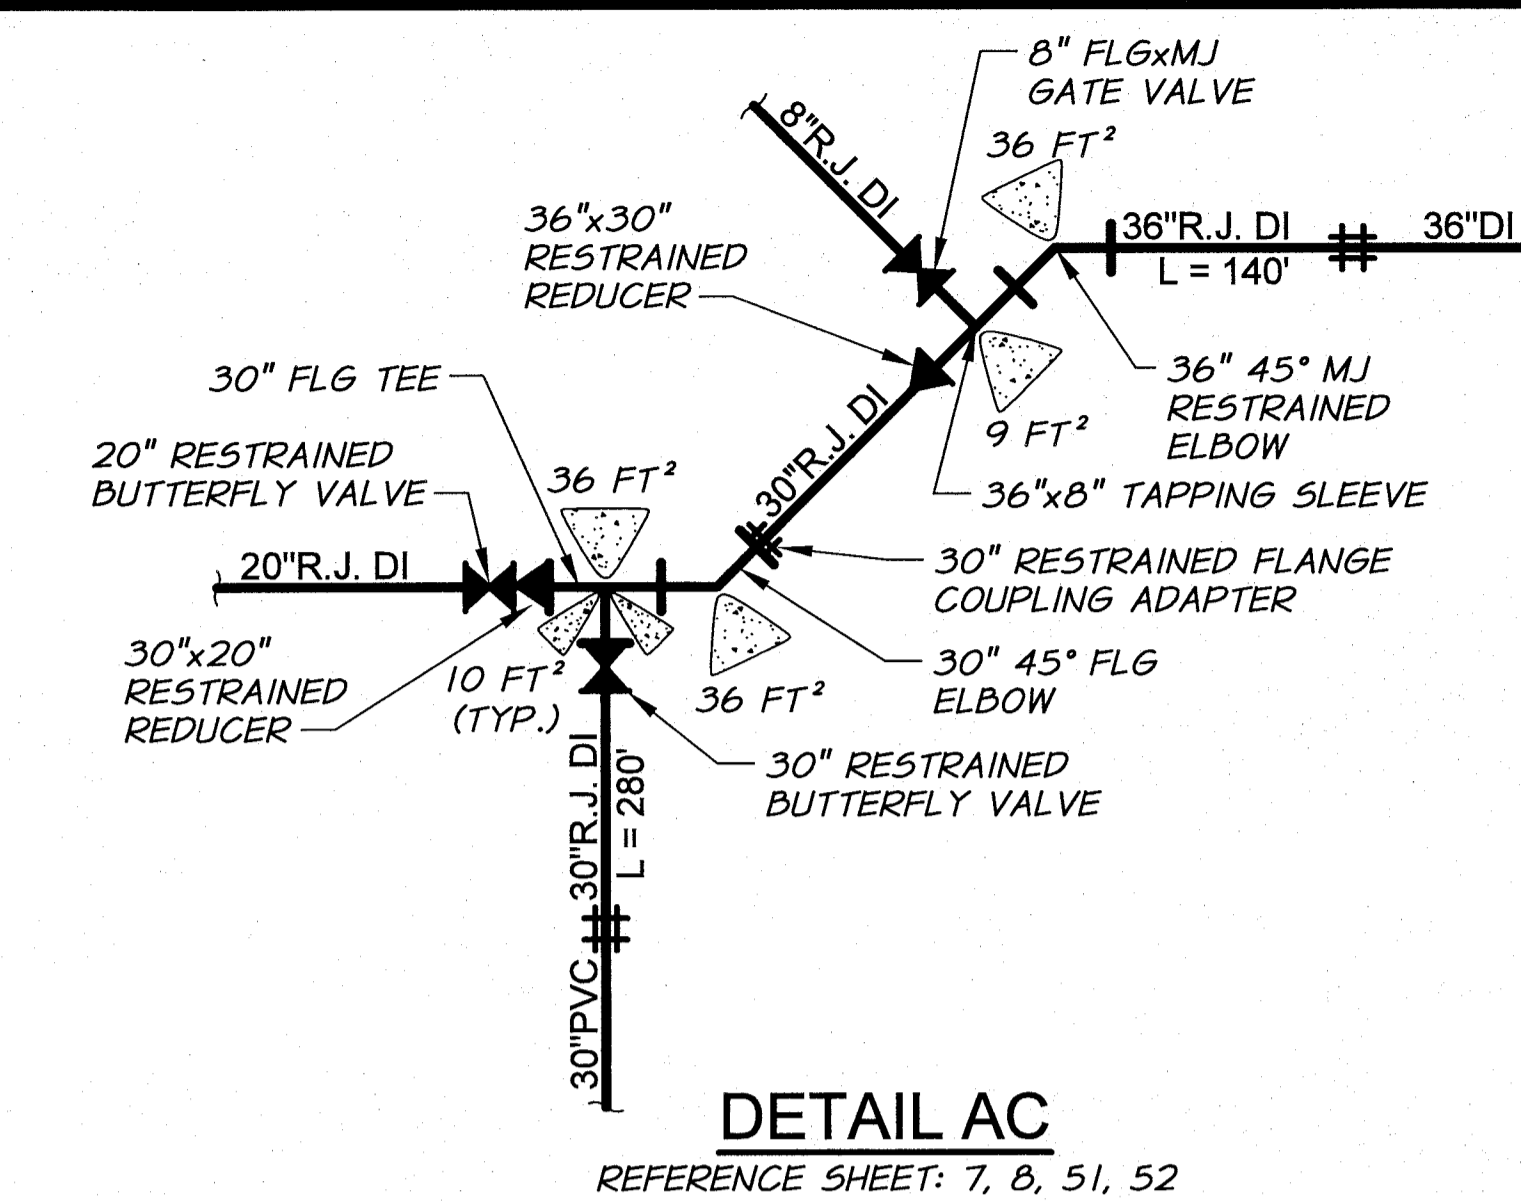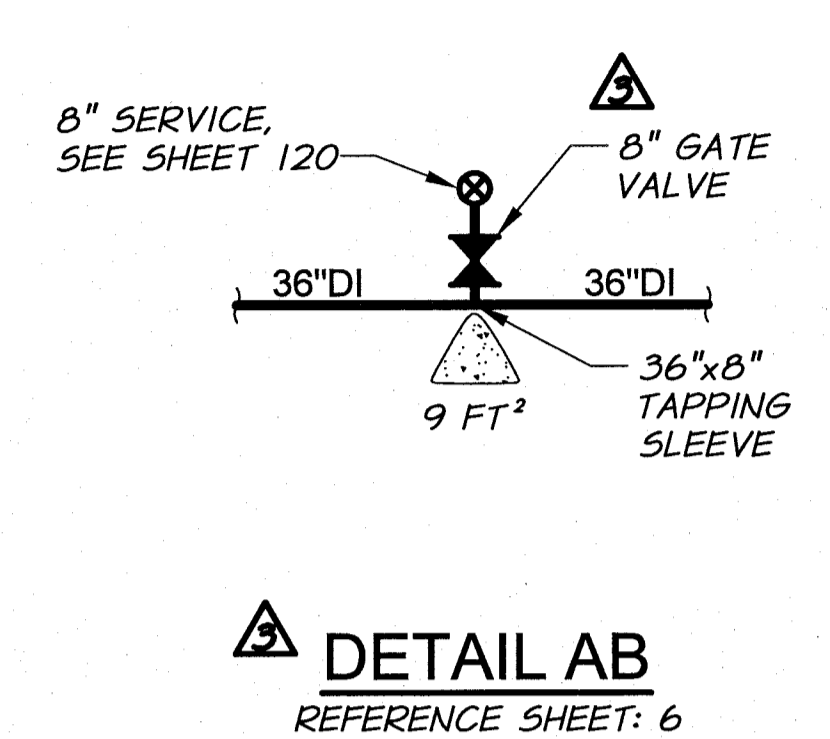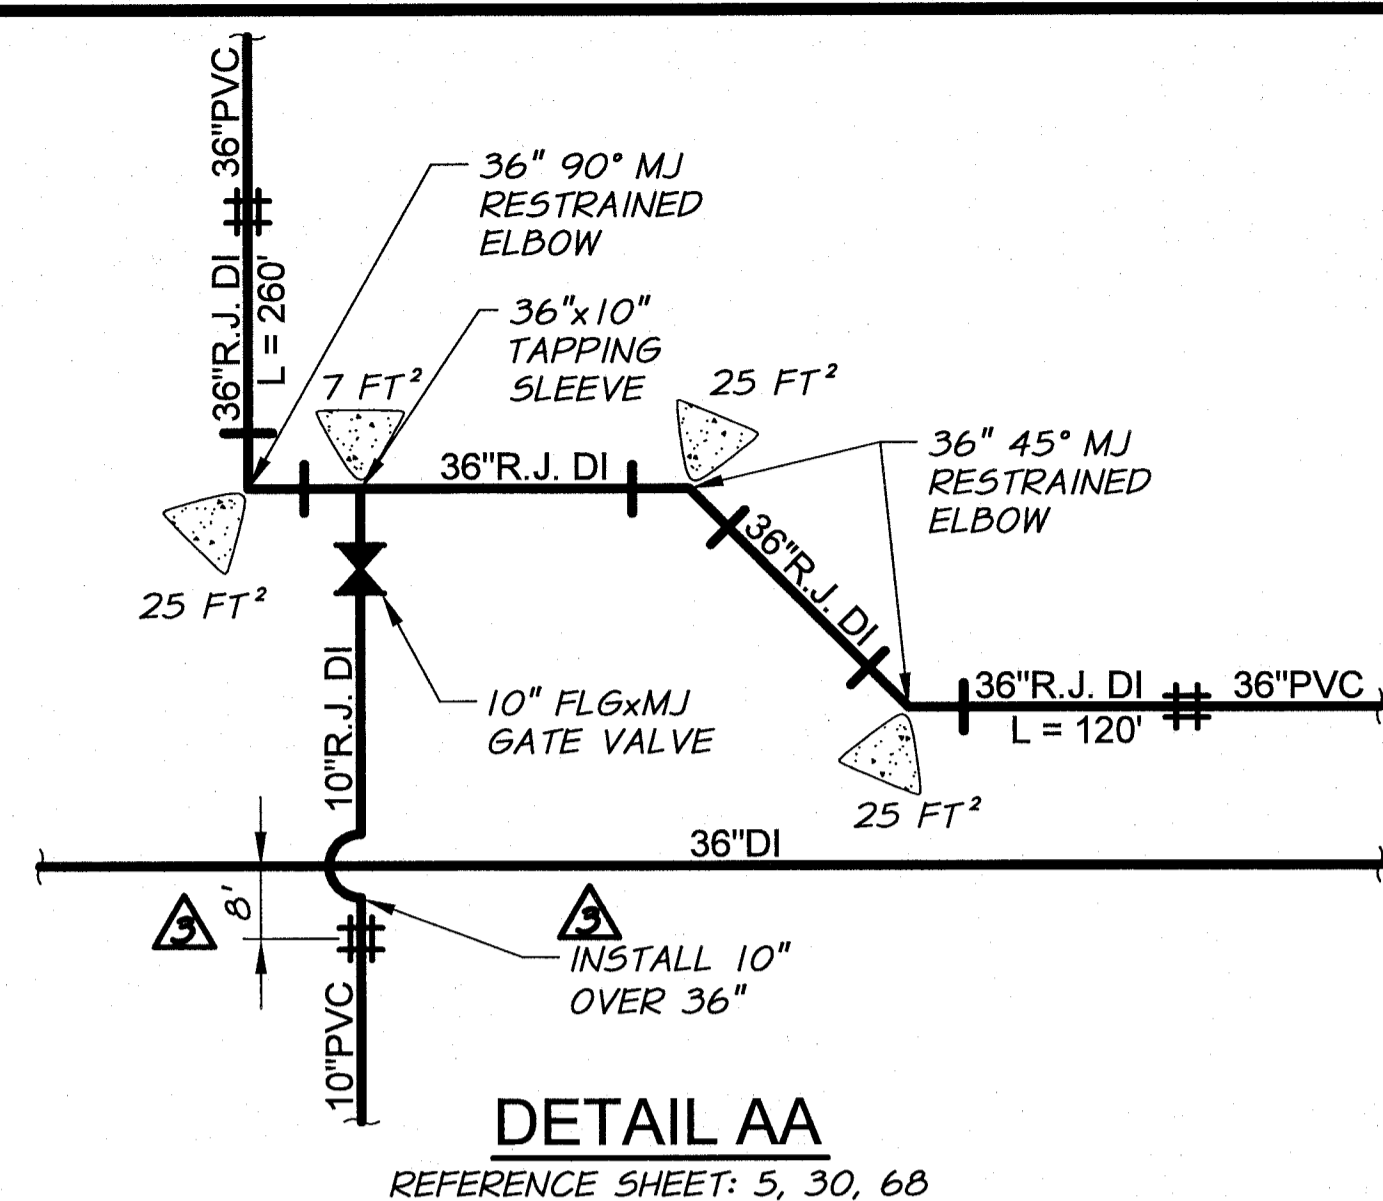


(DETAIL ELIMINATED)

DETAIL AF
REFERENCE SHEET:

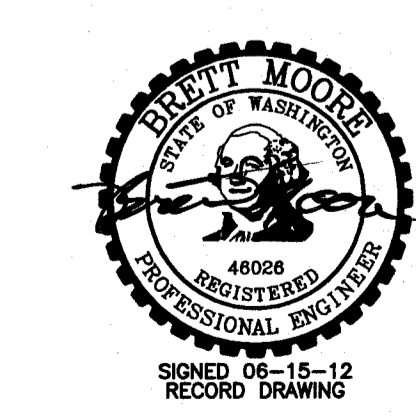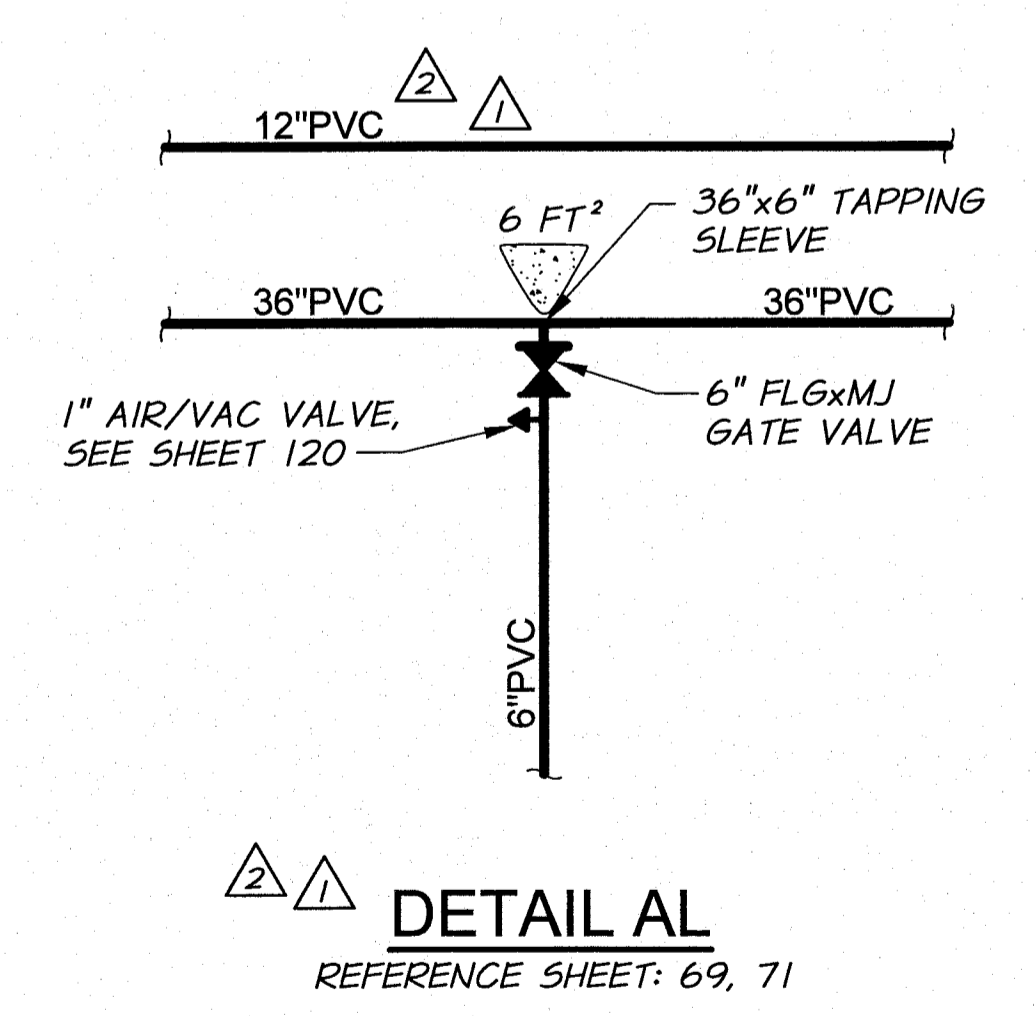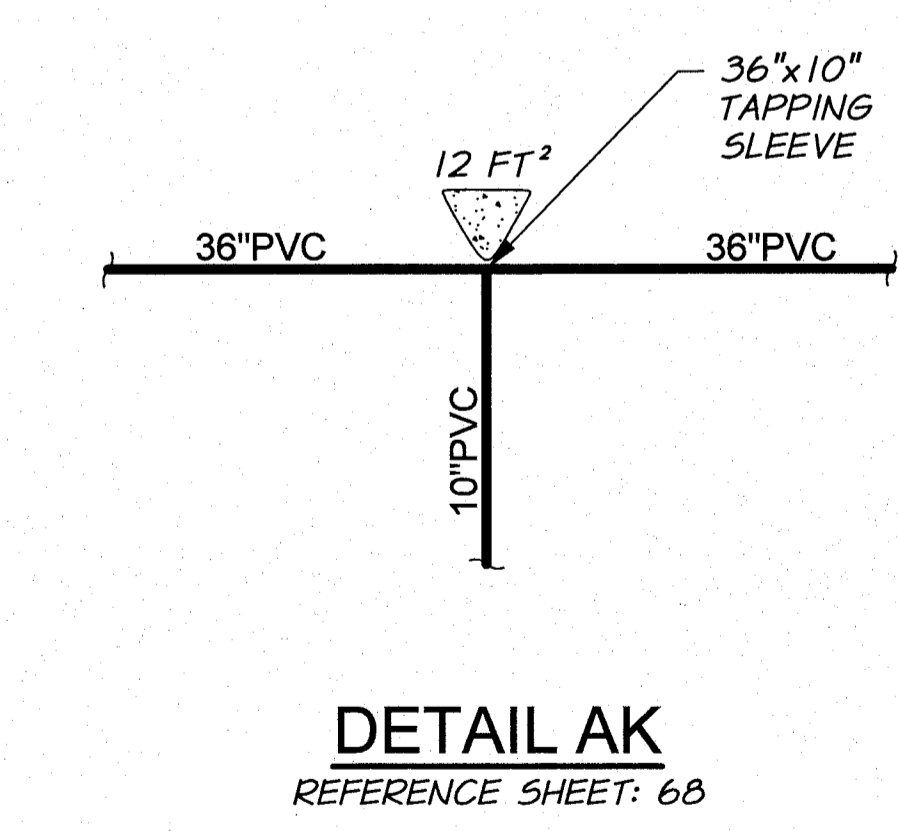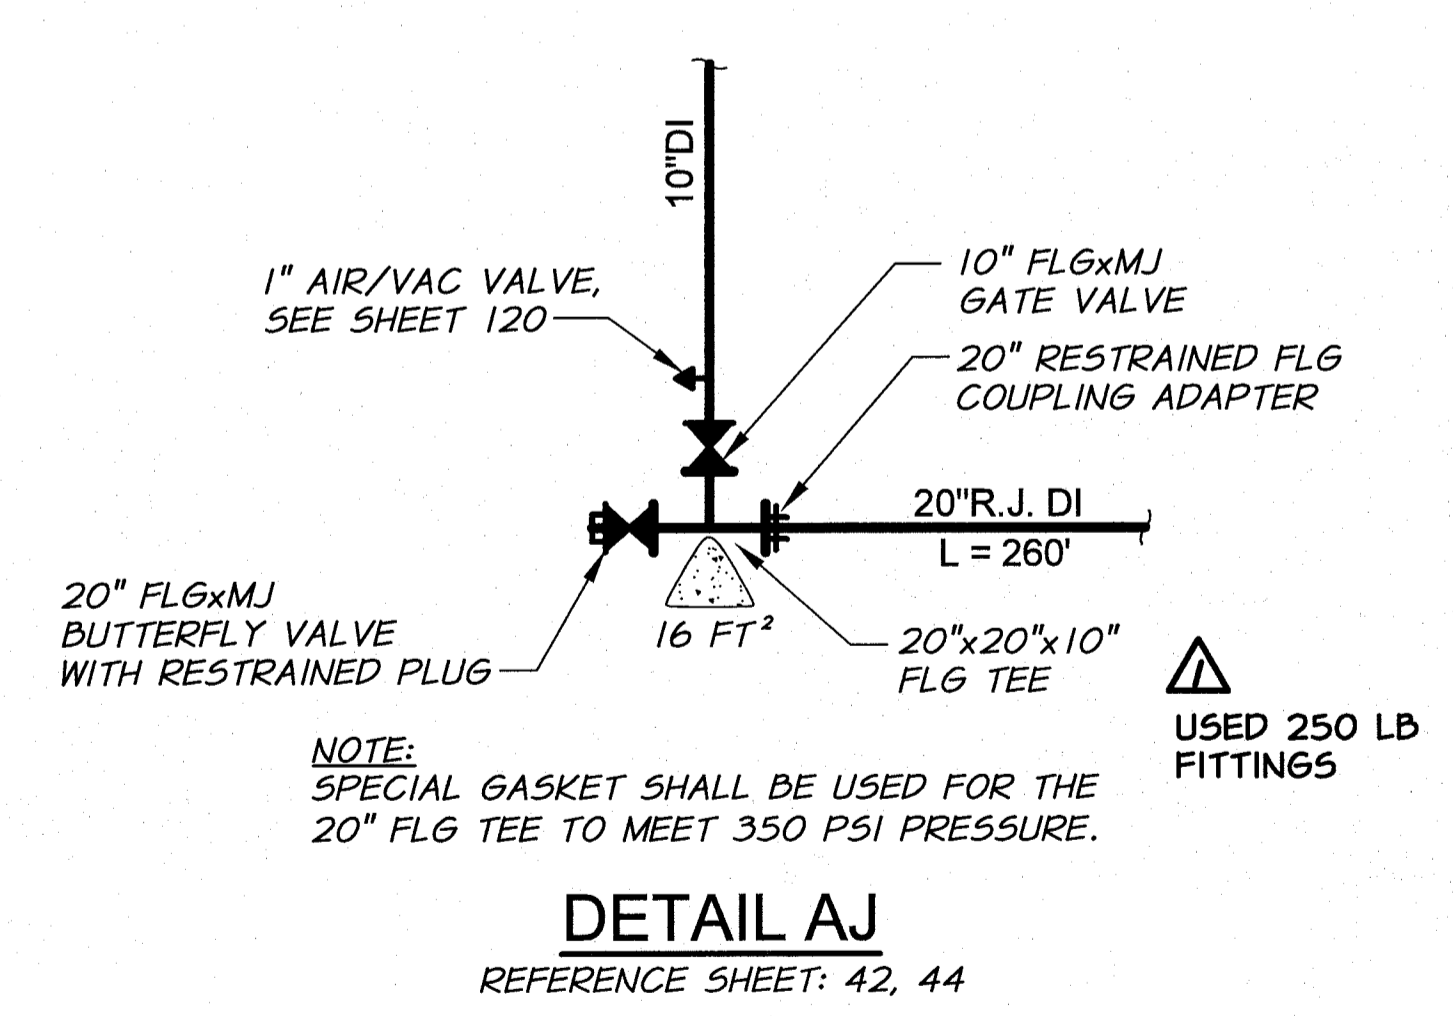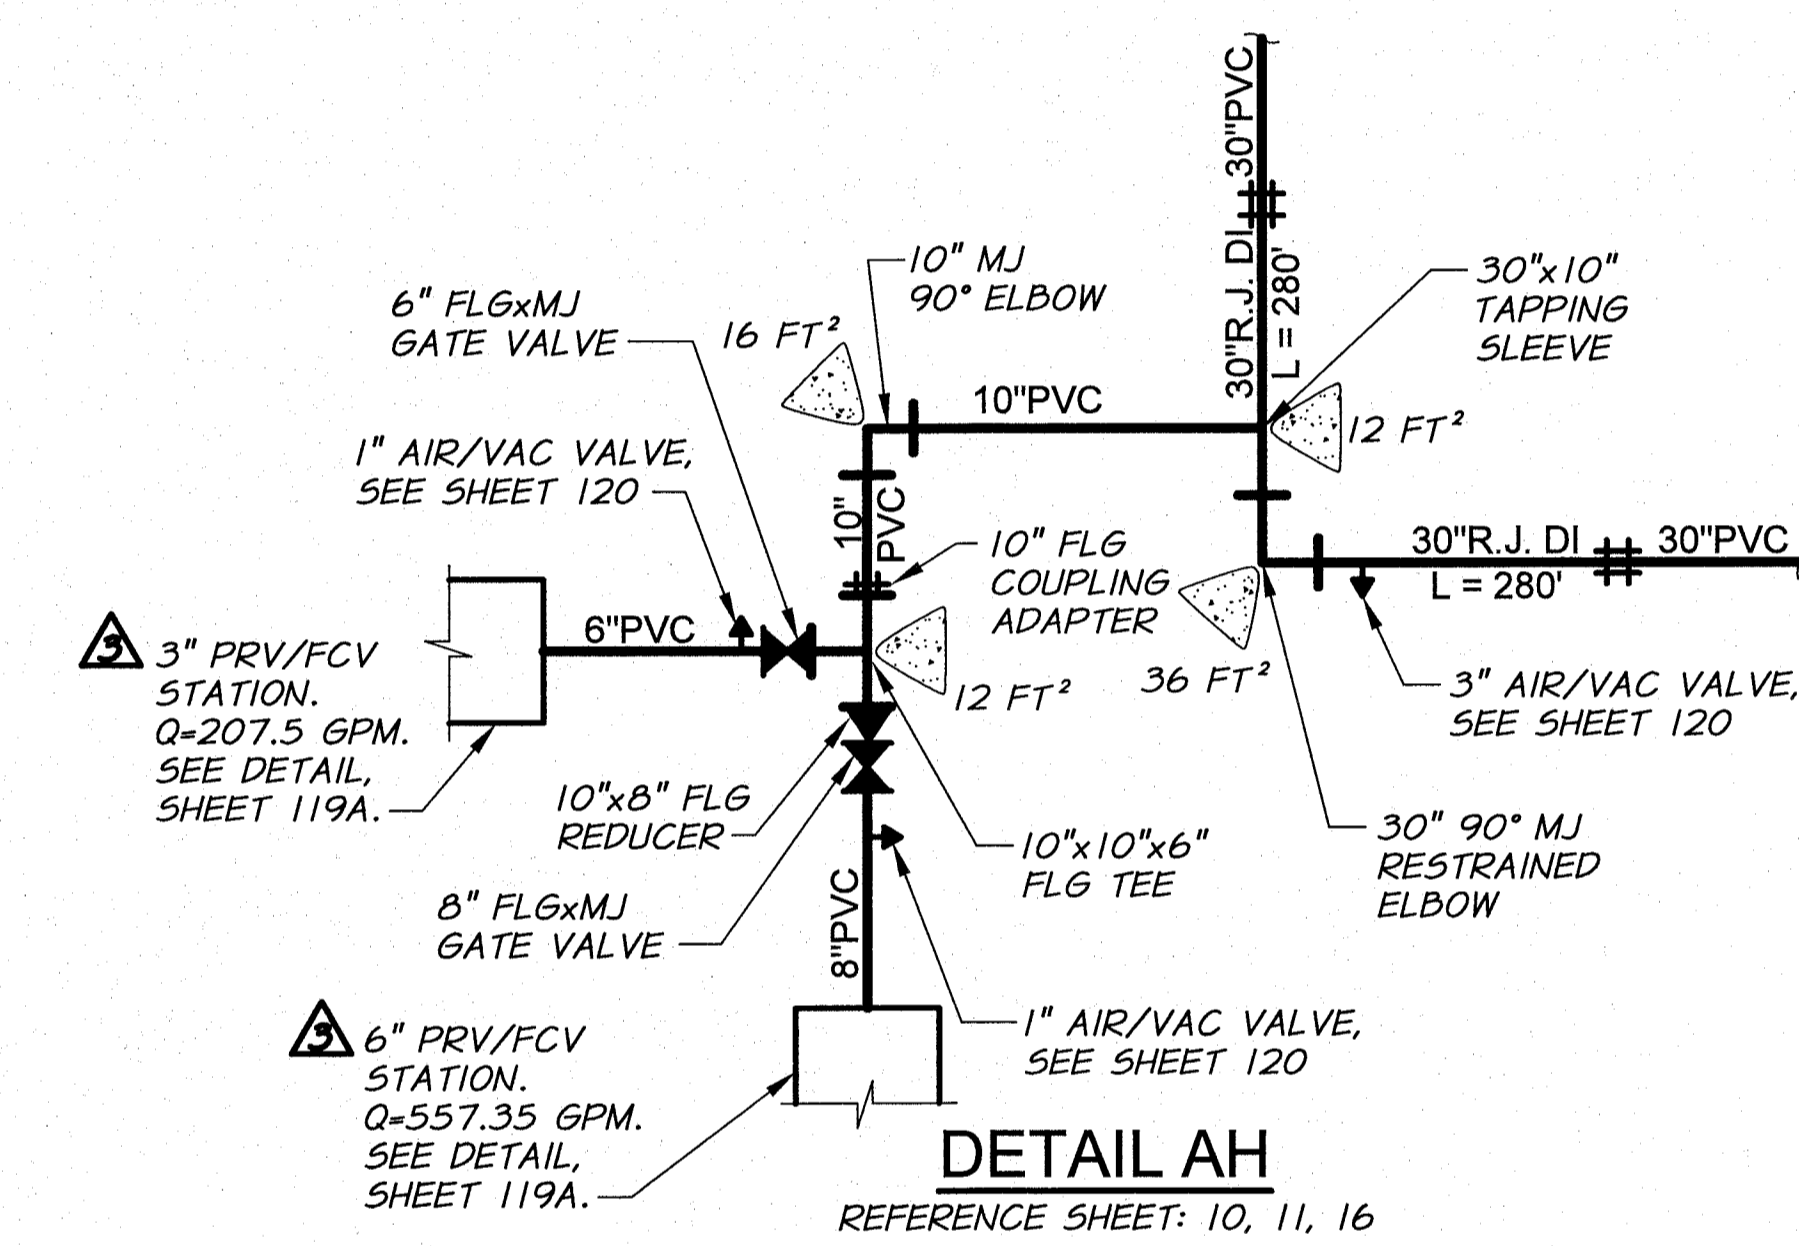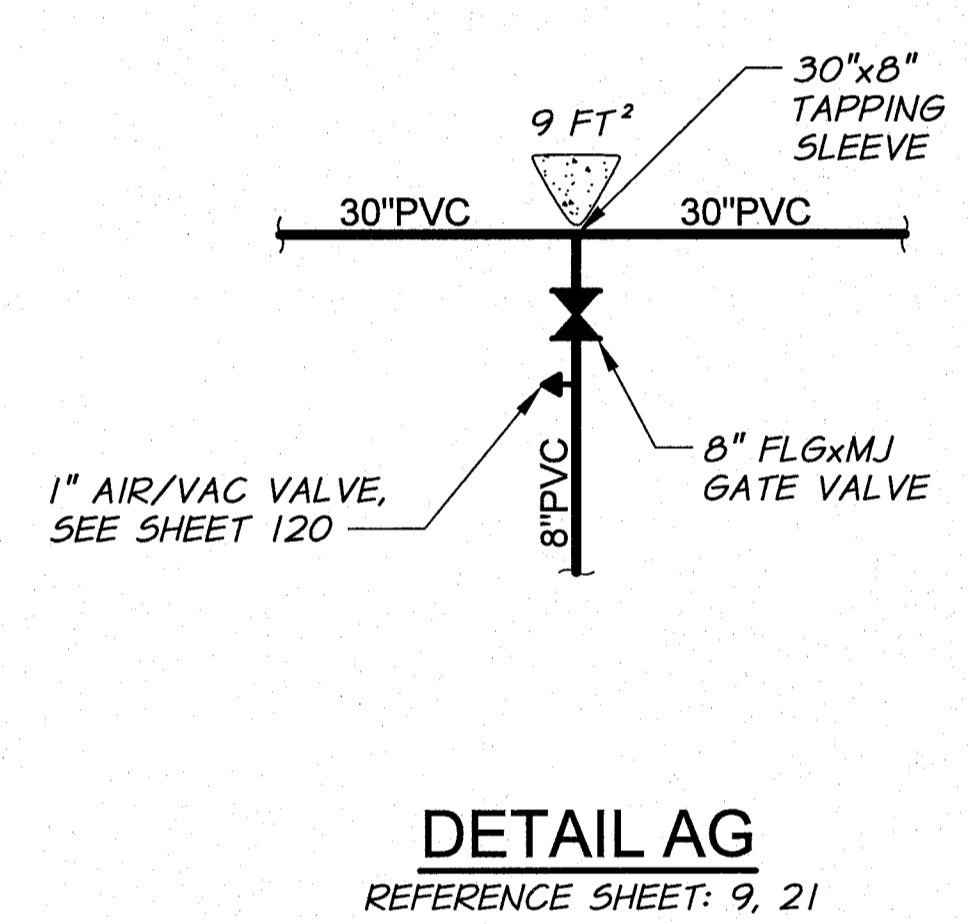


RECORD DRAWING	E.H.	12/11		
DETAIL REVISION	R.H.	2/10		
DETAIL REVISION	R.H.	1/10		
DESIGNED BY	R. HARRIS	XREFS: TB-BID.dwg	JOB NUMBER	1199-336
DRAWN BY	P. RICHARDSON		DATE	2009
REVIEWED BY	H. PERRY		ACAD FILE	WATERPIPINGDETS.dwg
			COPYRIGHT 2009 BY ANDERSON-PERRY & ASSOC., INC.	


RECORD DRAWINGS
These record drawings have been prepared, in part, on the basis of information compiled and furnished by others. They may contain some discrepancies and omissions, and do not necessarily represent "exact" field conditions. The Owner and the Engineer accept no responsibility for their accuracy.

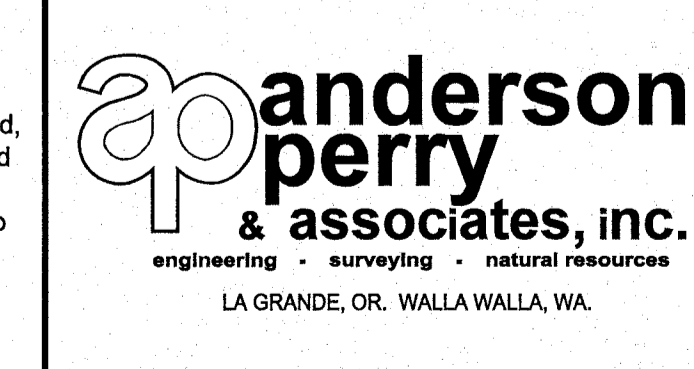


BENTON IRRIGATION DISTRICT
IRRIGATION SYSTEM IMPROVEMENTS
PHASE I
PIPE CONNECTION DETAILS I

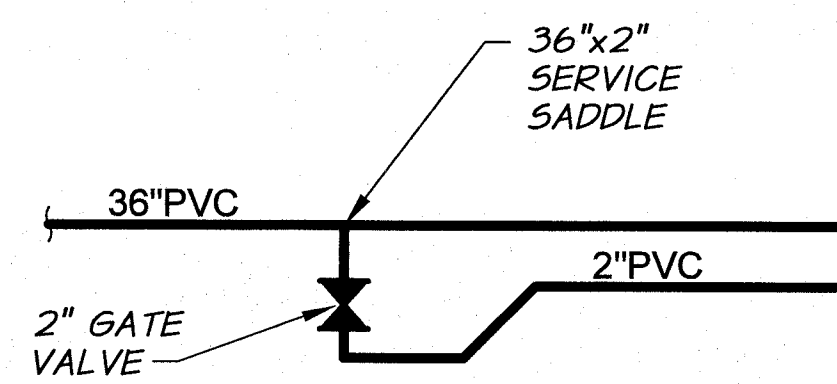


DETAIL AM
REFERENCE SHEET: 69

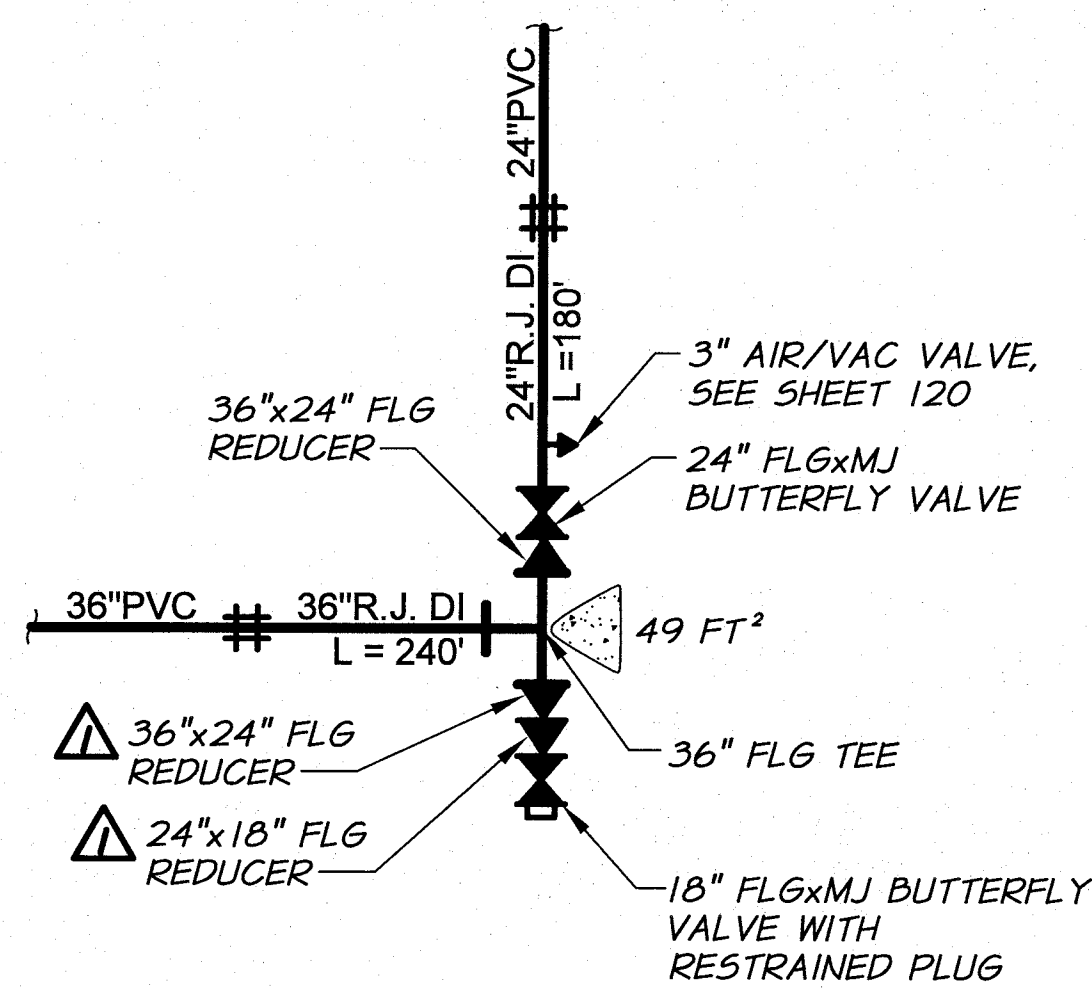


DETAIL AN
REFERENCE SHEET: 70, 76

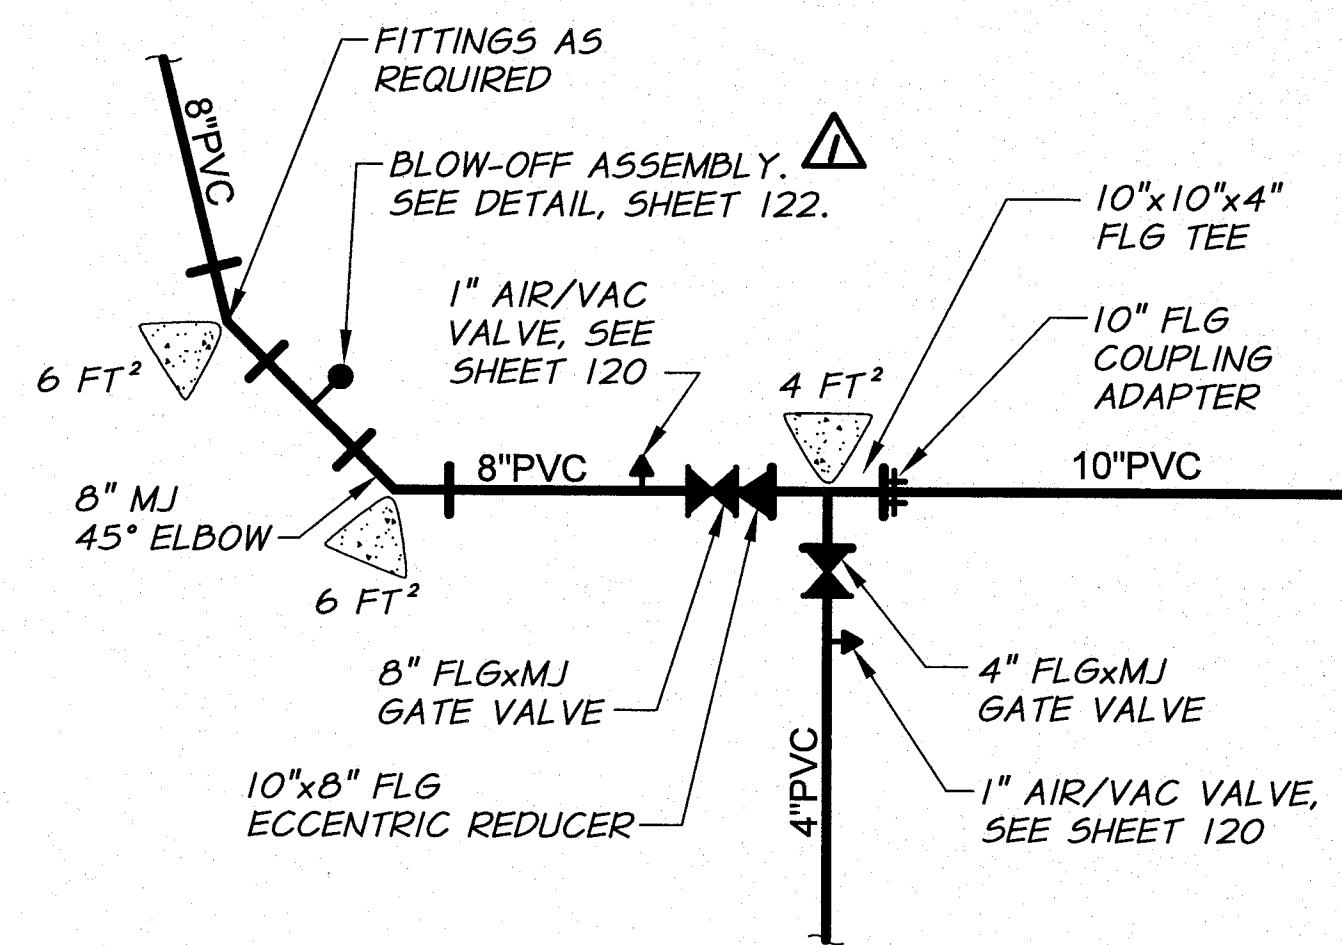


DETAIL AP
REFERENCE SHEET: 30, 39

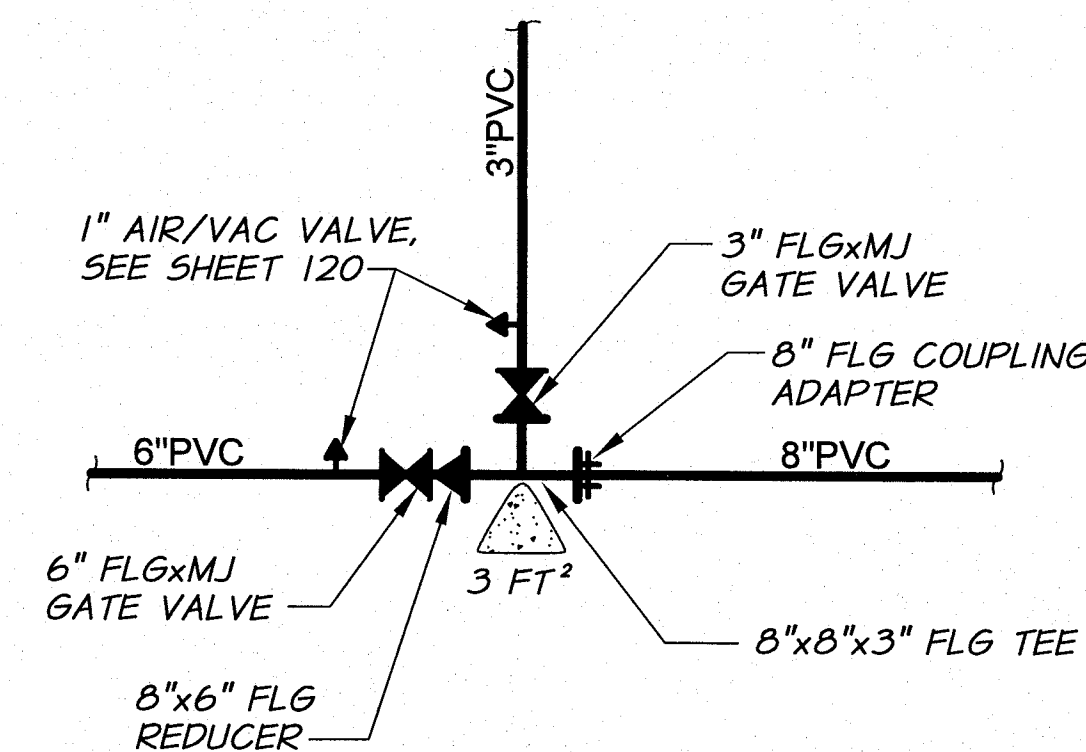


DETAIL AQ
REFERENCE SHEET: 31, 38

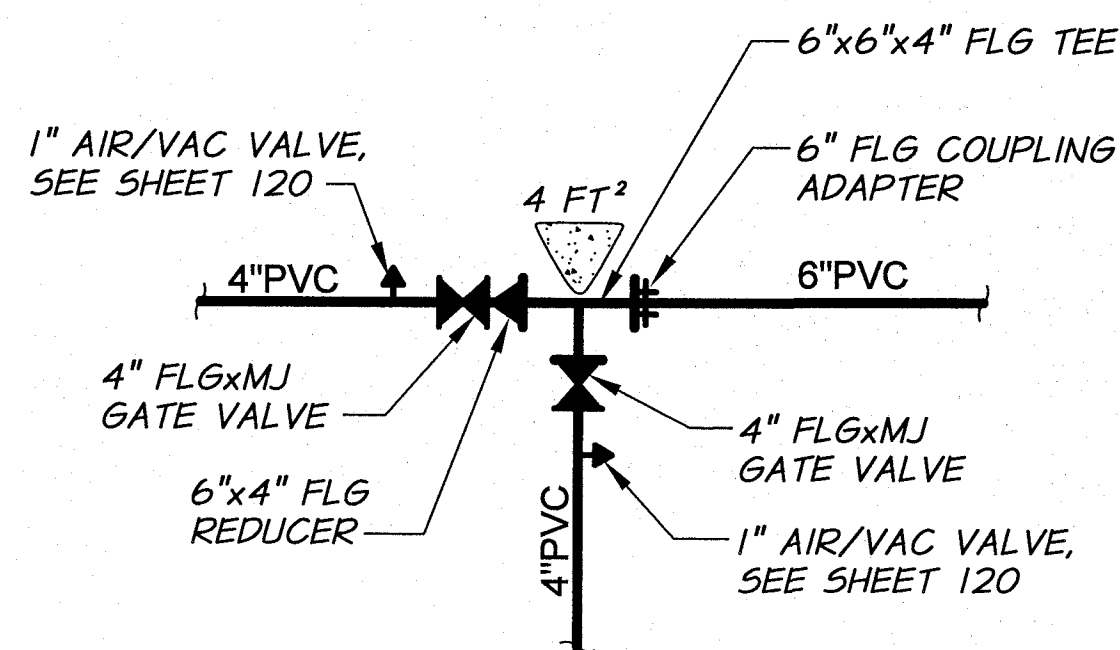


DETAIL AR
REFERENCE SHEET: 33, 35

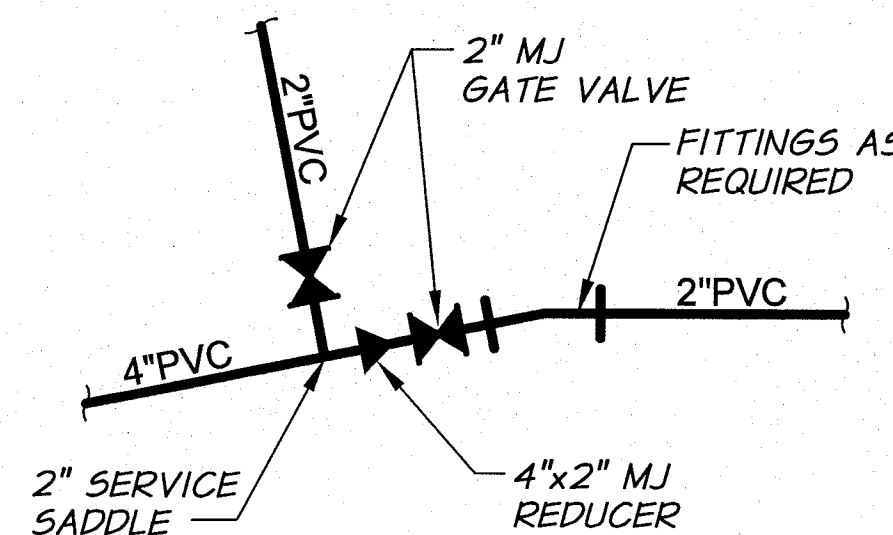


DETAIL AS
REFERENCE SHEET: 28, 29

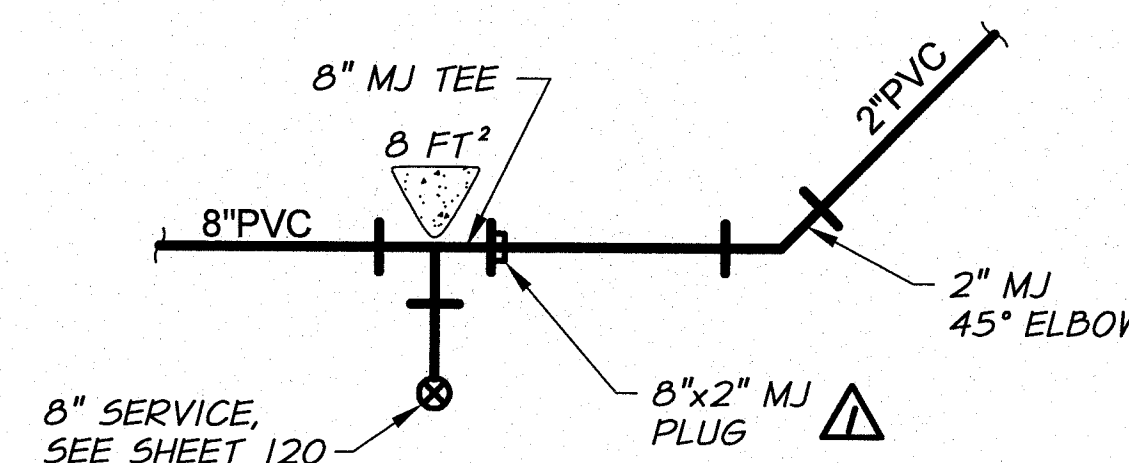


DETAIL AT
REFERENCE SHEET: 21

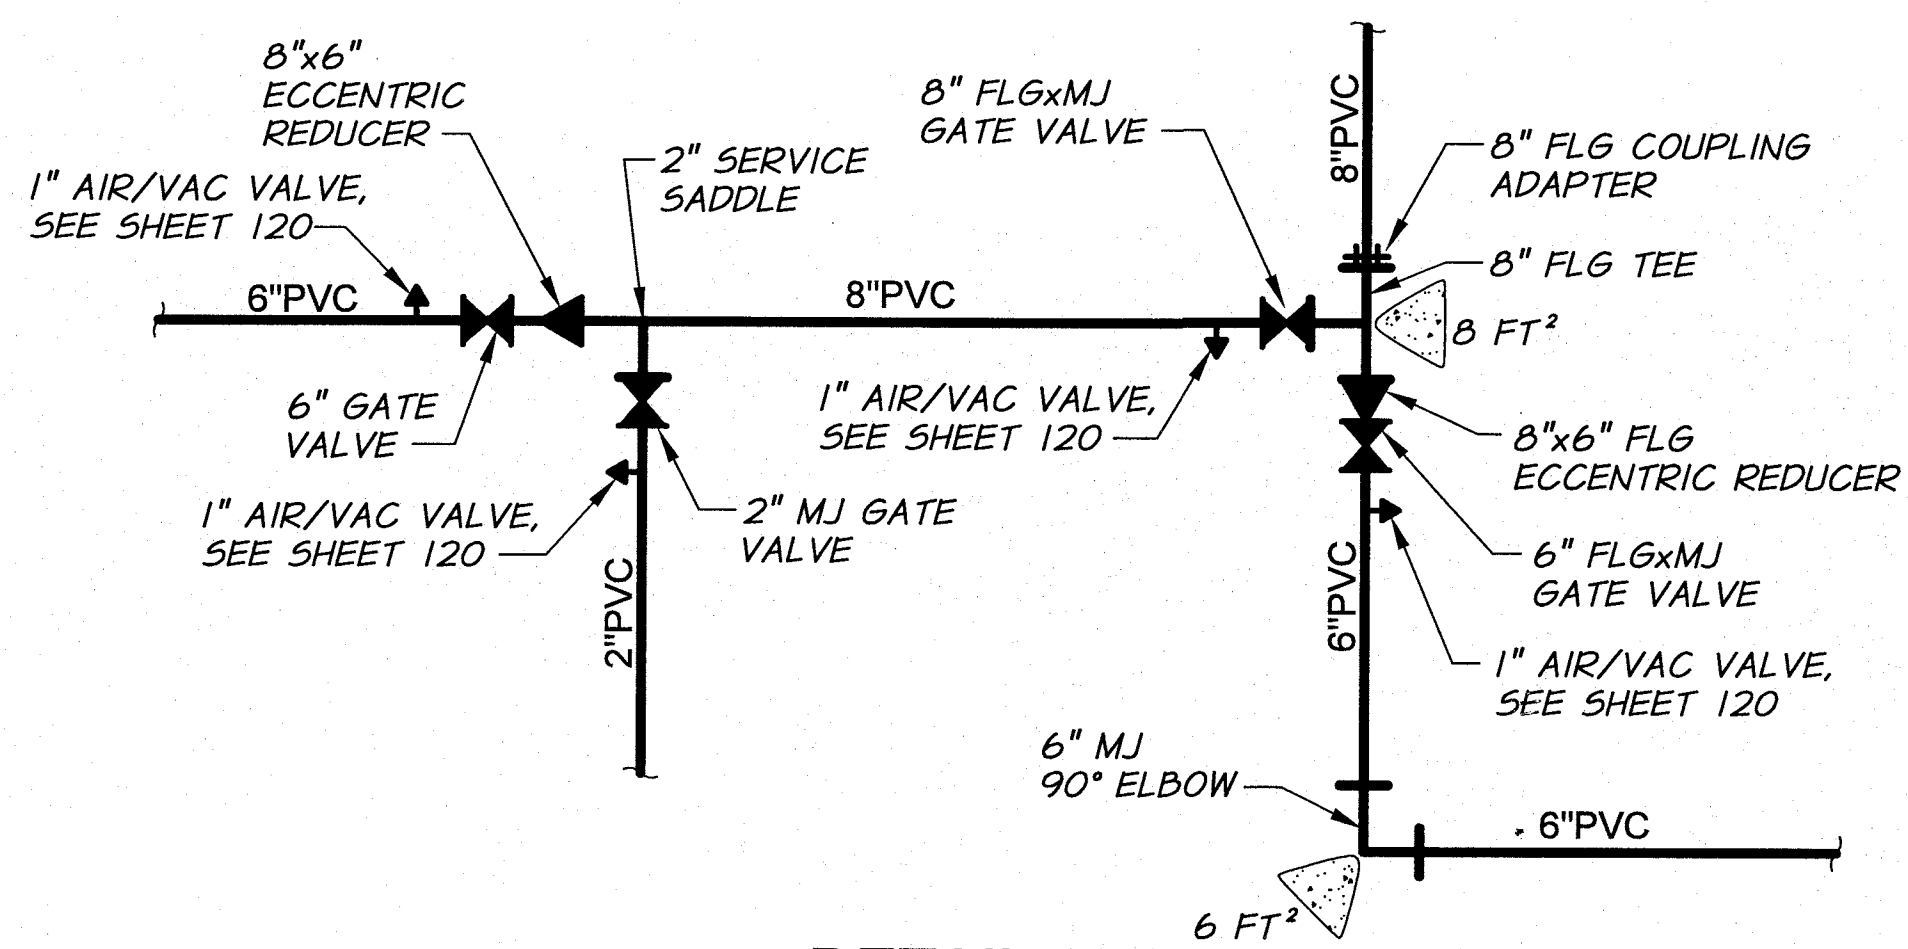

DETAIL AU
REFERENCE SHEET: 16, 18, 19

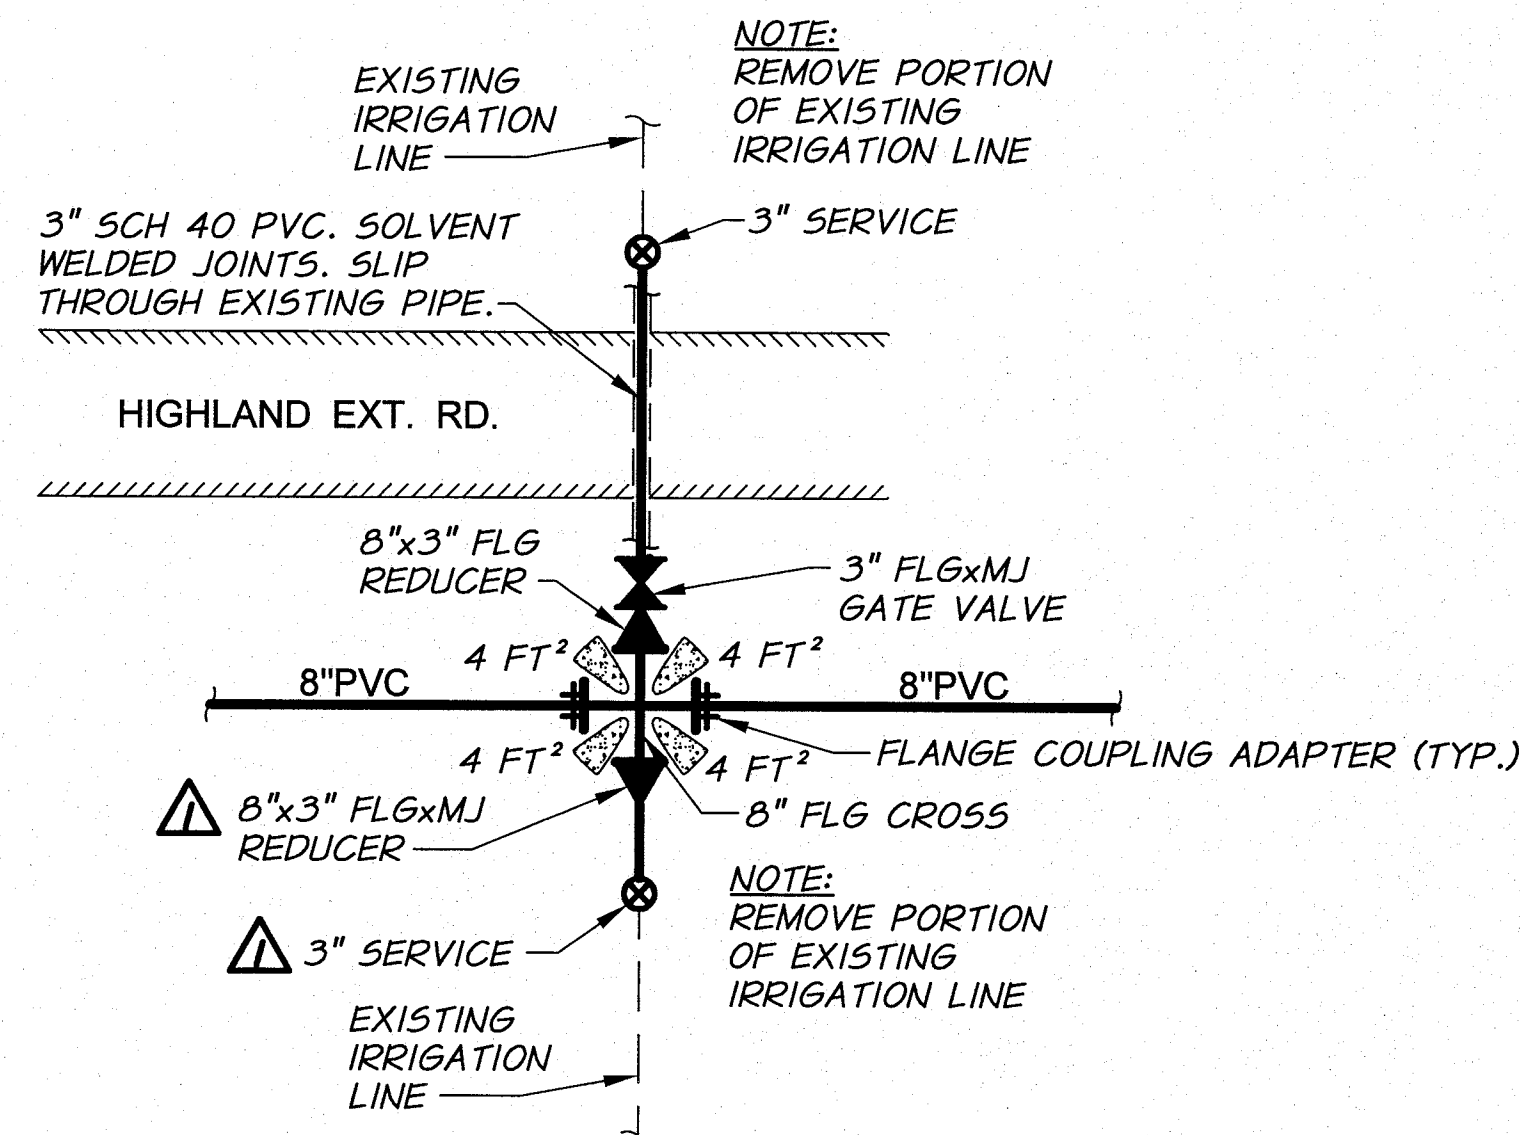

DETAIL AV
REFERENCE SHEET: 46

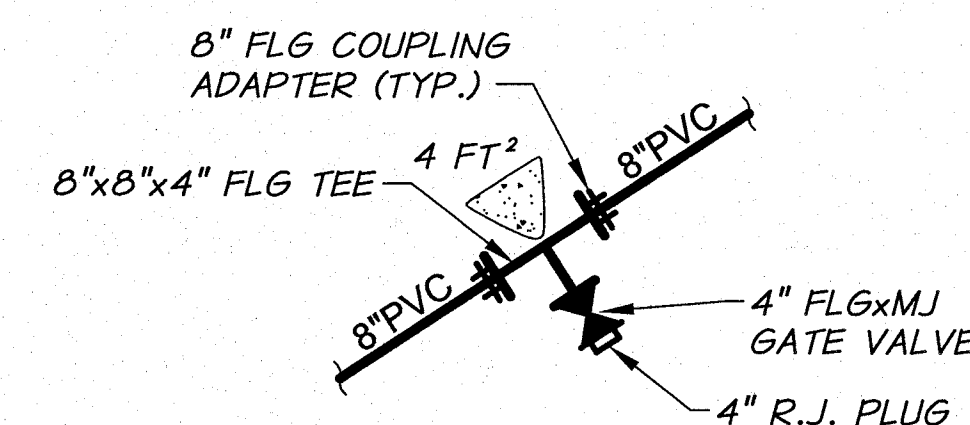


DETAIL AW
REFERENCE SHEET: 46



RECORD DRAWING		E.H.	12/11		
DESIGNED BY	R. HARRIS	BY		HORIZ. SCALE	NONE
DRAWN BY	E. ARNTZ	DATE		VERT. SCALE	
REVISED BY	H. PERRY	JOB NUMBER	1199-336	DATE	2009
		ACAD FILE:	WATERPIPINGDETS.dwg		
COPYRIGHT 2009 BY ANDERSON-PERRY & ASSOC., INC.					

RECORD DRAWINGS

These record drawings have been prepared, in part, on the basis of information compiled and furnished by others. They may contain some discrepancies and omissions, and do not necessarily represent "exact" field conditions. The Owner and the Engineer accept no responsibility for their accuracy.

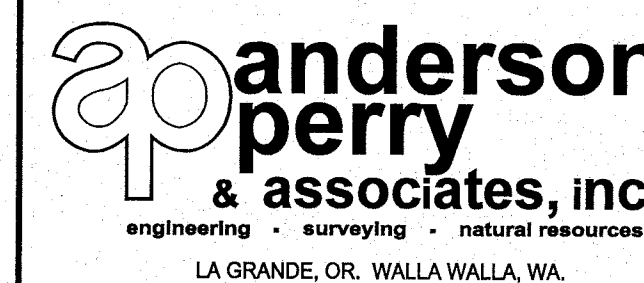


BENTON IRRIGATION DISTRICT
IRRIGATION SYSTEM IMPROVEMENTS
PHASE I


PIPE CONNECTION DETAILS II

SHEET


113

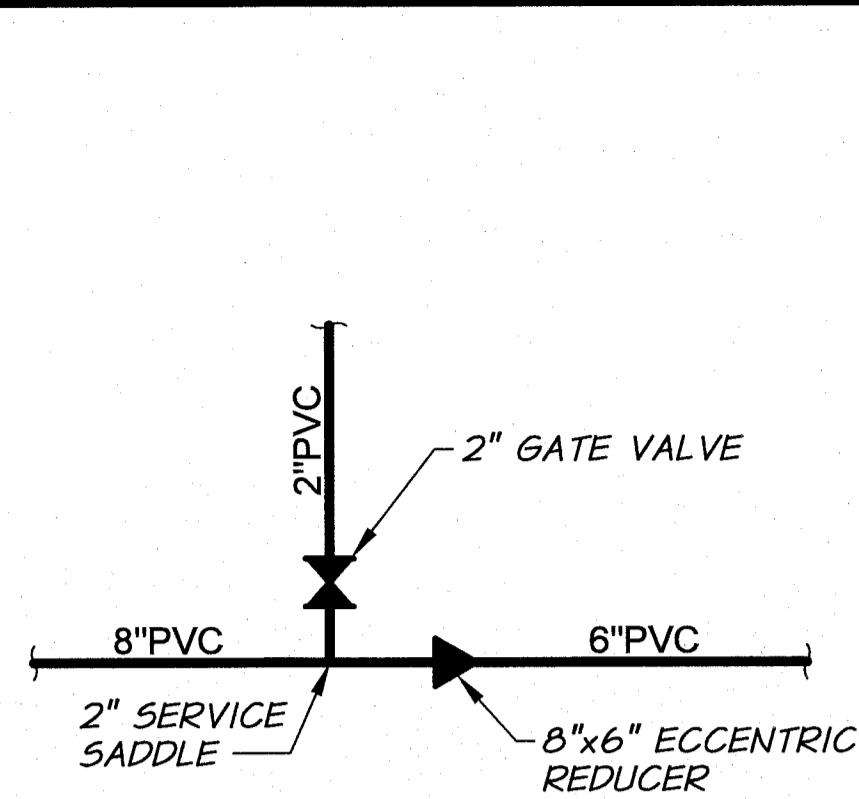


DETAIL AX
REFERENCE SHEET: 47, 49

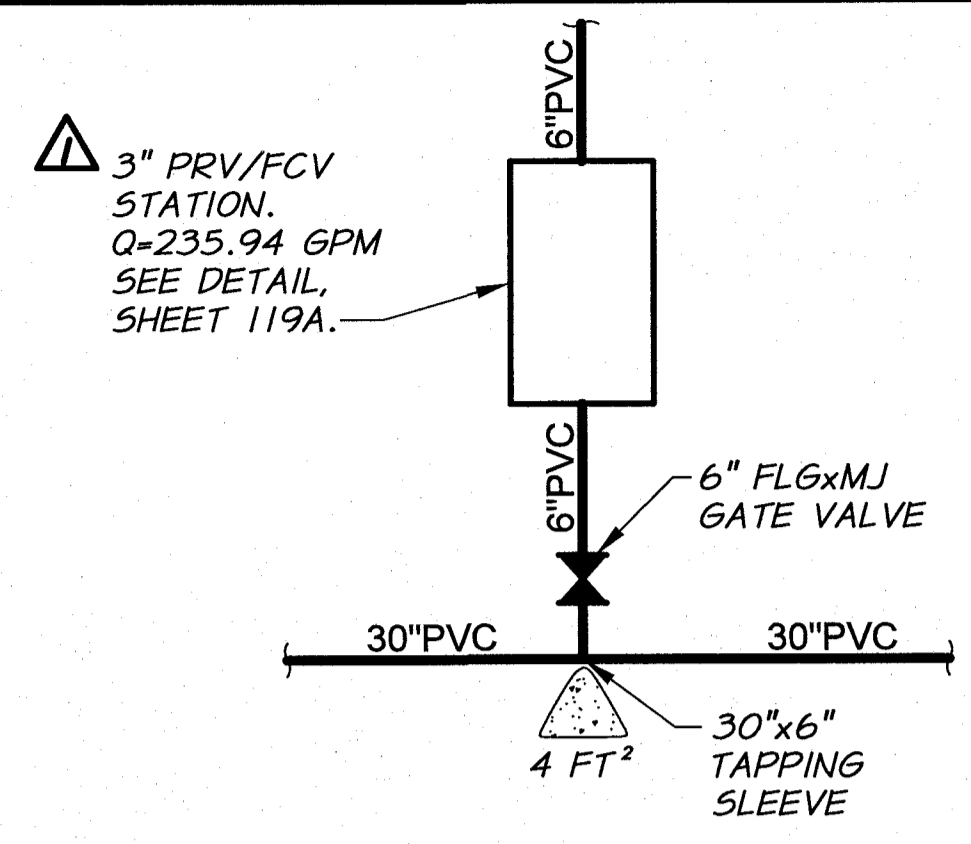


DETAIL AY
REFERENCE SHEET: 11, 15

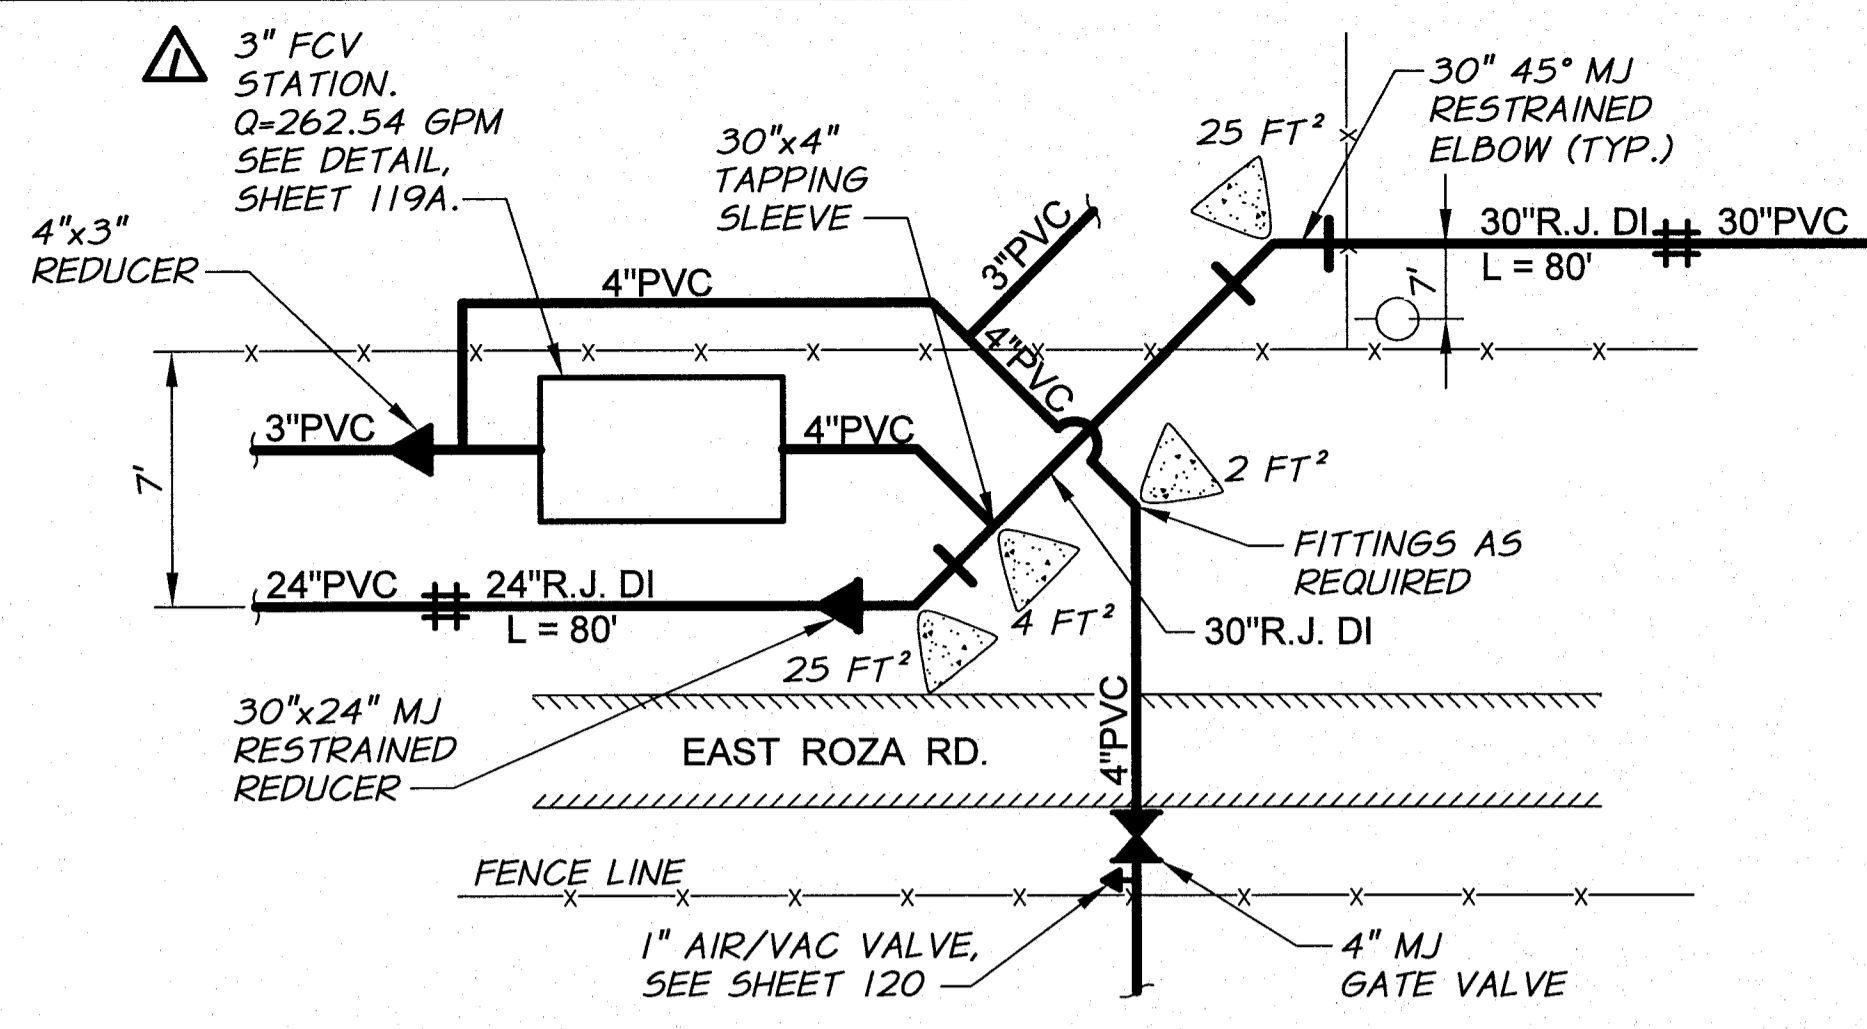


DETAIL AZ
REFERENCE SHEET: 12, 14

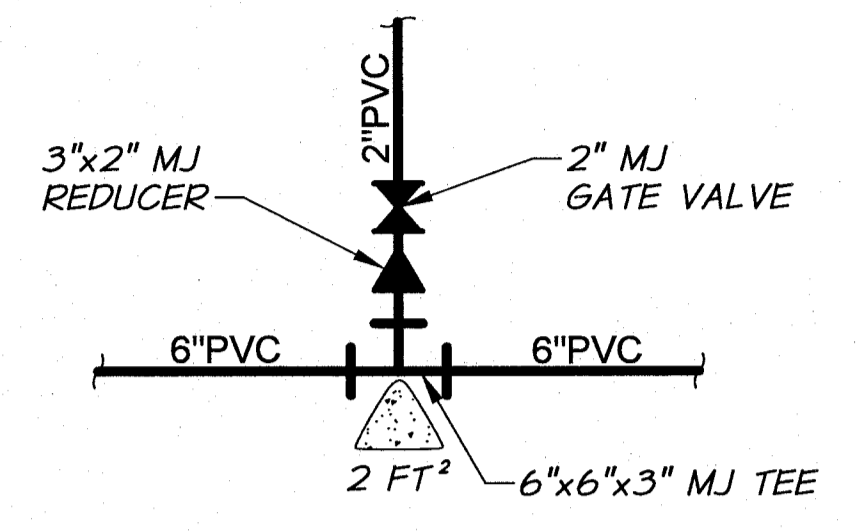


DETAIL BA
REFERENCE SHEET: 23, 26

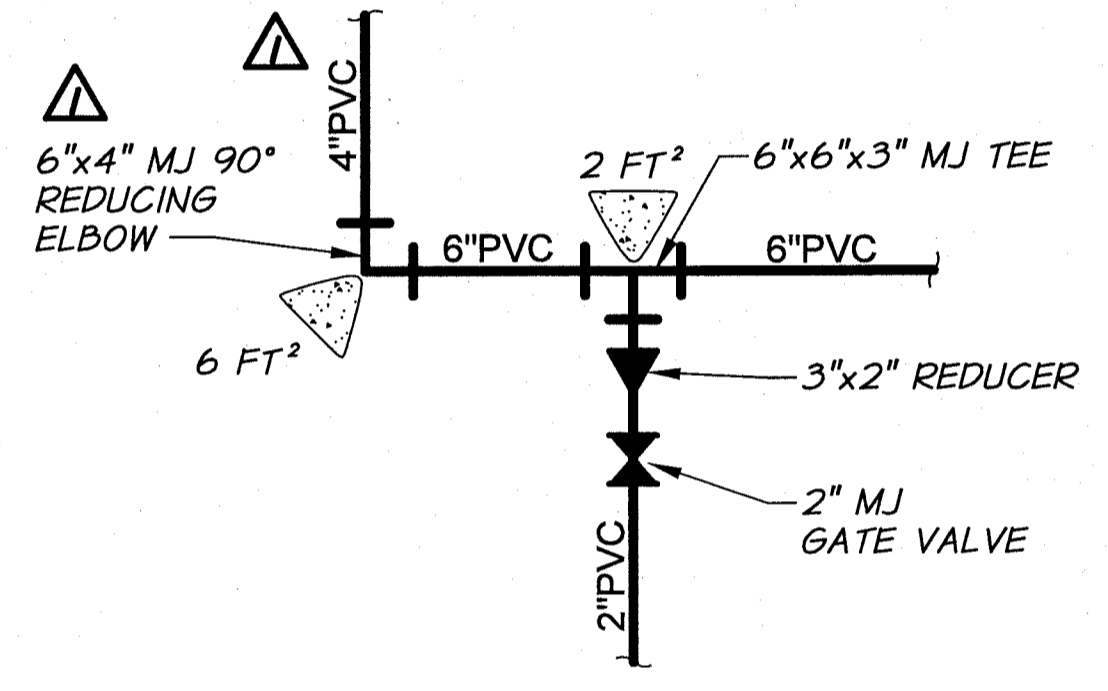


DETAIL BB
REFERENCE SHEET: 23, 25

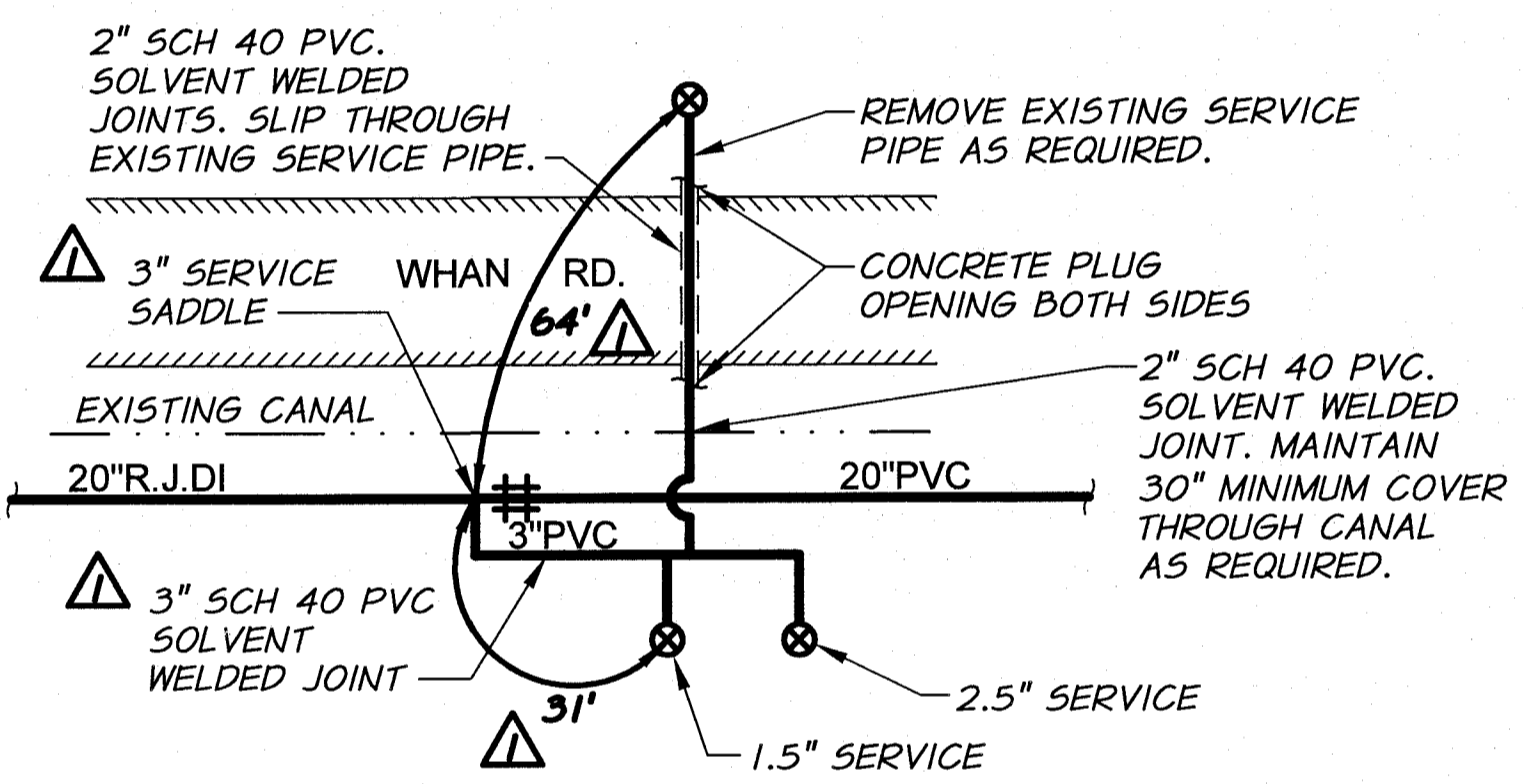


DETAIL BC
REFERENCE SHEET: 52

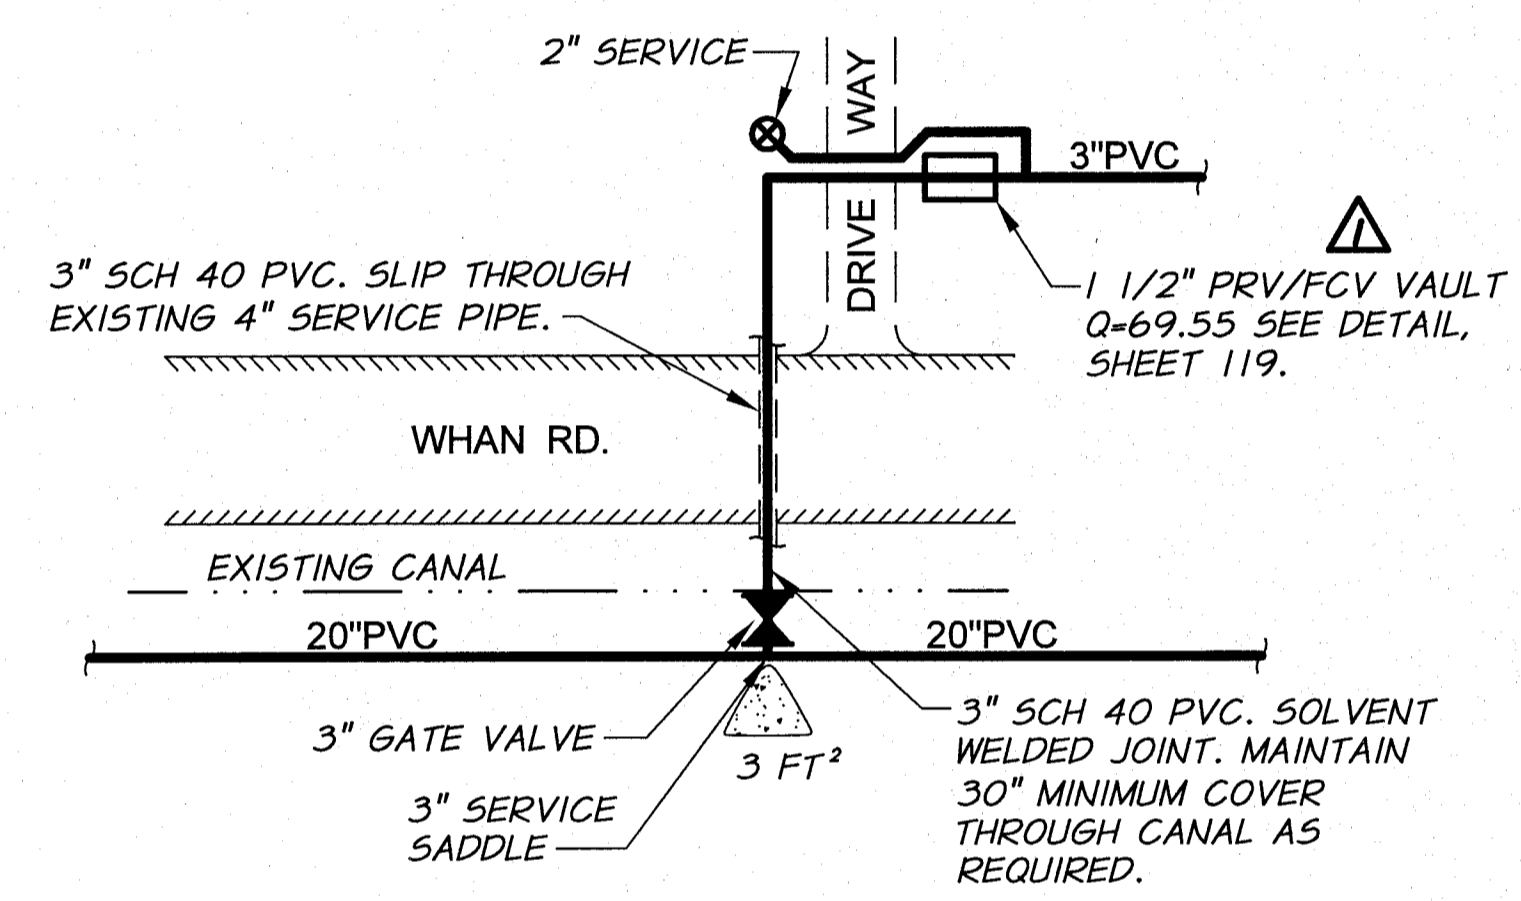


DETAIL BD
REFERENCE SHEET: 52

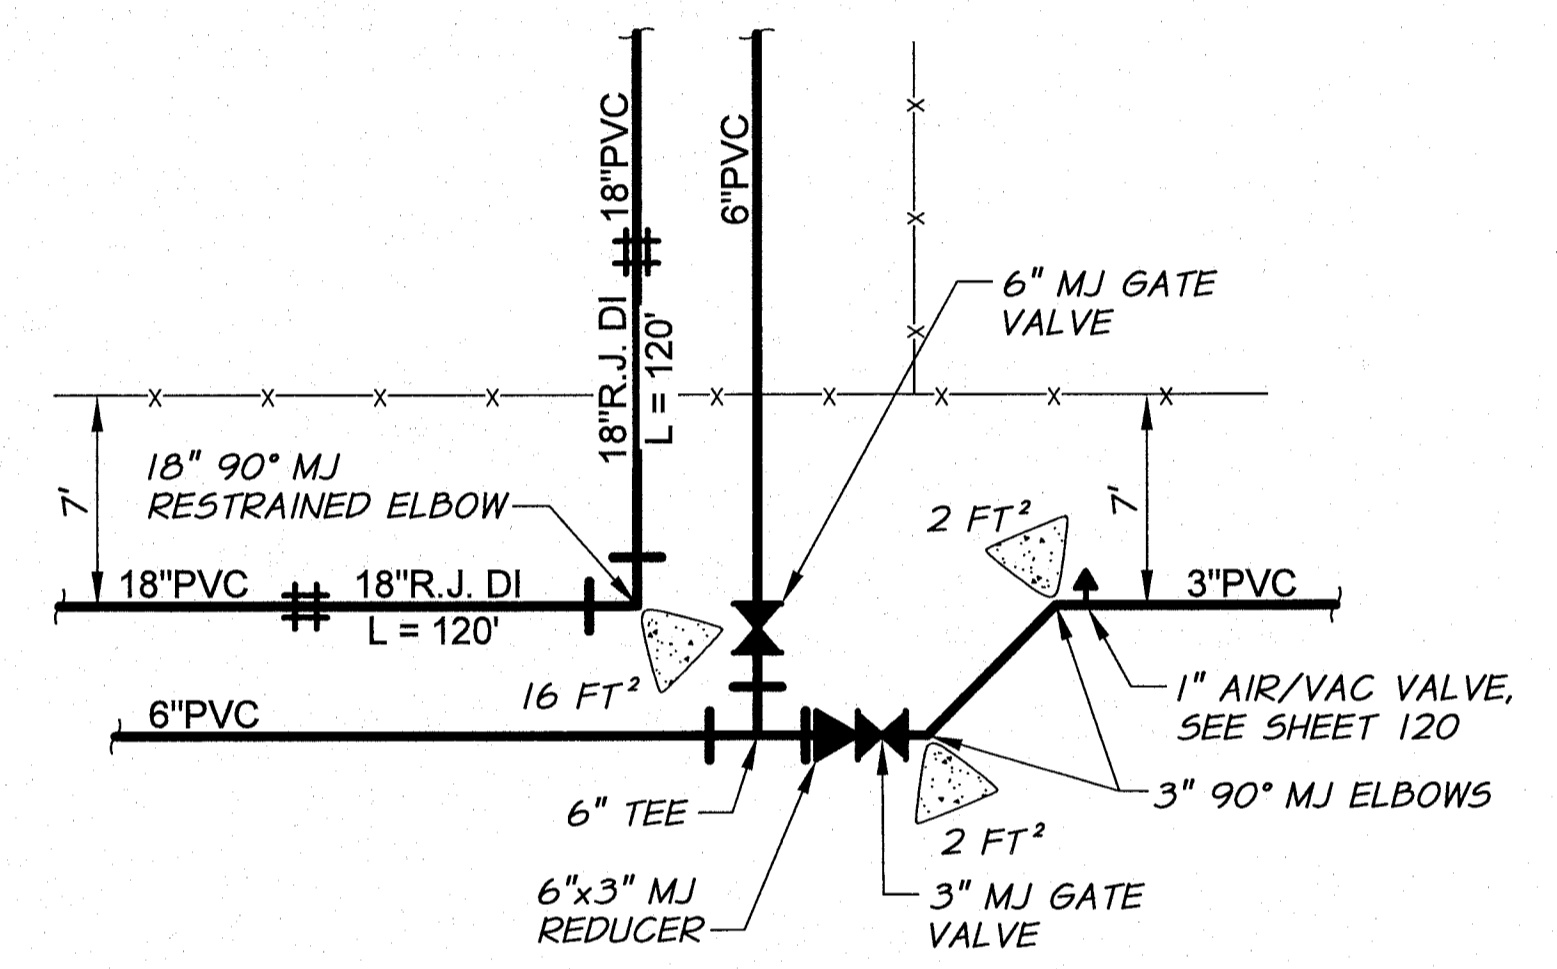


DETAIL BE
REFERENCE SHEET: 53, 62

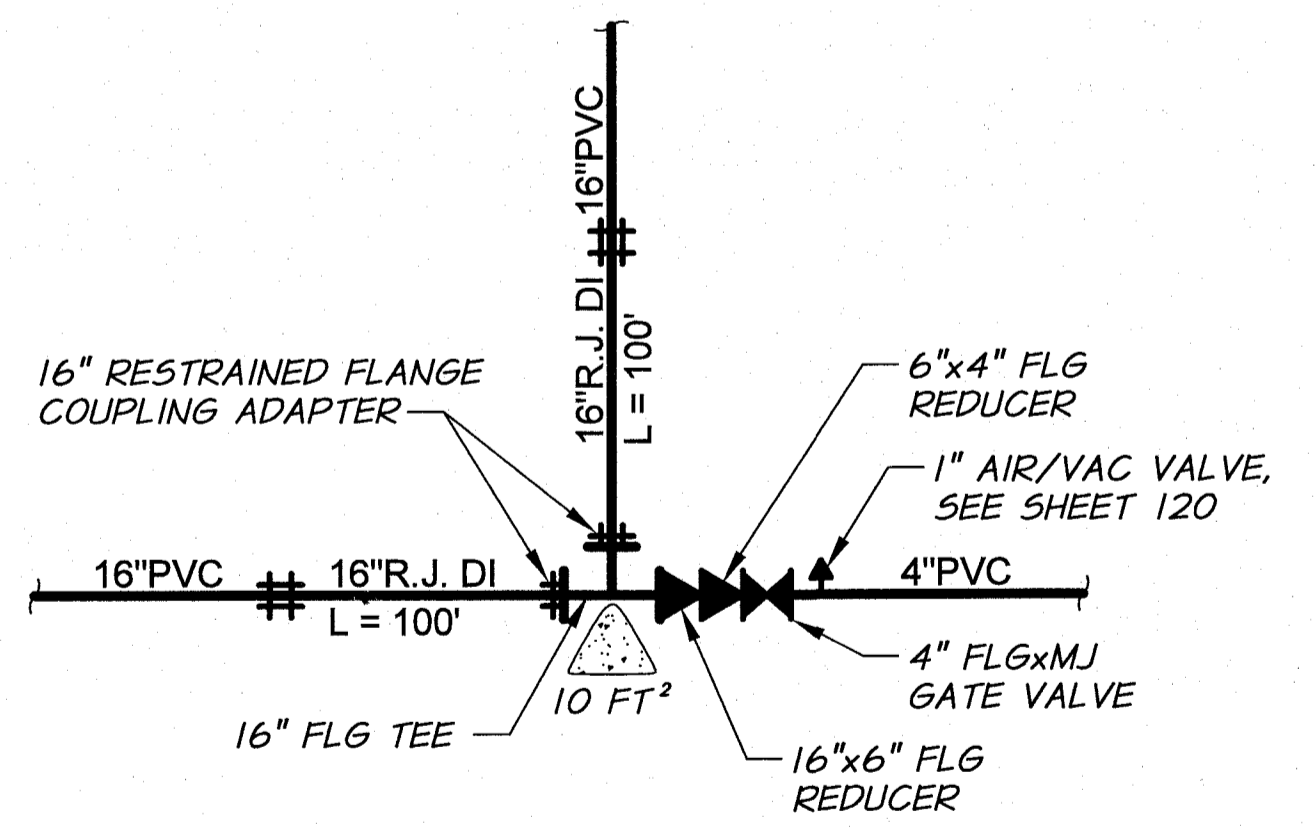

DETAIL BF
REFERENCE SHEET: 55, 57

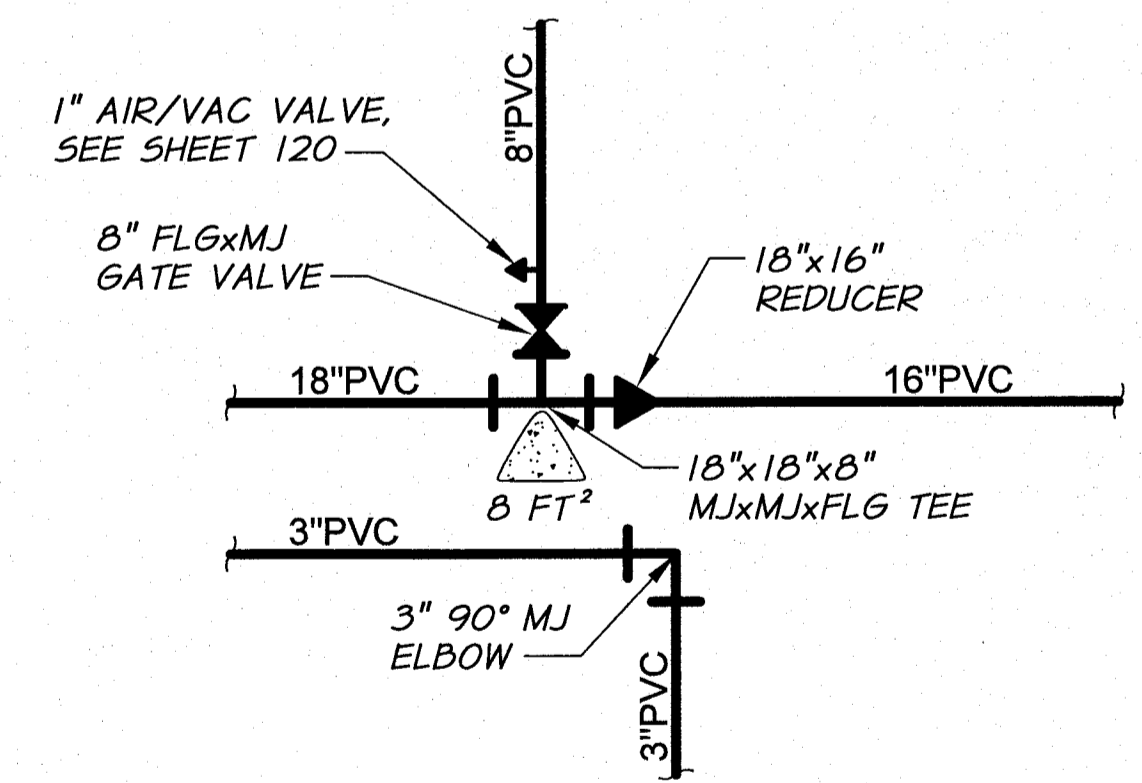

DETAIL BG
REFERENCE SHEET: 55, 61, 63

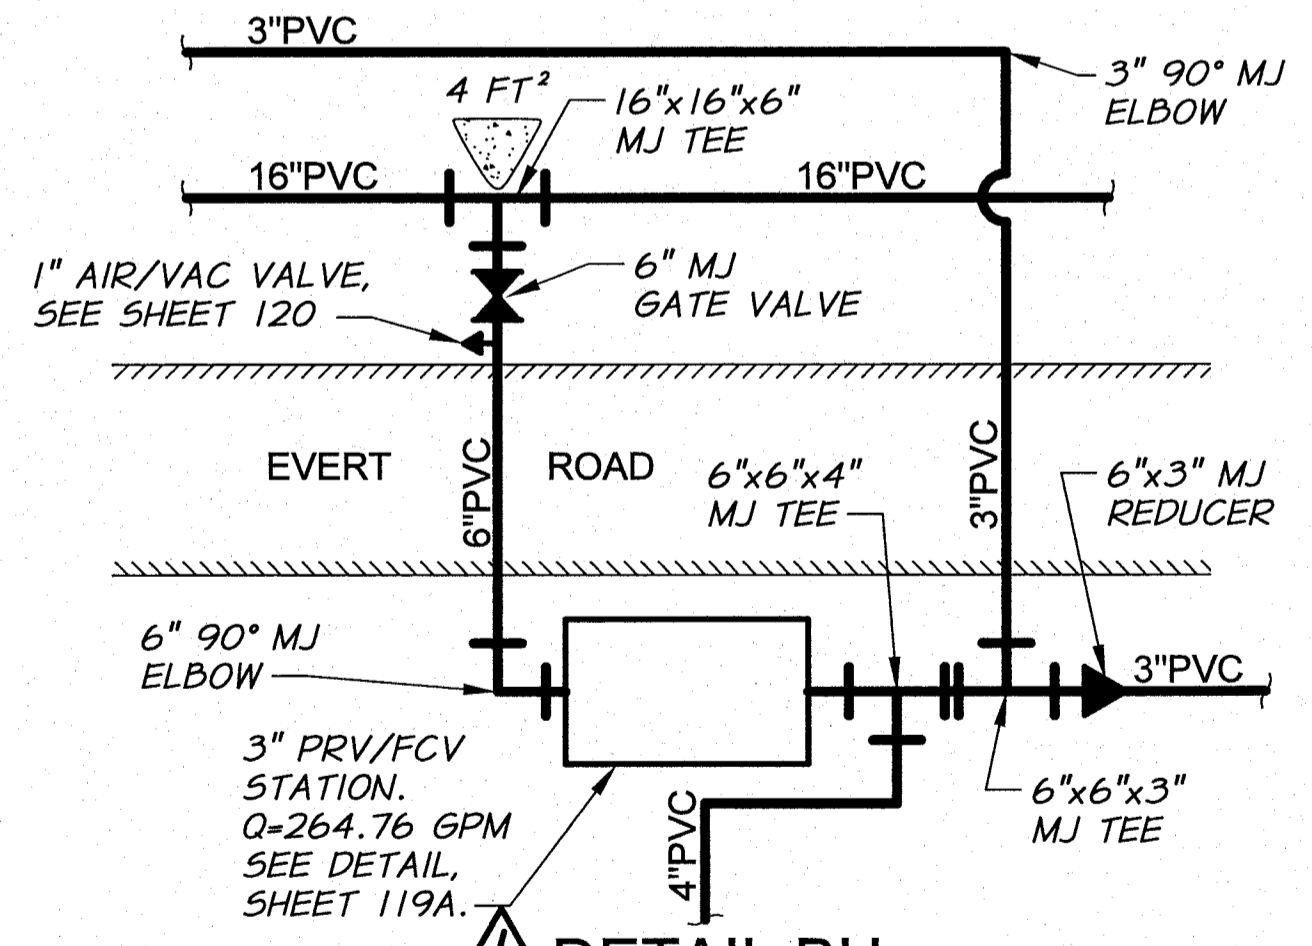


DETAIL BH
REFERENCE SHEET: 56, 60




RECORD DRAWING		E.H. 12/11	
DESIGNED BY	R. HARRIS	XREFS:	TB-BID.dwg
DRAWN BY	E. ARNTZ	JOB NUMBER	1199-336
REVIEWED BY	H. PERRY	DATE	2009
		ACAD FILE	WATERPIPINGDETS.dwg
COPYRIGHT 2009 BY ANDERSON-PERRY & ASSOC., INC.			


RECORD DRAWINGS
These record drawings have been prepared, in part, on the basis of information compiled and furnished by others. They may contain some discrepancies and omissions, and do not necessarily represent "exact" field conditions. The Owner and the Engineer accept no responsibility for their accuracy.

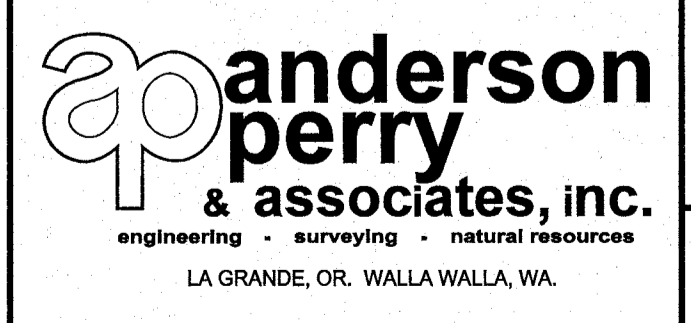


BENTON IRRIGATION DISTRICT
IRRIGATION SYSTEM IMPROVEMENTS
PHASE I
PIPE CONNECTION DETAILS III

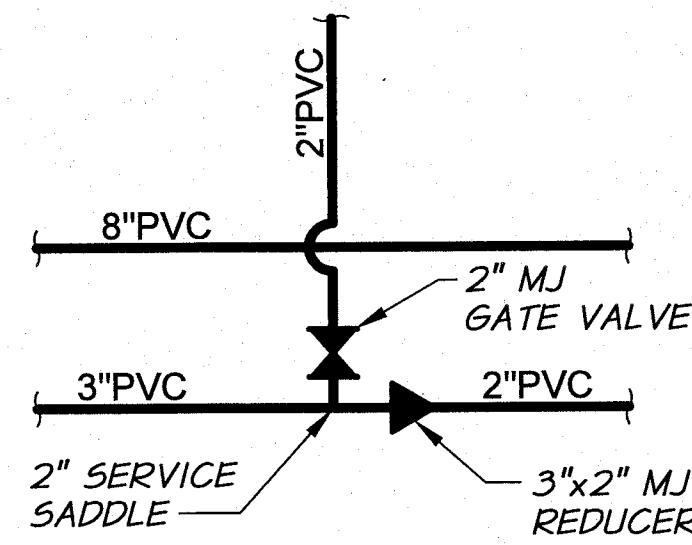


DETAIL BJ
REFERENCE SHEET: 63, 67

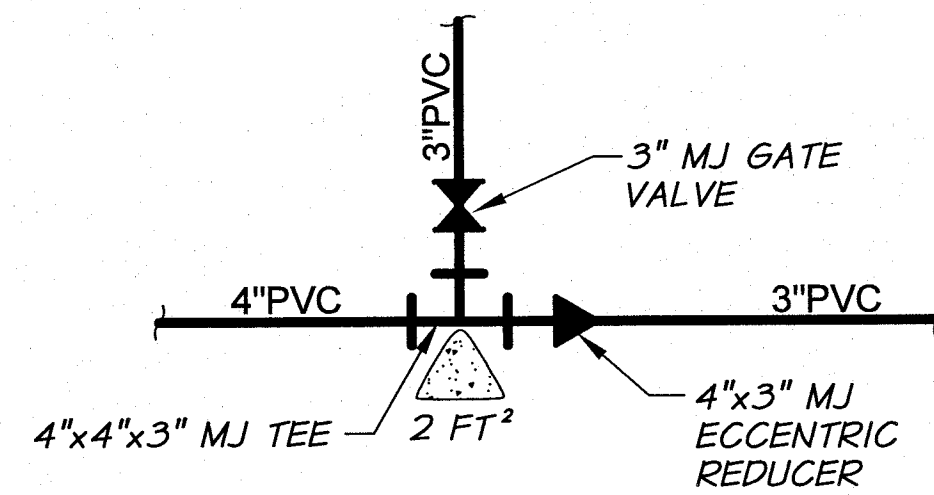


DETAIL BK
REFERENCE SHEET: 57, 59

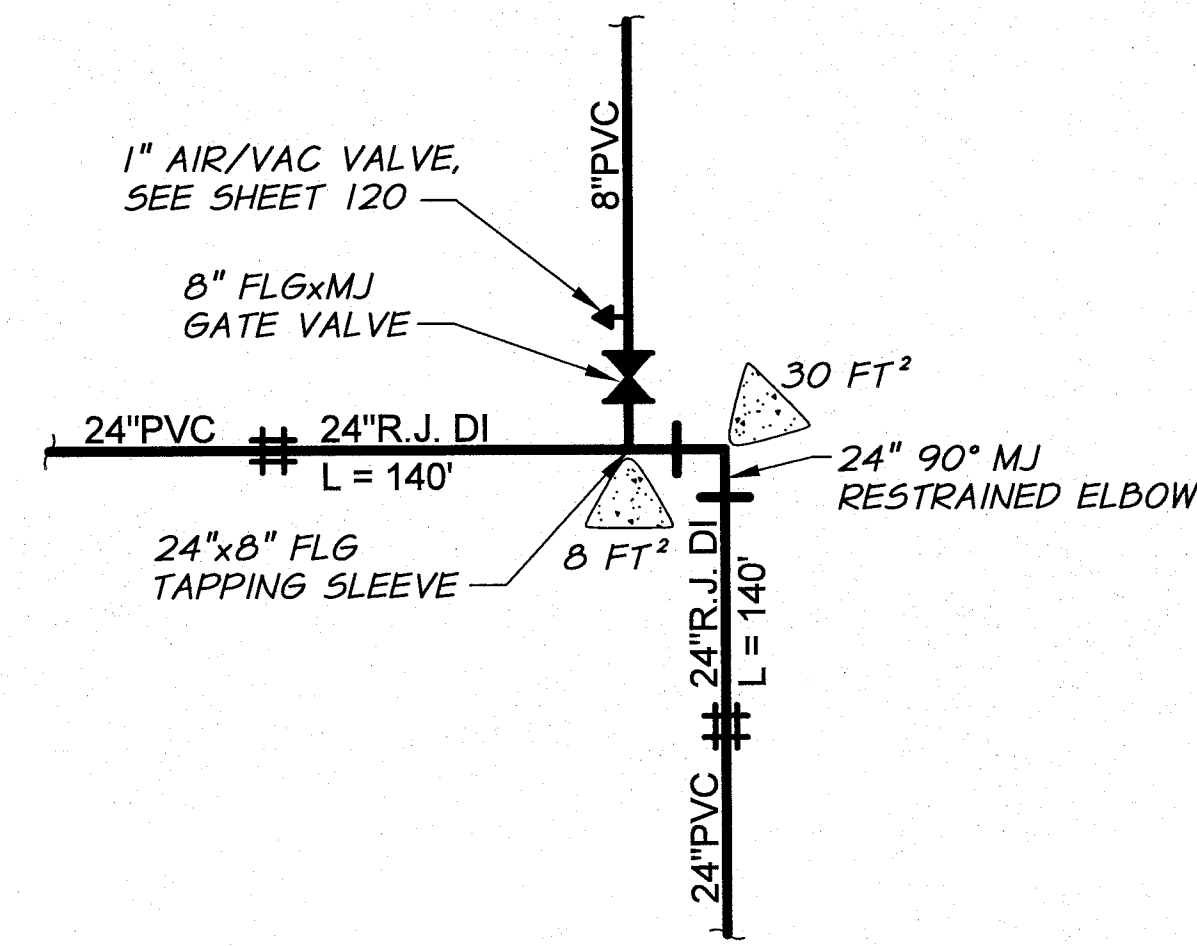


DETAIL BL
REFERENCE SHEET: 77, 93

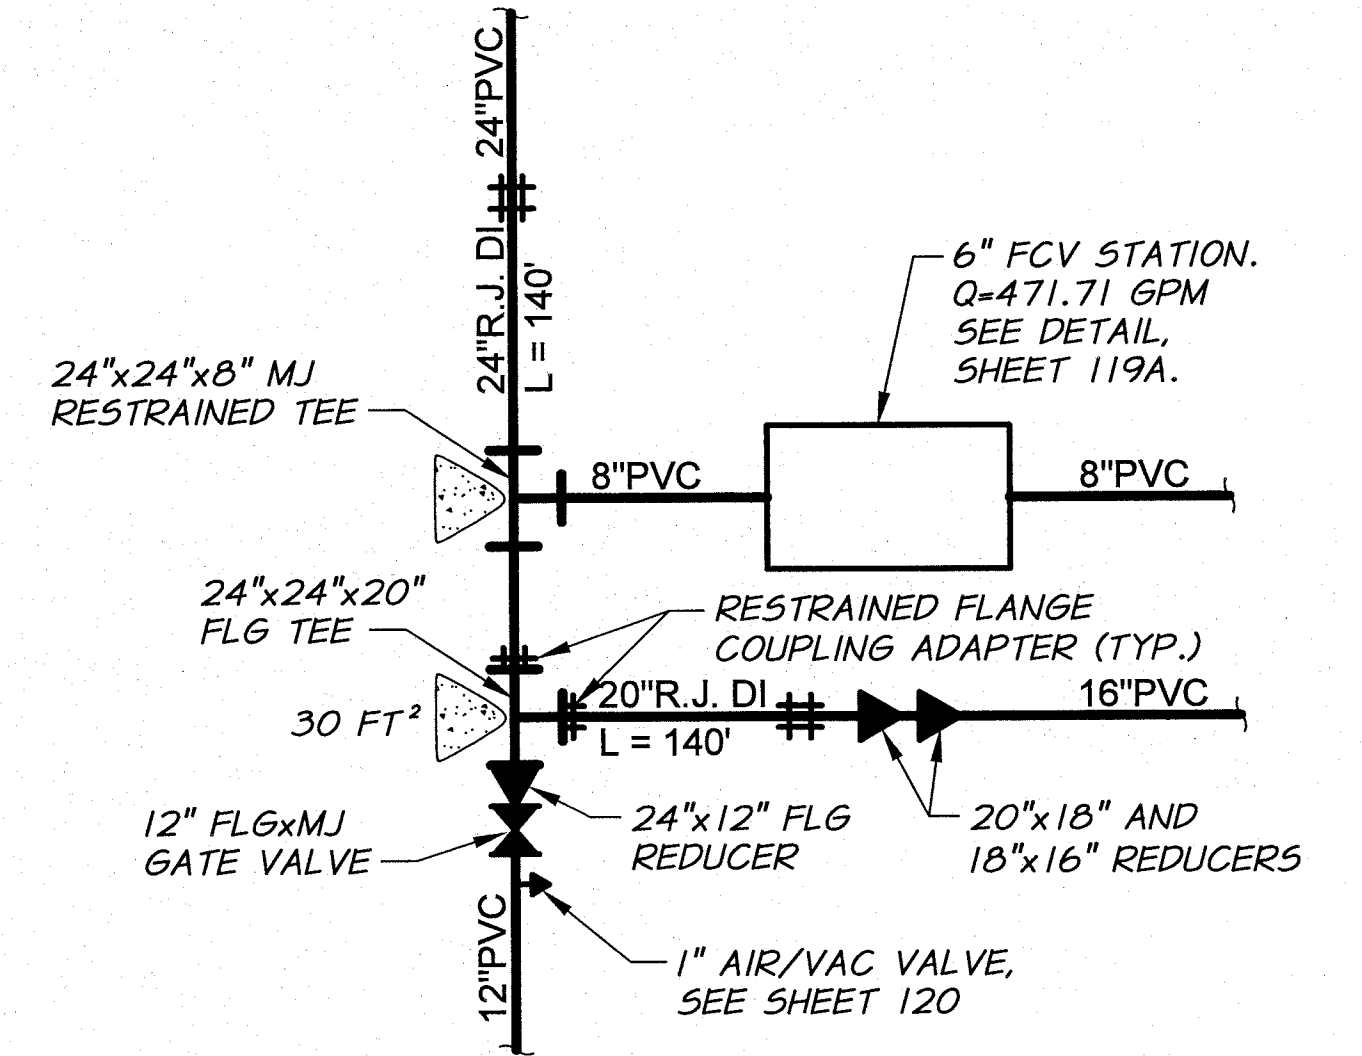


DETAIL BM
REFERENCE SHEET: 78, 92

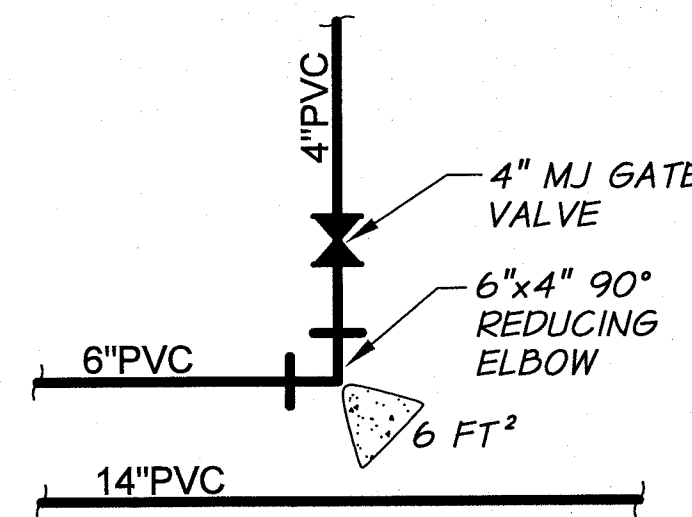


DETAIL BN
REFERENCE SHEET: 79, 88

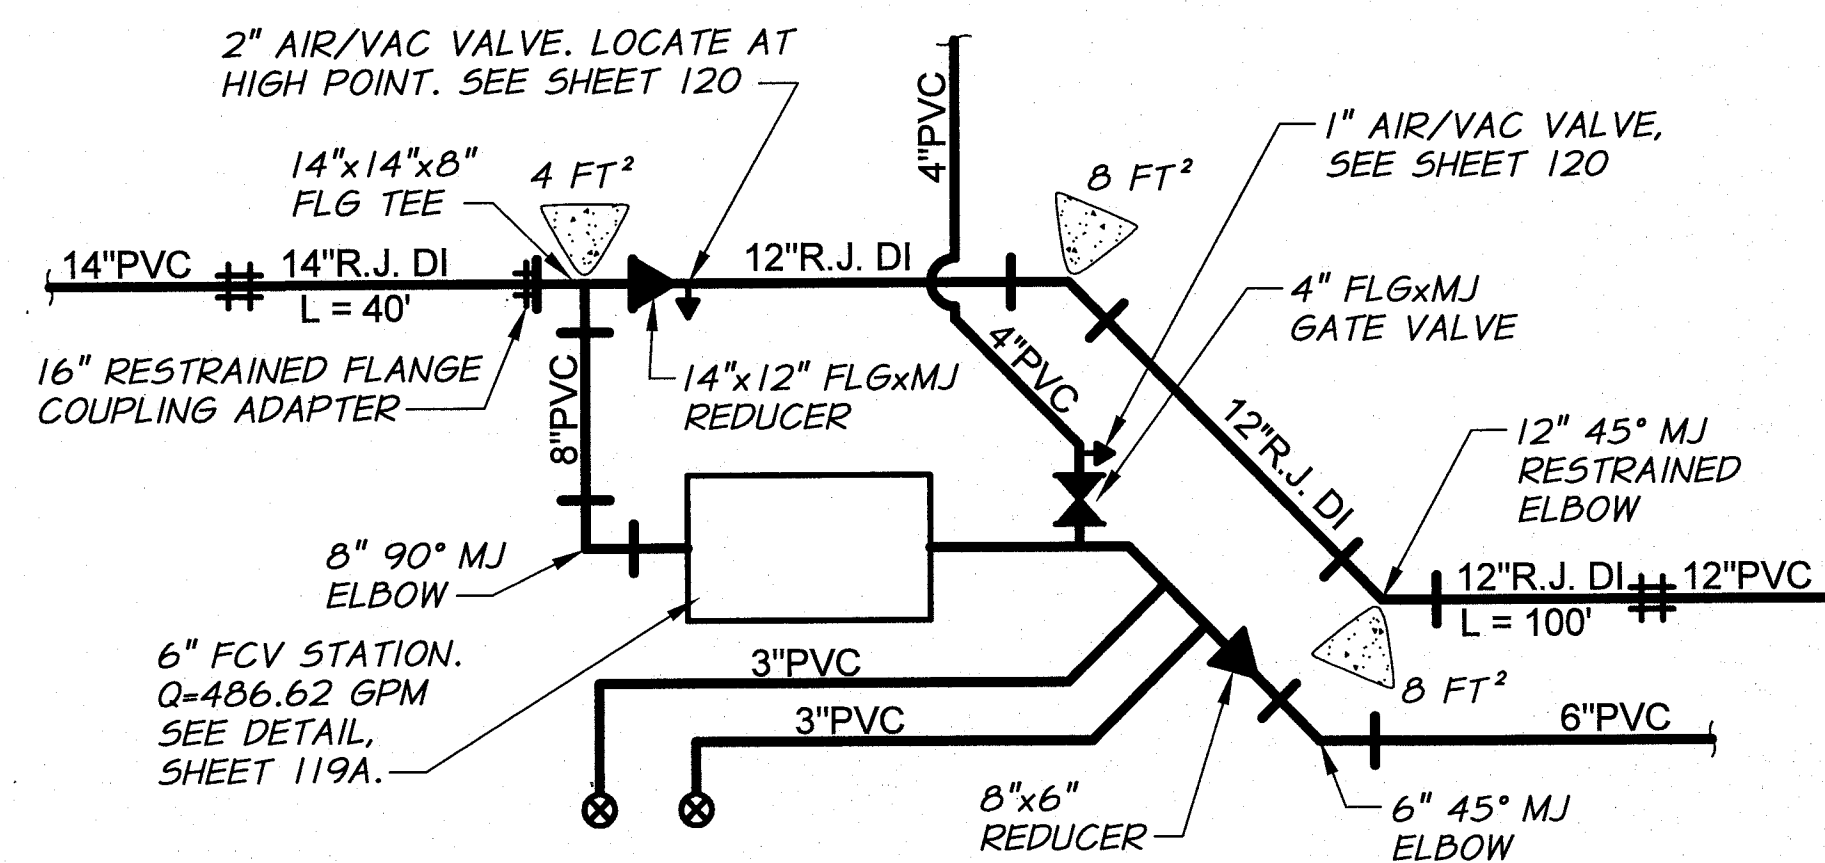


DETAIL BP
REFERENCE SHEET: 80, 87

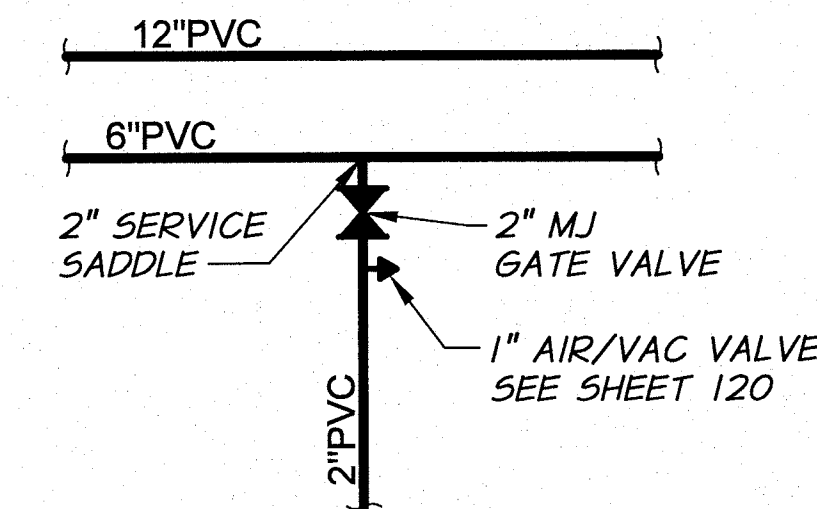


DETAIL BQ
REFERENCE SHEET: 80, 86

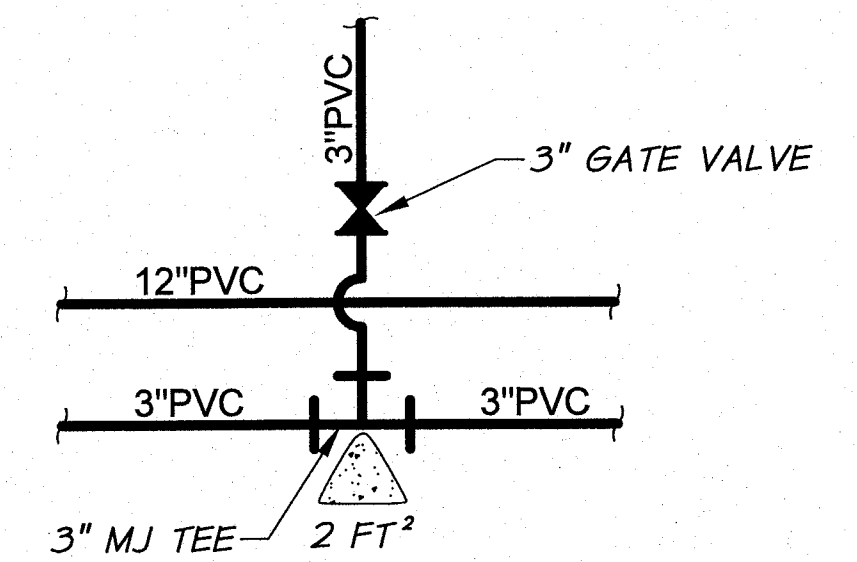


DETAIL BR
REFERENCE SHEET: 81, 85

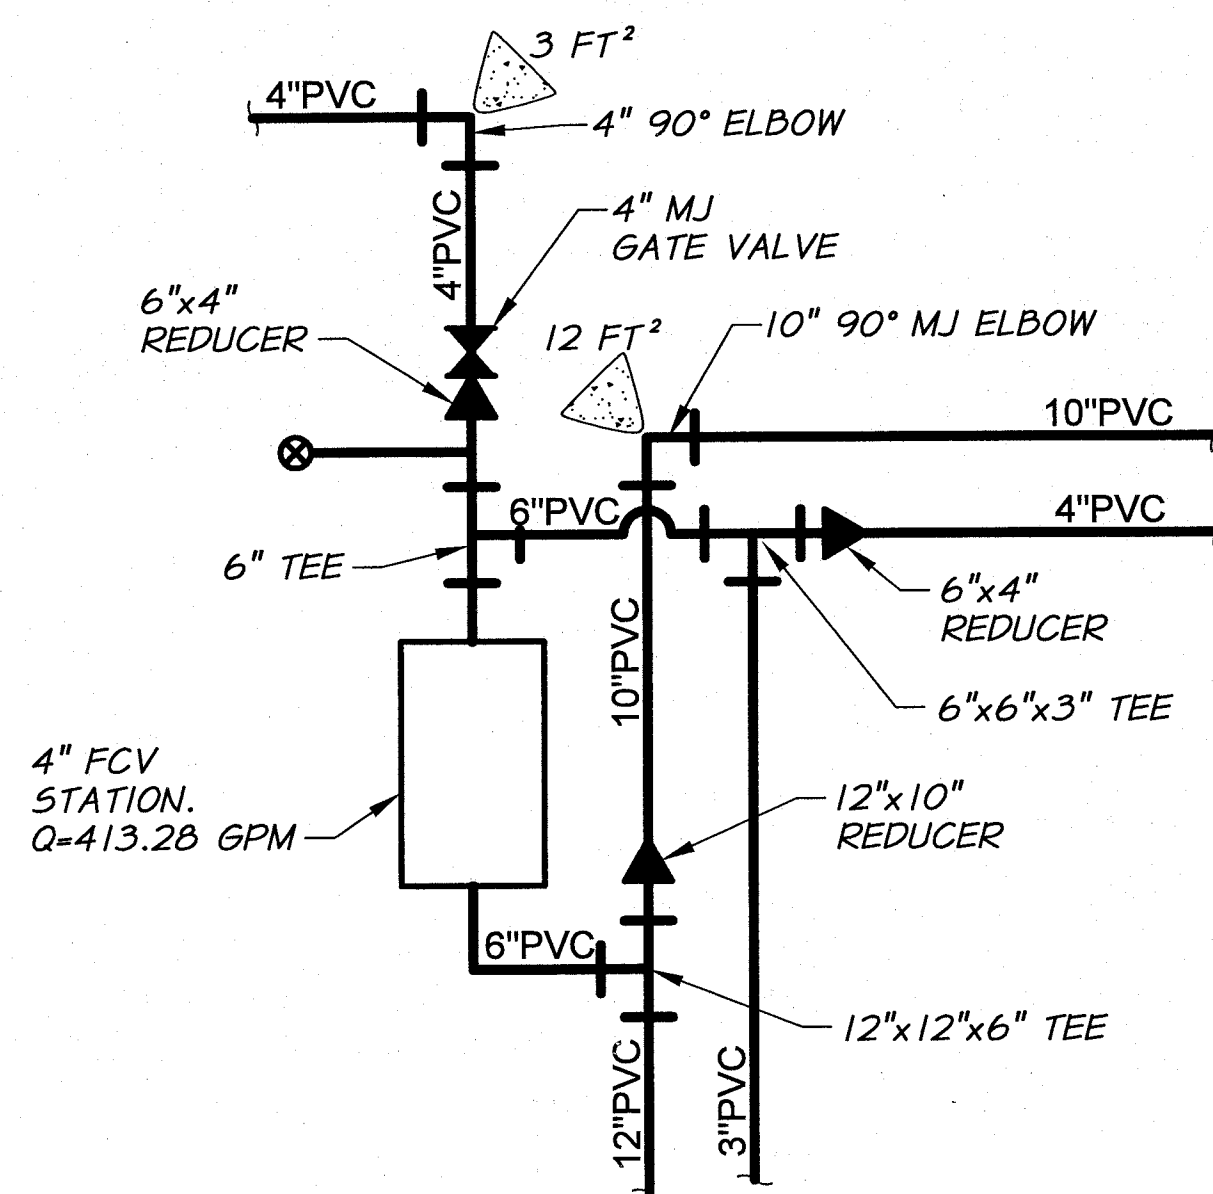


DETAIL BS
REFERENCE SHEET: 82, 84

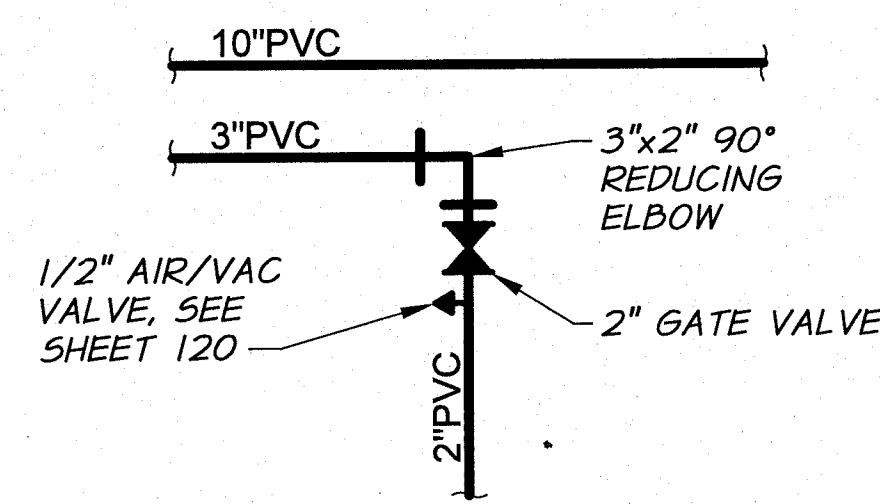


DETAIL BT
REFERENCE SHEET: 82, 83

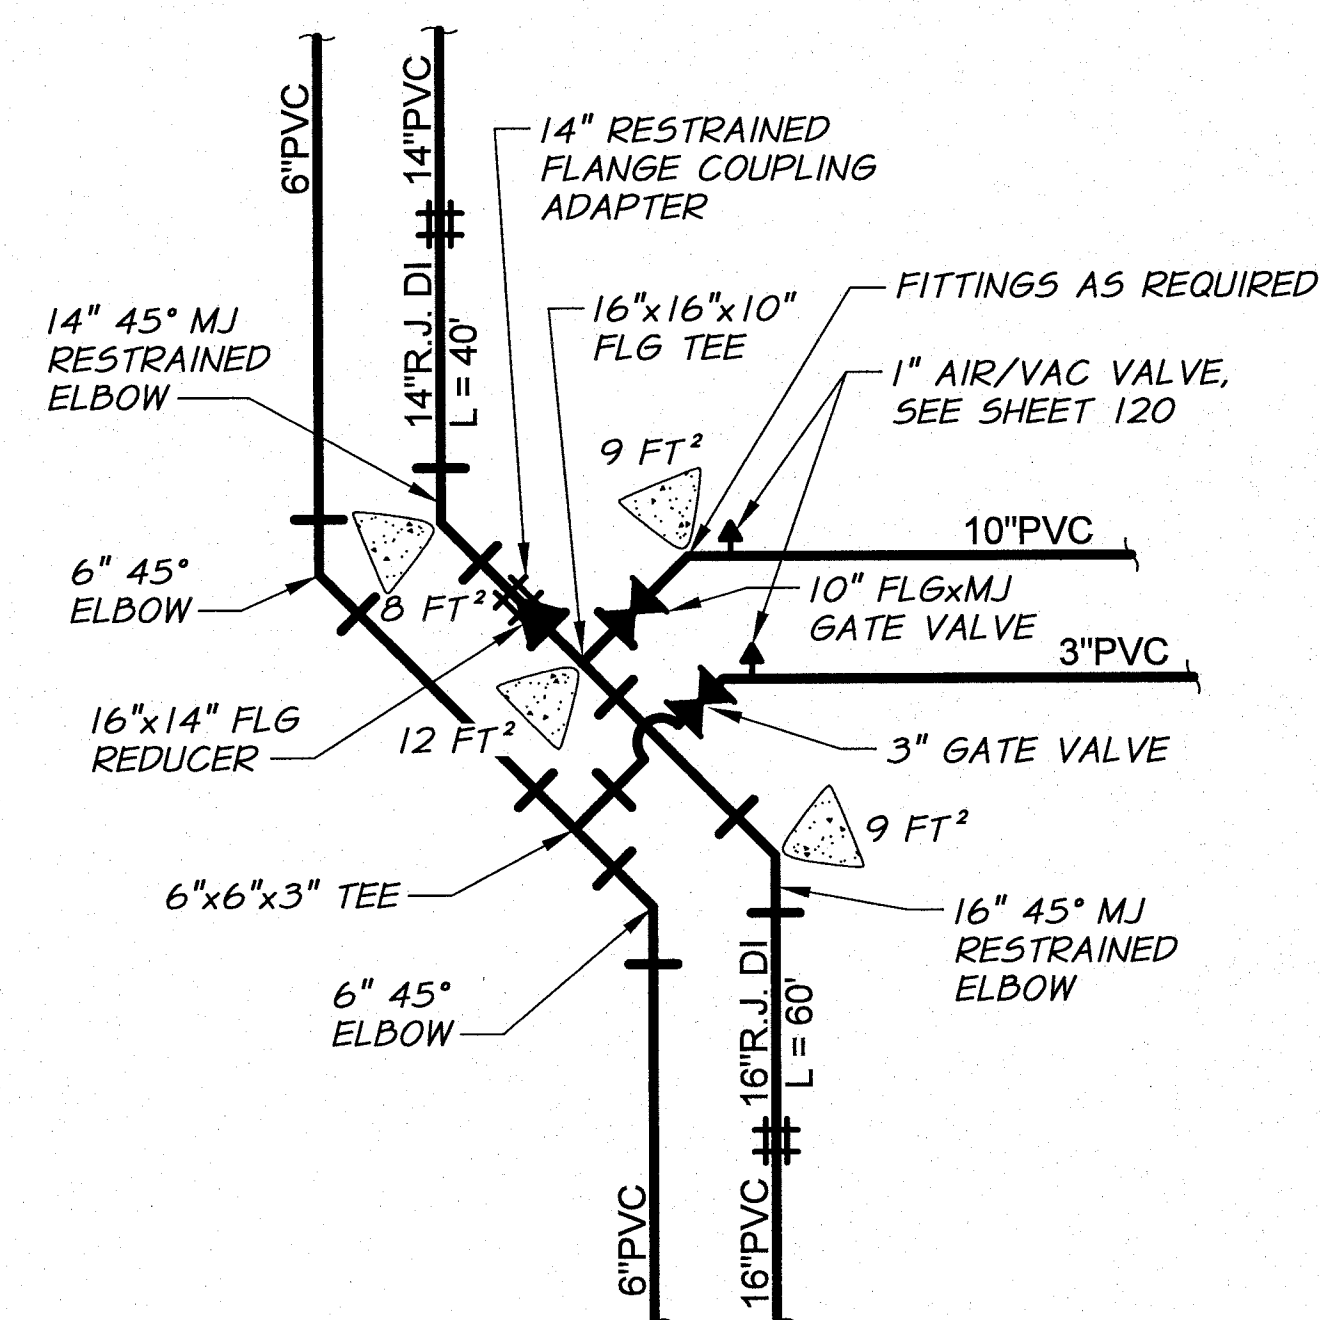

DETAIL BU
REFERENCE SHEET: 78, 90

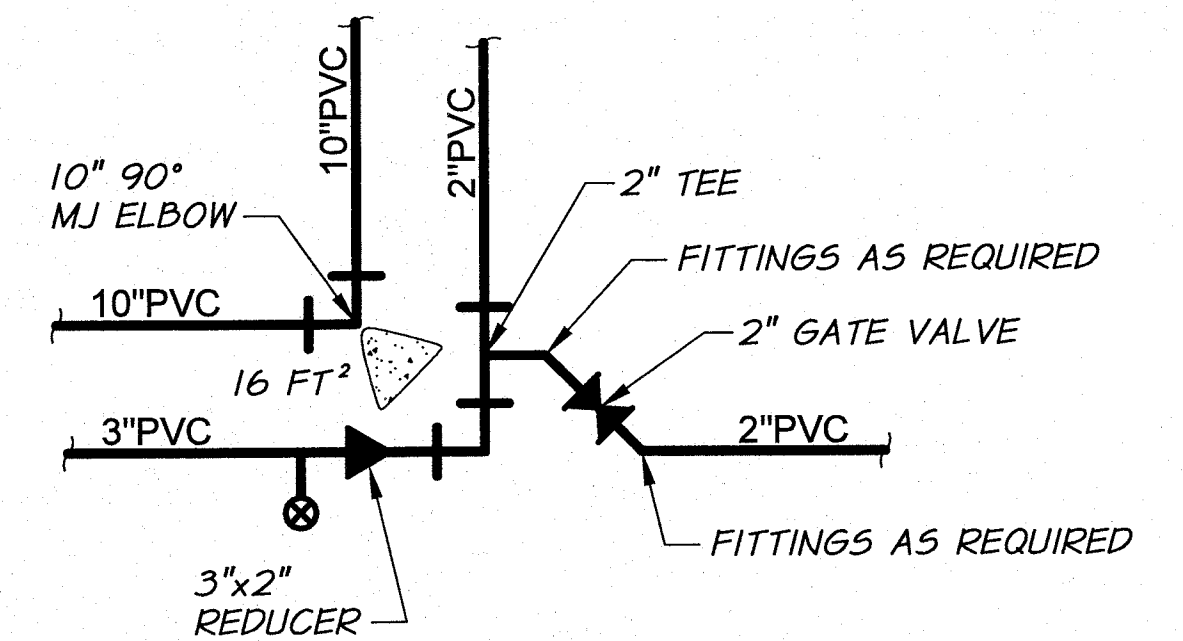


DETAIL BV
REFERENCE SHEET: 90

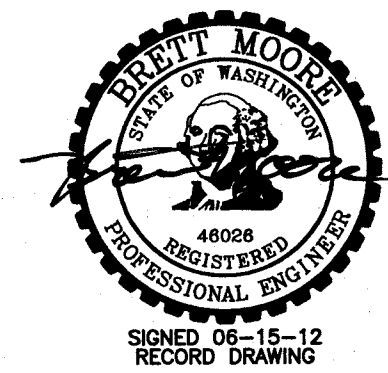

RECORD DRAWING		E.H.	12/11		
DESIGNED BY	R. HARRIS	XREFS:	TB-BID.dwg	HORIZ. SCALE	NONE
DRAWN BY	E. ARNTZ	JOB NUMBER	1199-336	DATE	2009
REVIEWED BY	H. PERRY	ACAD FILE:	WATERPIPINGDETS.dwg	VERT. SCALE	
COPYRIGHT 2009 BY ANDERSON-PERRY & ASSOC., INC.					

RECORD DRAWINGS

These record drawings have been prepared, in part, on the basis of information compiled and furnished by others. They may contain some discrepancies and omissions, and do not necessarily represent "exact" field conditions. The Owner and the Engineer accept no responsibility for their accuracy.

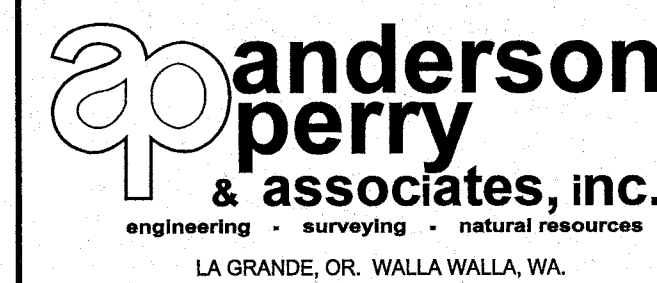


**BENTON IRRIGATION DISTRICT
IRRIGATION SYSTEM IMPROVEMENTS
PHASE I**

PIPE CONNECTION DETAILS IV


SHEET

115


(DETAIL ELIMINATED)

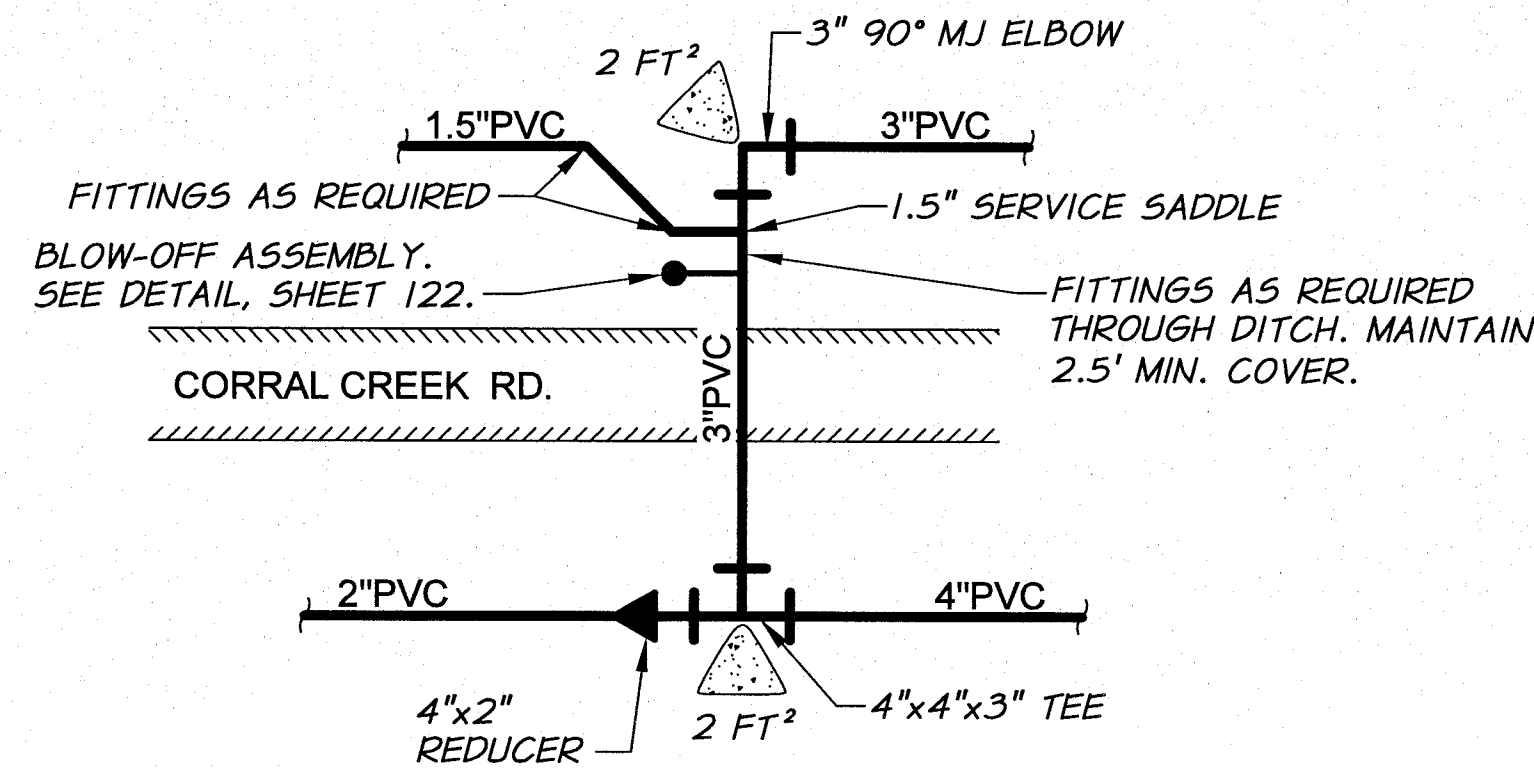

DETAIL BY
REFERENCE SHEET: 94

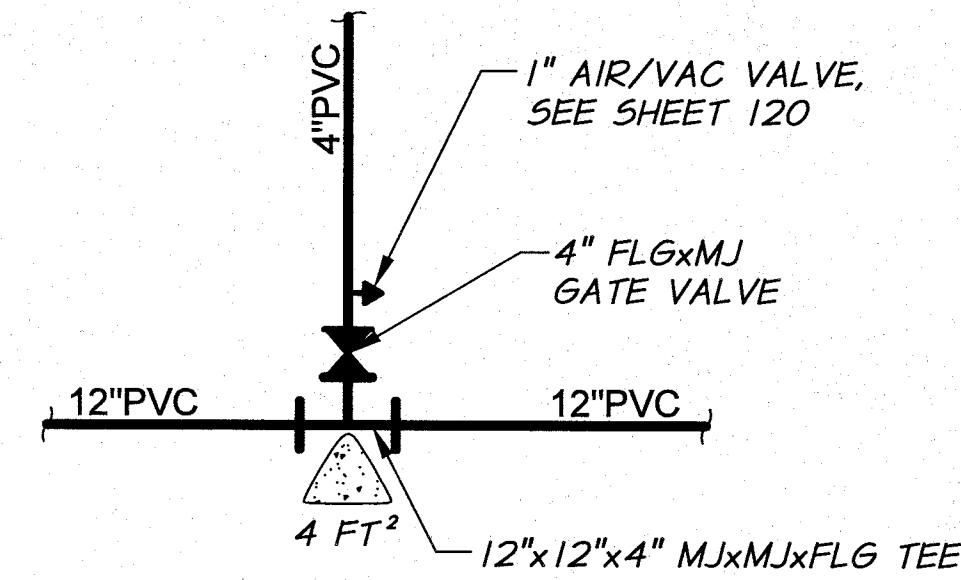


DETAIL BZ
REFERENCE SHEET: 97, 104

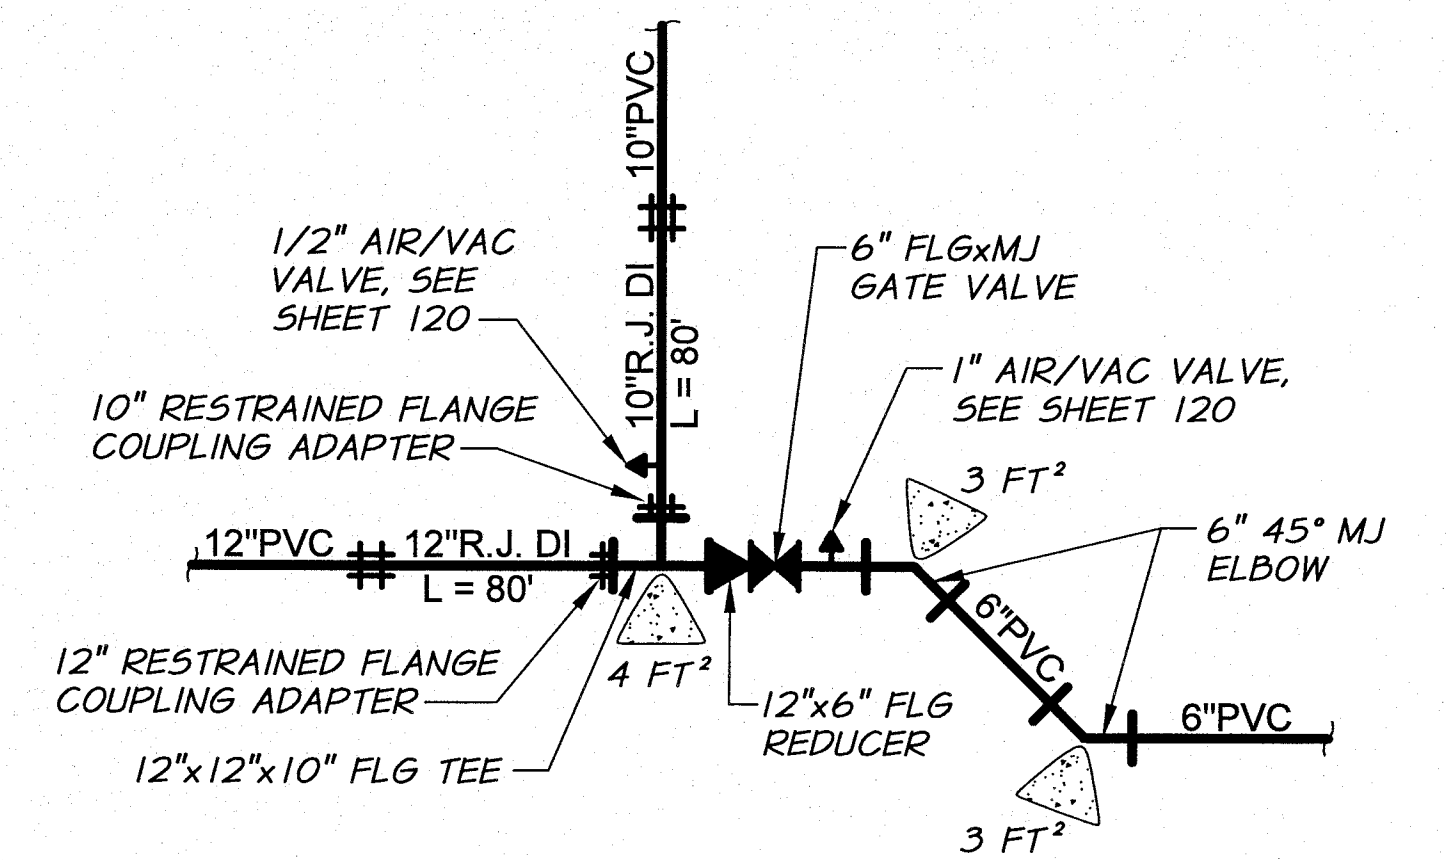


DETAIL CA
REFERENCE SHEET: 99, 103

DETAIL BW
REFERENCE SHEET: 91

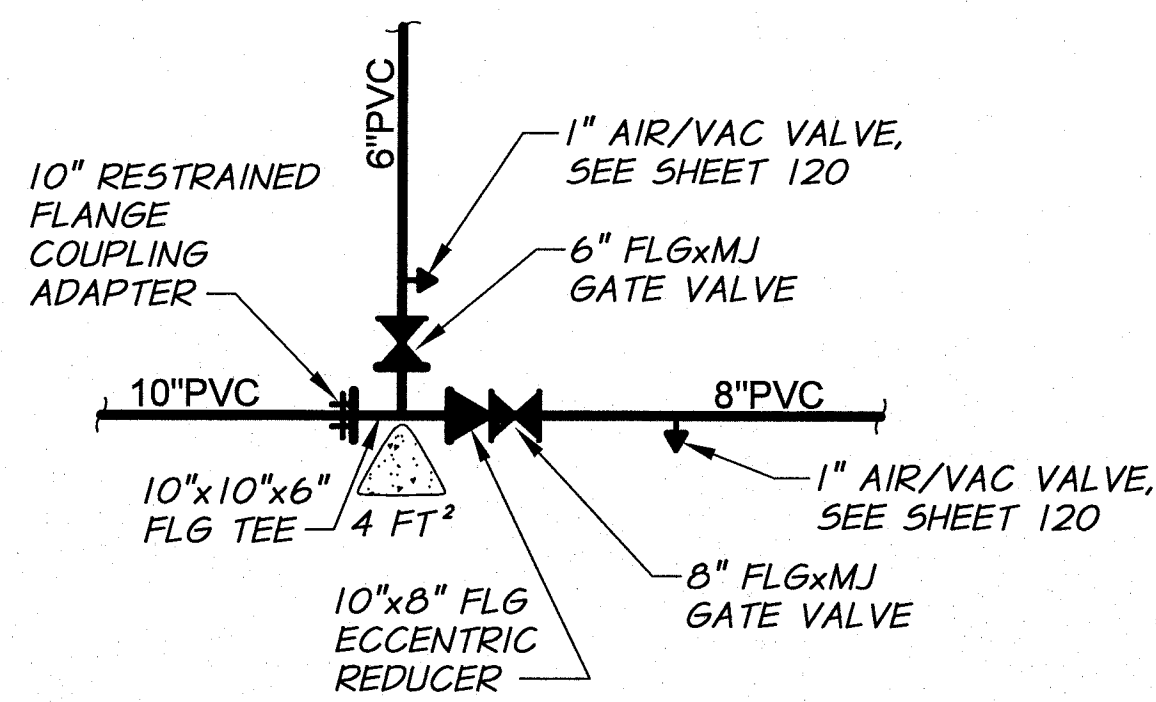


DETAIL CB
REFERENCE SHEET: 101, 106

(DETAIL ELIMINATED)

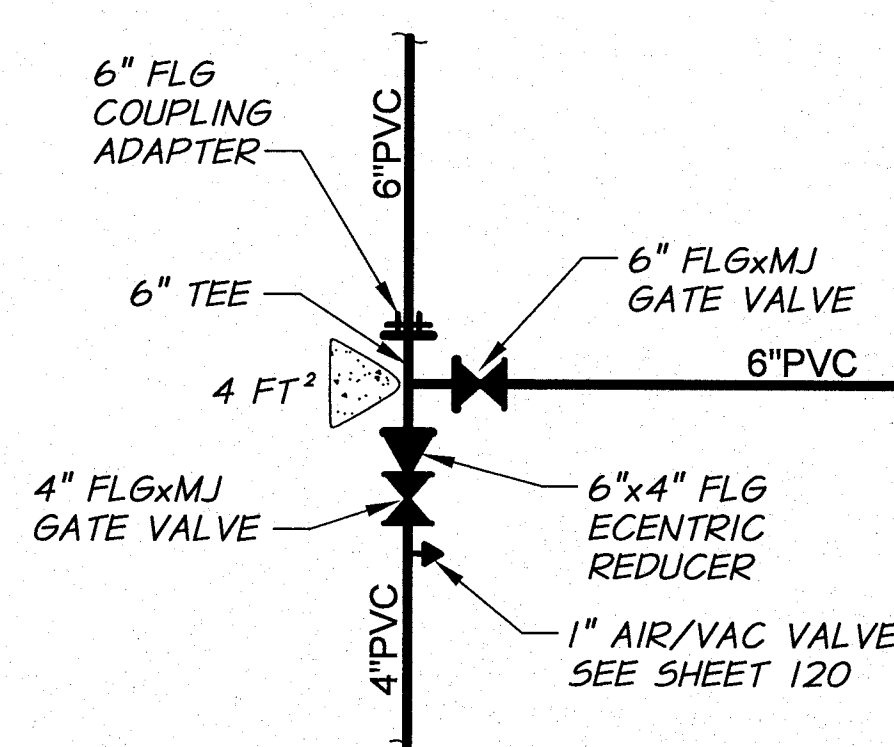


DETAIL CD
REFERENCE SHEET: 106, 110

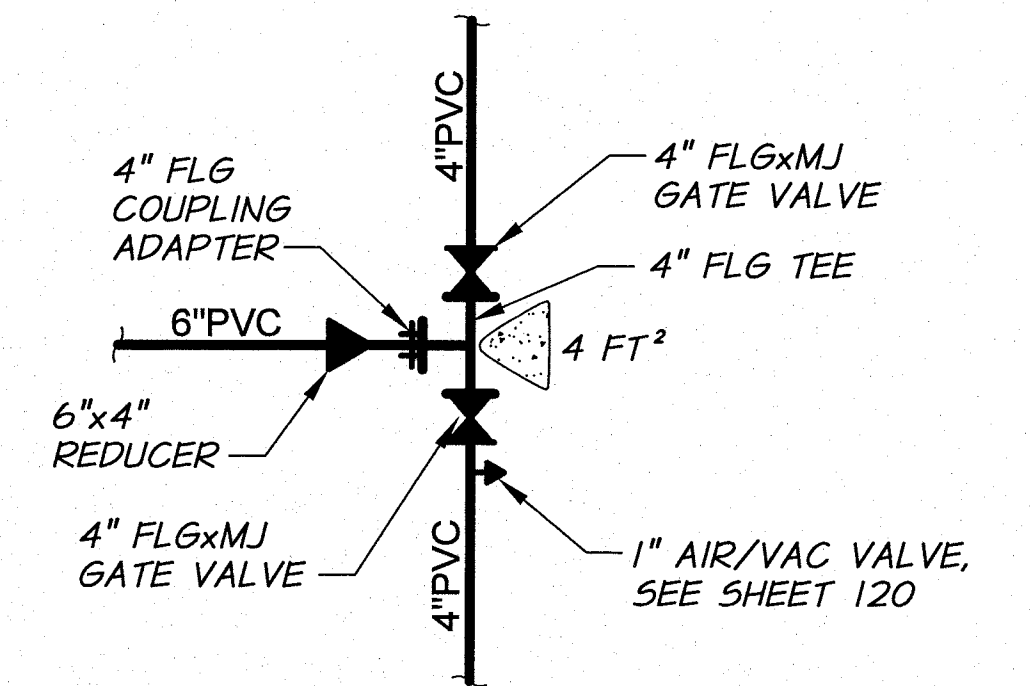


DETAIL CE
REFERENCE SHEET: 107, 109


DETAIL CC
REFERENCE SHEET: 102

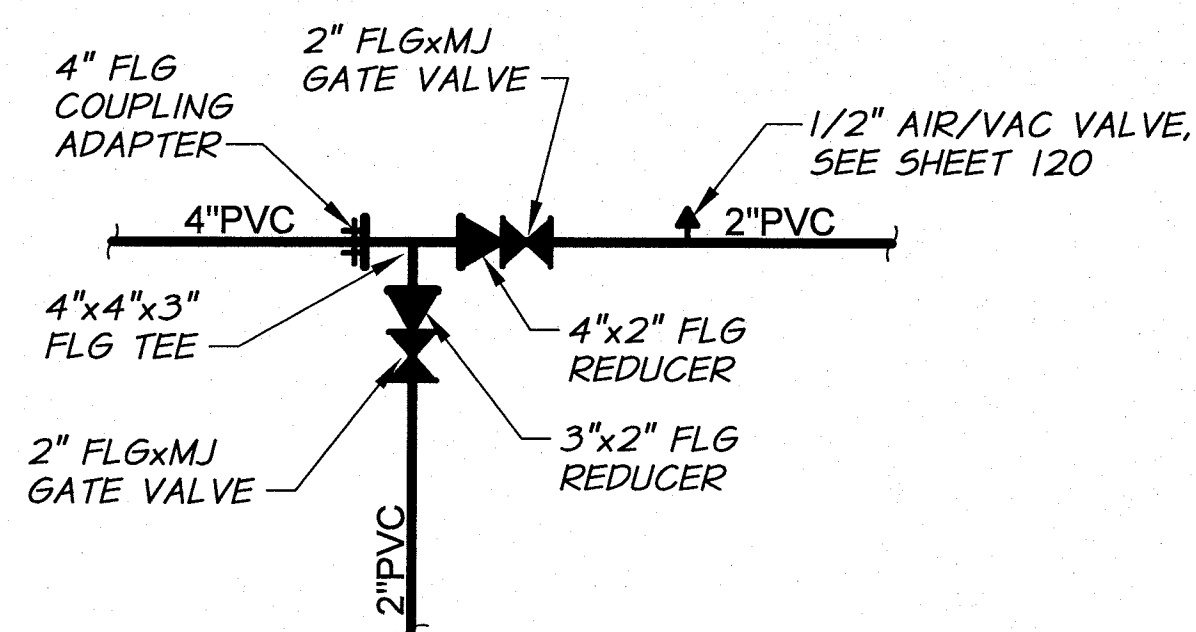


DETAIL CF
REFERENCE SHEET: 110, 111

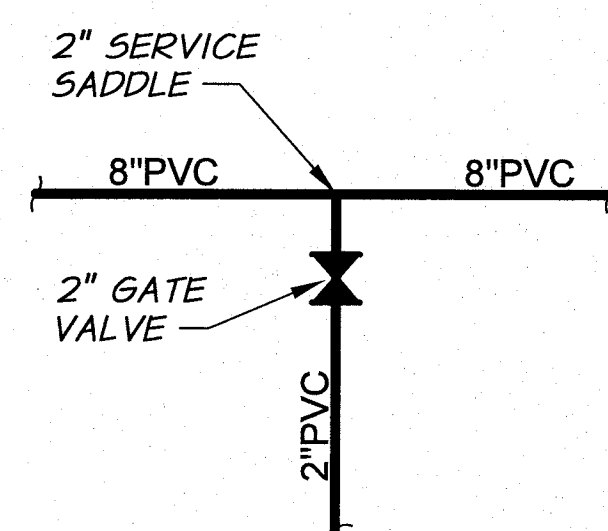


DETAIL CG
REFERENCE SHEET: 46, 50

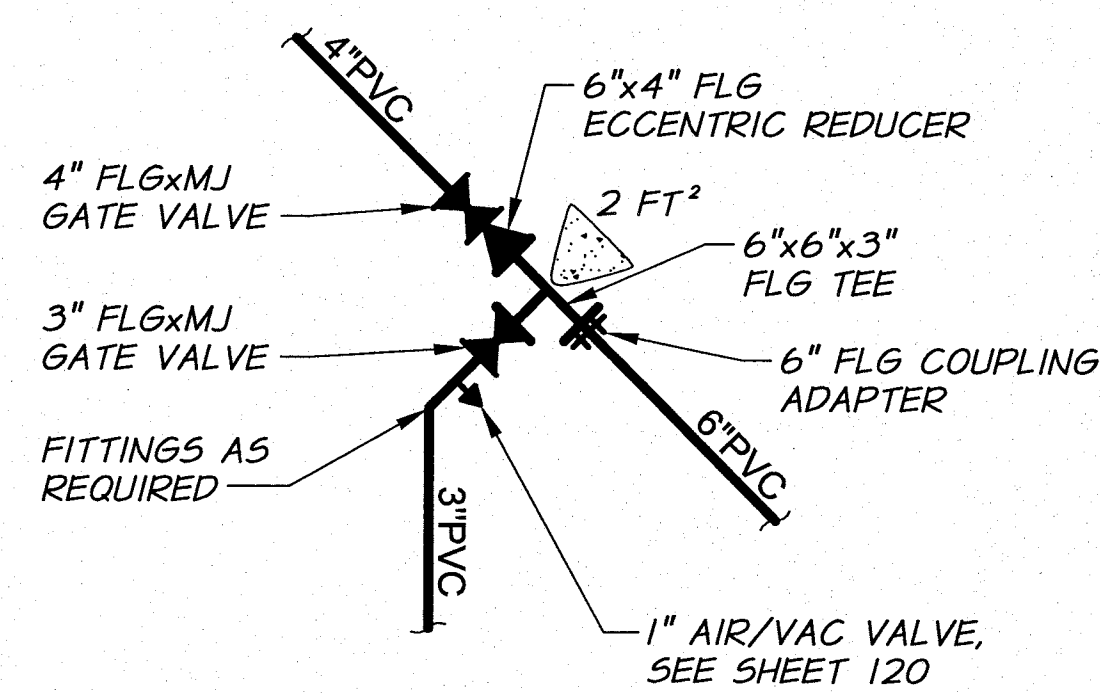

DETAIL CH
REFERENCE SHEET: 72, 74

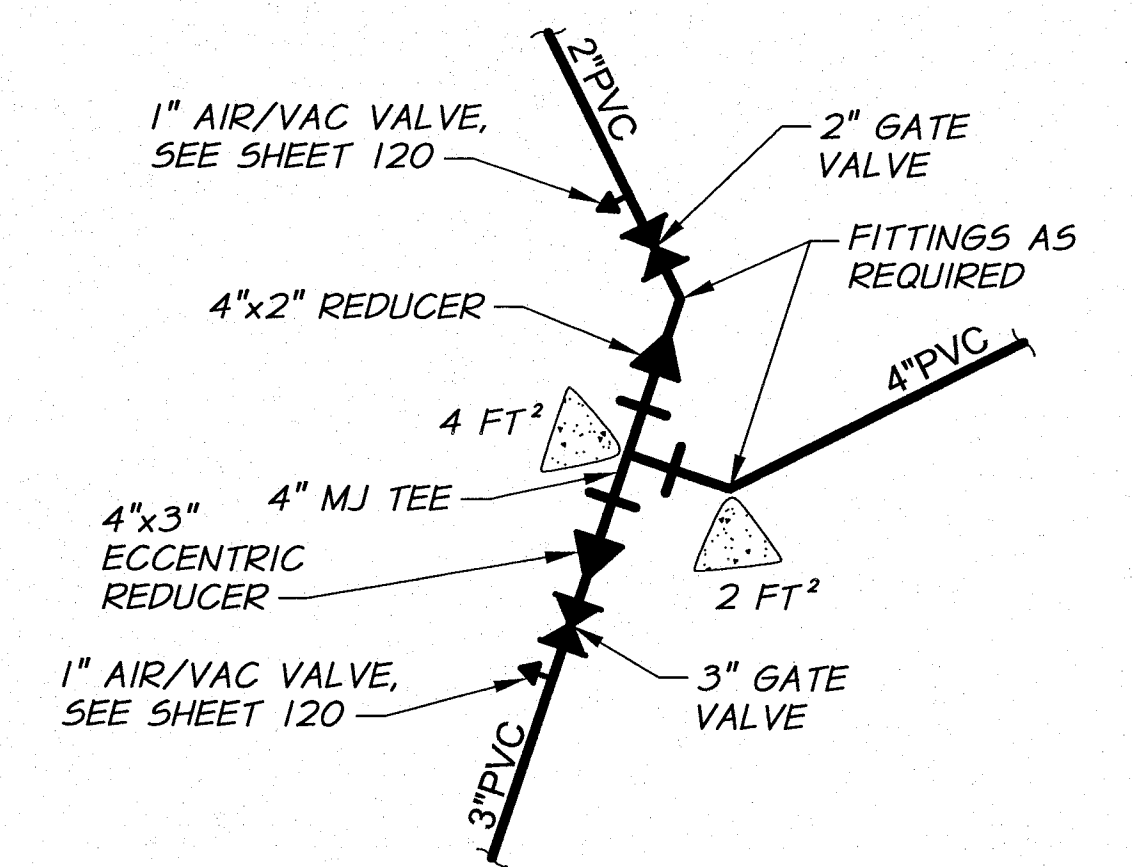


DETAIL CJ
REFERENCE SHEET: 73, 75

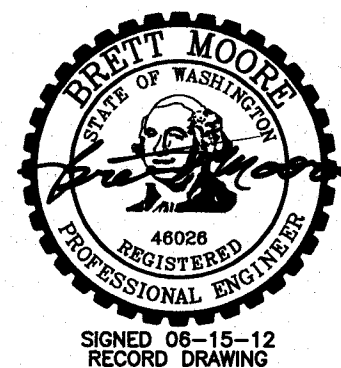

RECORD DRAWING		BY	E.H.	DATE	12/11
DESIGNED BY	R. HARRIS	XREFS:	TB-BID.dwg		
DRAWN BY	D. CHRISTMAN	JOB NUMBER	1199-336	DATE	2009
REVIEWED BY	H. PERRY	ACAD FILE	WATERPIPINGDETS.dwg		
COPYRIGHT 2009 BY ANDERSON-PERRY & ASSOC., INC.					

RECORD DRAWINGS

These record drawings have been prepared, in part, on the basis of information compiled and furnished by others. They may contain some discrepancies and omissions, and do not necessarily represent "exact" field conditions. The Owner and the Engineer accept no responsibility for their accuracy.

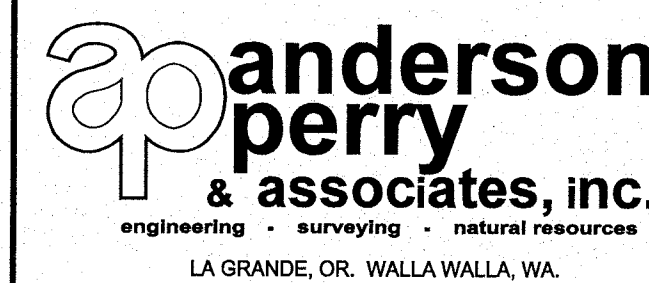


BENTON IRRIGATION DISTRICT
IRRIGATION SYSTEM IMPROVEMENTS
PHASE I

PIPE CONNECTION DETAILS V


SHEET

116


ARCHIVED

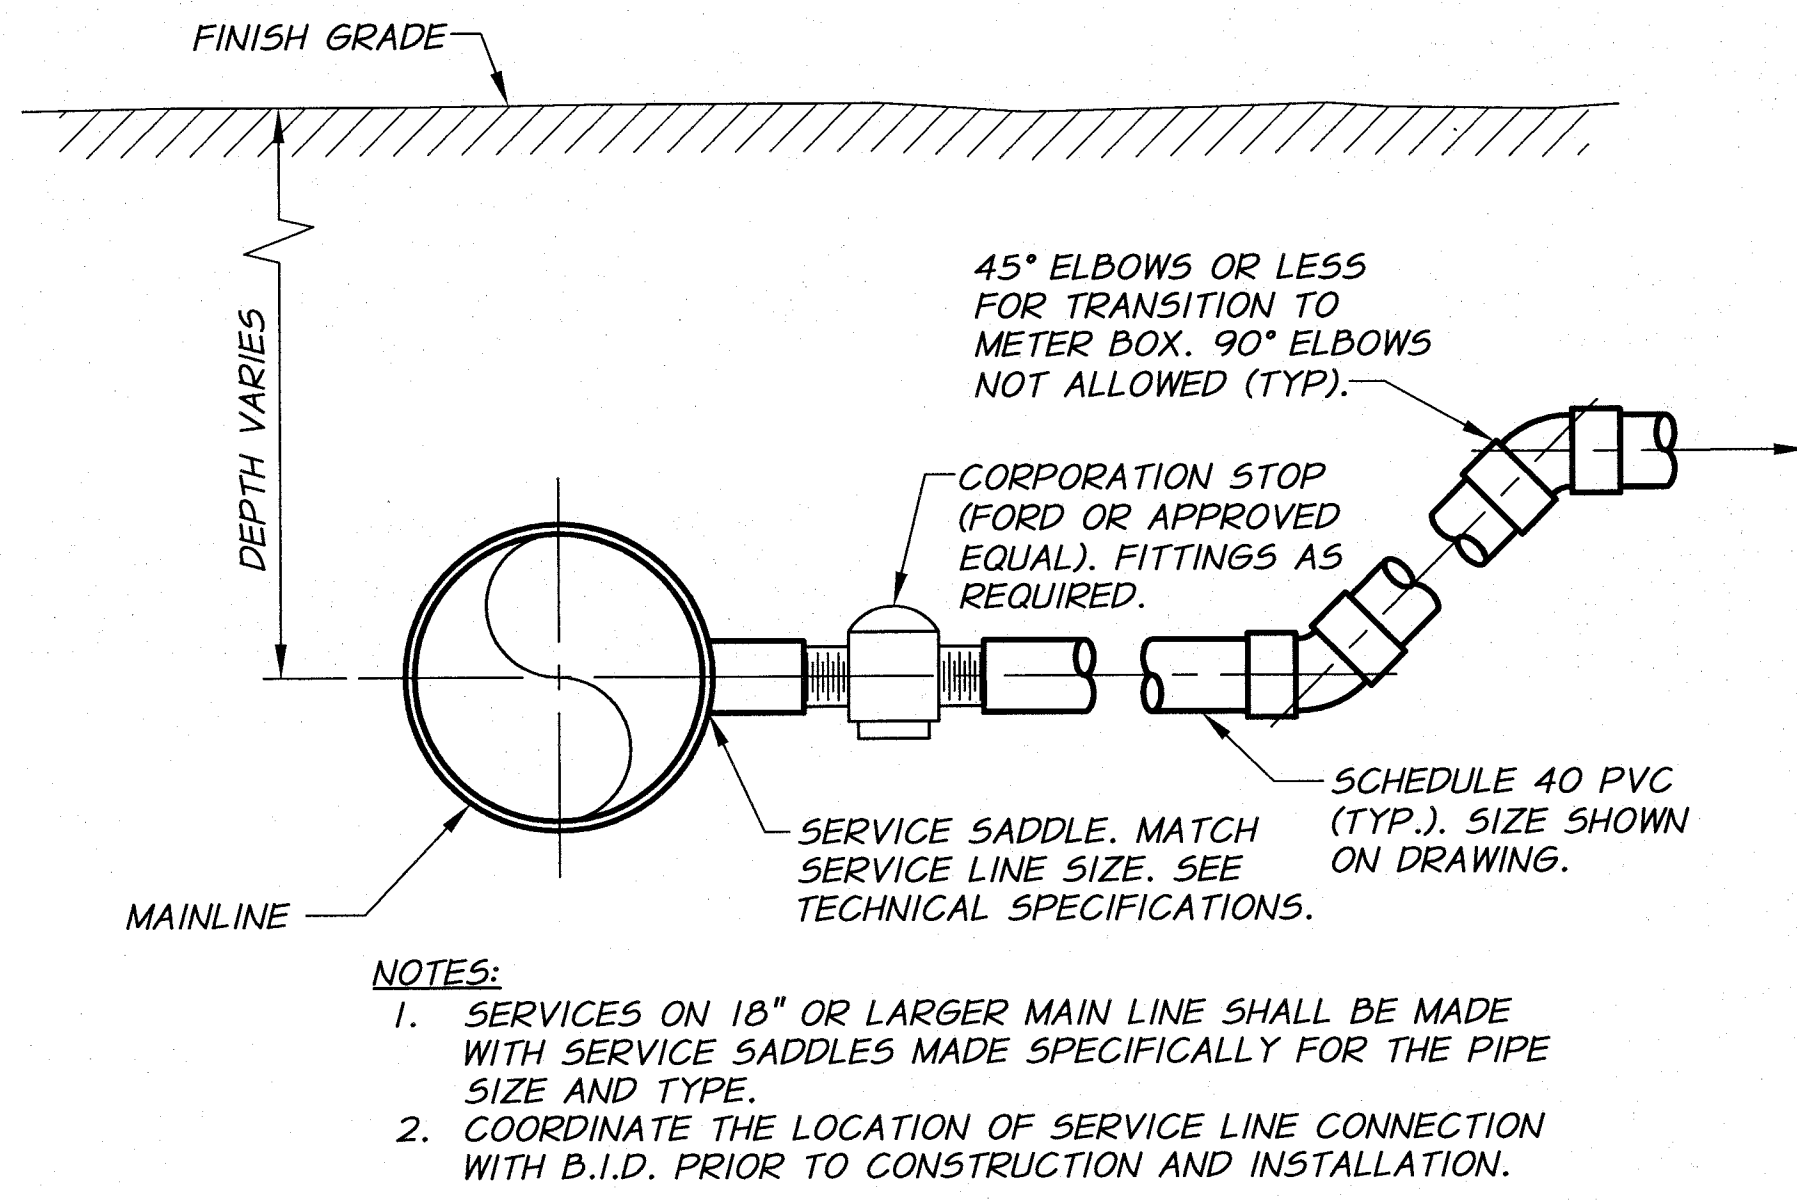

△ MAIN LINE SERVICE CONNECTION
FOR 1.5" AND 2" SERVICE
N.T.S.

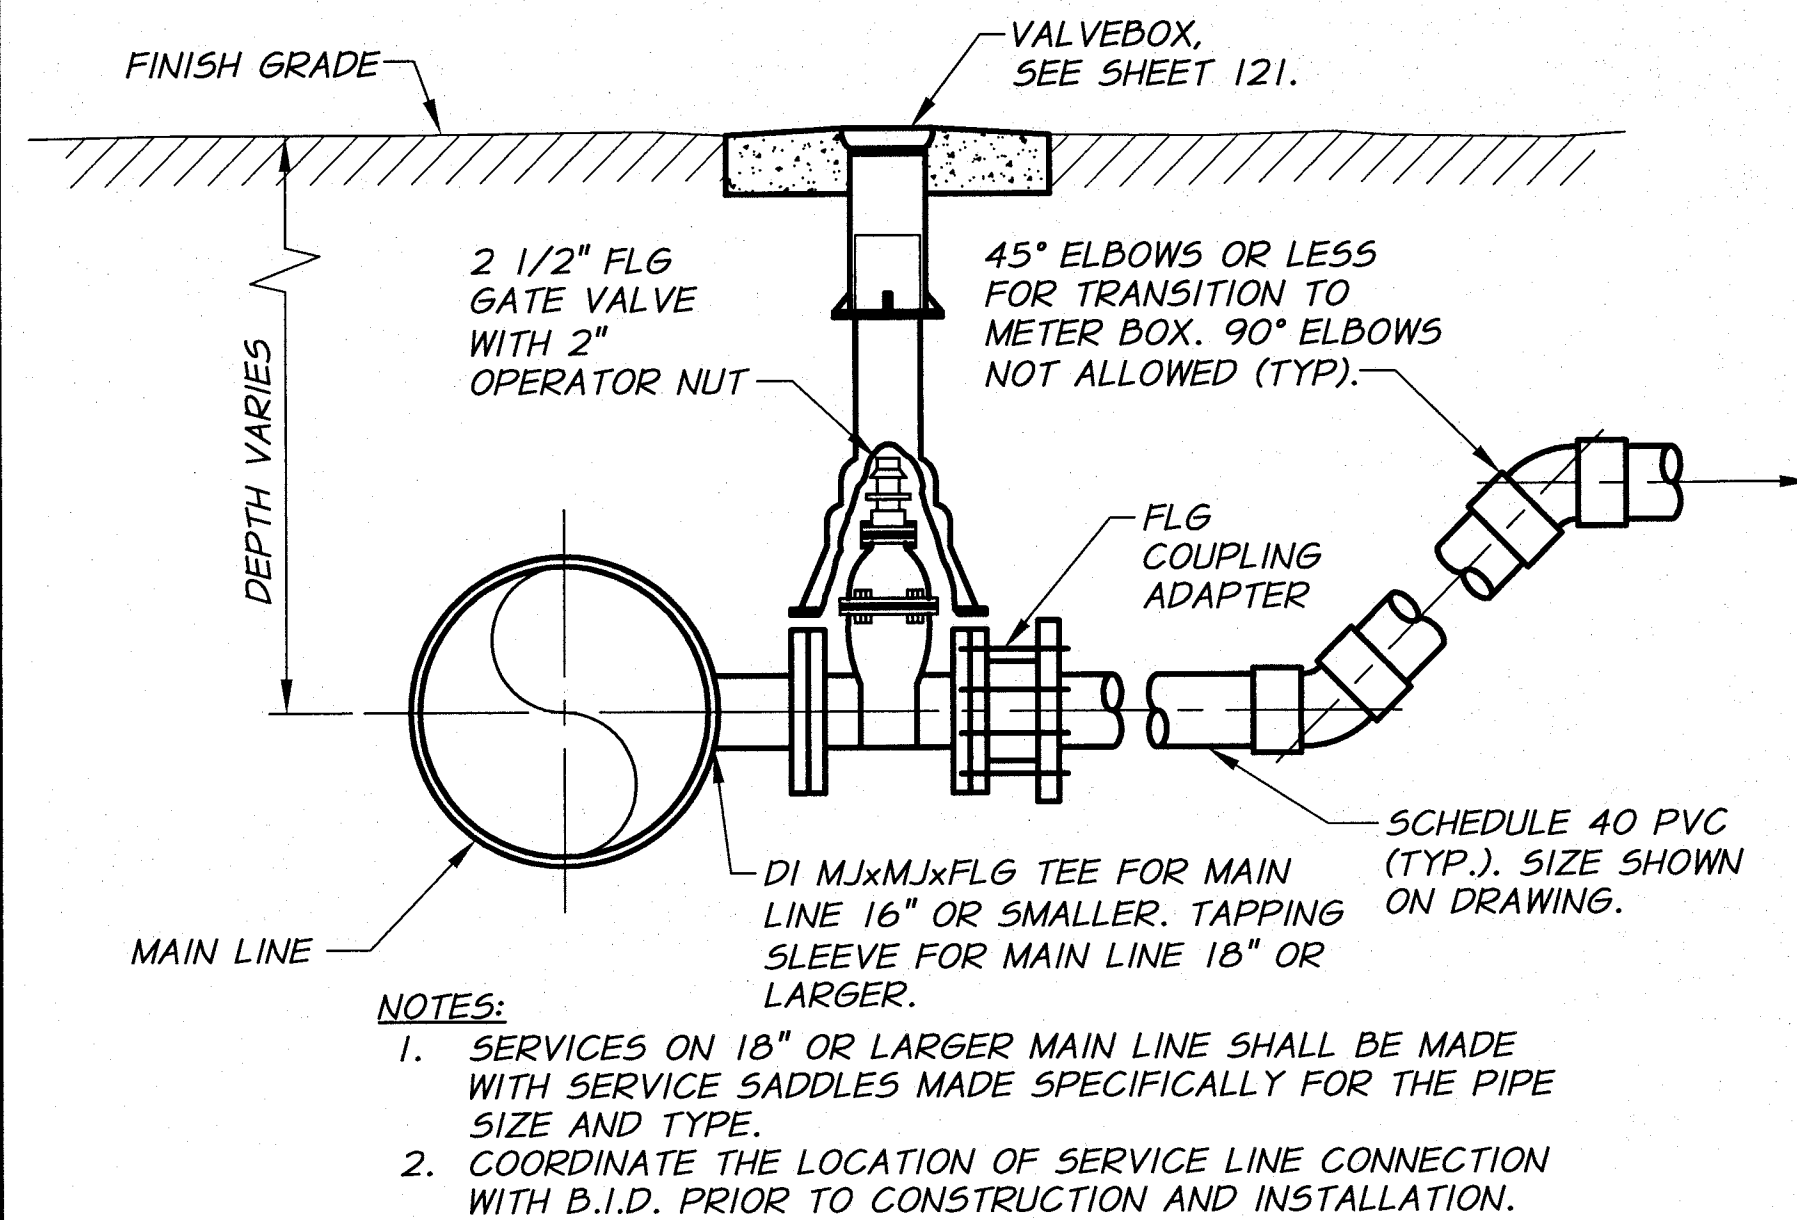


△ MAIN LINE SERVICE CONNECTION
FOR 2.5" SERVICE
N.T.S.

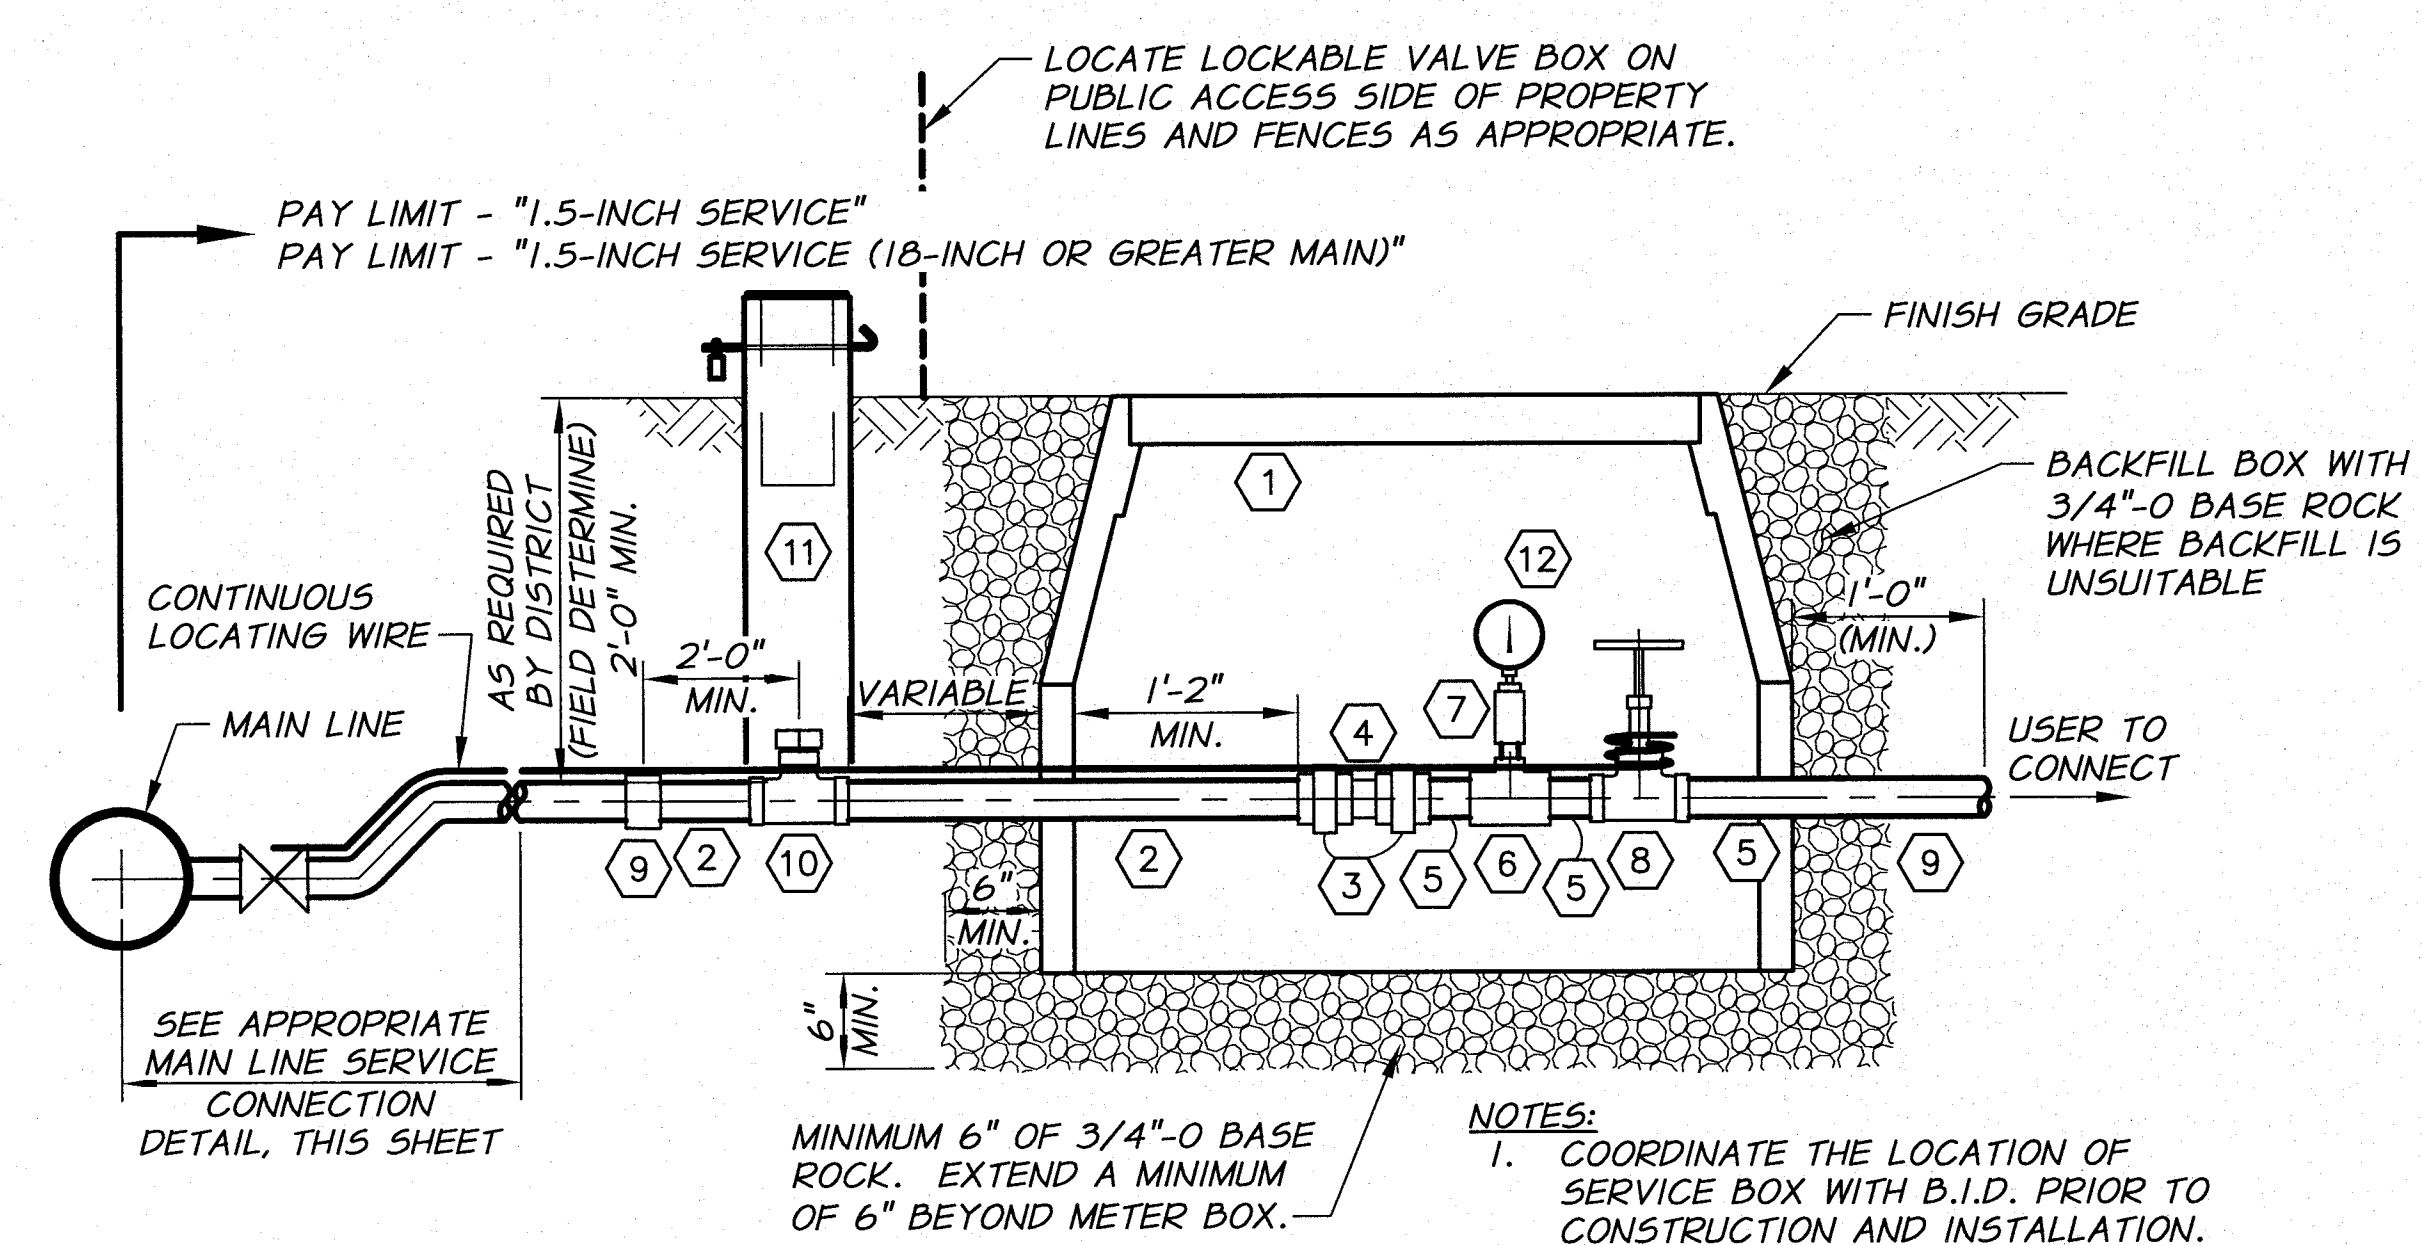


△ TYPICAL 1.5" SERVICE DETAIL
WITHOUT PRESSURE REDUCING VALVE
N.T.S.

- SERVICE FITTING SCHEDULE**
- 1 CARSON INDUSTRIES MODEL 2436-36 VAULT WITH LID. INSTALL IN NON-TRAFFIC BEARING ZONE.
 - 2 SCH. 40 G.I.P. PIPE
 - 3 G.I.P. UNION
 - 4 DOLE FLOW CONTROL VALVE. SIZE AS SHOWN ON PLANS.
 - 5 THREADED SCH. 40 G.I.P. SPOOL, LENGTH AS REQUIRED.
 - 6 SIZE x 3/4" G.I.P. TEE
 - 7 3/4" THREADED BRASS BALL VALVE WITH 3/4"x1/4" BUSHING AND BRASS QUICK COUPLING PLUG (UNVALVED)
 - 8 BRASS THREADED GATE VALVE
 - 9 TRANSITION COUPLING AND FITTINGS AS REQ'D
 - 10 CORP STOP WITH 2" OPERATOR NUT FOR 1.5" SERVICE.
 - 11 LOCKABLE VALVE BOX. SEE DETAIL, SHEET 121.
 - 12 DISTRICT PORTABLE GAUGE WITH BRASS QUICK COUPLING SOCKET (UNVALVED).

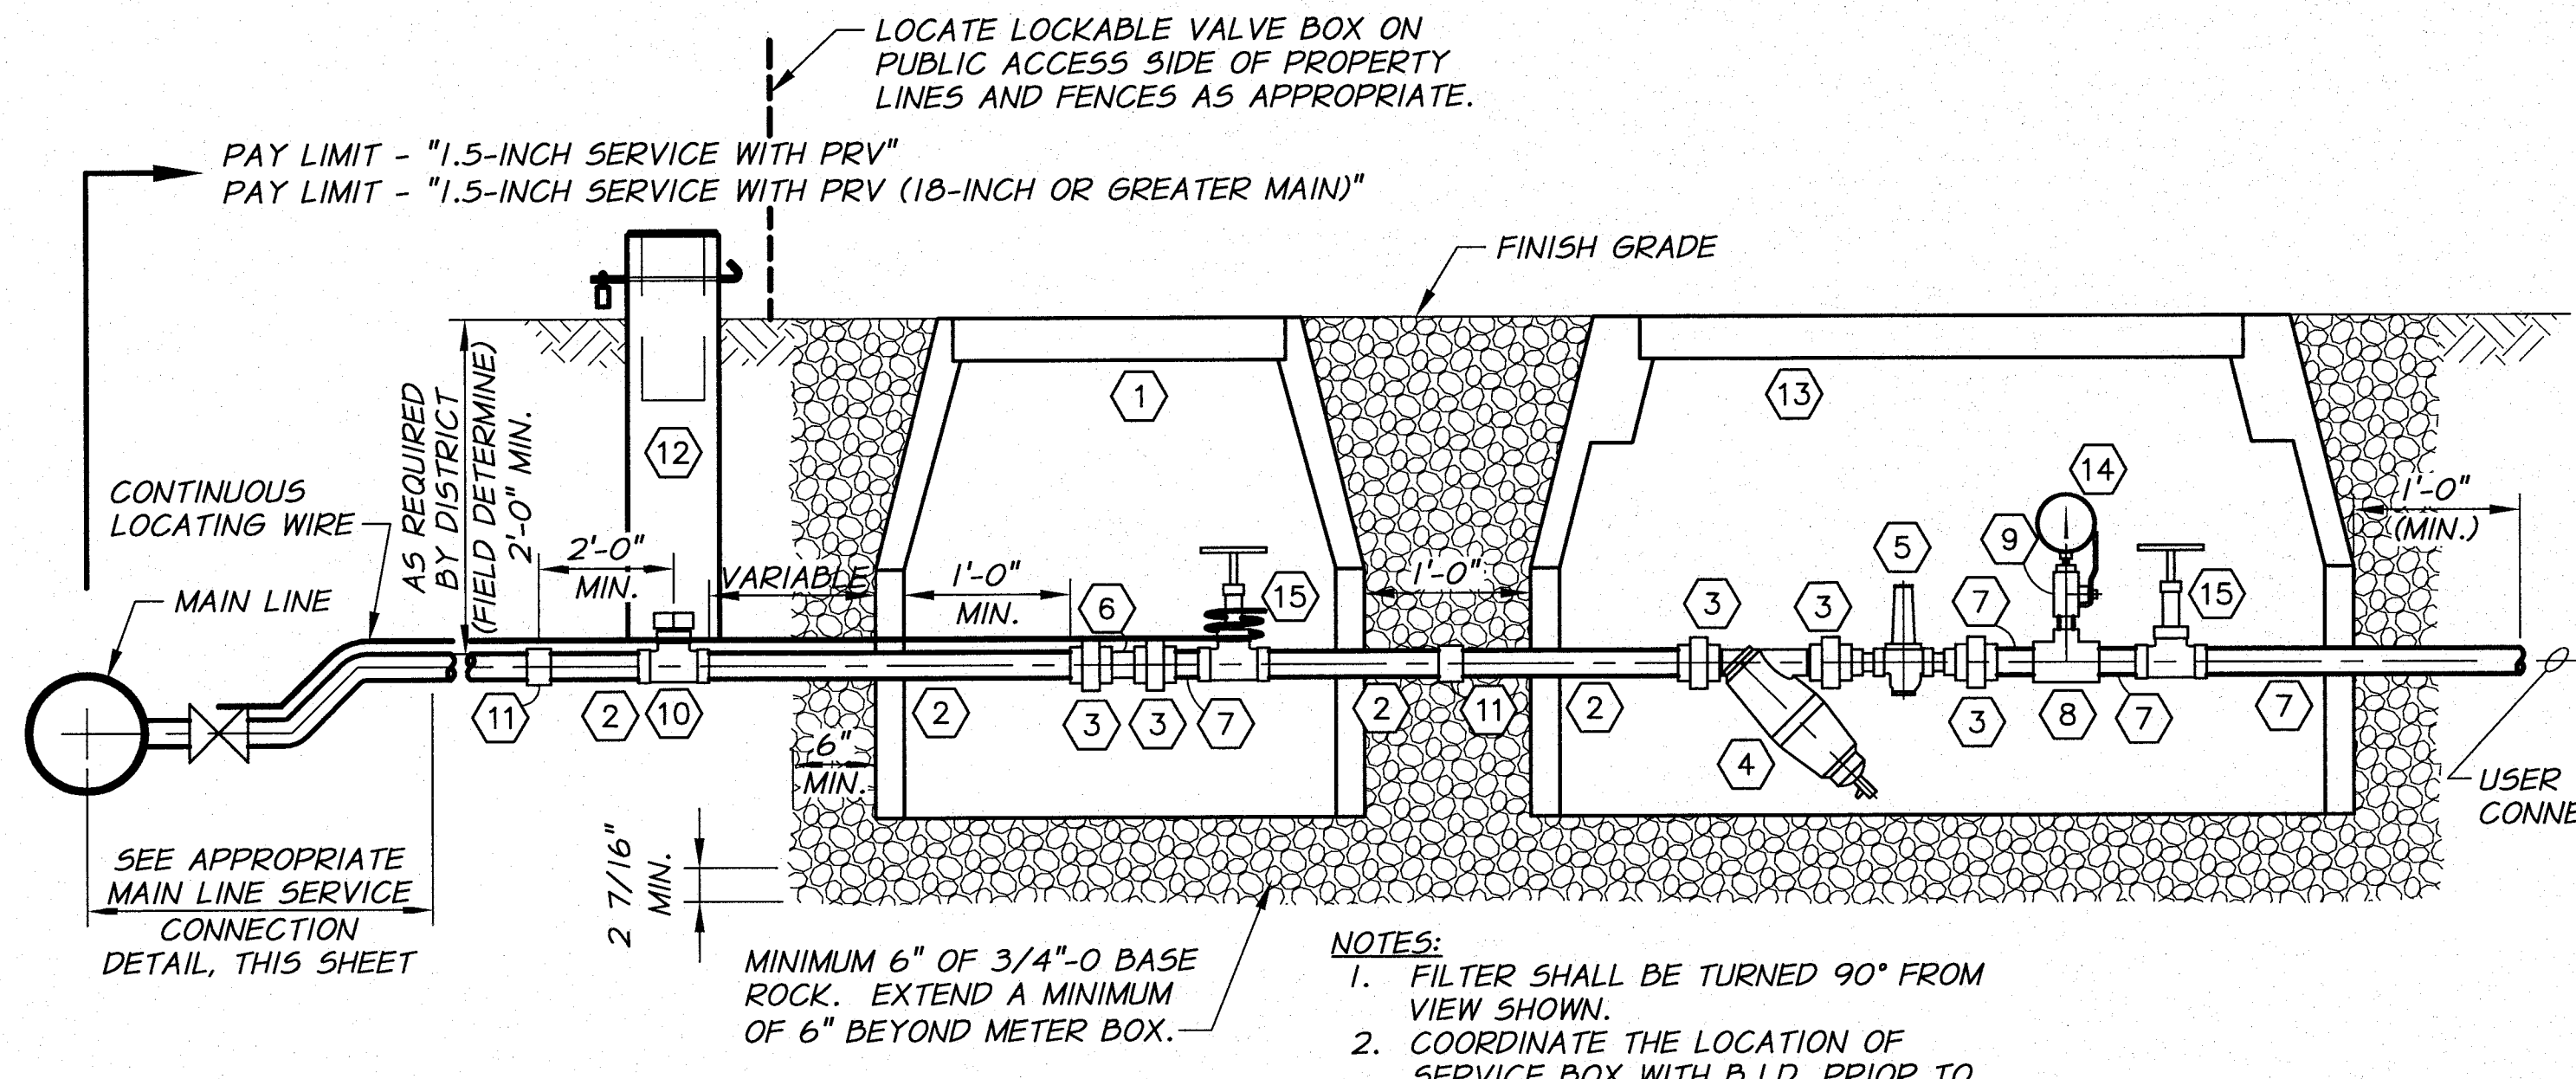


△ TYPICAL 1.5" SERVICE DETAIL
WITH PRESSURE REDUCING VALVE
N.T.S.

- SERVICE FITTING SCHEDULE**
- 1 CARSON INDUSTRIES MODEL 2424-36 VAULT WITH LID. INSTALL IN NON-TRAFFIC BEARING ZONE.
 - 2 SCH. 40 G.I.P. PIPE
 - 3 G.I.P. UNION OR G.I.P. REDUCING UNION AS REQUIRED
 - 4 Y-STRAINER WITH 40 MESH FILTER SCREEN. AMIAD FILTER NO. 1-1601 1-1/2" SUPER FILTER
 - 5 CLA-VAL 990 PRESSURE REDUCING VALVE. SIZE AS SHOWN ON PLANS. SEE TECHNICAL SPECIFICATIONS FOR DETAILS.
 - 6 DOLE FLOW CONTROL VALVE. SIZE AS SHOWN ON PLANS.
 - 7 THREADED SCH. 40 G.I.P. SPOOL, LENGTH AS REQUIRED.
 - 8 1-1/2"x3/4" G.I.P. TEE
 - 9 3/4" THREADED BRASS BALL VALVE WITH 3/4"x1/4" BUSHING AND BRASS QUICK COUPLING PLUG (UNVALVED).
 - 10 1-1/2" CORP STOP WITH 2" OPERATOR NUT
 - 11 TRANSITION COUPLING AND FITTINGS AS REQ'D
 - 12 LOCKABLE VALVE BOX. SEE DETAIL, SHEET 121.
 - 13 CARSON INDUSTRIES MODEL 2448-36 VAULT WITH LID. INSTALL IN NON-TRAFFIC BEARING ZONE.
 - 14 DISTRICT PORTABLE GAUGE WITH BRASS QUICK COUPLING SOCKET (UNVALVED).
 - 15 1-1/2" BRASS THREADED GATE VALVE

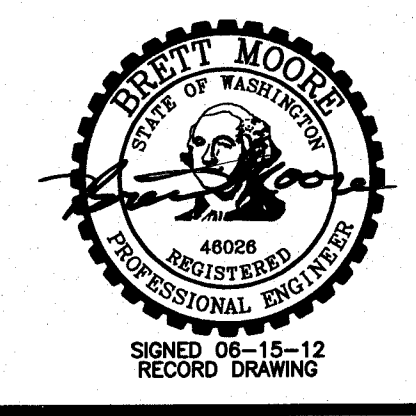


RECORD DRAWING		E.H.	12/11	HORIZ. SCALE NONE		VERT. SCALE	
DESIGNED BY	R. HARRIS	XREFS:	TB-BID.dwg	JOB NUMBER	1199-336	DATE	2009
DRAWN BY	D. CHRISTMAN	ACAD FILE:	ServiceDets.dwg				
REVIEWED BY	H. PERRY	COPYRIGHT 2009 BY ANDERSON-PERRY & ASSOC., INC.					

RECORD DRAWINGS
These record drawings have been prepared, in part, on the basis of information compiled and furnished by others. They may contain some discrepancies and omissions, and do not necessarily represent "exact" field conditions. The Owner and the Engineer accept no responsibility for their accuracy.

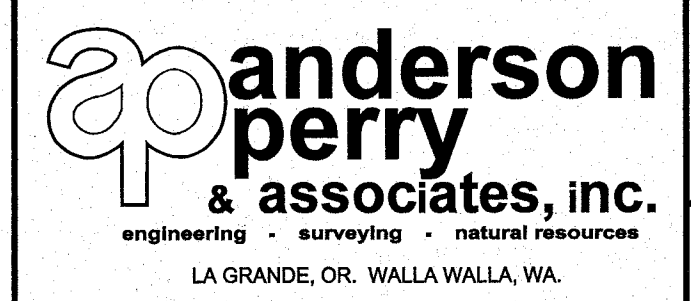


BENTON IRRIGATION DISTRICT
IRRIGATION SYSTEM IMPROVEMENTS
PHASE I
SERVICE DETAILS I

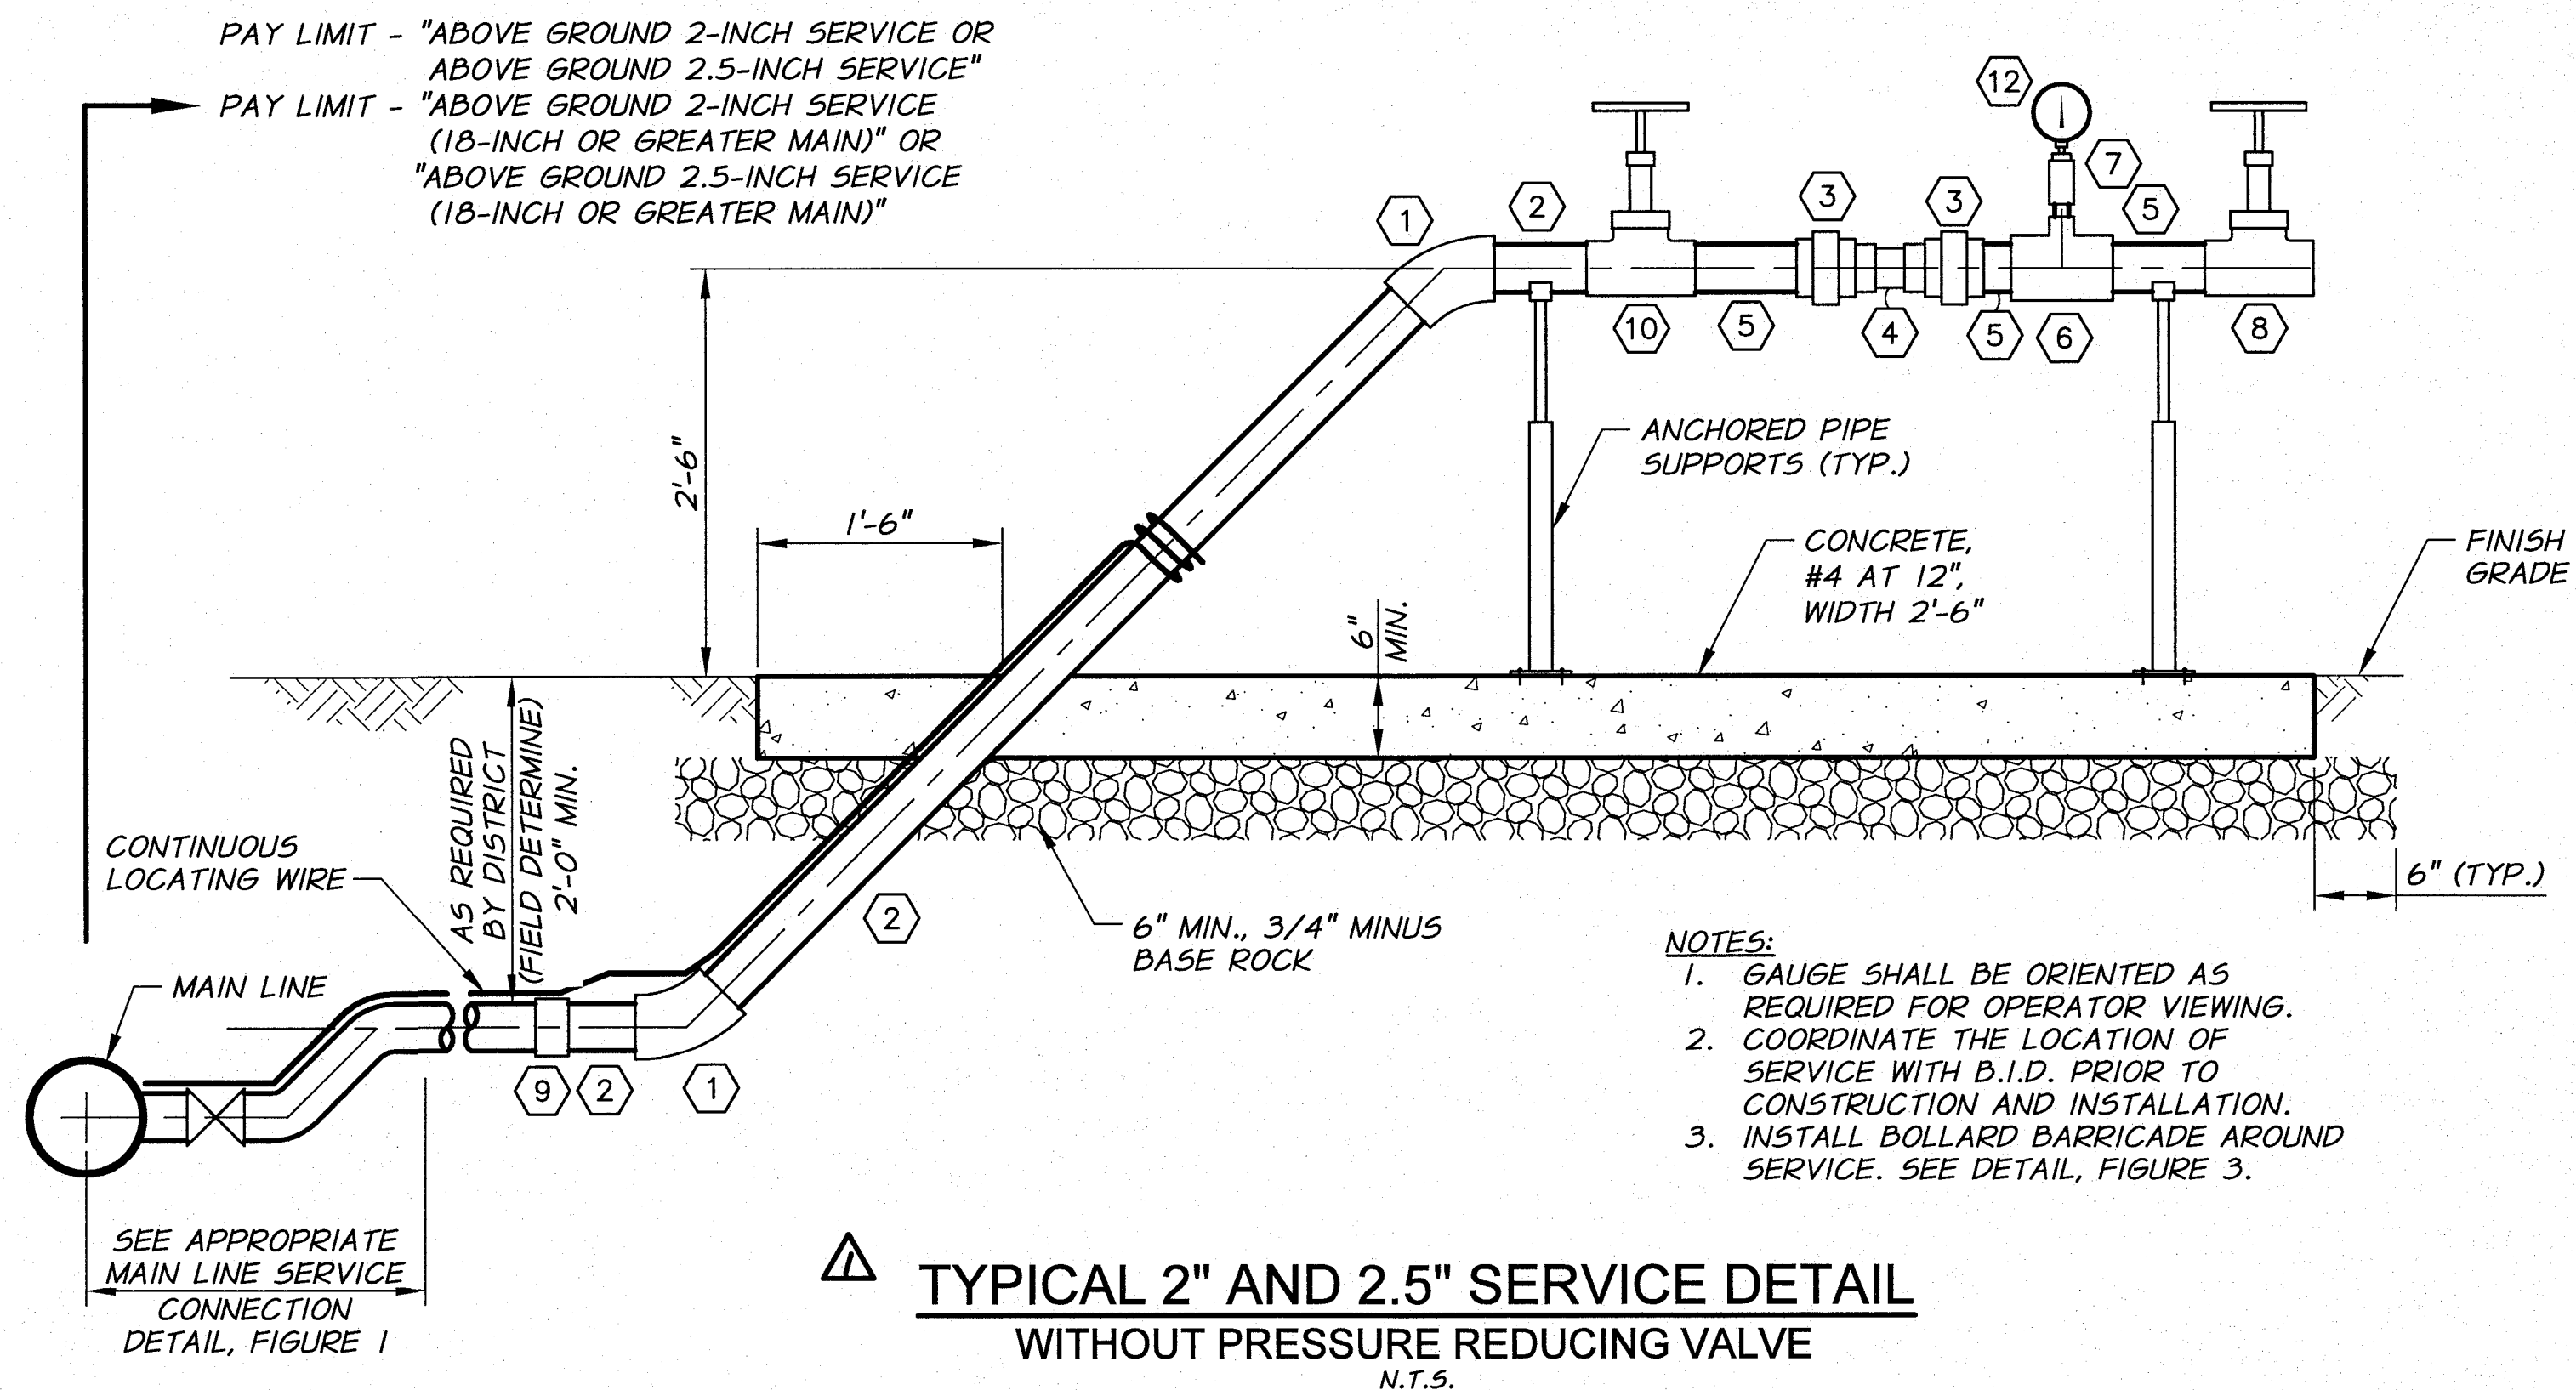


SERVICE FITTING SCHEDULE

- 1 G.I.P. 45° ELBOW
- 2 SCH. 40 G.I.P. PIPE
- 3 G.I.P. UNION
- 4 DOLE FLOW CONTROL VALVE. SIZE AS SHOWN ON PLANS.
- 5 THREADED SCH. 40 G.I.P. SPOOL, LENGTH AS REQUIRED.
- 6 SIZE x 3/4" G.I.P. TEE
- 7 3/4" THREADED BRASS BALL VALVE WITH 3/4"x1/4" BUSHING AND BRASS QUICK COUPLING PLUG (UNVALVED)
- 8 BRASS THREADED GATE VALVE
- 9 TRANSITION COUPLING AND FITTINGS AS REQ'D
- 10 2" LOCKING THREADED BRASS GATE VALVE WITH 2 1/2"x2" BUSHINGS AS REQ'D
- 11 RESERVED
- 12 DISTRICT PORTABLE GAUGE WITH BRASS QUICK COUPLING SOCKET (UNVALVED)

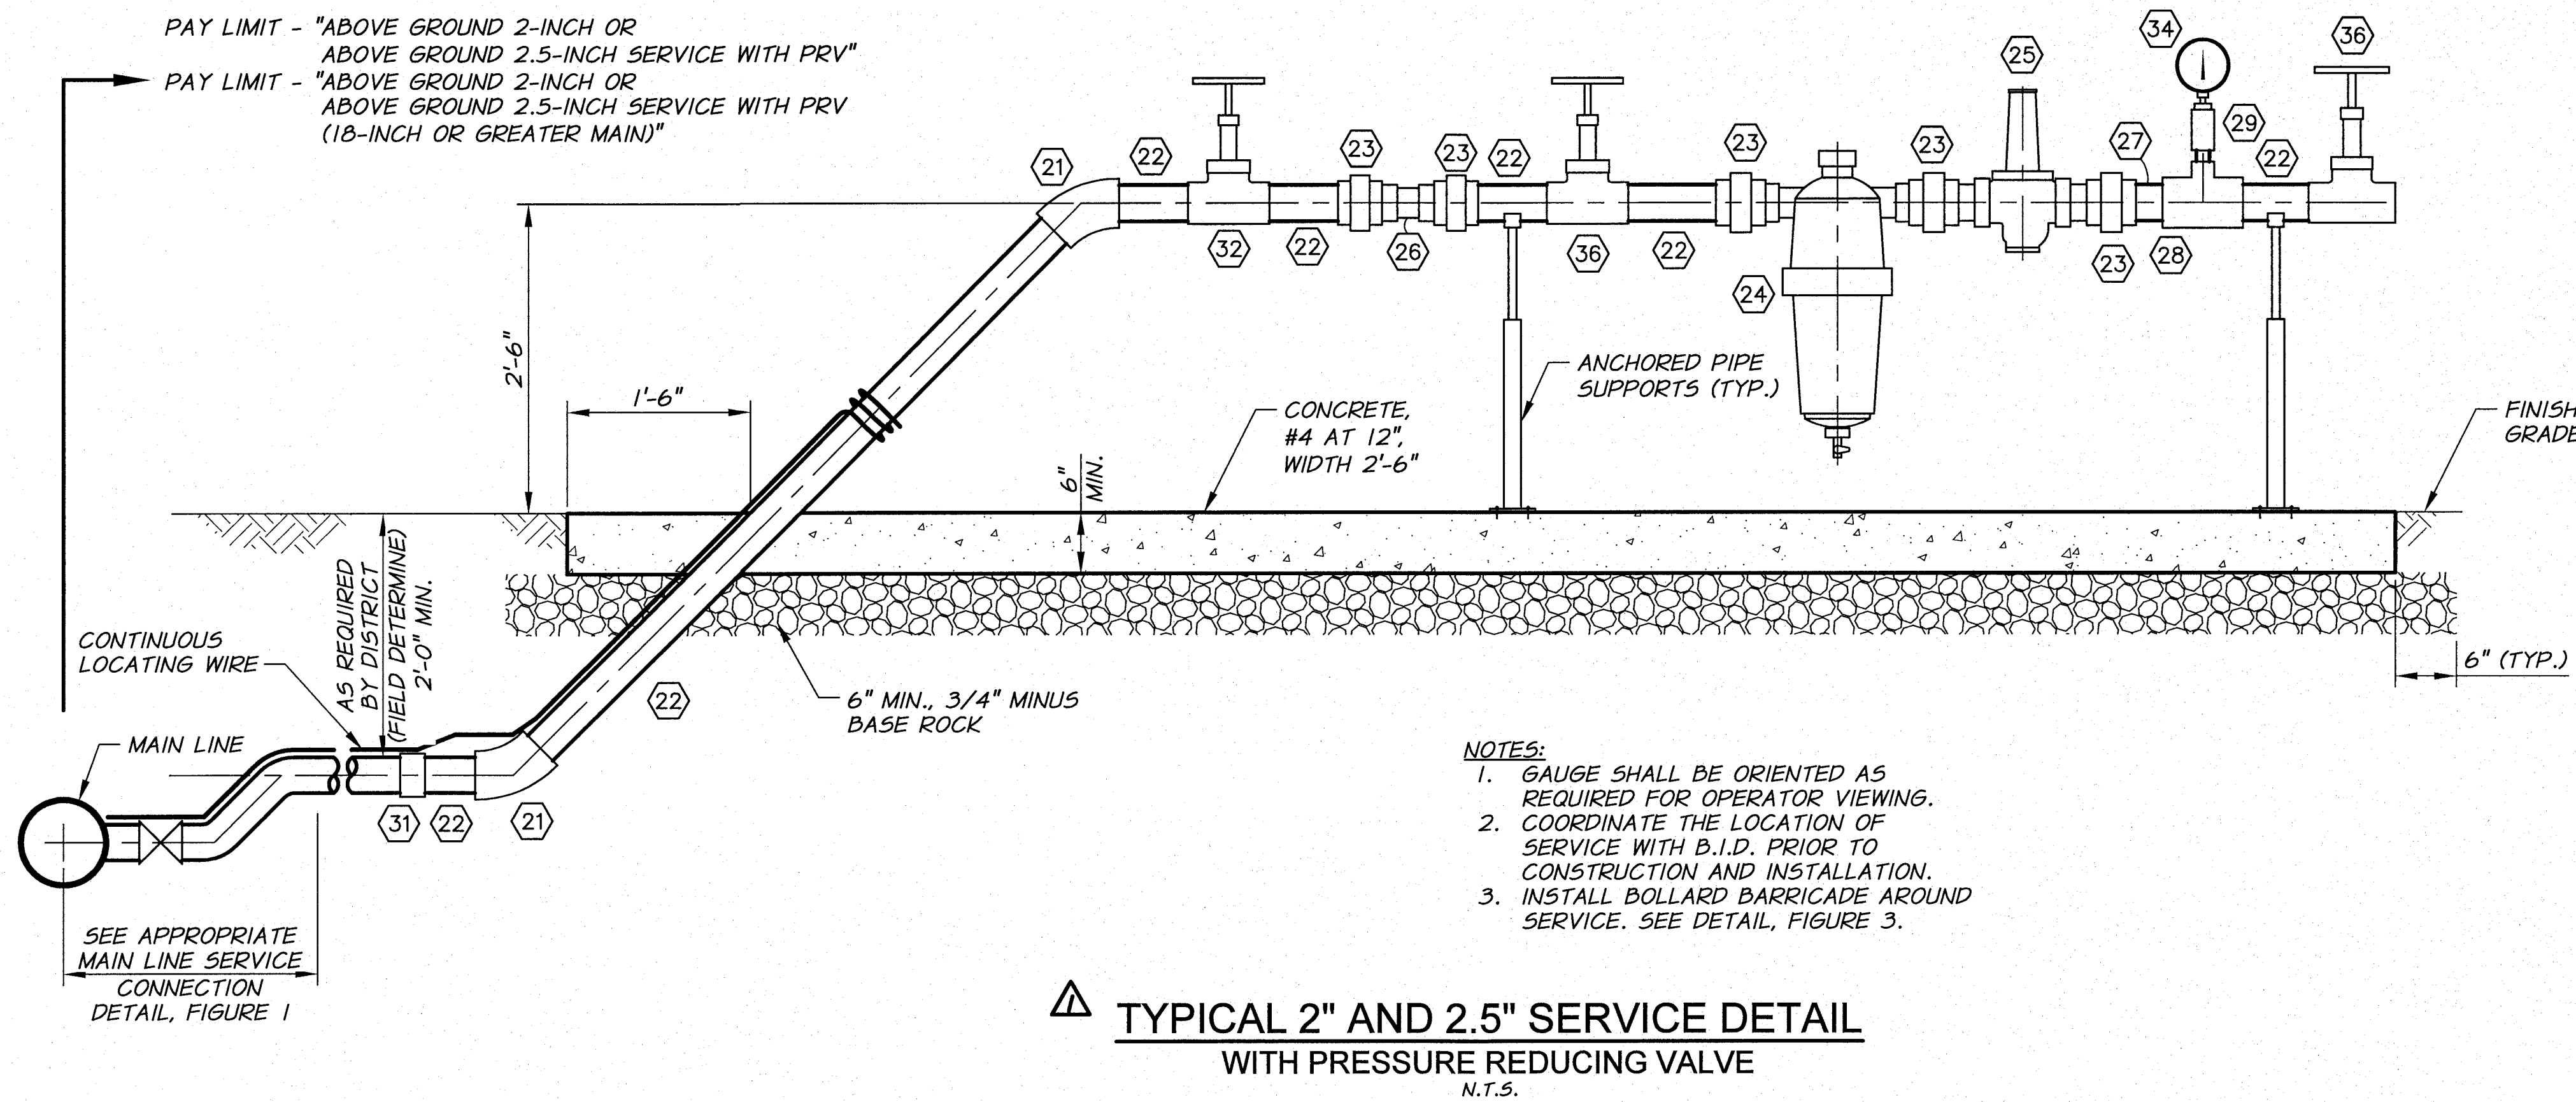

SERVICE FITTING SCHEDULE


- 21 G.I.P. 45° ELBOW
- 22 SCH. 40 G.I.P. PIPE
- 23 G.I.P. UNION OR G.I.P. REDUCING UNION AS REQUIRED
- 24 STRAINER WITH 40 MESH FILTER SCREEN. AMIAD FILTER 2" T-SUPER
- 25 CLA-VAL 990 PRESSURE REDUCING VALVE. SIZE AS SHOWN ON PLANS. SEE TECHNICAL SPECIFICATIONS FOR DETAILS.
- 26 DOLE FLOW CONTROL VALVE. SIZE AS SHOWN ON PLANS.
- 27 SCH. 40 G.I.P. SPOOL
- 28 SIZE x 3/4" G.I.P. TEE
- 29 3/4" THREADED BRASS BALL VALVE WITH 3/4"x1/4" BUSHING AND BRASS QUICK COUPLING PLUG (UNVALVED)
- 30 RESERVED
- 31 TRANSITION COUPLING AND FITTINGS AS REQ'D
- 32 2" LOCKING THREADED BRASS GATE VALVE WITH 2 1/2"x2" BUSHINGS AS REQUIRED
- 33 RESERVED
- 34 DISTRICT PORTABLE GAUGE WITH BRASS QUICK COUPLING (UNVALVED)
- 35 RESERVED
- 36 BRASS THREADED GATE VALVE

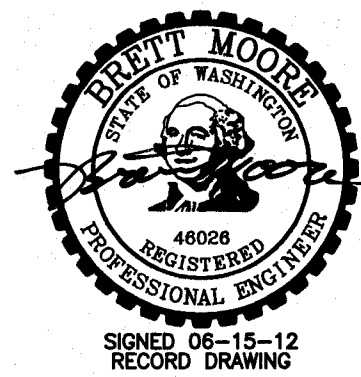

RECORD DRAWING		E.H. 12/11	
DESIGNED BY R. HARRIS	XREFS: TB-BID.dwg	JOB NUMBER 1199-336	DATE 2009
DRAWN BY D. CHRISTMAN		ACAD FILE ServiceDets.dwg	
REVIEWED BY H. PERRY		COPYRIGHT 2009 BY ANDERSON-PERRY & ASSOC., INC.	

RECORD DRAWINGS

These record drawings have been prepared, in part, on the basis of information compiled and furnished by others. They may contain some discrepancies and omissions, and do not necessarily represent "exact" field conditions. The Owner and the Engineer accept no responsibility for their accuracy.

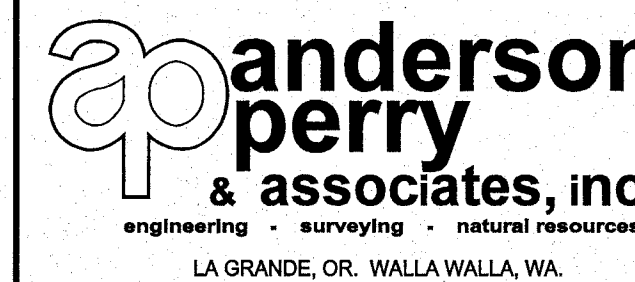


**BENTON IRRIGATION DISTRICT
IRRIGATION SYSTEM IMPROVEMENTS
PHASE I**

SERVICE DETAILS II

SHEET

118

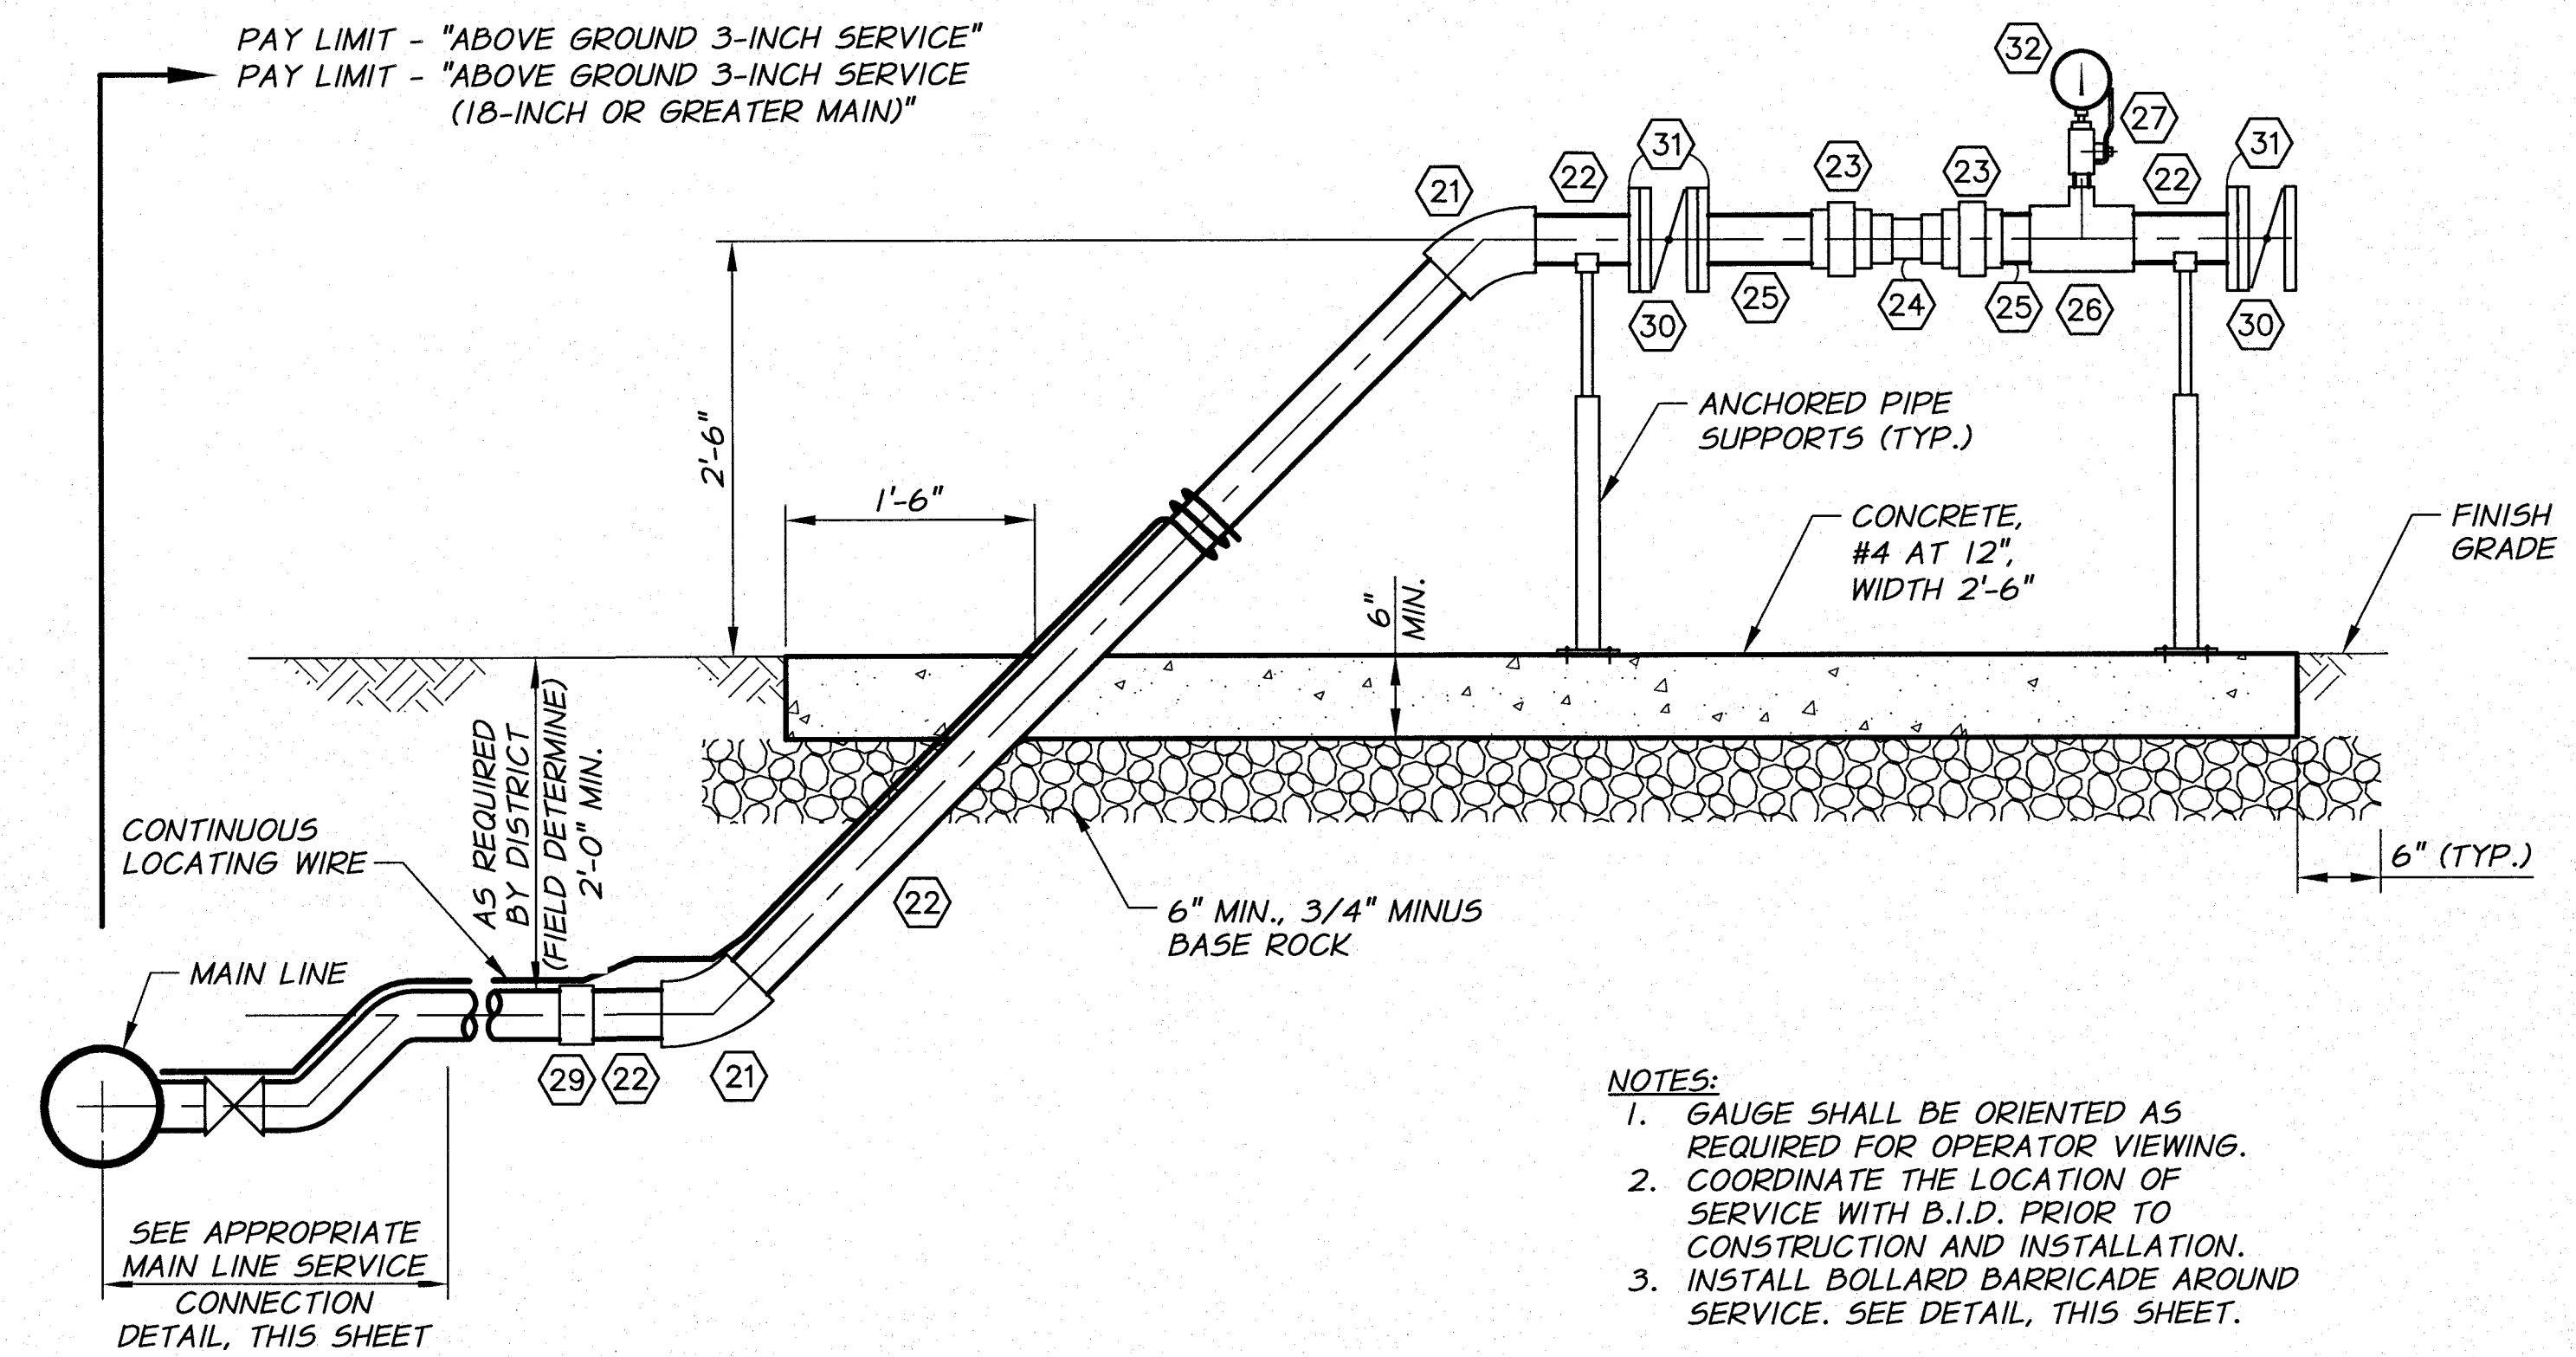


- NOTES:**
1. GAUGE SHALL BE ORIENTED AS REQUIRED FOR OPERATOR VIEWING.
 2. COORDINATE THE LOCATION OF SERVICE WITH B.I.D. PRIOR TO CONSTRUCTION AND INSTALLATION.
 3. INSTALL BOLLARD BARRICADE AROUND SERVICE. SEE DETAIL, THIS SHEET.


SERVICE FITTING SCHEDULE

- (21) G.I.P. ELBOW
- (22) SCH. 40 G.I.P. PIPE
- (23) G.I.P. UNION OR G.I.P. REDUCING UNION AS REQUIRED
- (24) DOLE FLOW CONTROL VALVE. SIZE AS SHOWN ON PLANS.
- (25) THREADED SCH. 40 G.I.P. SPOOL, LENGTH AS REQUIRED.
- (26) SIZE x 3/4" G.I.P. TEE
- (27) 3/4" THREADED BRASS BALL VALVE WITH 3/4"x1/4" BUSHING AND BRASS QUICK COUPLING PLUG (UNVALVED)
- (28) RESERVED
- (29) TRANSITION COUPLING AND FITTINGS AS REQ'D
- (30) 3" BUTTERFLY VALVE WITH WHEEL OPERATOR AND POSITION INDICATOR
- (31) FLG ADAPTER
- (32) DISTRICT PORTABLE GAUGE WITH BRASS QUICK COUPLING SOCKET (UNVALVED)

TYPICAL 3" SERVICE DETAIL WITHOUT PRESSURE REDUCING VALVE
N.T.S.

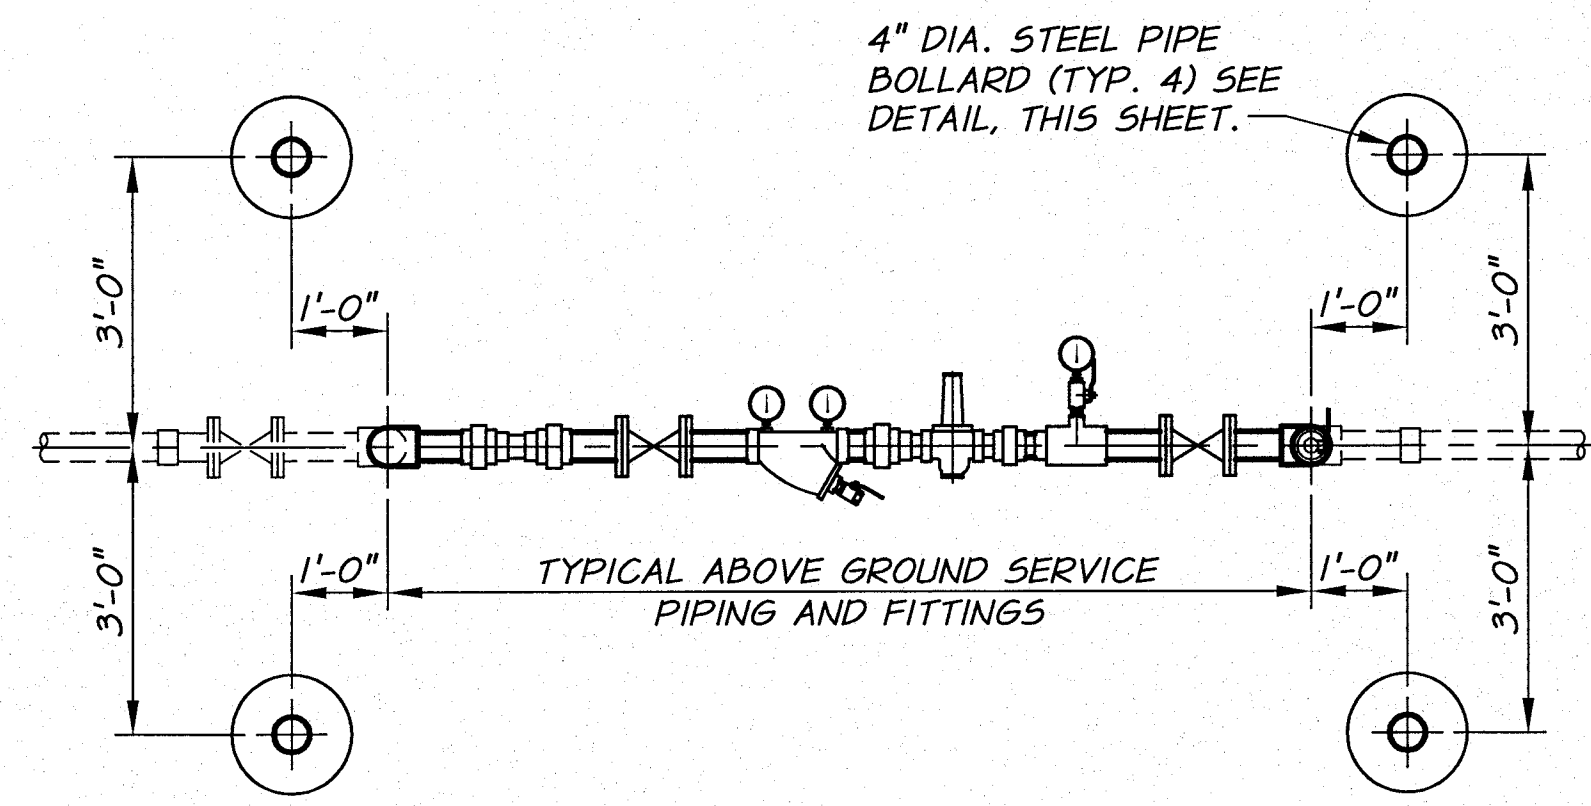


ABOVE GROUND SERVICE BARRICADE DETAIL
PLAN
N.T.S.

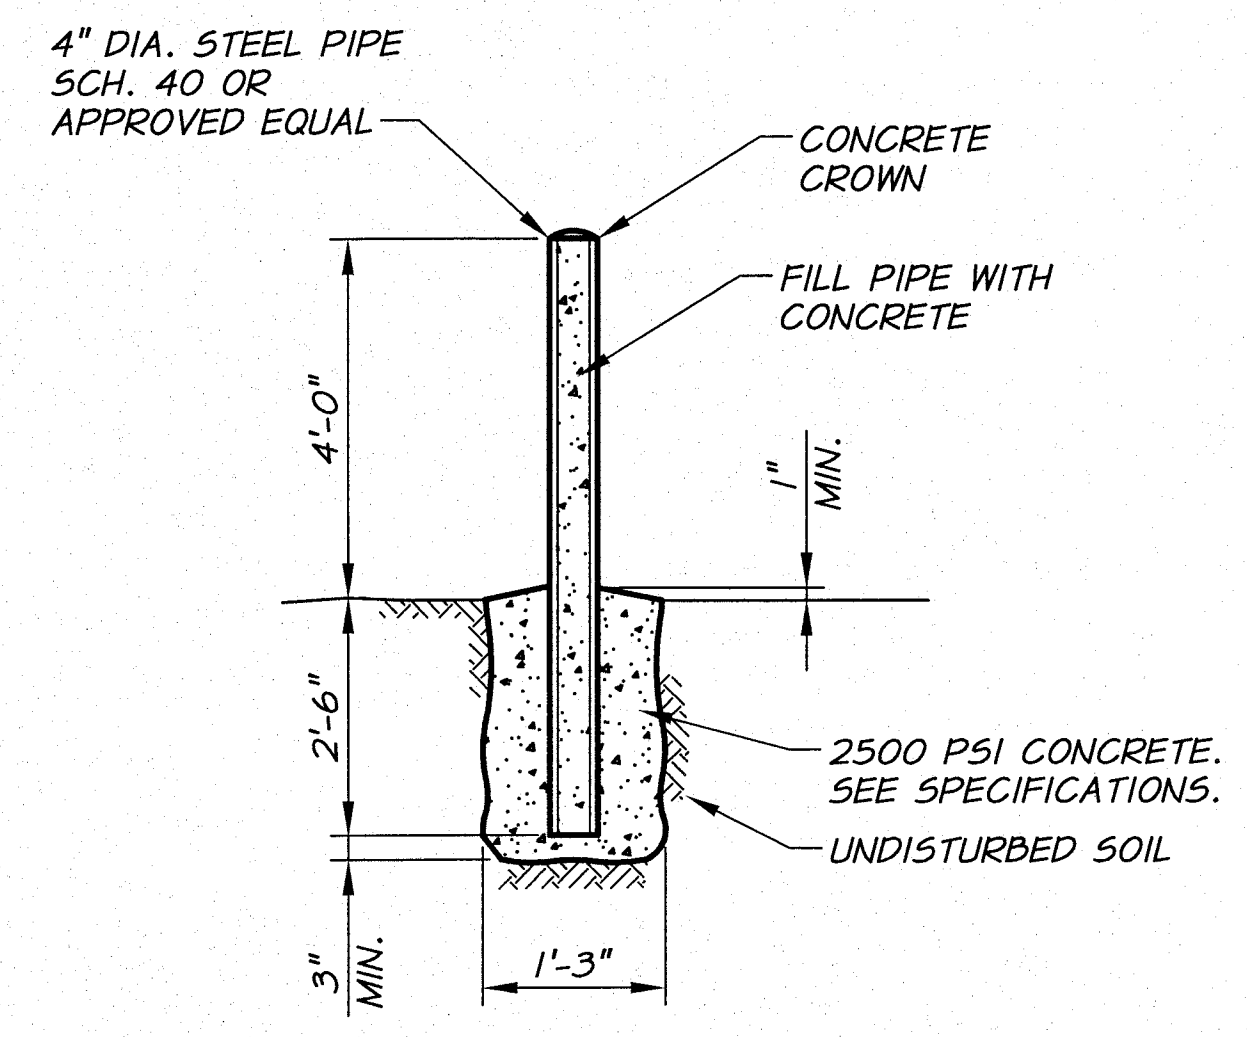

- NOTES:**
1. 4" DIA. STEEL PIPE SHALL BE PLUMB.
 2. PAINTING SHALL BE DONE ONLY AFTER SURFACE IS FREE OF RUST, OIL, AND GREASE. THE METAL SHALL BE PRIMED AND TWO FINISH COATS APPLIED, YELLOW IN COLOR.

BOLLARD DETAIL
N.T.S.

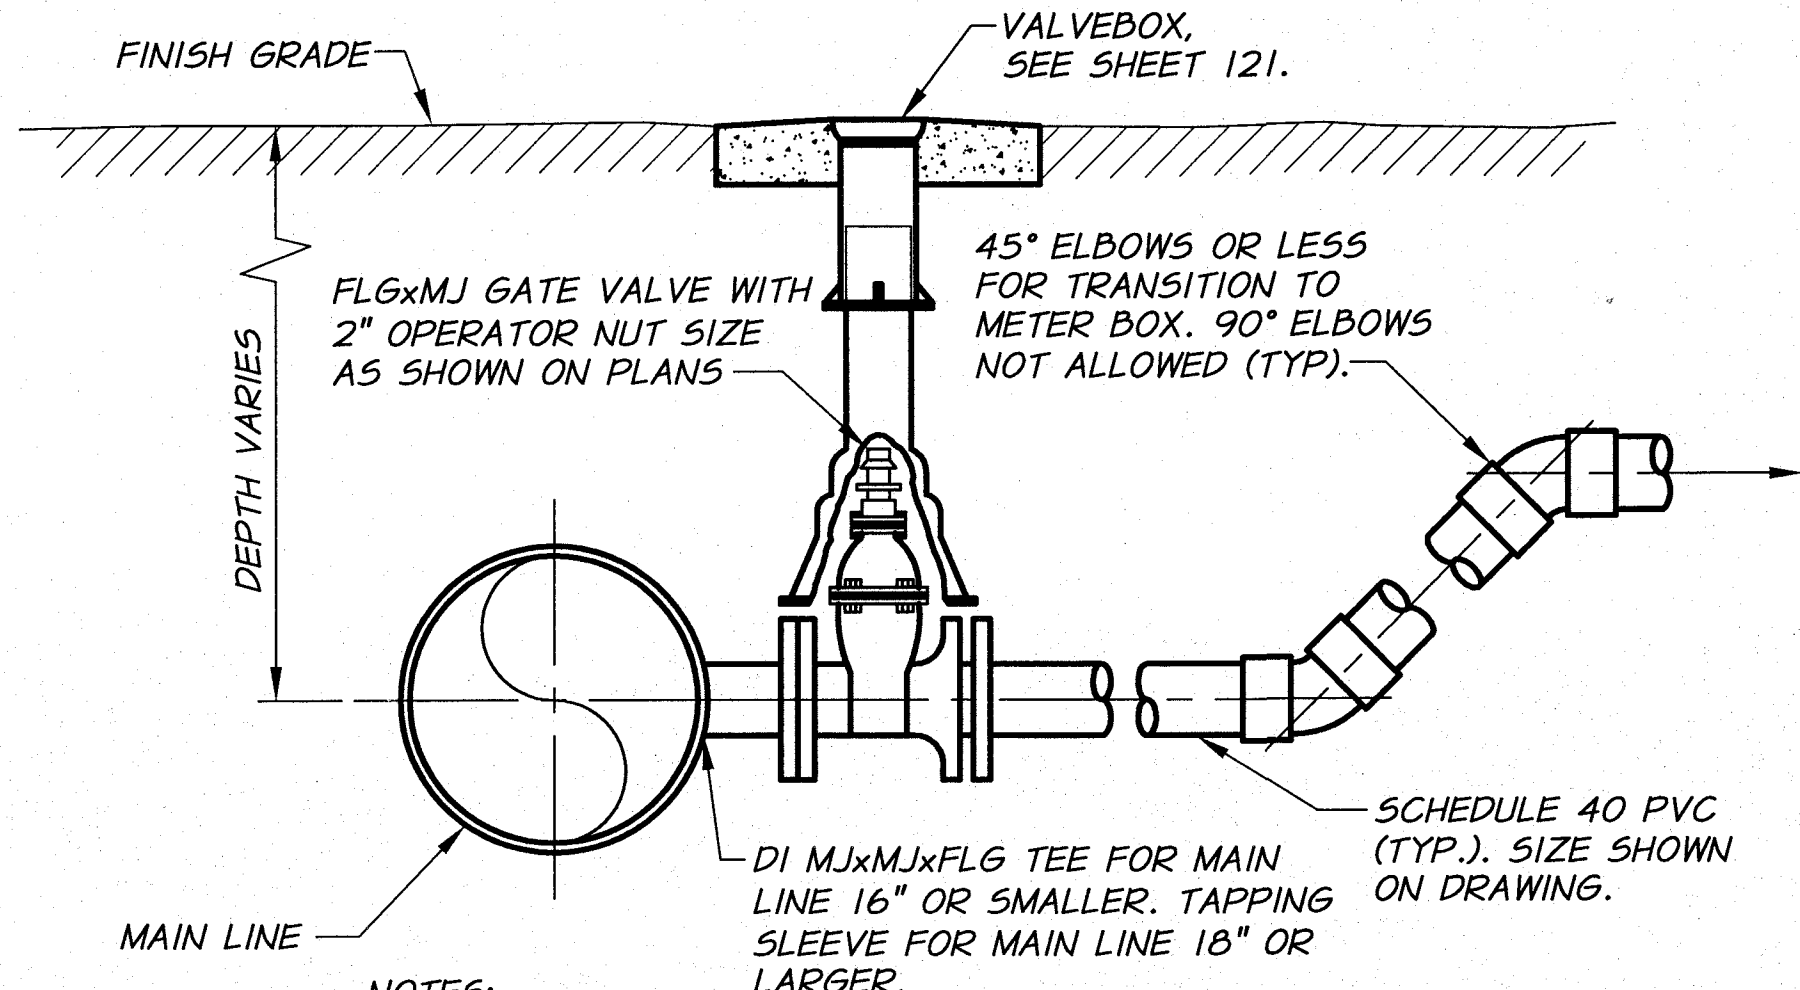


- NOTES:**
1. SERVICES ON 18" OR LARGER MAIN LINE SHALL BE MADE WITH SERVICE SADDLES MADE SPECIFICALLY FOR THE PIPE SIZE AND TYPE.
 2. COORDINATE THE LOCATION OF SERVICE LINE CONNECTION WITH B.I.D. PRIOR TO CONSTRUCTION AND INSTALLATION.

MAIN LINE SERVICE CONNECTION FOR 3" SERVICE AND LARGER
N.T.S.



RECORD DRAWING		E.H.	12/11		
DESIGNED BY	R. HARRIS	XREFS:	TB-BID.dwg	HORIZ. SCALE	NONE
DRAWN BY	D. CHRISTMAN	JOB NUMBER	1199-336	VERT. SCALE	
REVIEWED BY	H. PERRY	ACAD FILE	ServiceDets.dwg	DATE	2009
COPYRIGHT 2009 BY ANDERSON-PERRY & ASSOC., INC.					


RECORD DRAWINGS
These record drawings have been prepared, in part, on the basis of information compiled and furnished by others. They may contain some discrepancies and omissions, and do not necessarily represent "exact" field conditions. The Owner and the Engineer accept no responsibility for their accuracy.

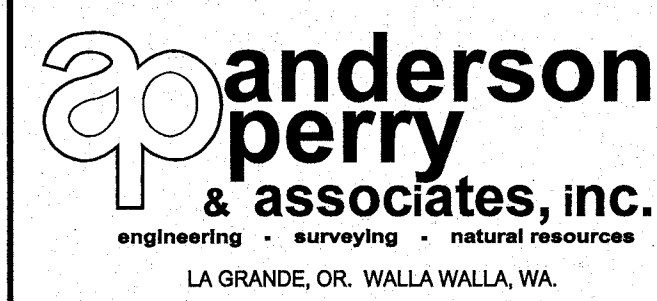

BENTON IRRIGATION DISTRICT
IRRIGATION SYSTEM IMPROVEMENTS
PHASE I
SERVICE DETAILS III

SHEET
118A

ARCHIVED

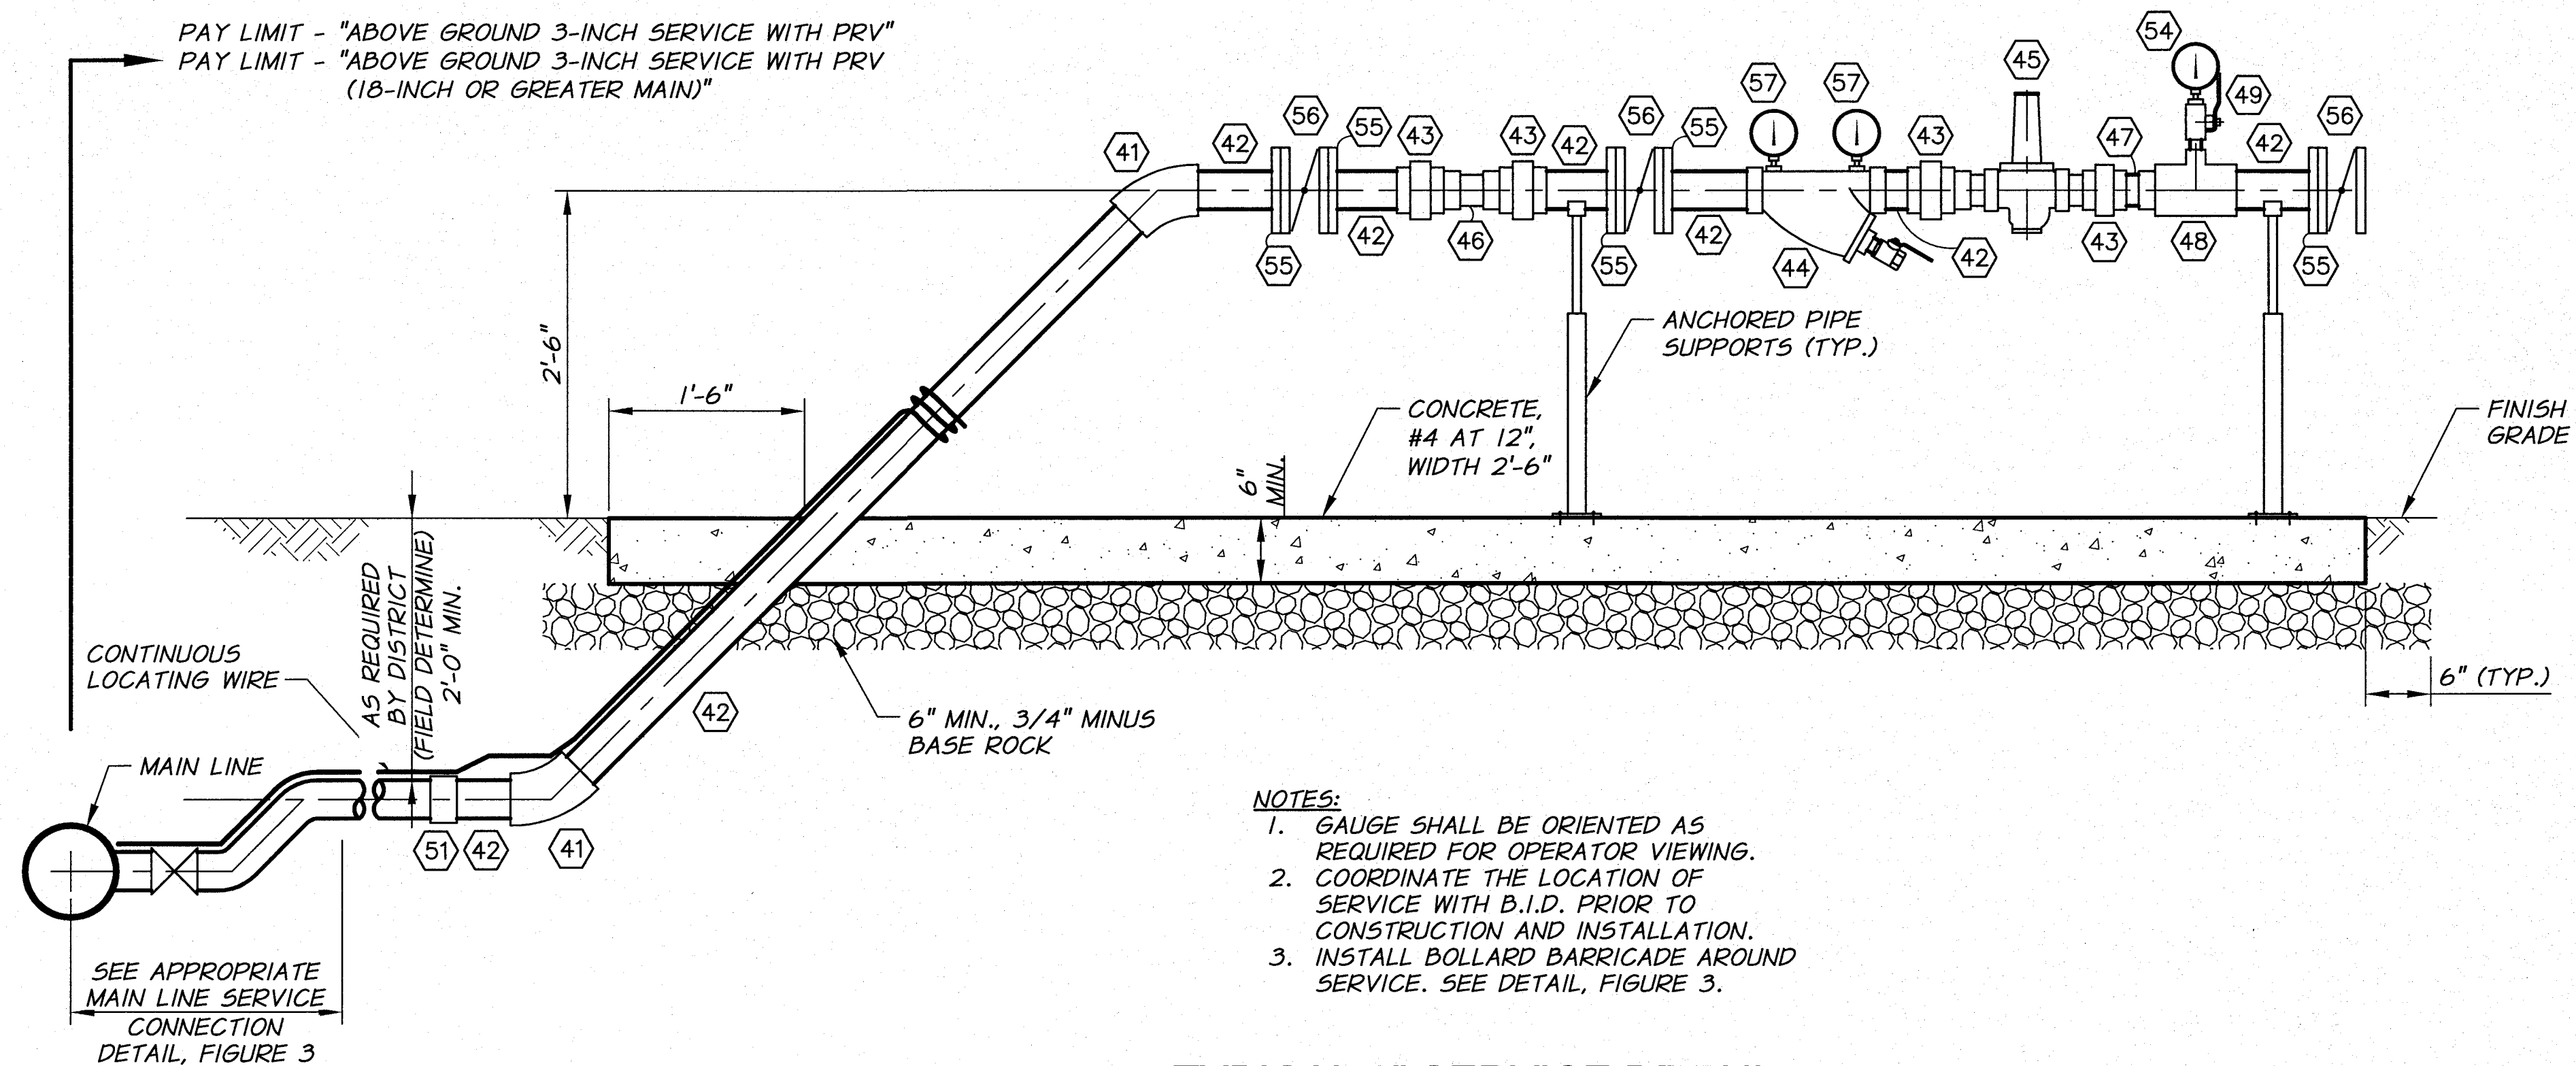

- NOTES:**
1. GAUGE SHALL BE ORIENTED AS REQUIRED FOR OPERATOR VIEWING.
 2. COORDINATE THE LOCATION OF SERVICE WITH B.I.D. PRIOR TO CONSTRUCTION AND INSTALLATION.
 3. INSTALL BOLLARD BARRICADE AROUND SERVICE. SEE DETAIL, FIGURE 3.

**TYPICAL 3" SERVICE DETAIL
WITH PRESSURE REDUCING VALVE**
N.T.S.


SERVICE FITTING SCHEDULE

- 41 G.I.P. 45° ELBOW
- 42 SCH. 40 G.I.P. PIPE
- 43 G.I.P. UNION OR G.I.P. REDUCING UNION AS REQUIRED
- 44 3" SONNITAG ALUMINUM Y-FILTER WITH 40 MESH FILTER SCREEN
- 45 CLA-VAL 990 PRESSURE REDUCING VALVE. SIZE AS SHOWN ON PLANS. SEE TECHNICAL SPECIFICATIONS FOR DETAILS.
- 46 DOLE FLOW CONTROL VALVE. SIZE AS SHOWN ON PLANS.
- 47 SCH. 40 G.I.P. SPOOL
- 48 3"x3/4" G.I.P. TEE
- 49 3/4" THREADED BRASS BALL VALVE WITH 3/4"x1/4" BUSHING AND BRASS QUICK COUPLING PLUG (UNVALVED)
- 50 RESERVED
- 51 TRANSITION COUPLING AND FITTINGS AS REQ'D
- 52 RESERVED
- 53 RESERVED
- 54 DISTRICT PORTABLE GAUGE WITH BRASS QUICK COUPLING SOCKET (UNVALVED)
- 55 FLANGE ADAPTER
- 56 3" FLG BUTTERFLY VALVE WITH WHEEL OPERATOR AND POSITION INDICATOR
- 57 4" 55 GLYCERIN FILLED PRESSURE GAUGE. FITTINGS AS REQUIRED.



RECORD DRAWING		BY	E.H.	DATE	12/11
DESIGNED BY	R. HARRIS	XREFS:	TB-BID.dwg		
DRAWN BY	D. CHRISTMAN	JOB NUMBER	1199-336	DATE	2009
REVIEWED BY	H. PERRY	ACAD FILE:	ServiceDets.dwg		
COPYRIGHT 2009 BY ANDERSON-PERRY & ASSOC., INC.					

RECORD DRAWINGS
These record drawings have been prepared, in part, on the basis of information compiled and furnished by others. They may contain some discrepancies and omissions, and do not necessarily represent "exact" field conditions. The Owner and the Engineer accept no responsibility for their accuracy.

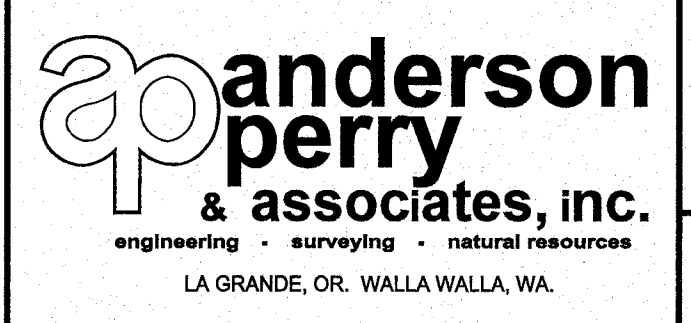

BENTON IRRIGATION DISTRICT
IRRIGATION SYSTEM IMPROVEMENTS
PHASE I
SERVICE DETAILS IV

SHEET
118B


▲
SHEET ADDED

ARCHIVED

FITTING SCHEDULE


- | | |
|---|---|
| 1 SERVICE LINE PVC PIPING | 13 PE DI SPOOL LENGTH AS REQUIRED |
| 2 MJ ECCENTRIC REDUCER | 14 FLANGE COUPLING ADAPTER |
| 3 CLASS 200 PVC PIPING | 15 FLG SIZE x SIZE x SIZE TEE, BRANCH NOT TO EXCEED 6" |
| 4 MJ GATE VALVE WITH VALVE BOX. SEE DETAIL, SHEET 121. | 16 FLG x MJ GATE VALVE WITH VALVE BOX. SEE DETAIL, SHEET 121. |
| 5 COUPLING | 17 RESERVED |
| 6 FLG x PE D.I. SPOOL, LENGTH AS REQUIRED | 18 FLG x PE SPOOL, LENGTH AS REQUIRED, FITTINGS AS REQUIRED |
| 7 FLG DI SPOOL x 1'-8" LONG FOR 4" SERVICE. FLG GIP SPOOL x 4'-0" LONG FOR 6" SERVICE. FLG DI SPOOL x 4'-0" LONG FOR 8" SERVICE. | 19 MAINGUARD BLOW-OFF #7600 (SEE TABLE 1, THIS SHEET). ENCLOSURE TO BE CARSON INDUSTRIES MODEL H2436 TRAFFIC BEARING VAULT AND LID WITH EXTENSIONS AS REQUIRED. |
| 8 MICROMETER FLOWMETER MODEL MW500 FOR 3", LP-22 FOR 4-INCH. MODEL LP 32 FOR 6-INCH. | 20 OSHA APPROVED GALVANIZED STEEL LADDER WITH 4 FOOT REMOVABLE EXTENSION |
| 9 FOR PRV/FCV SERVICE ONLY: 3/4" TAPPING SADDLE WITH 3/4" THREADED BRASS BALL VALVE, 3/4"x1/4" BUSHING, AND BRASS QUICK COUPLING PLUG (UNVALVED) | 21 PIPE SUPPORT. SEE TYPICAL PIPE SUPPORT DETAIL SHEET 122. |
| 10 CLA-VAL 49-01 FLOW CONTROL OR COMBINATION FLOW CONTROL AND PRESSURE REDUCING VALVE, TYPE AS SHOWN ON PLANS. SEE TABLE 1, THIS SHEET, AND SPECIFICATIONS FOR DETAILS. | 22 SEAL PIPE PENETRATIONS WATERTIGHT WITH NON-SHRINK GROUT |
| 11 RESTRAINED FLANGE COUPLING ADAPTER | 23 BRASS GRATED DRAIN WITH KNOCKOUT HOLE FOR DRAIN PIPE |
| 12 BRASS QUICK COUPLING PLUG (UNVALVED) AND FITTINGS AS REQUIRED ON ORIFICE PILOT PIPING. PROVIDE ADDITIONAL ISOLATION VALVE. | 24 FLG x PE DI SPOOL x 2 FT. LONG |
| | 25 ORIFICE PLATE |

SERVICE SIZE	CONTROL VALVE SIZE	BLOW-OFF INLET	BLOW-OFF OUTLET
4-INCH	3"	4"	4"
6-INCH	4"	4"	4"
8-INCH	6"	6"	4"

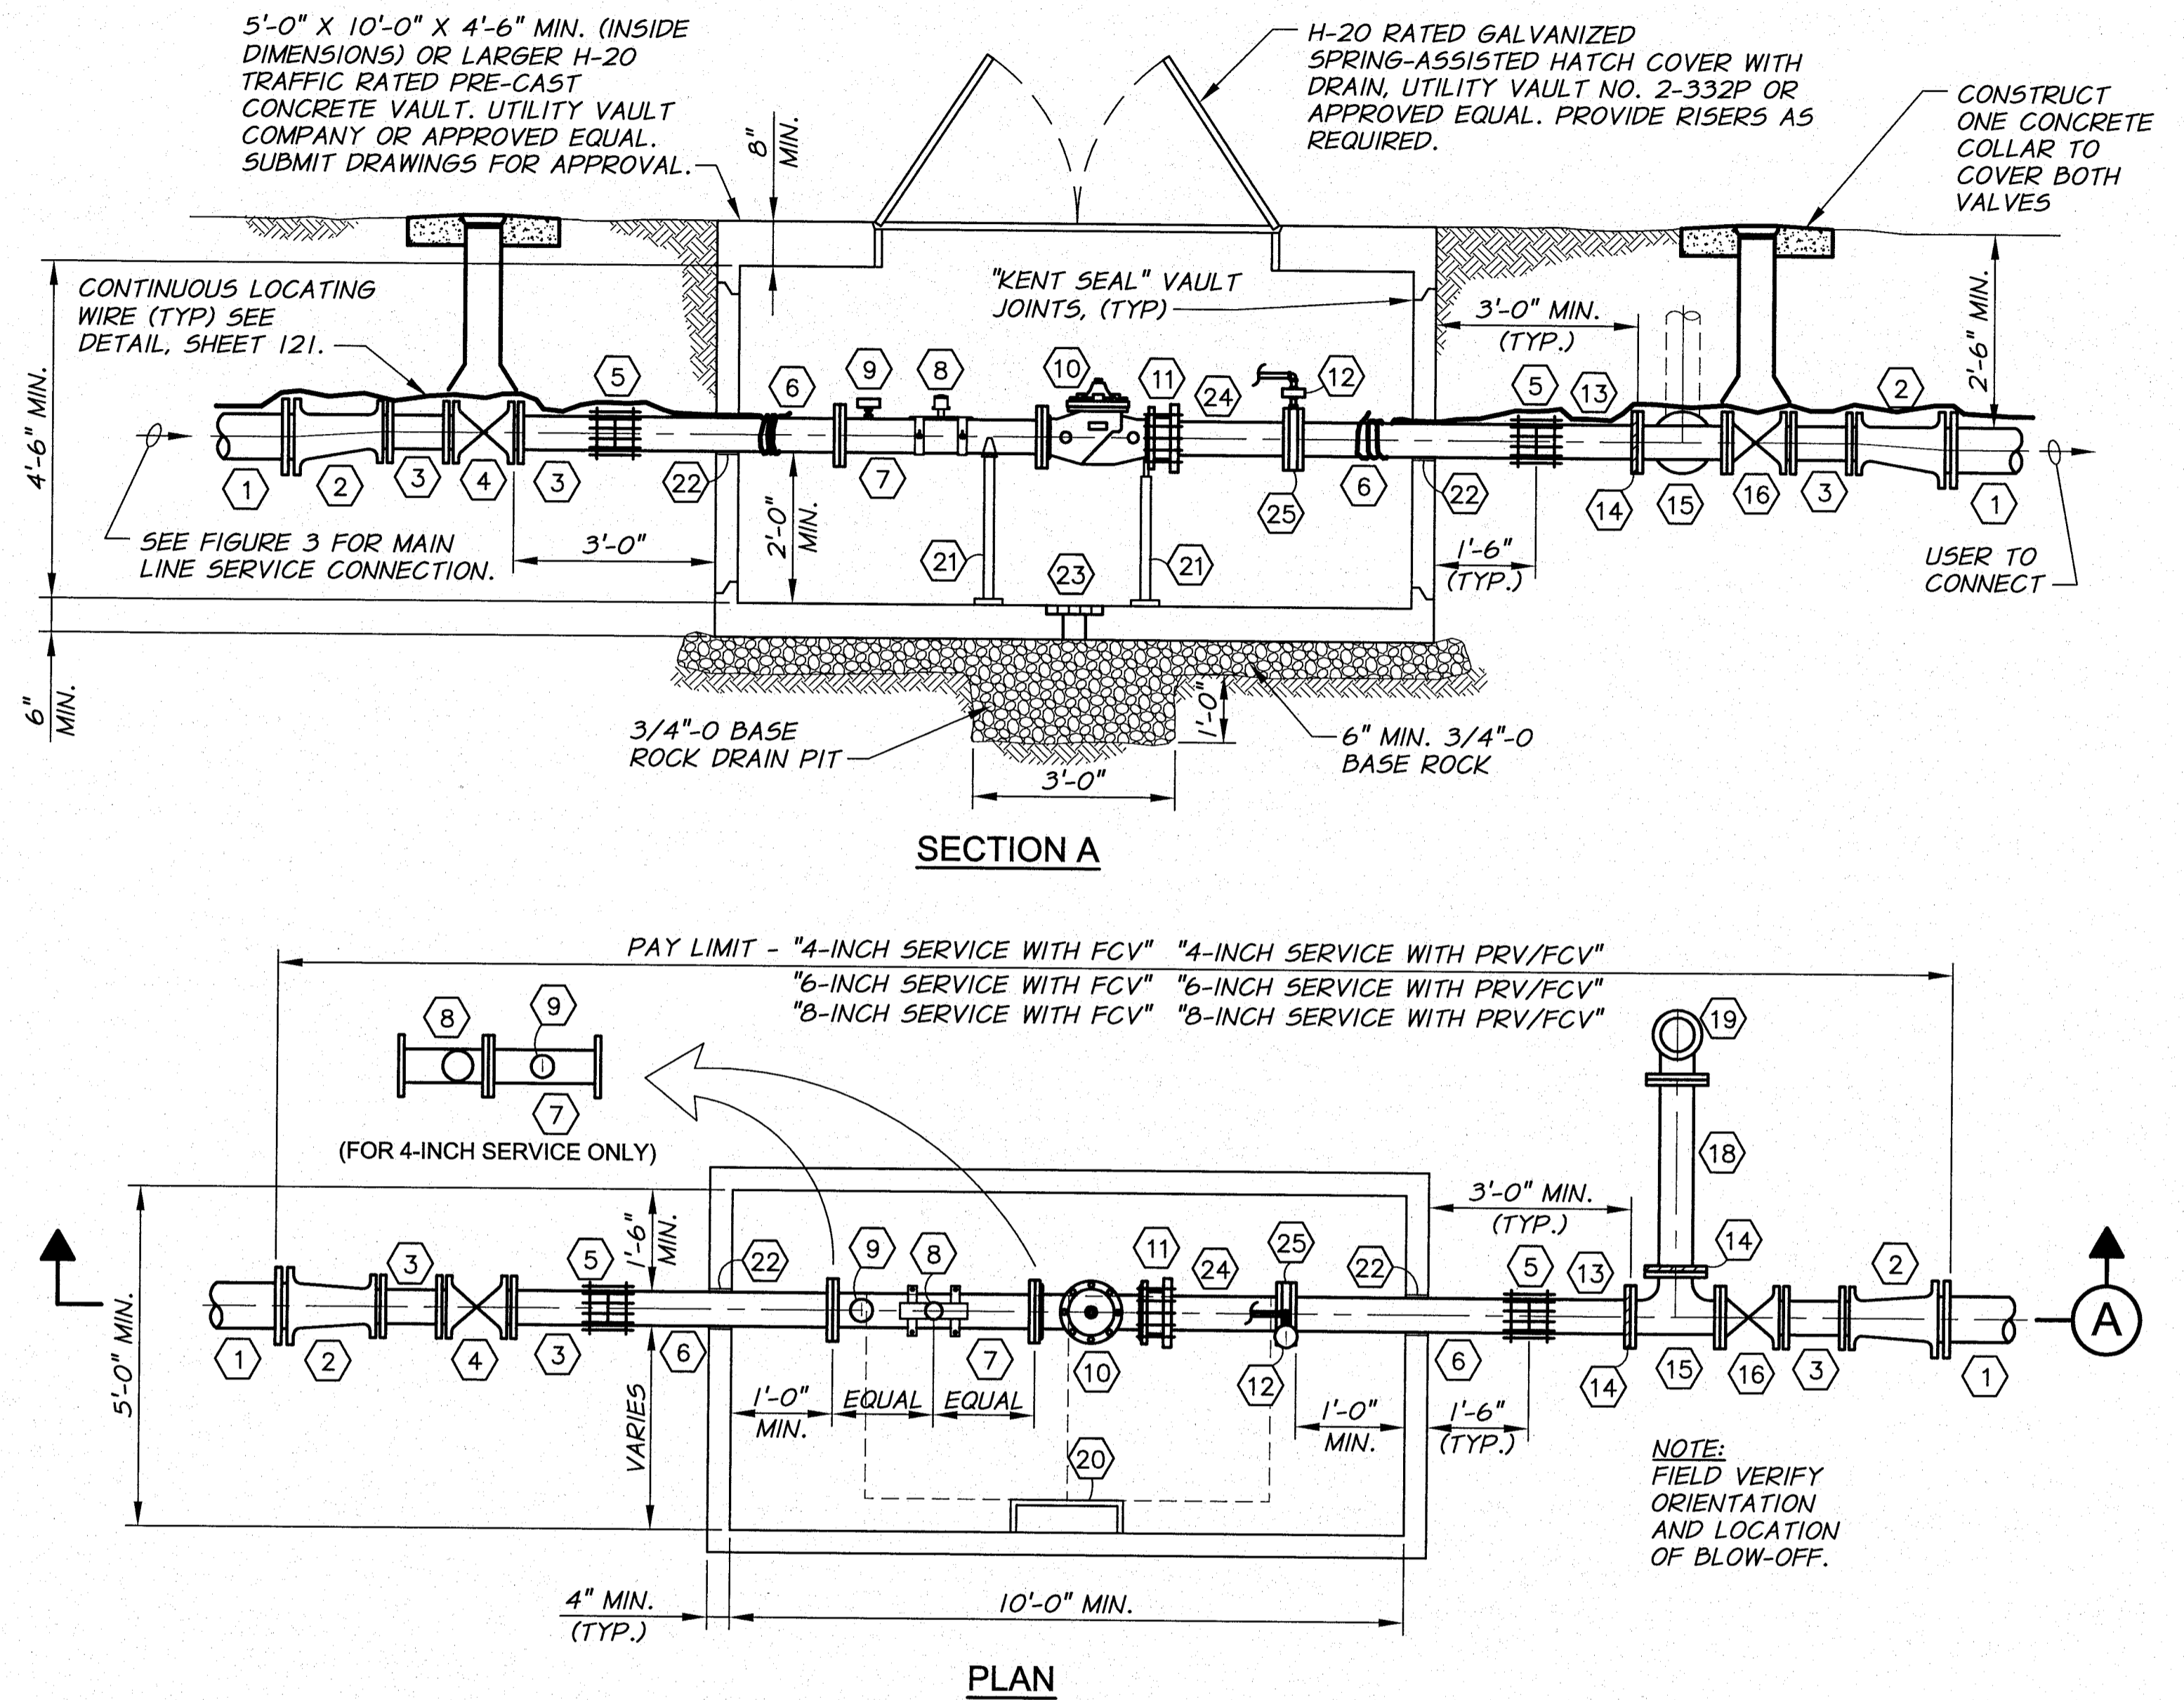


- NOTES:**
1. PIPING SIZE TO MATCH CONTROL VALVE SIZE UNLESS OTHERWISE NOTED.
 2. SET FRAME AND COVER TO GRADE AND PROVIDE GRADE RINGS AS REQUIRED.
 3. PIPE SUPPORTS TO BE SIZED APPROPRIATELY FOR PIPE AND INSTALLED PER MANUFACTURER'S RECOMMENDATIONS.
 4. ALL WORK SHOWN IN THIS DETAIL, INCLUDING ANY REQUIRED SURFACE RESTORATION, SHALL BE INCLUDED IN THE SERVICE PAY ITEM.

4", 6", AND 8" SERVICE WITH PRV/FCV OR FCV DETAIL
N.T.S.

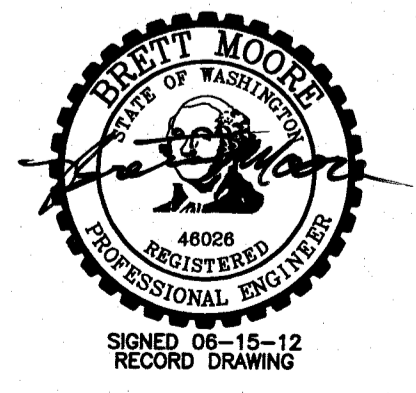

RECORD DRAWING		E.H.	12/11		
DESIGNED BY	R. HARRIS	BY		HORIZ. SCALE	NONE
DRAWN BY	D. CHRISTMAN	DATE		VERT. SCALE	
REVIEWED BY	H. PERRY	JOB NUMBER	1199-336	DATE	2009
		ACAD FILE	ServiceDets.dwg		
COPYRIGHT 2009 BY ANDERSON-PERRY & ASSOC., INC.					

RECORD DRAWINGS
These record drawings have been prepared, in part, on the basis of information compiled and furnished by others. They may contain some discrepancies and omissions, and do not necessarily represent "exact" field conditions. The Owner and the Engineer accept no responsibility for their accuracy.

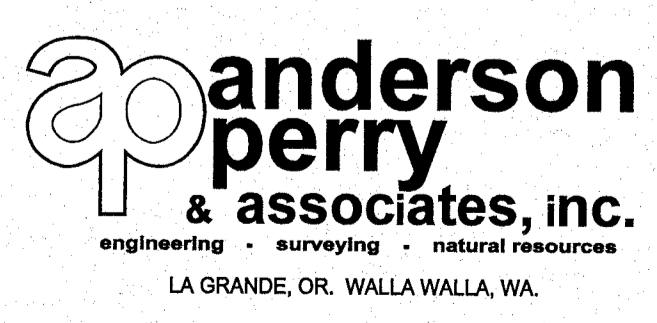

BENTON IRRIGATION DISTRICT
IRRIGATION SYSTEM IMPROVEMENTS
PHASE I
SERVICE DETAILS V


△ SHEET ADDED
SHEET
118C

4'-6" X 8'-6" X 5'-0" MIN. (INSIDE DIMENSIONS) OR LARGER H-20 TRAFFIC RATED PRE-CAST CONCRETE VAULT. UTILITY VAULT COMPANY OR APPROVED EQUAL. SUBMIT DRAWINGS FOR APPROVAL.


H-20 RATED GALVANIZED SPRING-ASSISTED HATCH COVER WITH DRAIN, UTILITY VAULT NO. 2-332P OR APPROVED EQUAL. PROVIDE RISERS AS REQUIRED.

FITTING SCHEDULE

- 1 TRANSITION COUPLING
- 2 GIP, SIZE AS SHOWN ON PLANS
- 3 THREADED GIP REDUCER WHERE REQUIRED
- 4 1 1/4", 2", OR 2 1/2" THREADED GIP
- 5 BRASS THREADED GATE VALVE
- 6 GIP UNION
- 7 SONNTAG ALUMINUM Y FILTER WITH 50 MESH SCREEN
- 8 1 1/4", 2", OR 2 1/2" THREADED PRESSURE REDUCING VALVE, CLA-VAL 90-01 FOR TYPE A. 1 1/4", 2", OR 2 1/2" THREADED PRESSURE REDUCING VALVE, CLA-VAL 990 FOR TYPE B.
- 9 SIZE x 3/4" THREADED GIP TEE
- 10 3/4" THREADED BRASS BALL VALVE WITH 3/4"x1/4" NPT BUSHING AND QUICK COUPLING
- 11 4" SS GLYCERIN FILLED PRESSURE GAUGE WITH FITTINGS AS REQUIRED
- 12 PIPE SUPPORT. SEE DETAIL, SHEET 122
- 13 SEAL PIPE PENETRATIONS WATERTIGHT WITH NON-SHRINK GROUT
- 14 BRASS GRATED DRAIN WITH KNOCKOUT HOLE FOR DRAIN PIPE

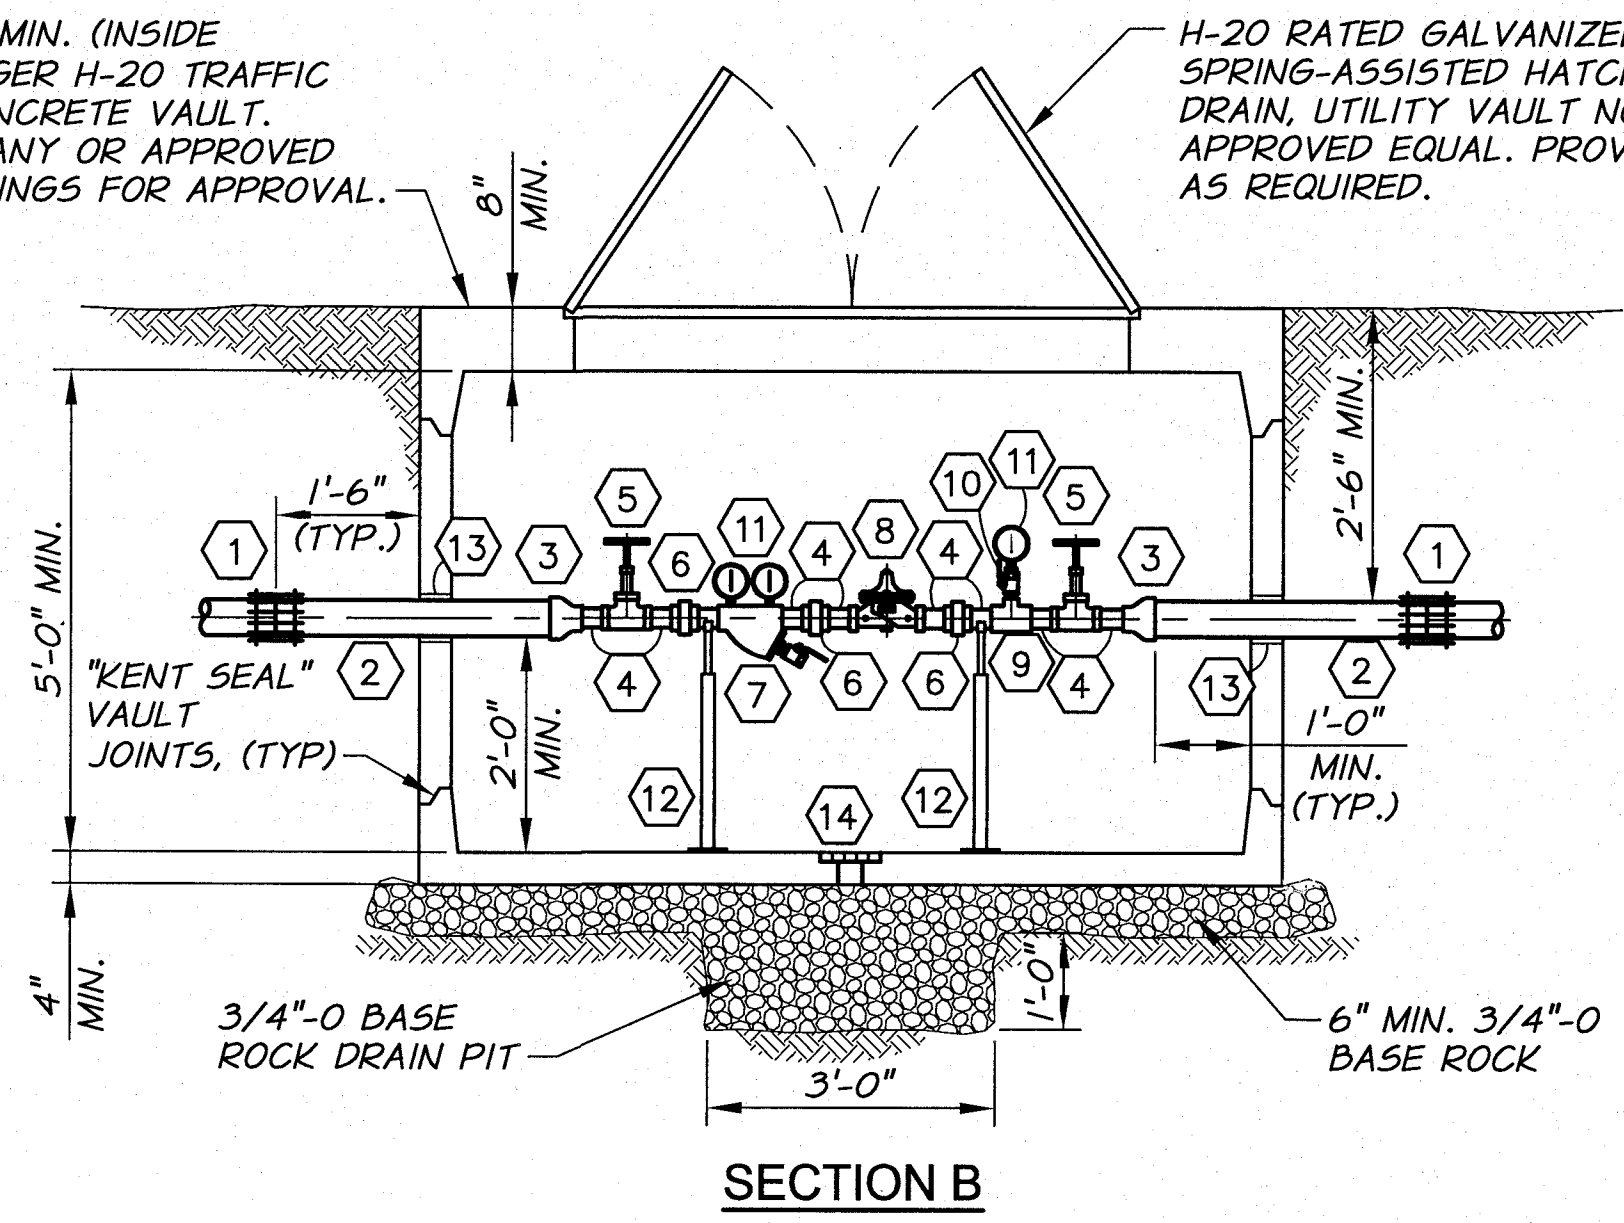

SECTION B

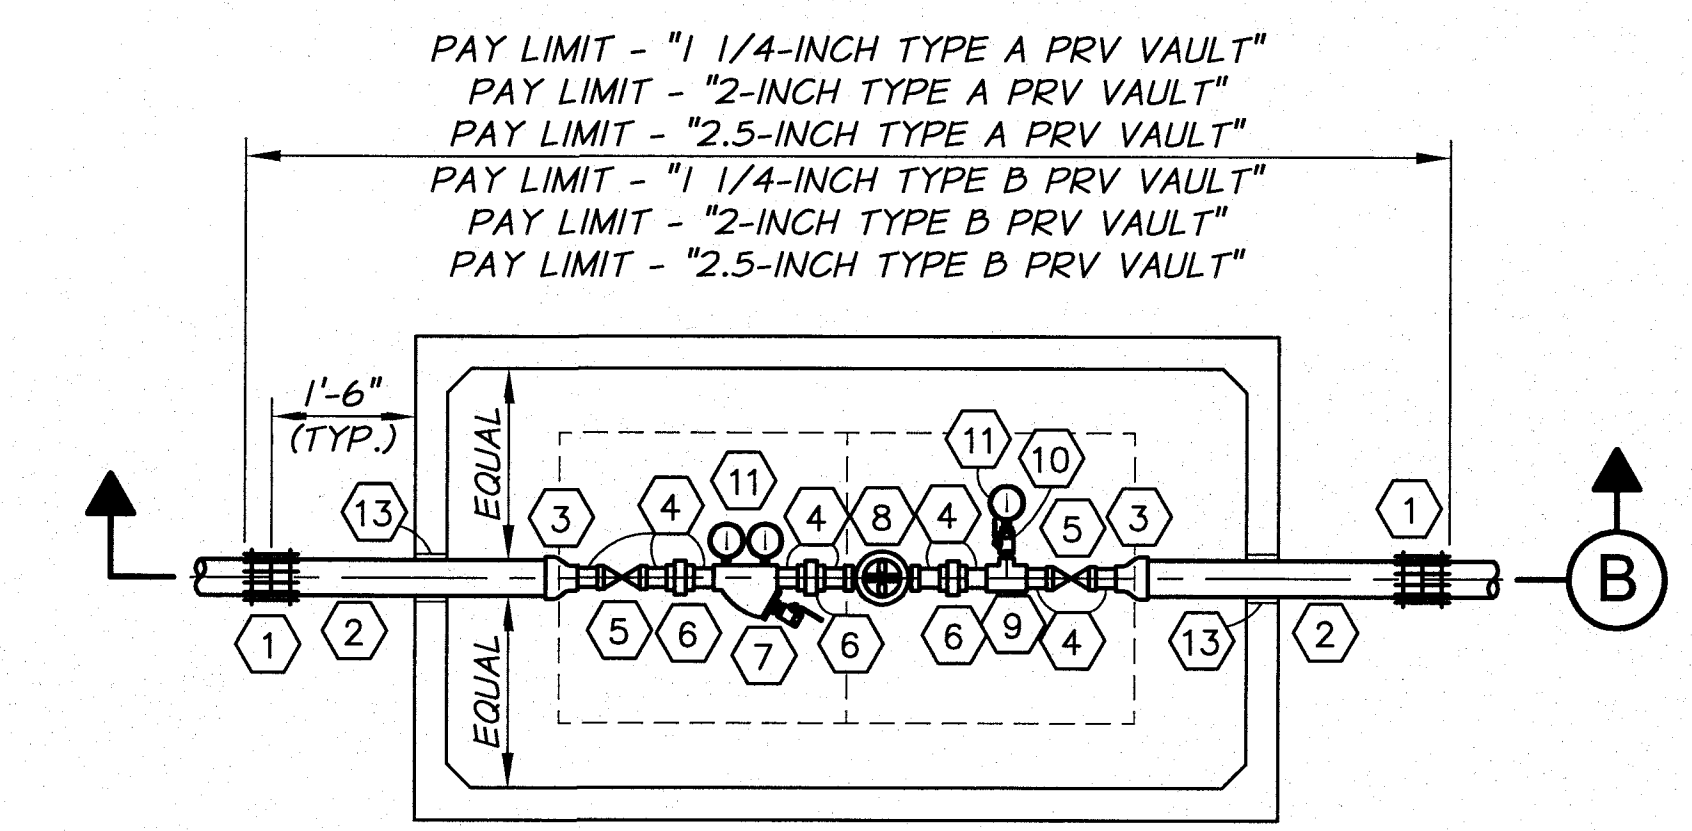


PLAN

NOTES:


1. SET FRAME AND COVER TO GRADE AND PROVIDE GRADE RINGS AS REQUIRED.
2. PIPE SUPPORTS TO BE SIZED APPROPRIATELY FOR PIPE AND INSTALLED PER MANUFACTURER'S RECOMMENDATIONS.
3. ALL WORK SHOWN IN THIS DETAIL, INCLUDING ANY REQUIRED SURFACE RESTORATION, SHALL BE INCLUDED IN THE "2-INCH TYPE A OR B PRESSURE REDUCING VALVE" OR "2.5-INCH TYPE A OR B PRESSURE REDUCING VALVE" PAY ITEM.

1 1/4", 2", AND 2.5" PRESSURE REDUCING VALVE VAULT DETAIL

TYPE A OR TYPE B
1/2"-1'-0"

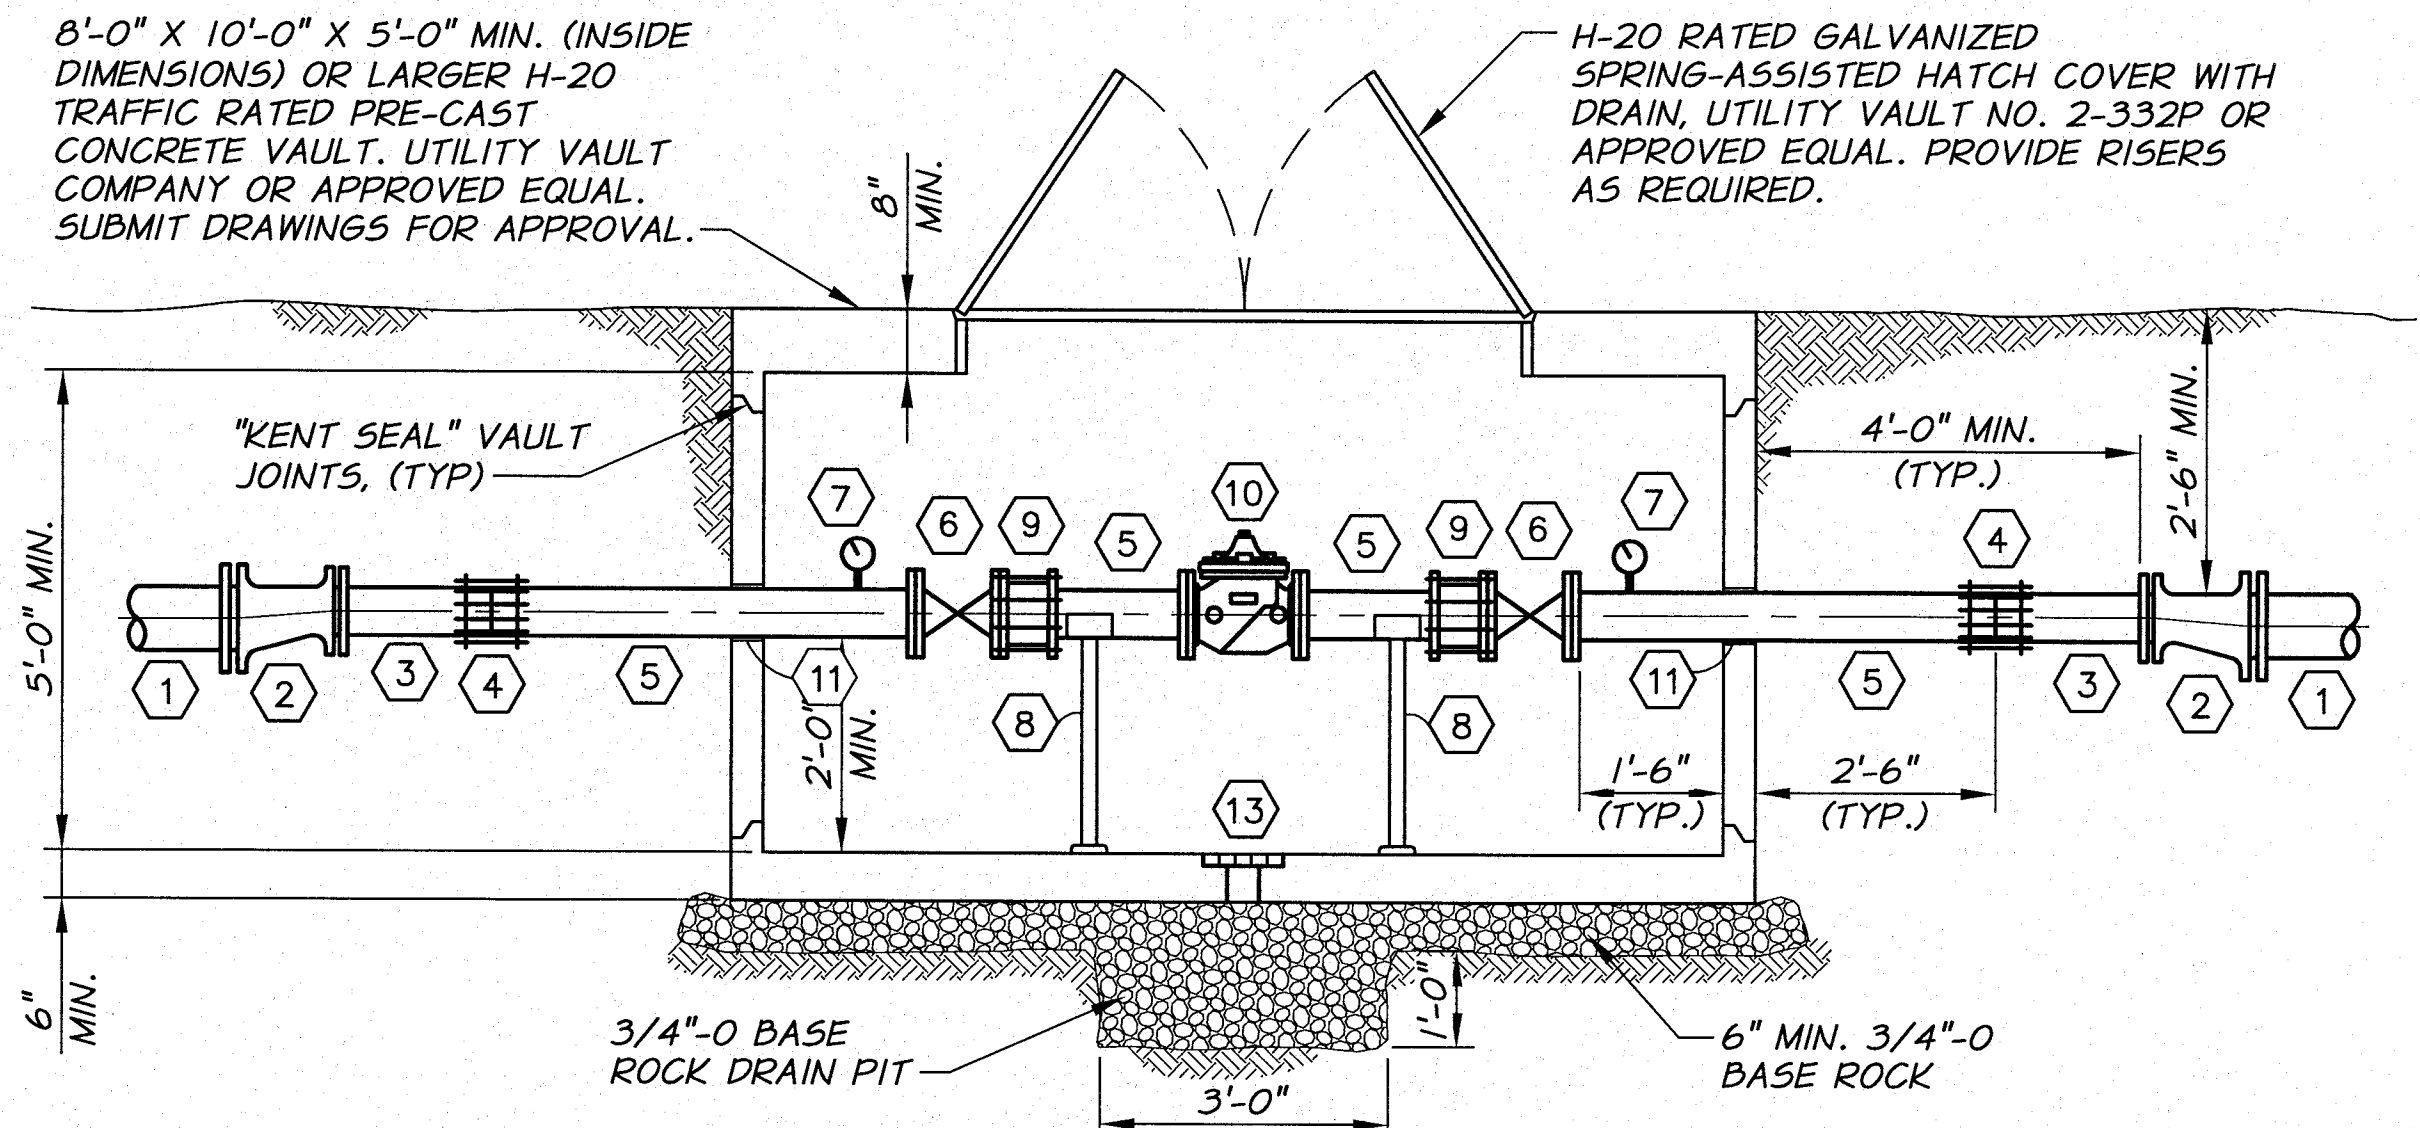

SECTION A

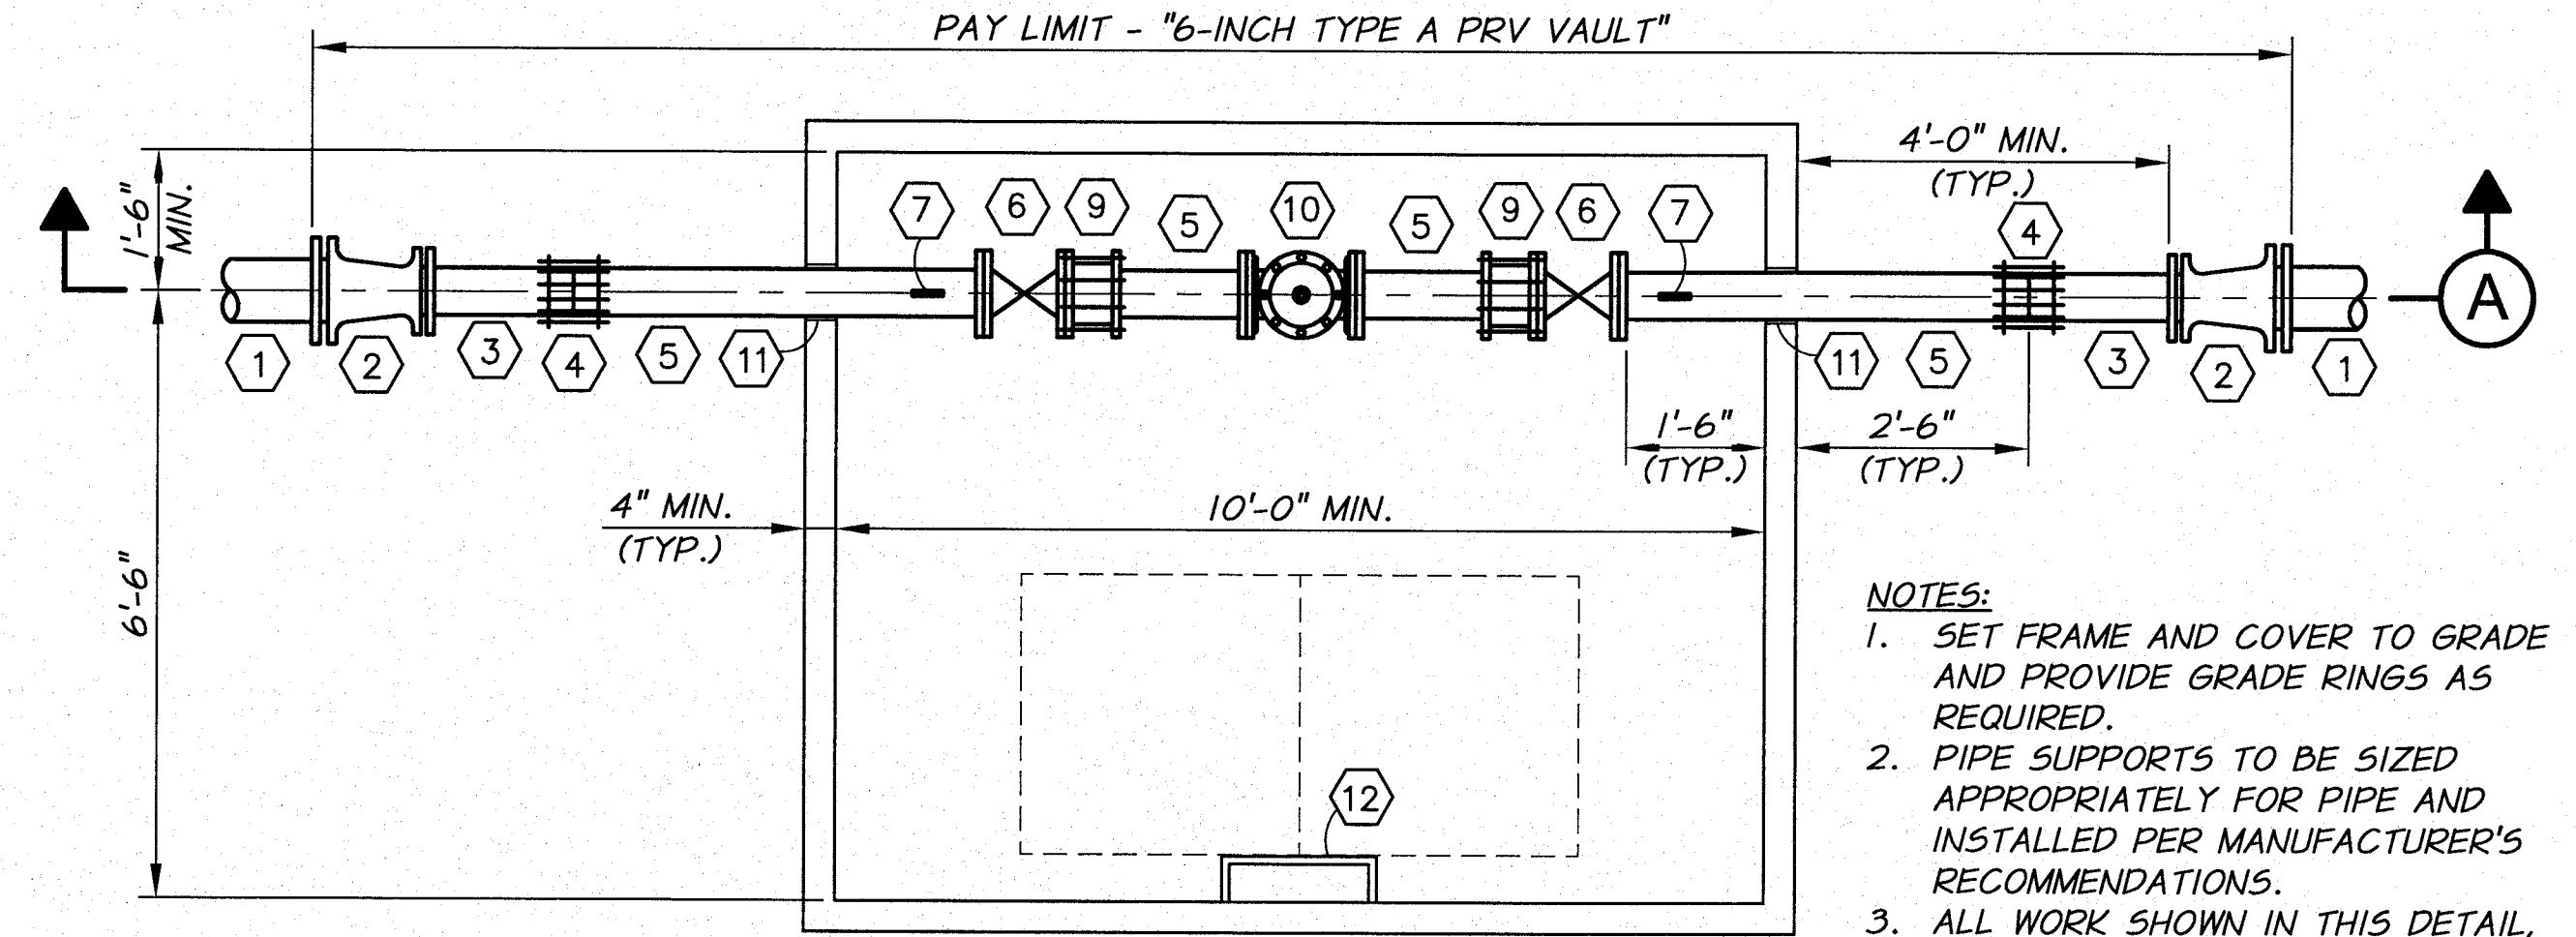

PLAN

NOTES:

1. SET FRAME AND COVER TO GRADE AND PROVIDE GRADE RINGS AS REQUIRED.
2. PIPE SUPPORTS TO BE SIZED APPROPRIATELY FOR PIPE AND INSTALLED PER MANUFACTURER'S RECOMMENDATIONS.
3. ALL WORK SHOWN IN THIS DETAIL, INCLUDING ANY REQUIRED SURFACE RESTORATION, SHALL BE INCLUDED IN THE "6-INCH PRESSURE REDUCING VALVE" PAY ITEM.


FITTING SCHEDULE

- 1 8" PVC PIPING
- 2 8" X 6" MJ ECCENTRIC REDUCER
- 3 6" PE D.I. SPOOL, LENGTH AS REQUIRED
- 4 6" COUPLING
- 5 6" FLG X PE D.I. SPOOL, LENGTH AS REQUIRED
- 6 6" FLG GATE VALVE WITH HANDWHEEL OPERATOR
- 7 4" S.S. PRESSURE GAUGE, GLYCERIN FILLED, 0-150 P.S.I. WITH 2 P.S.I. GRADUATIONS, PRESSURE SNUBBER, ISOLATION VALVE AND FITTINGS AS REQUIRED. TAP D.I. PIPE AS REQUIRED.

- 8 PIPE SUPPORT. SEE TYPICAL PIPE SUPPORT DETAIL SHEET 122.
- 9 6" RESTRAINED FLANGE COUPLING ADAPTER
- 10 6" FLG PRESSURE REDUCING VALVE, CLA-VAL MODEL 90-01 OR APPROVED EQUAL
- 11 SEAL PIPE PENETRATIONS WATERTIGHT WITH NON-SHRINK GROUT
- 12 OSHA APPROVED GALVANIZED STEEL LADDER WITH 4 FOOT REMOVABLE EXTENSION
- 13 BRASS GRATED DRAIN WITH KNOCKOUT HOLE FOR DRAIN PIPE

6" TYPE A PRESSURE REDUCING VALVE VAULT DETAIL


1/2"-1'-0"

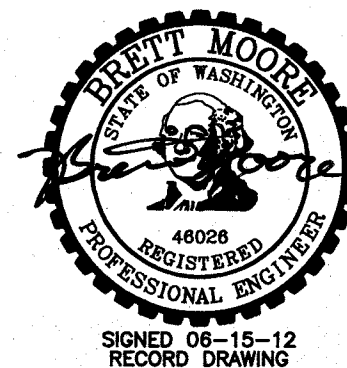

RECORD DRAWING		E.H. 12/11		SCALE IN FEET	
DESIGNED BY	R. HARRIS	DATE	12/11	HORIZ. SCALE	1/2" = 1'-0"
DRAWN BY	D. CHRISTMAN	JOB NUMBER	1199-336	VERT. SCALE	
REVIEWED BY	H. PERRY	ACAD FILE	lrrgDets-1.dwg	DATE	2009
COPYRIGHT 2009 BY ANDERSON-PERRY & ASSOC., INC.					

RECORD DRAWINGS

These record drawings have been prepared, in part, on the basis of information compiled and furnished by others. They may contain some discrepancies and omissions, and do not necessarily represent "exact" field conditions. The Owner and the Engineer accept no responsibility for their accuracy.

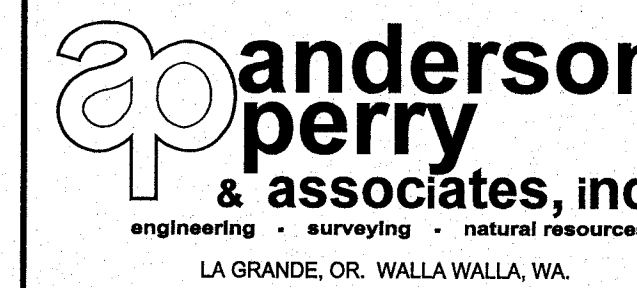



BENTON IRRIGATION DISTRICT
IRRIGATION SYSTEM IMPROVEMENTS
PHASE I

PRESSURE REDUCER VAULT DETAILS

SHEET

119

ARCHIVED

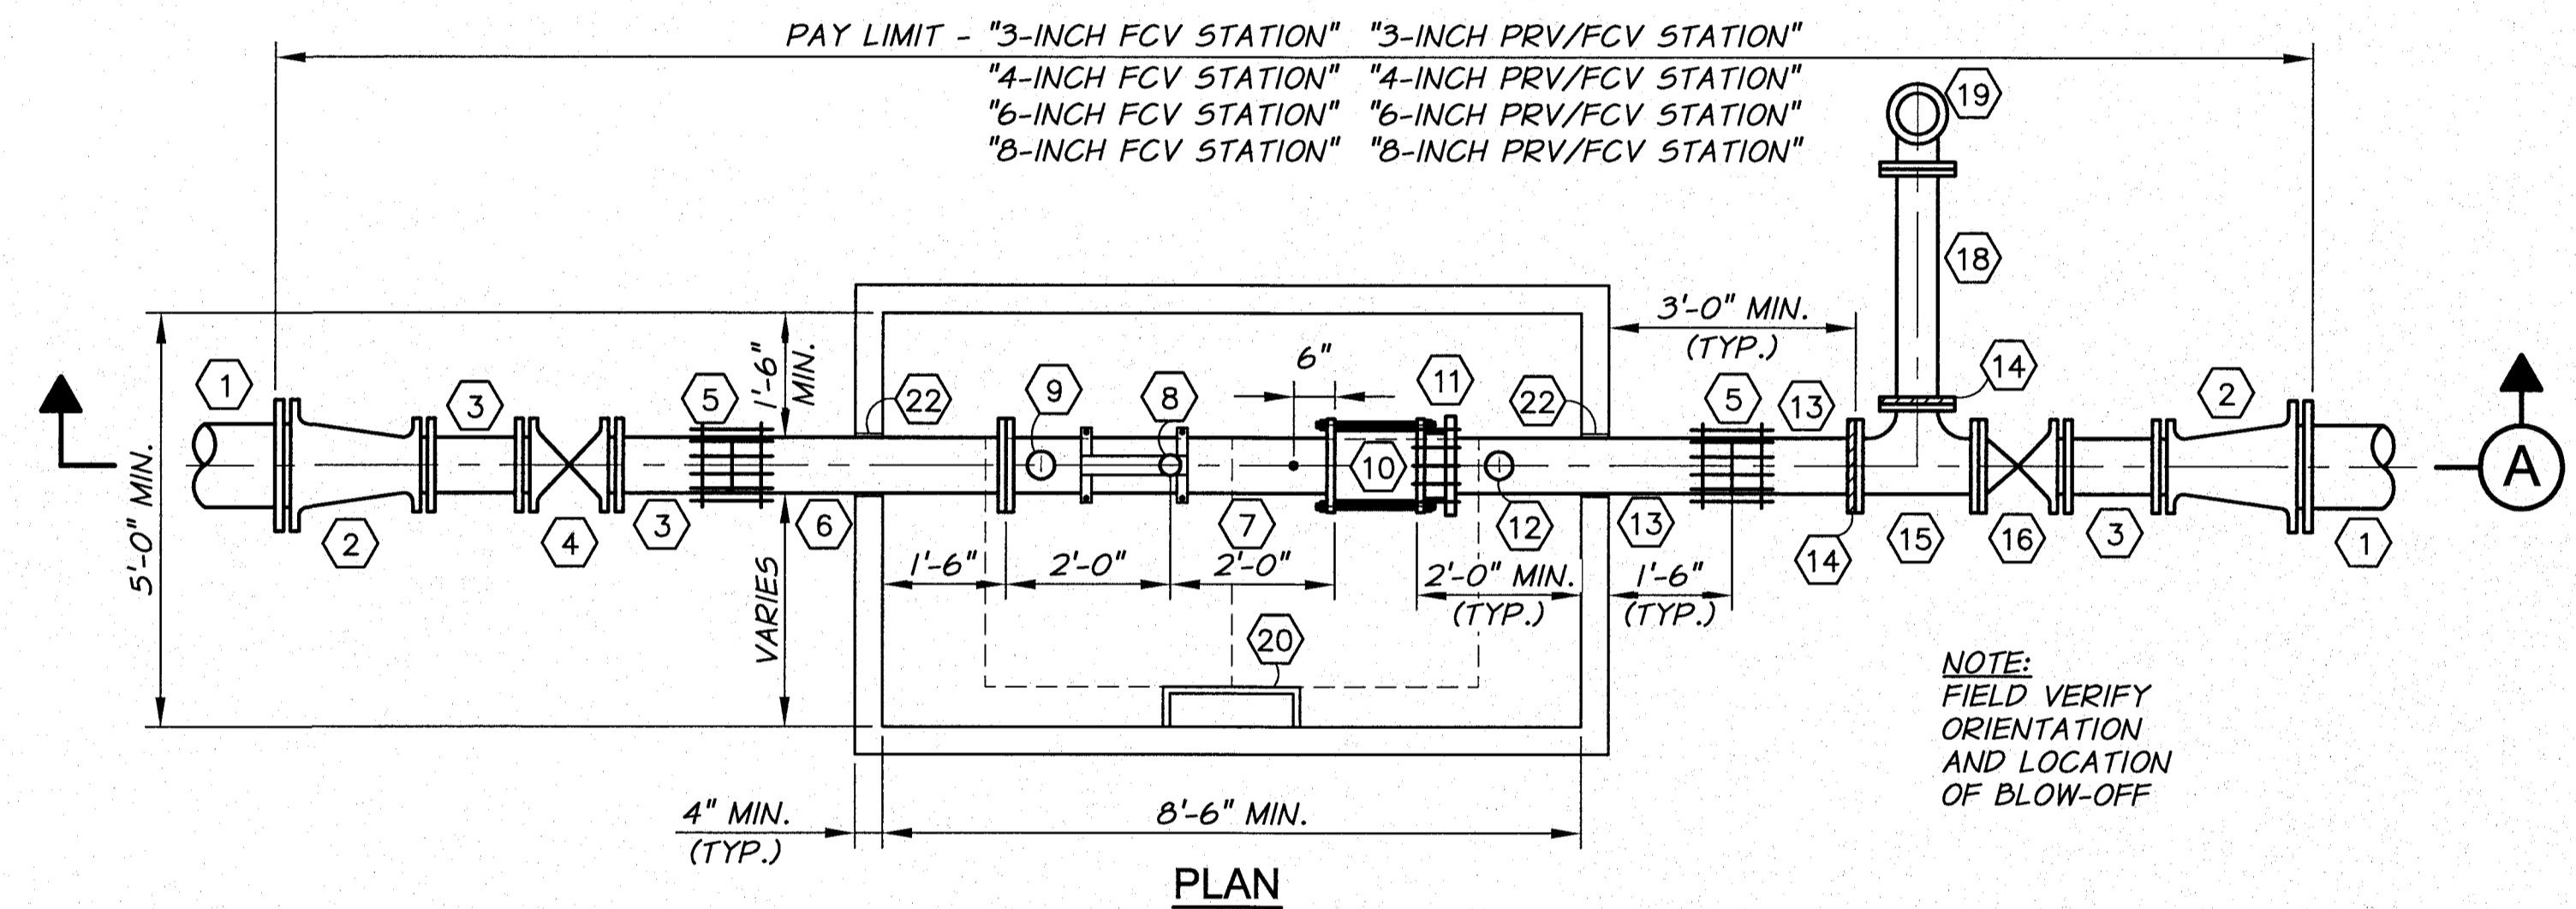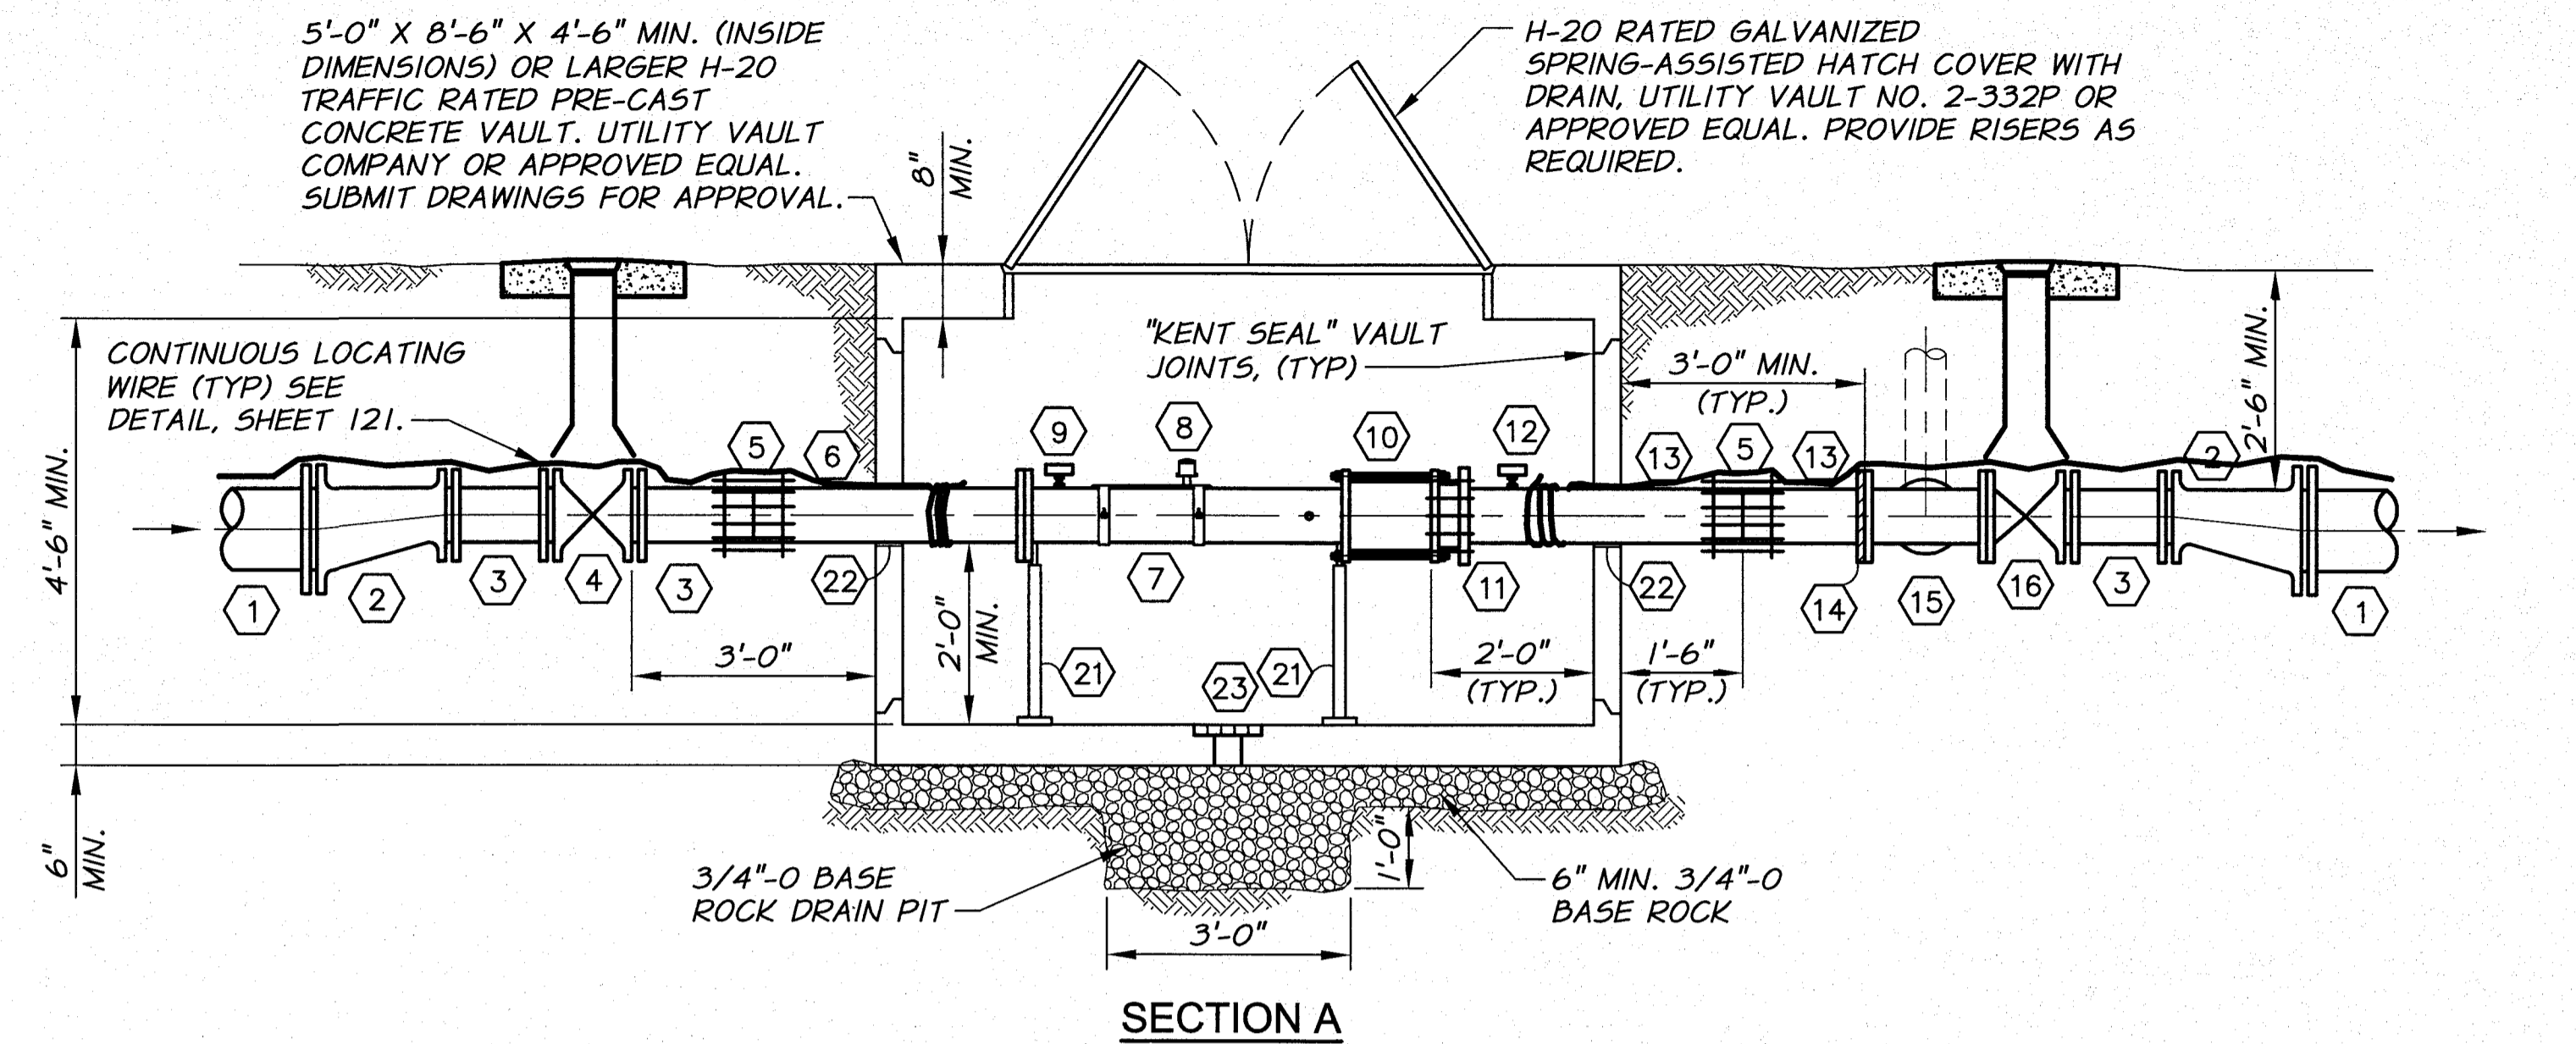


- NOTES:**
1. PIPING SIZE TO MATCH CONTROL VALVE SIZE UNLESS OTHERWISE NOTED.
 2. SET FRAME AND COVER TO GRADE AND PROVIDE GRADE RINGS AS REQUIRED.
 3. PIPE SUPPORTS TO BE SIZED APPROPRIATELY FOR PIPE AND INSTALLED PER MANUFACTURER'S RECOMMENDATIONS.
 4. ALL WORK SHOWN IN THIS DETAIL, INCLUDING ANY REQUIRED SURFACE RESTORATION, SHALL BE INCLUDED IN THE "-INCH FCV STATION" OR THE "-INCH PRV/FCV STATION" PAY ITEM.

CONTROL VALVE SIZE	BLOW-OFF TYPE	INLET	OUTLET
3-INCH	ECLIPSE NO. 85 BLOW-OFF HYDRANT	3"	2 1/2 NST
4-INCH	MAINGUARD BLOW-OFF #7600	4"	4"
6-INCH	MAINGUARD BLOW-OFF #7600	4"	4"
8-INCH	MAINGUARD BLOW-OFF #7600	6"	4"

3", 4", 6" AND 8" PRV/FCV AND FCV STATION DETAIL
N.T.S.


FITTING SCHEDULE

- 1 PVC PIPING, SIZE PER MAIN LINE
- 2 MJ ECCENTRIC REDUCER
- 3 PVC PIPING
- 4 MJ GATE VALVE WITH VALVE BOX. SEE DETAIL, SHEET 121.
- 5 COUPLING
- 6 FLG X PE D.I. SPOOL, LENGTH AS REQUIRED
- 7 FLG DI SPOOL x 2'-8" LONG FOR 3" STATION. FLG GIP SPOOL x 4'-0" LONG FOR 4" STATION. FLG DI SPOOL x 4'-0" LONG FOR 6" AND 8" STATIONS.
- 8 MICROMETER FLOWMETER MODEL MW500 FOR 3", LP-22 FOR 4-INCH. MODEL LP 32 FOR PIPE SIZE GREATER THAN 4-INCH.
- 9 FOR PRV/FCV STATIONS ONLY: 3/4" TAPPING SADDLE WITH 3/4" THREADED BRASS BALL VALVE, 3/4"x1/4" BUSHING, AND BRASS QUICK COUPLING PLUG (UNVALVED)
- 10 WAFER STYLE 800 SERIES NELSON CONTROL VALVE. TYPE AS SHOWN ON PLANS, PRV/FCV OR FCV. SEE SPECIFICATIONS FOR DETAILS. PROVIDE LONG BOLTS FOR FLANGES AS REQUIRED. LOCATE PADDLE 6" UPSTREAM OF VALVE. 1-INCH TAPPING SADDLE REQUIRED.
- 11 RESTRAINED FLANGE COUPLING ADAPTER
- 12 SAME AS ITEM 9, REQUIRED FOR BOTH TYPES OF CONTROL VALVES.
- 13 PE DI SPOOL LENGTH AS REQUIRED
- 14 FLANGE COUPLING ADAPTER
- 15 FLG SIZExSIZExSIZE TEE, BRANCH NOT TO EXCEED 6"
- 16 FLGxMJ GATE VALVE WITH VALVE BOX. SEE DETAIL, SHEET 121.
- 17 RESERVED
- 18 FLGxPE SPOOL, LENGTH AS REQUIRED, FITTINGS AS REQUIRED
- 19 MAINGUARD BLOW-OFF #7600 FOR 4-INCH, 6-INCH AND 8-INCH CONTROL VALVE STATIONS. ECLIPSE NO. 85 BLOW-OFF HYDRANT FOR 3-INCH CONTROL VALVE STATIONS (SEE TABLE 1, THIS SHEET). ENCLOSURE TO BE CARSON INDUSTRIES MODEL H2436 TRAFFIC BEARING VAULT AND LID WITH EXTENSIONS AS REQUIRED.
- 20 OSHA APPROVED GALVANIZED STEEL LADDER WITH 4 FOOT REMOVABLE EXTENSION
- 21 PIPE SUPPORT. SEE TYPICAL PIPE SUPPORT DETAIL SHEET 122.
- 22 SEAL PIPE PENETRATIONS WATERTIGHT WITH NON-SHRINK GROUT
- 23 BRASS GRATED DRAIN WITH KNOCKOUT HOLE FOR DRAIN PIPE

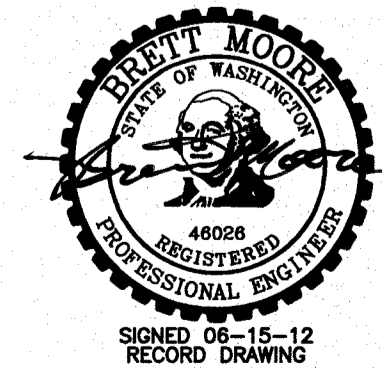

RECORD DRAWING	BY: E.H.	DATE: 12/11	HORIZ. SCALE: NONE	VERT. SCALE:
DESIGNED BY: R. HARRIS	XREFS: TB-BID.dwg		JOB NUMBER: 1199-336	DATE: 2009
DRAWN BY: D. CHRISTMAN			ACAD FILE: IrrgDets-l.dwg	
REVIEWED BY: H. PERRY			COPYRIGHT 2009 BY ANDERSON-PERRY & ASSOC., INC.	

RECORD DRAWINGS
These record drawings have been prepared, in part, on the basis of information compiled and furnished by others. They may contain some discrepancies and omissions, and do not necessarily represent "exact" field conditions. The Owner and the Engineer accept no responsibility for their accuracy.

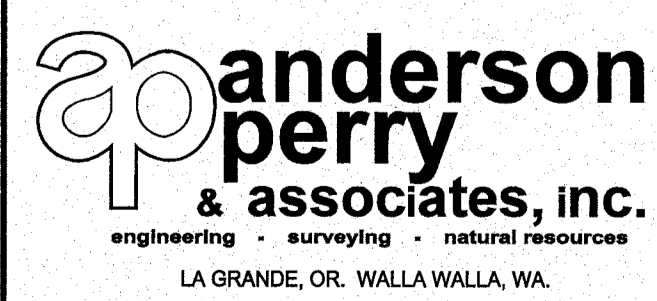



BENTON IRRIGATION DISTRICT
IRRIGATION SYSTEM IMPROVEMENTS
PHASE I
PRV/FCV AND FCV STATIONS

SHEET ADDED
119A

ARCHIVED

FITTING SCHEDULE


- ① 8" PVC PIPING
- ② 8"x6" MJ ECCENTRIC REDUCER
- ③ 6" PVC PIPING
- ④ 6" MJ GATE VALVE WITH VALVE BOX. SEE DETAIL, SHEET 121.
- ⑤ 6" COUPLING ADAPTER
- ⑥ 6" FLGxPE D.I. SPOOL, LENGTH AS REQUIRED
- ⑦ 6" FLG DI SPOOL x 4'-0" LONG
- ⑧ MICROMETER FLOWMETER MODEL LP 32
- ⑨ 3/4" TAPPING SADDLE WITH 3/4" THREADED BRASS BALL VALVE, 3/4"x1/4" BUSHING, AND BRASS QUICK COUPLING PLUG (UNVALVED)
- ⑩ WAFER STYLE 800 SERIES NELSON CONTROL VALVE, PRV/FCV. PROVIDE LONG BOLTS FOR FLANGES AS REQUIRED. LOCATE PADDLE 6" UPSTREAM OF VALVE. 1-INCH TAPPING SADDLE REQUIRED.
- ⑪ 6" RESTRAINED FLANGE COUPLING ADAPTER
- ⑫ 2 1/2" SERVICE SADDLE
- ⑬ 6" PE DI SPOOL LENGTH AS REQUIRED
- ⑭ 6" FLANGE COUPLING ADAPTER
- ⑮ 6" FLG TEE
- ⑯ 6" FLGxMJ GATE VALVE WITH VALVE BOX. SEE DETAIL, SHEET 121.
- ⑰ 2 1/2" GIP, LENGTH AS REQUIRED
- ⑱ 2 1/2" GIP 90° ELBOW
- ⑲ MAINGUARD BLOW-OFF #7600. ENCLOSURE TO BE CARSON INDUSTRIES MODEL H2436 TRAFFIC BEARING VAULT AND LID WITH EXTENSIONS AS REQUIRED.
- ⑳ OSHA APPROVED GALVANIZED STEEL LADDER WITH 4 FOOT REMOVABLE EXTENSION
- ㉑ PIPE SUPPORT. SEE TYPICAL PIPE SUPPORT DETAIL SHEET 122.
- ㉒ SEAL PIPE PENETRATIONS WATERTIGHT WITH NON-SHRINK GROUT
- ㉓ BRASS GRATED DRAIN WITH KNOCKOUT HOLE FOR DRAIN PIPE
- ㉔ 2 1/2" BRASS THREADED GATE VALVE
- ㉕ 3" RAISED FACE FLANGE WITH REDUCING BUSHING AND 2 1/2" GIP NIPPLE
- ㉖ 3" DOLE FLOW CONTROL VALVE WITH 3" RAISED FACE FLANGE EACH END
- ㉗ 2 1/2" GIP TEE
- ㉘ 2 1/2" GIP UNION
- ㉙ 2 1/2" COUPLING ADAPTER
- ㉚ 2 1/2" PVC PIPING AND FITTINGS AS REQUIRED

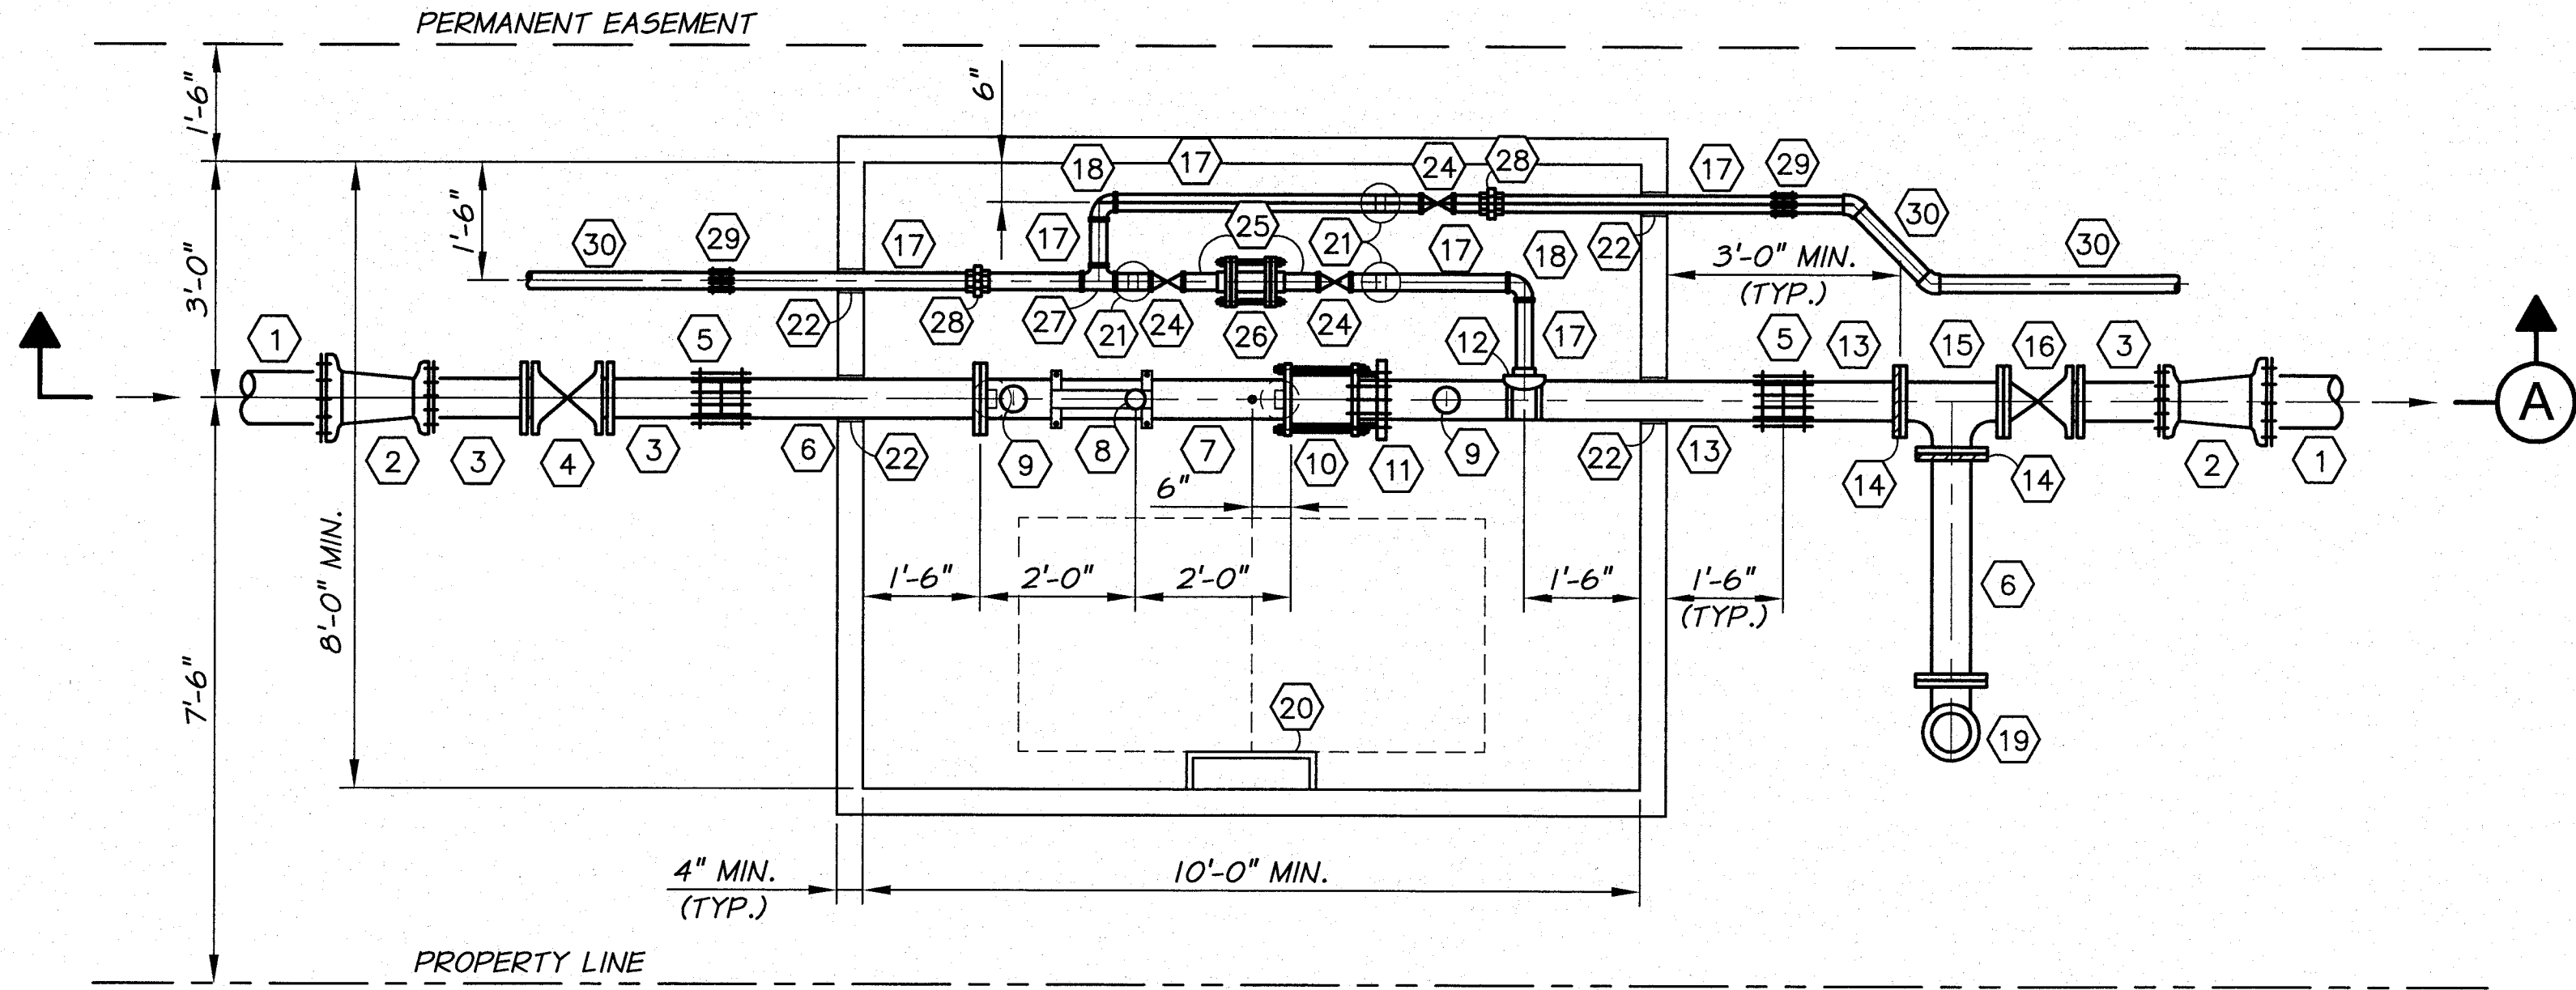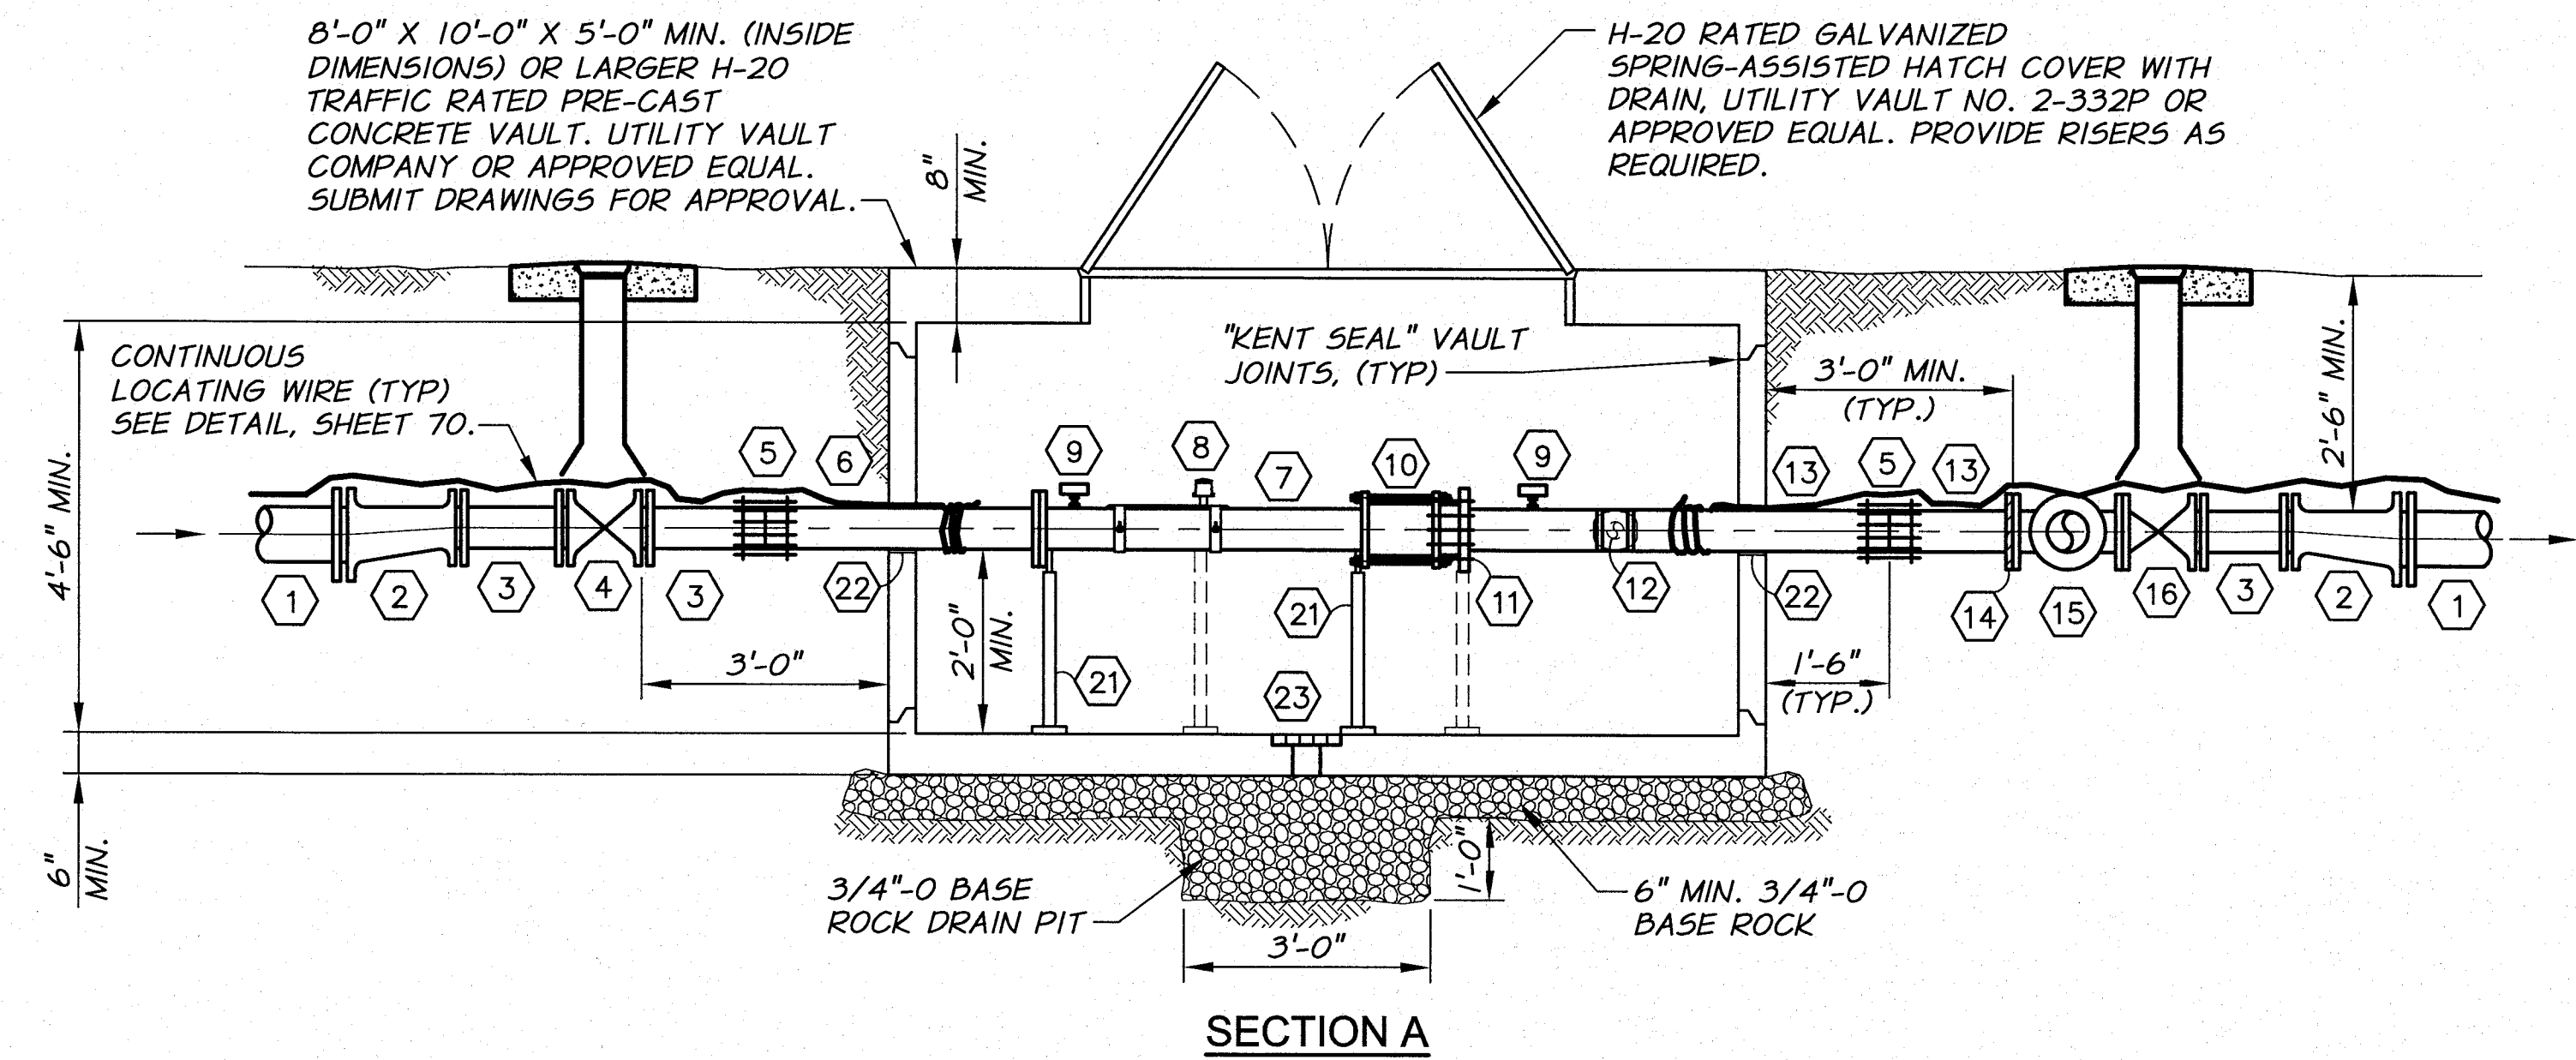

NOTES:


1. SET FRAME AND COVER TO GRADE AND PROVIDE GRADE RINGS AS REQUIRED.
2. PIPE SUPPORTS TO BE SIZED APPROPRIATELY FOR PIPE AND INSTALLED PER MANUFACTURER'S RECOMMENDATIONS.
3. ALL WORK SHOWN IN THIS DETAIL, INCLUDING ANY REQUIRED SURFACE RESTORATION, SHALL BE INCLUDED IN THE "6-INCH PRV/FCV STATION" PAY ITEM.

6" PRV/FCV STATION DETAIL
N.T.S.

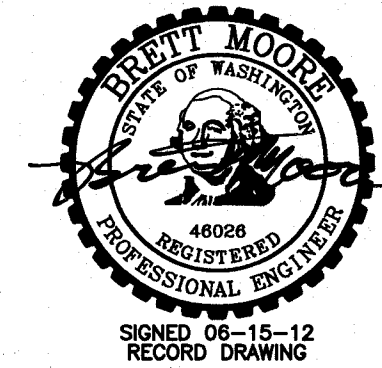

RECORD DRAWING		BY	DATE	HORIZ. SCALE	VERT. SCALE
		E.H.	12/11	NONE	
DESIGNED BY	R. HARRIS	XREFS: TB-BID.dwg		JOB NUMBER	1199-336
DRAWN BY	D. CHRISTMAN			DATE	2009
REVIEWED BY	H. PERRY			ACAD FILE	IrrgDets-1.dwg
COPYRIGHT 2009 BY ANDERSON-PERRY & ASSOC., INC.					



RECORD DRAWINGS
These record drawings have been prepared, in part, on the basis of information compiled and furnished by others. They may contain some discrepancies and omissions, and do not necessarily represent "exact" field conditions. The Owner and the Engineer accept no responsibility for their accuracy.

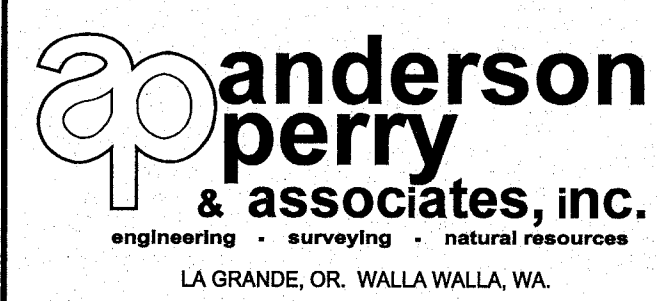

BENTON IRRIGATION DISTRICT
IRRIGATION SYSTEM IMPROVEMENTS
PHASE I
PRV/FCV STATION DETAIL

▲ SHEET ADDED
SHEET
119B

H-20 TRAFFIC RATED PRE-CAST CONCRETE VAULT. UTILITY VAULT COMPANY OR APPROVED EQUAL. SUBMIT DRAWINGS FOR APPROVAL. 4'-6" X 10'-0" X 4'-6" MIN. (INSIDE DIMENSIONS)

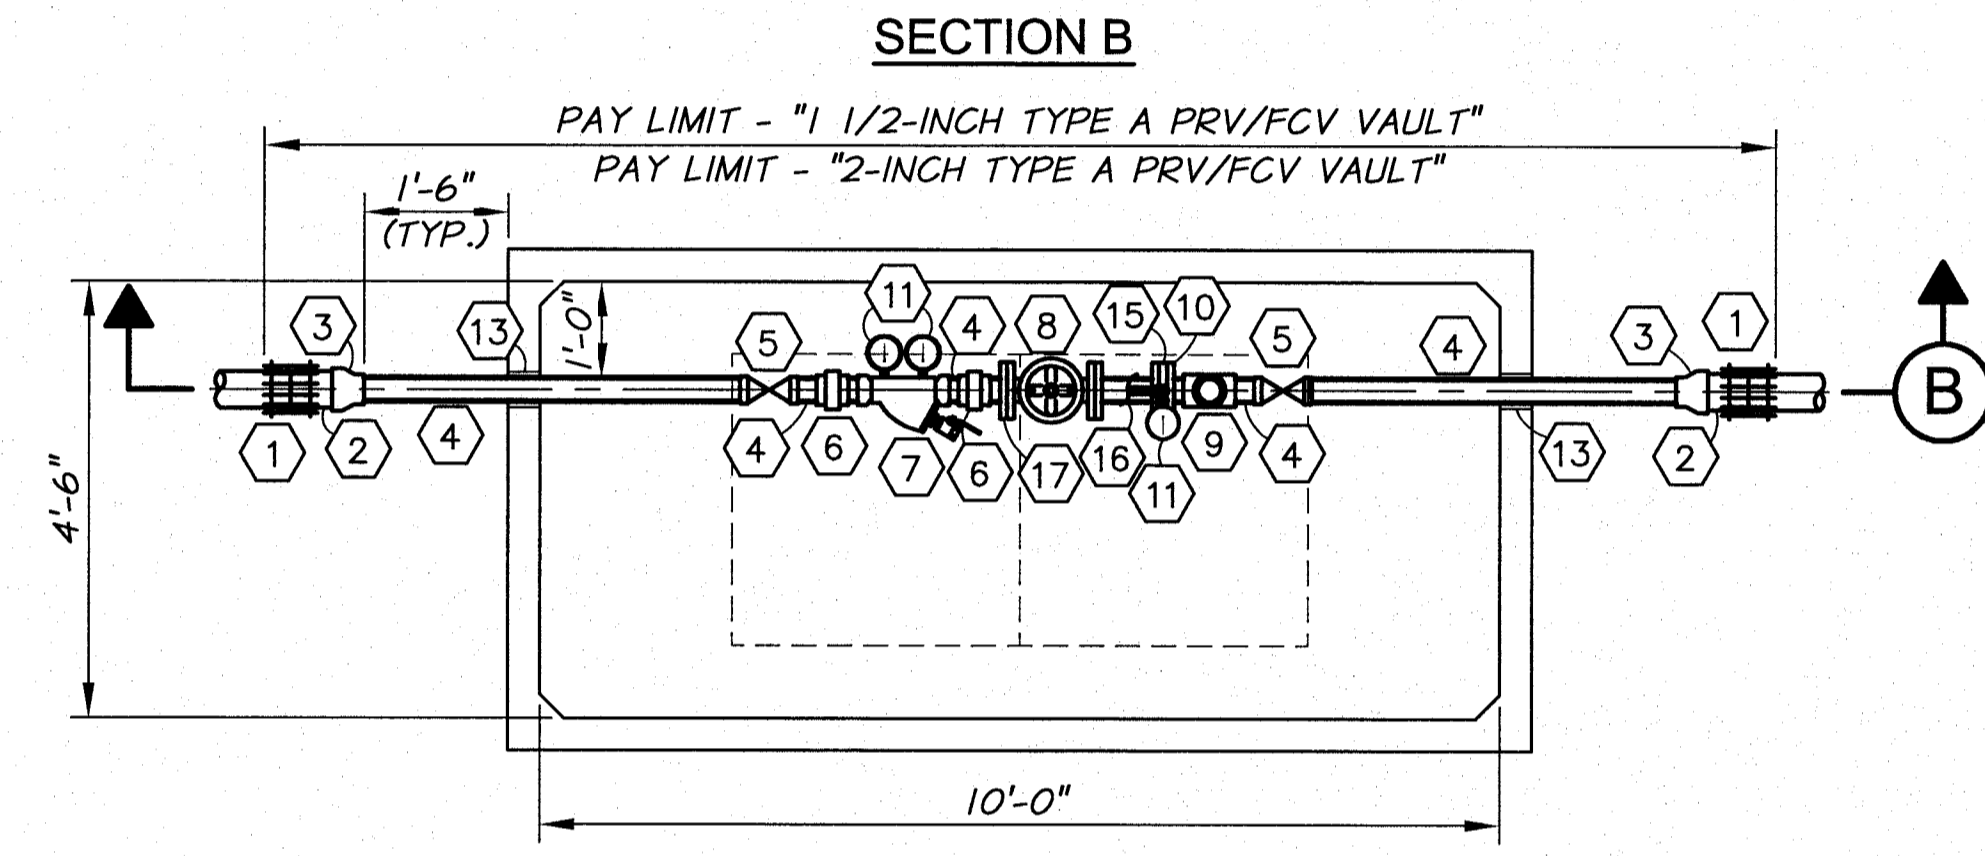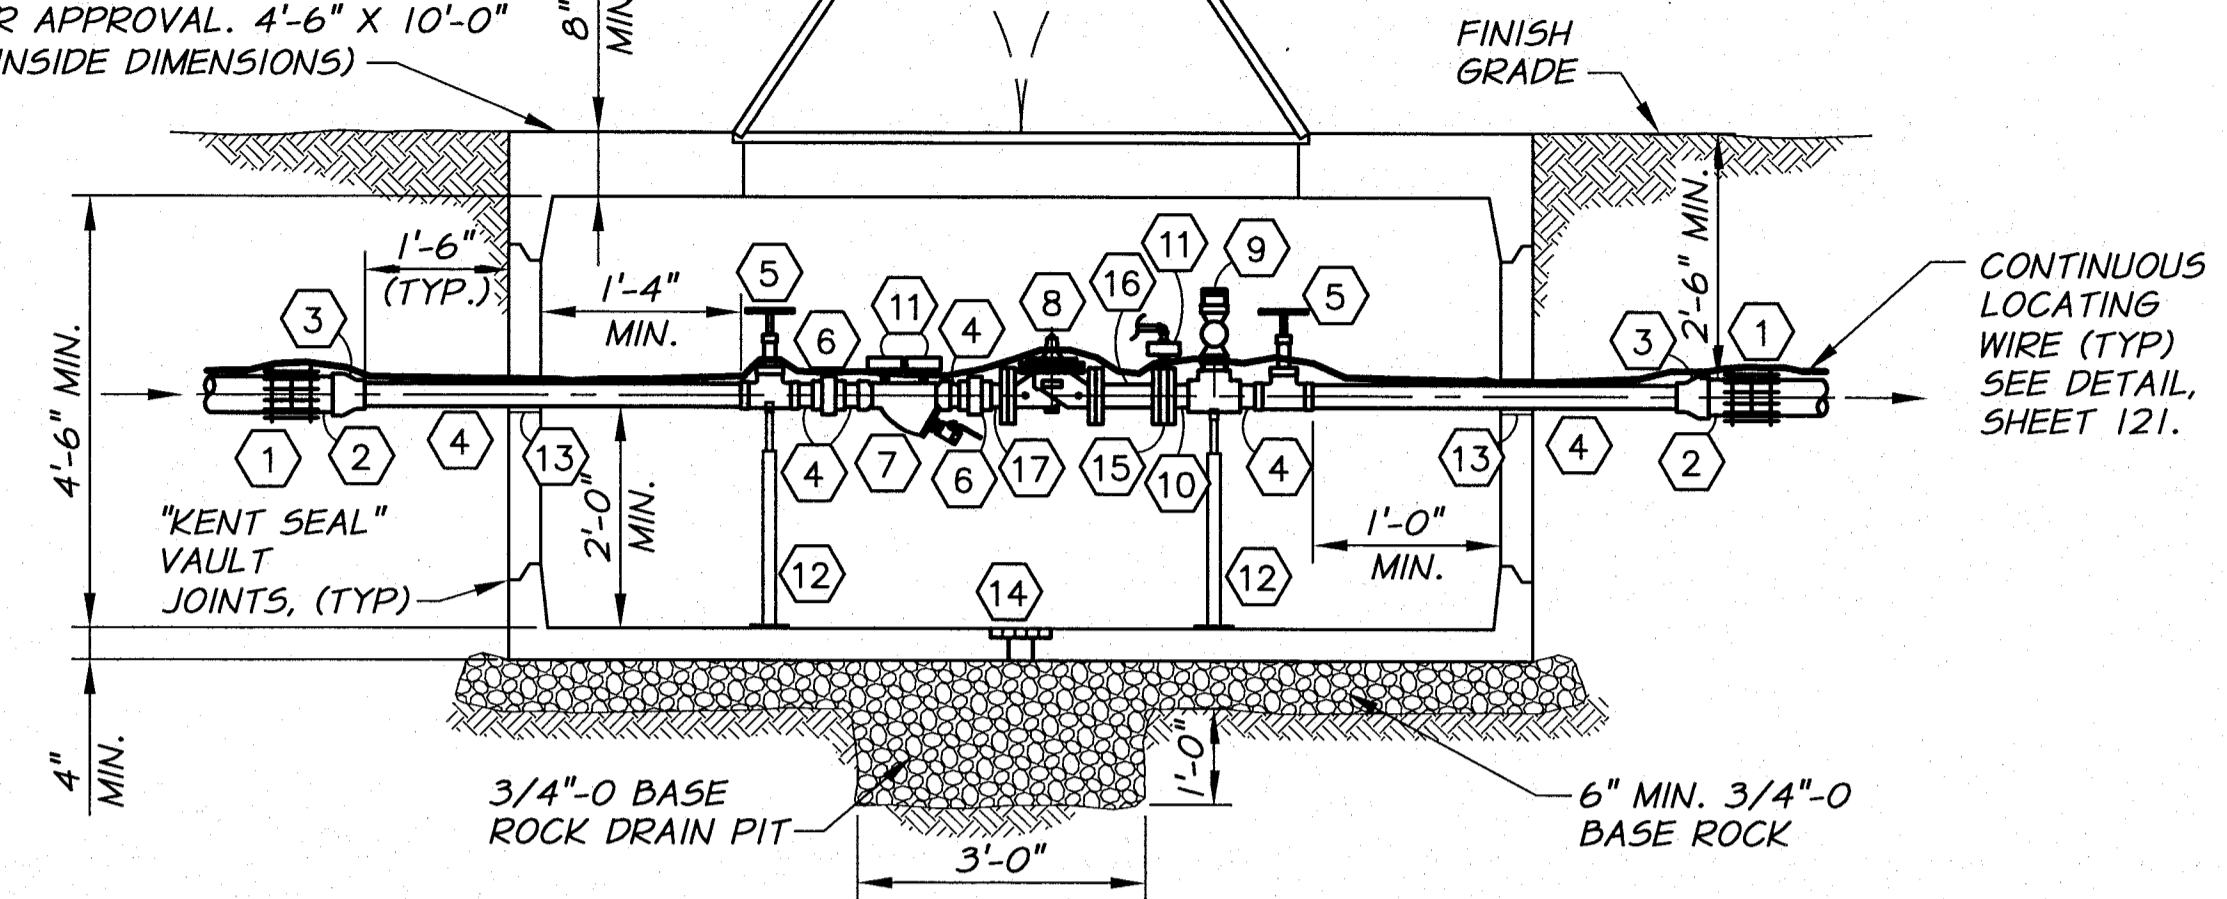


- NOTES:**
1. PIPING SIZE TO MATCH CONTROL VALVE SIZE UNLESS OTHERWISE NOTED
 2. SET FRAME AND COVER TO GRADE AND PROVIDE GRADE RINGS AS REQUIRED.
 3. PIPE SUPPORTS TO BE SIZED APPROPRIATELY FOR PIPE AND INSTALLED PER MANUFACTURER'S RECOMMENDATIONS.
 4. ALL WORK SHOWN IN THIS DETAIL, INCLUDING ANY REQUIRED SURFACE RESTORATION, SHALL BE INCLUDED IN THE PAY ITEM.

FITTING SCHEDULE

- | | |
|---|---|
| ① TRANSITION COUPLING | ⑪ 4" 55 GLYCERIN FILLED PRESSURE GAUGE AND ISOLATION VALVE WITH FITTINGS AS REQUIRED ON ORIFICE PILOT PIPING. ORIENT GAUGE SO THAT FACE IS CLEARLY VISIBLE FROM VAULT ACCESS OPENING. |
| ② GIP, SIZE AS SHOWN ON PLANS | ⑫ PIPE SUPPORT. SEE DETAIL, SHEET 122. |
| ③ THREADED GIP REDUCER WHERE REQUIRED | ⑬ SEAL PIPE PENETRATIONS WATERTIGHT WITH NON-SHRINK GROUT |
| ④ THREADED GIP | ⑭ BRASS GRATED DRAIN WITH KNOCKOUT HOLE FOR DRAIN PIPE. DO NOT PROVIDE DRAIN IN HIGH GROUND WATER AREA. |
| ⑤ BRASS THREADED GATE VALVE | ⑮ ORIFICE PLATE |
| ⑥ GIP UNION AND BUSHINGS AS REQUIRED | ⑯ FLG X RAISED FACE FLG GIP SPOOL X 8" LG. |
| ⑦ SONNTAG ALUMINUM Y FILTER WITH 3/32 SCREEN, FITTINGS AS REQUIRED | ⑰ FLG X THREADED GIP SPOOL |
| ⑧ FLANGED PRESSURE REDUCING/FLOW CONTROL VALVE, CLA-VAL MODEL 49G-01AB. | |
| ⑨ THREADED GIP TEE WITH BALL VALVE, GIP, AND CAM-LOCK ADAPTER AND CAP | |
| ⑩ RAISED FACE FLANGE X THREADED GIP SPOOL | |


1 1/2" AND 2" TYPE A PRV/FCV AND FCV VAULT DETAIL
N.T.S.

△ SHEET ADDED

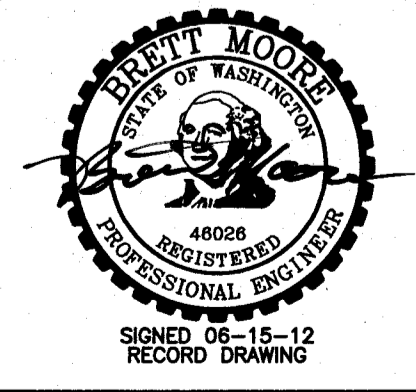

RECORD DRAWING		BY	DATE	HORIZ. SCALE	NONE	VERT. SCALE	
DESIGNED BY	R. HARRIS		12/11	JOB NUMBER	1199-336	DATE	2009
DRAWN BY	D. CHRISTMAN	XREFS: TB-BID.dwg		ACAD FILE	lrrgDets-l.dwg		
REVIEWED BY	H. PERRY	COPYRIGHT 2009 BY ANDERSON-PERRY & ASSOC., INC.					

RECORD DRAWINGS
These record drawings have been prepared, in part, on the basis of information compiled and furnished by others. They may contain some discrepancies and omissions, and do not necessarily represent "exact" field conditions. The Owner and the Engineer accept no responsibility for their accuracy.

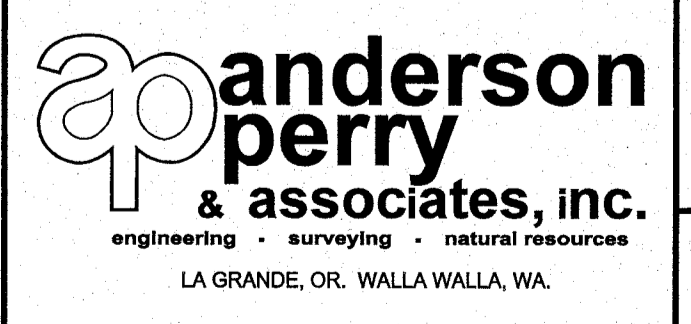


BENTON IRRIGATION DISTRICT
IRRIGATION SYSTEM IMPROVEMENTS
PHASE I
PRV/FCV VAULT DETAIL

SHEET
119C


ARCHIVED

FITTING SCHEDULE

- (51) PVC MAIN PIPING
- (52) COUPLING ADAPTER
- (53) GIP, SIZE OF MAIN
- (54) BRASS THREADED GATE VALVE
- (55) GIP UNION
- (56) DOLE FLOW CONTROL VALVE, SIZE SPECIFIED ON DRAWINGS
- (57) 54" PRECAST MANHOLE WITH H2O TRAFFIC RATED FLAT TOP AND 24" MANHOLE COVER WITH FRAME CAST INTO SLAB
- (58) SEAL PIPE PENETRATIONS WATERTIGHT WITH NON-SHRINK GROUT

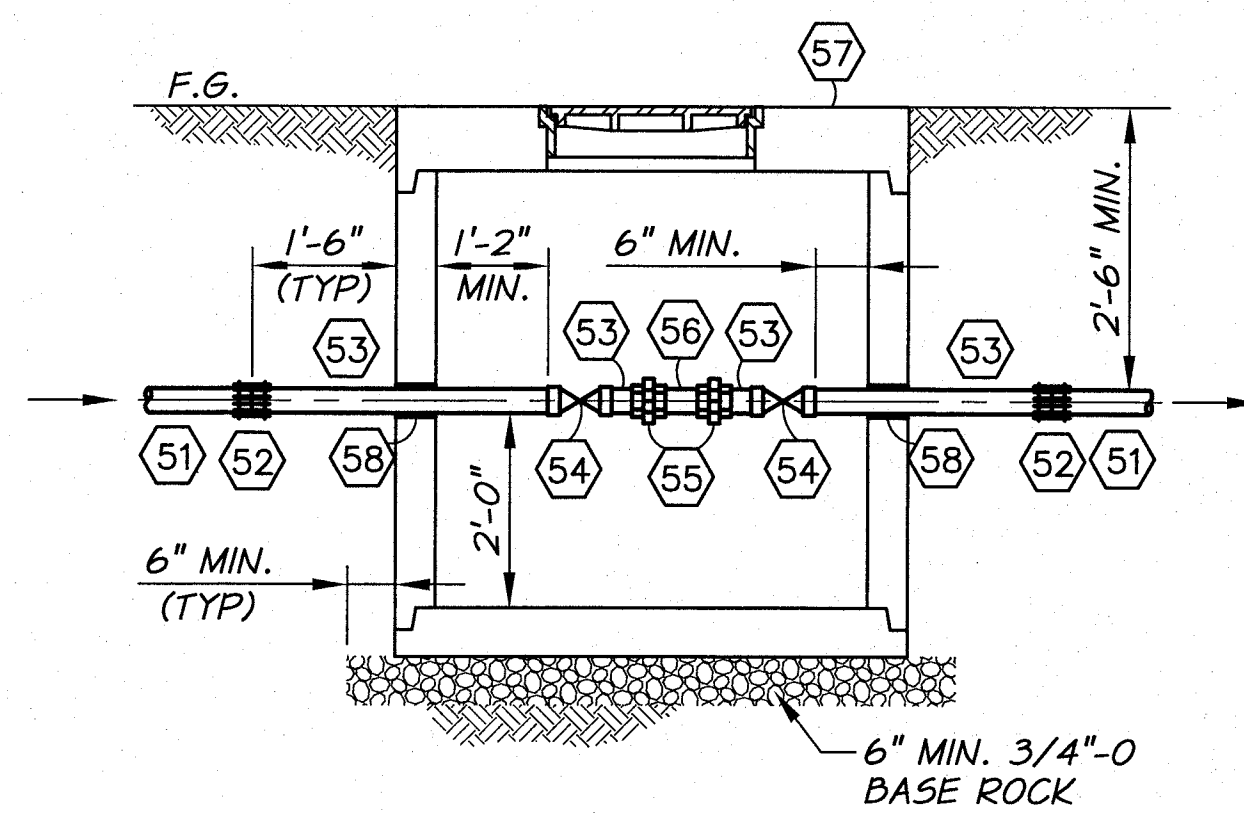

SECTION B

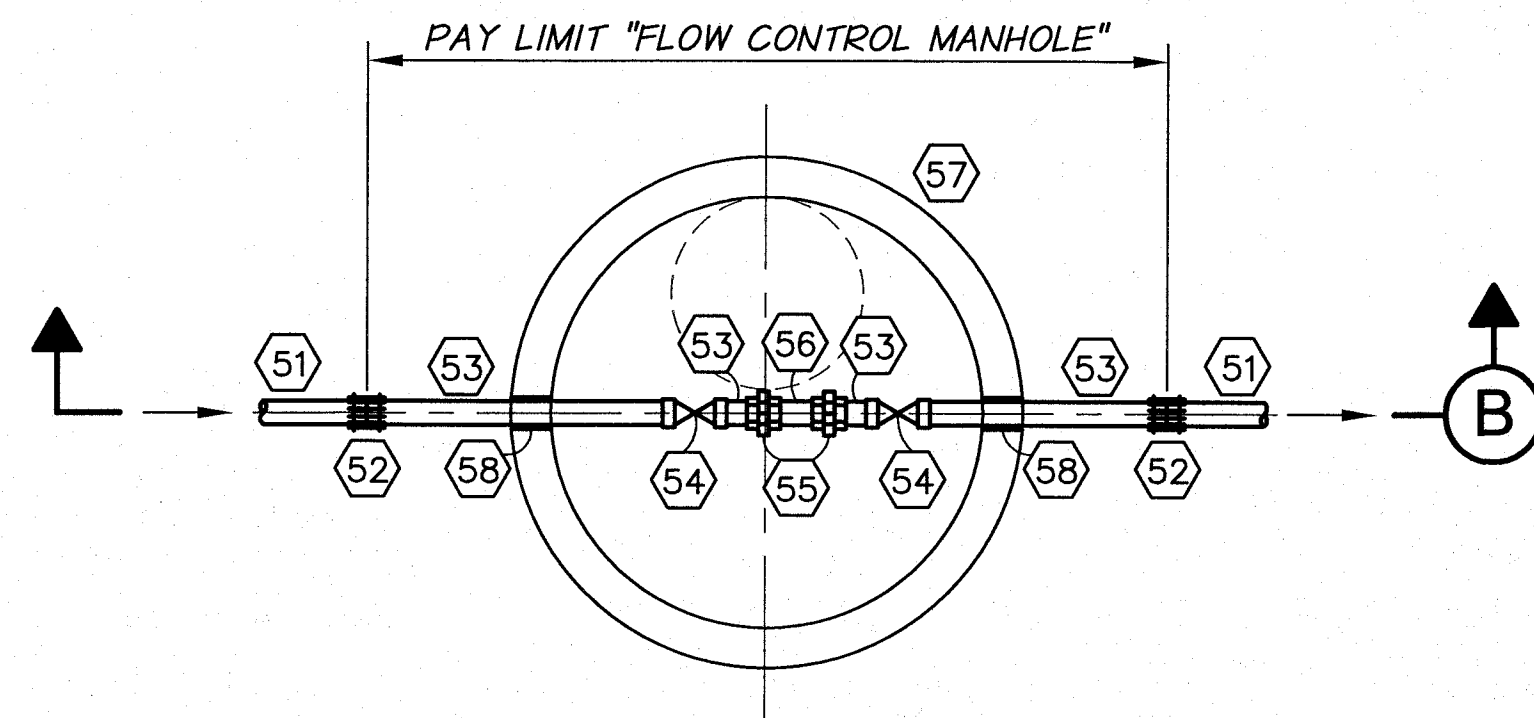


PLAN

FLOW CONTROL MANHOLE DETAIL
N.T.S.


DETAIL ELIMINATED

TYPICAL 4" AND LARGER SERVICE DETAIL

N.T.S.

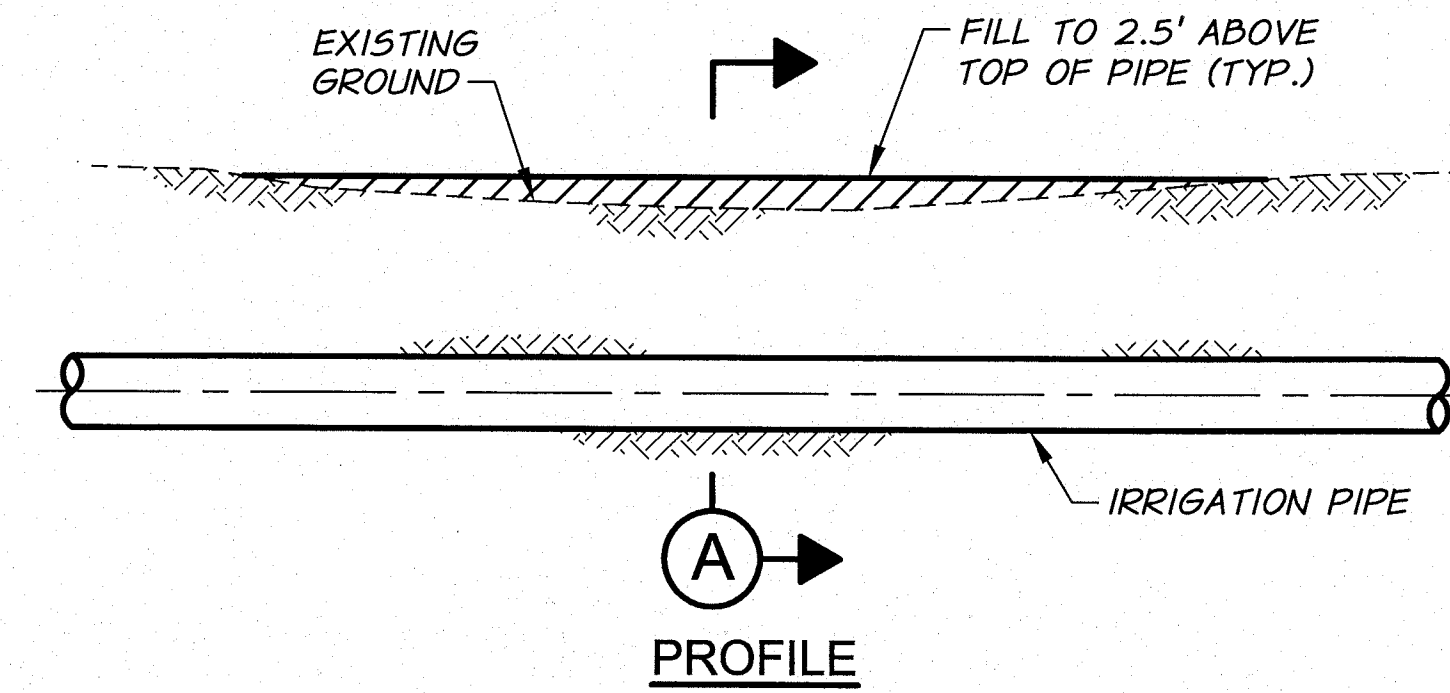


PROFILE

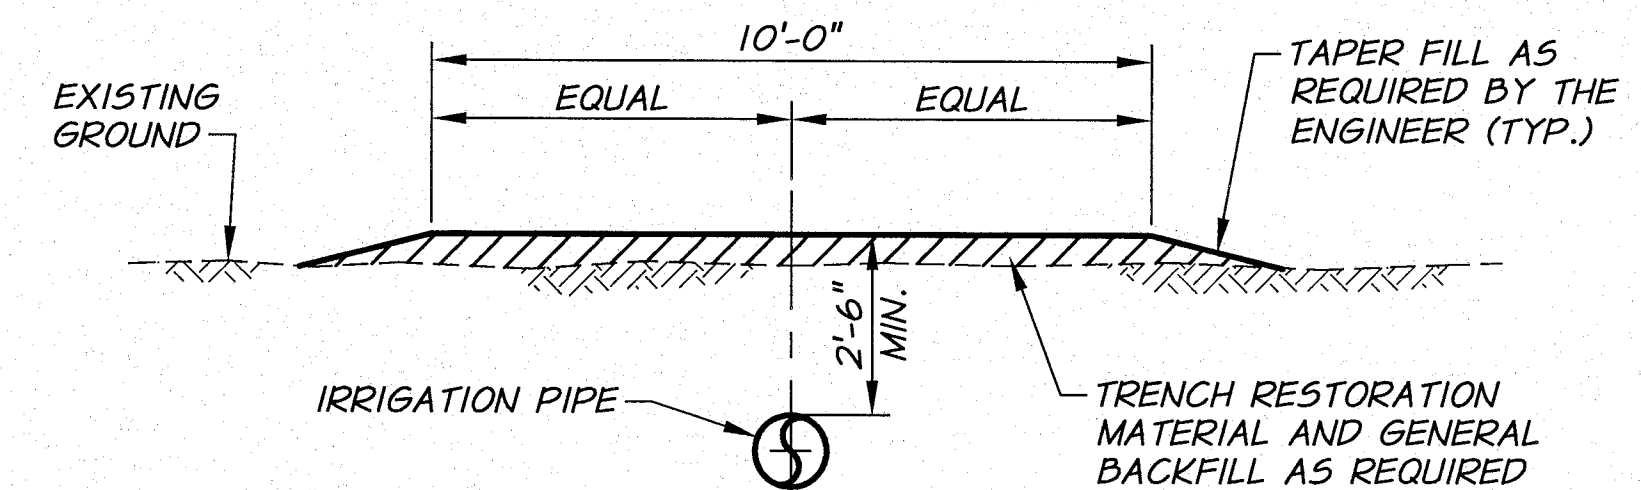

SECTION A

TYPICAL PIPELINE LOW AREA BACKFILL DETAIL

N.T.S.

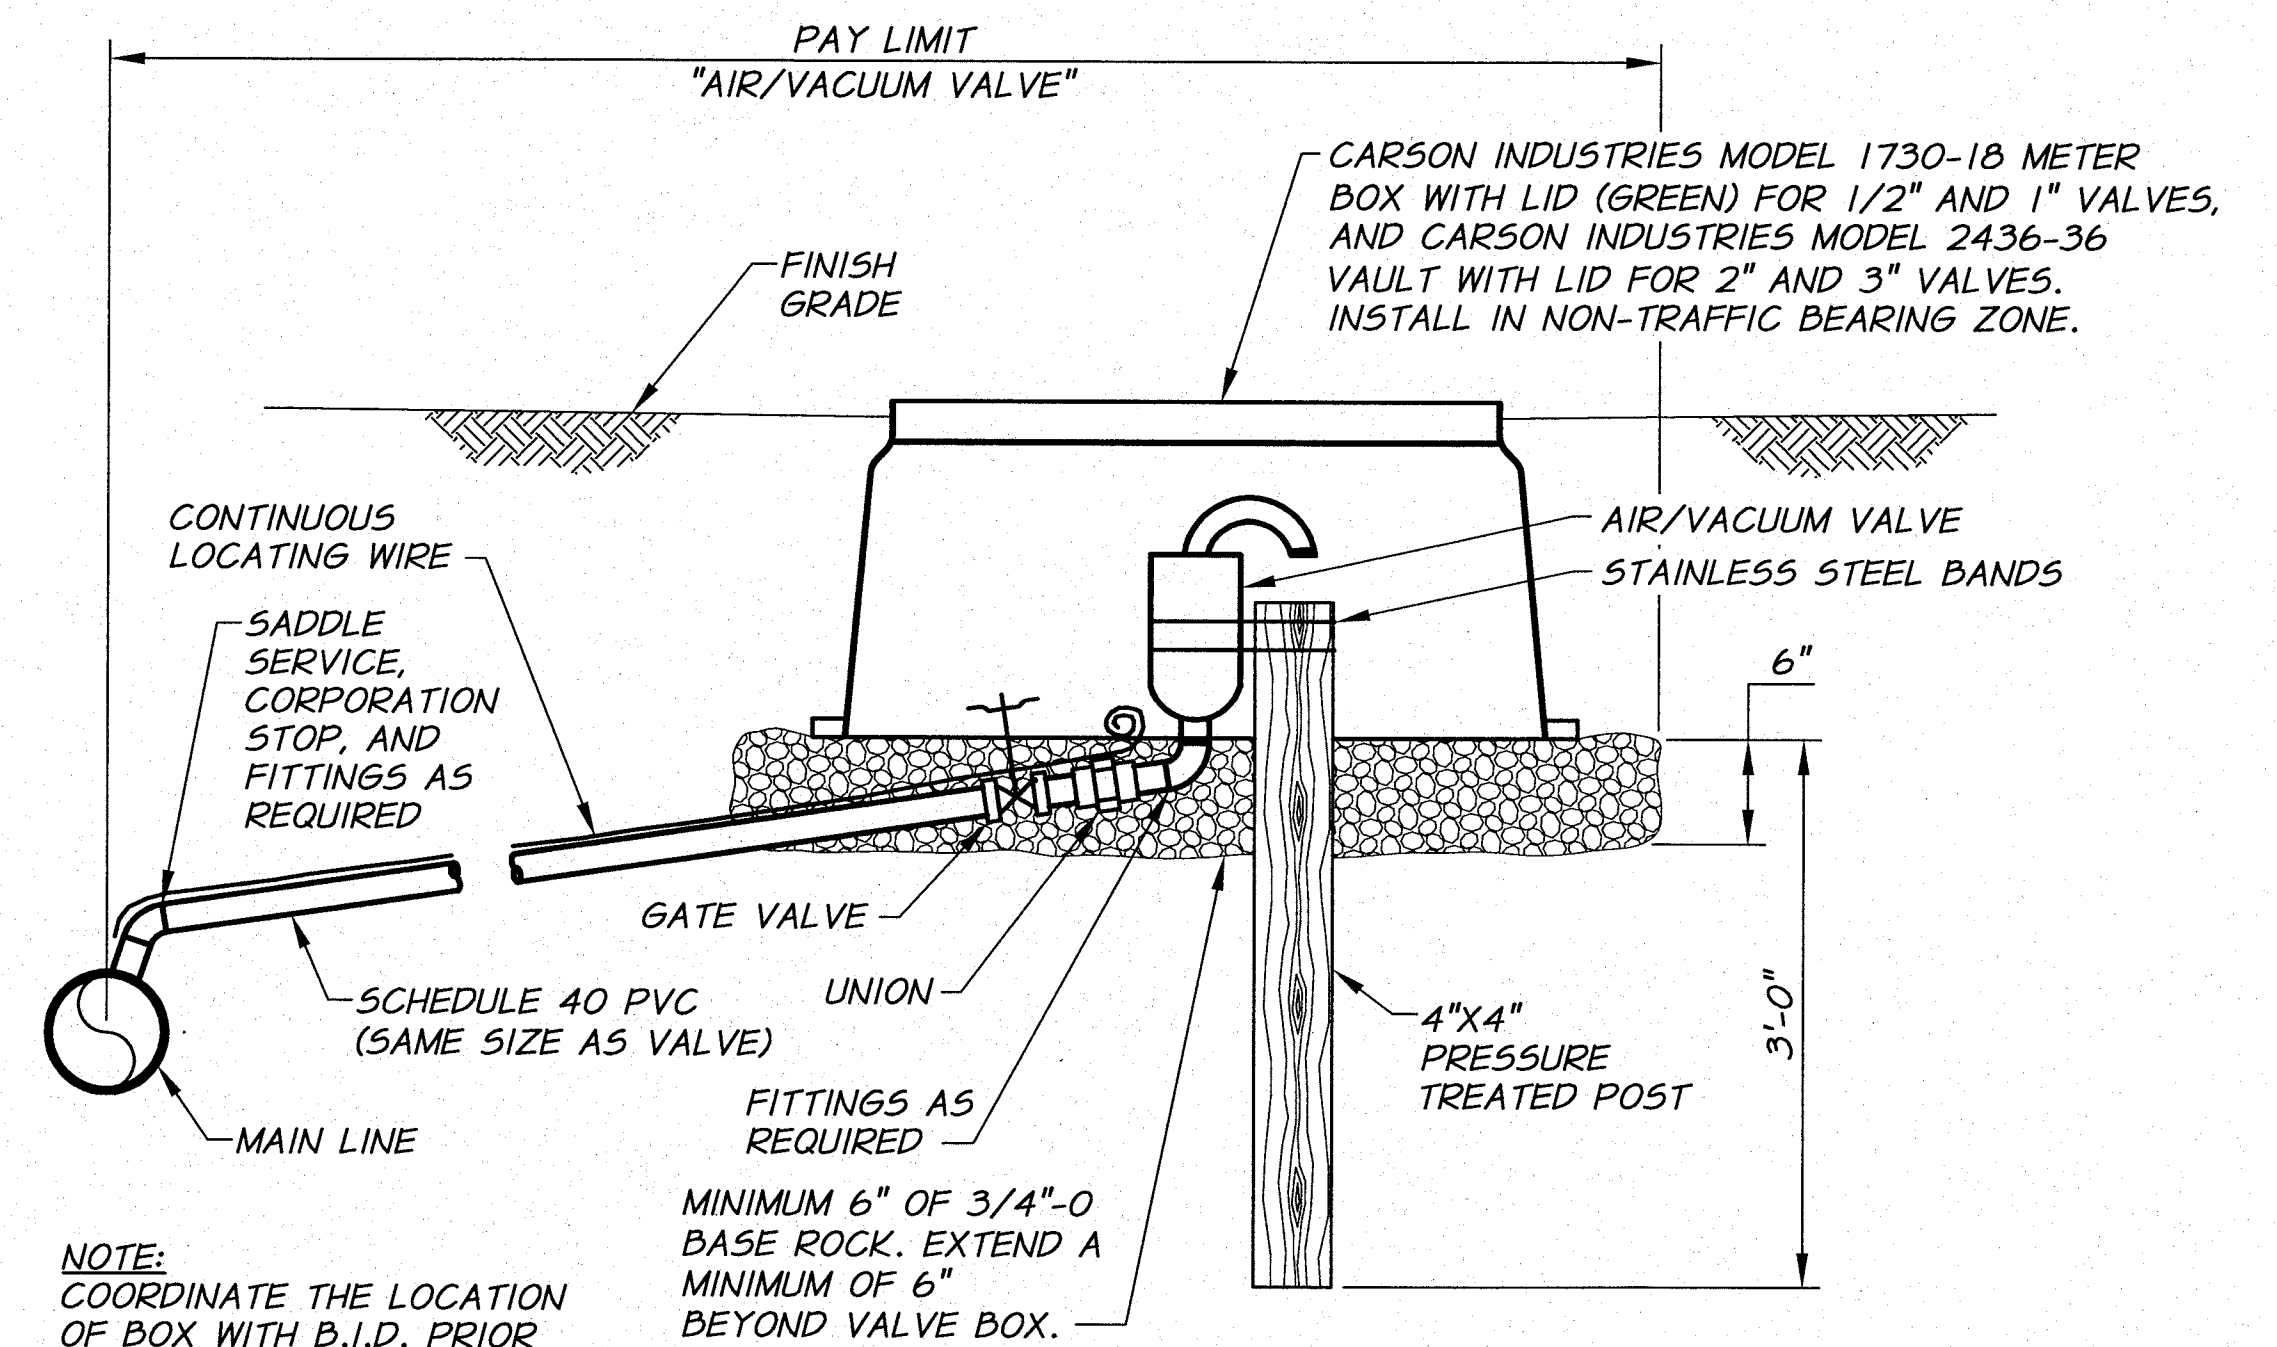

AIR / VACUUM VALVE


N.T.S.



RECORD DRAWING		BY	E.H.	DATE	12/11	HORZ. SCALE	NONE	VERT. SCALE	
DESIGNED BY	R. HARRIS	XREFS:		TB-BID.dwg		JOB NUMBER	1199-336	DATE	2009
DRAWN BY	D. CHRISTMAN	ACAD FILE:		IrrgDets-I.dwg					
REVIEWED BY	H. PERRY	COPYRIGHT 2009 BY ANDERSON-PERRY & ASSOC., INC.							

RECORD DRAWINGS

These record drawings have been prepared, in part, on the basis of information compiled and furnished by others. They may contain some discrepancies and omissions, and do not necessarily represent "exact" field conditions. The Owner and the Engineer accept no responsibility for their accuracy.

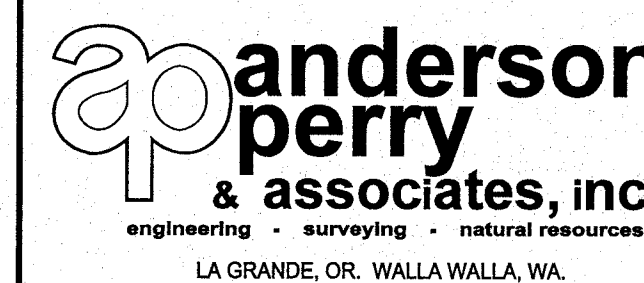


BENTON IRRIGATION DISTRICT
IRRIGATION SYSTEM IMPROVEMENTS
PHASE I

MISCELLANEOUS DETAILS I

SHEET


120

ARCHIVED

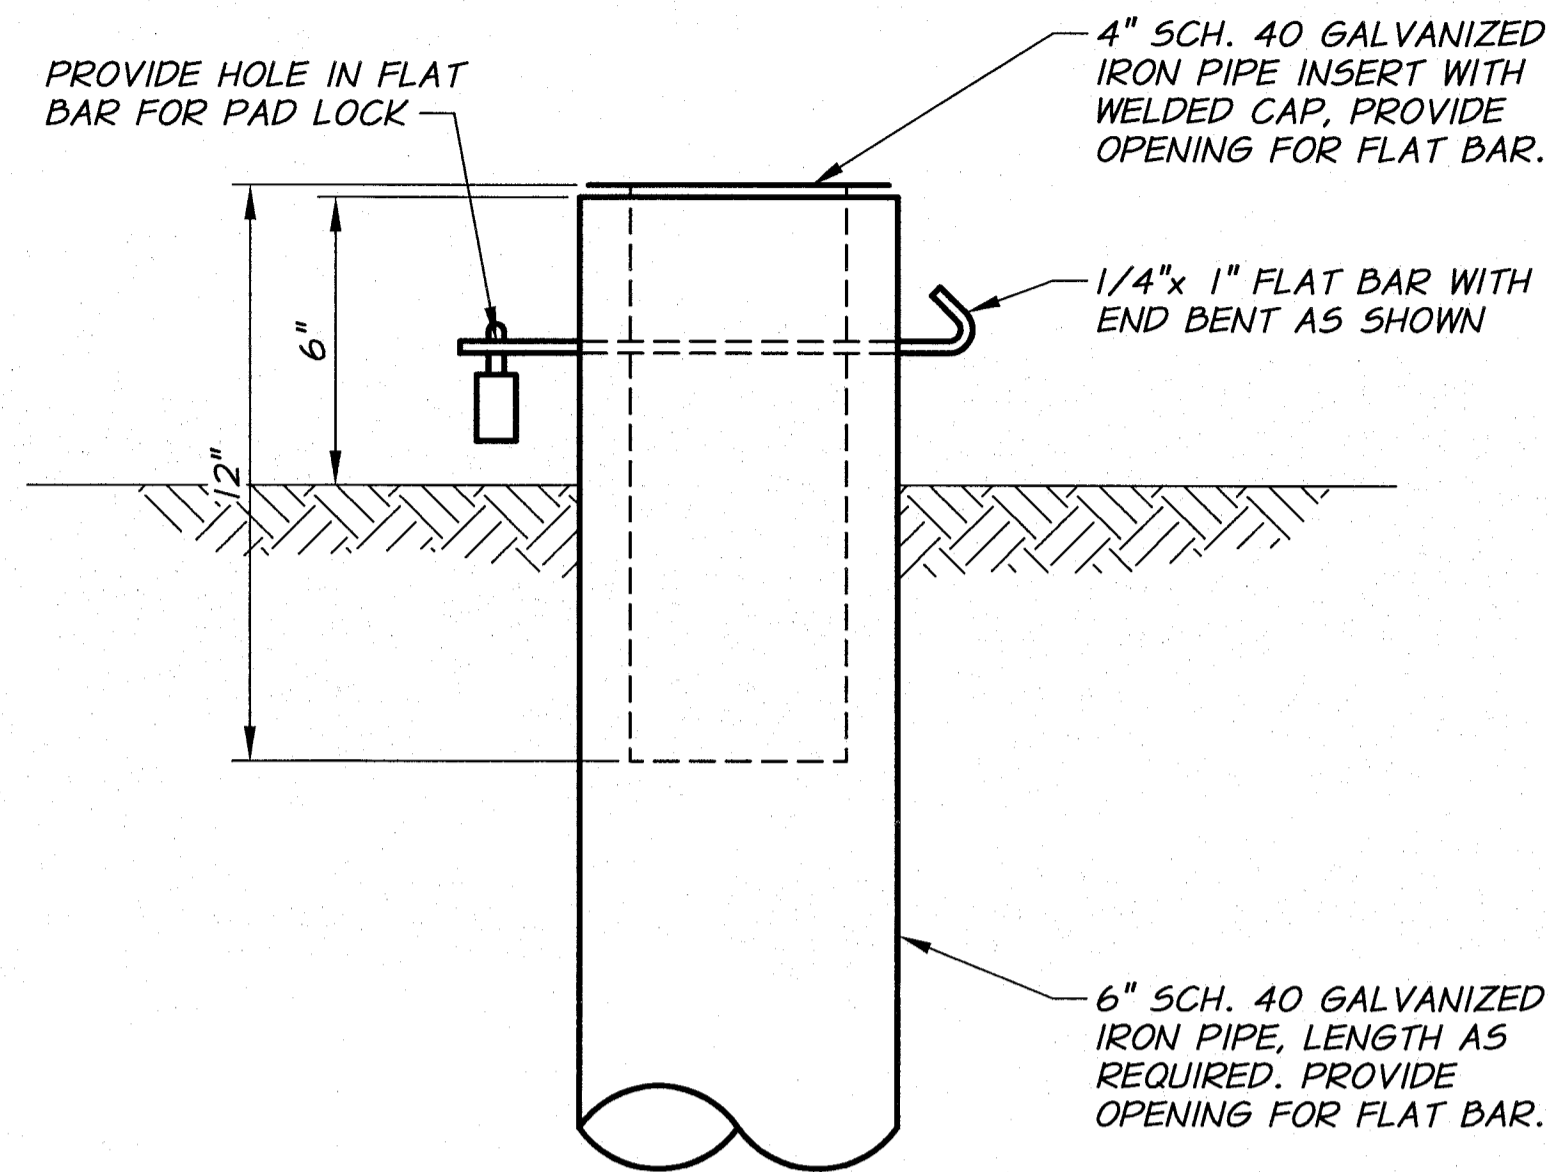

LOCKABLE VALVE BOX DETAIL

N.T.S.

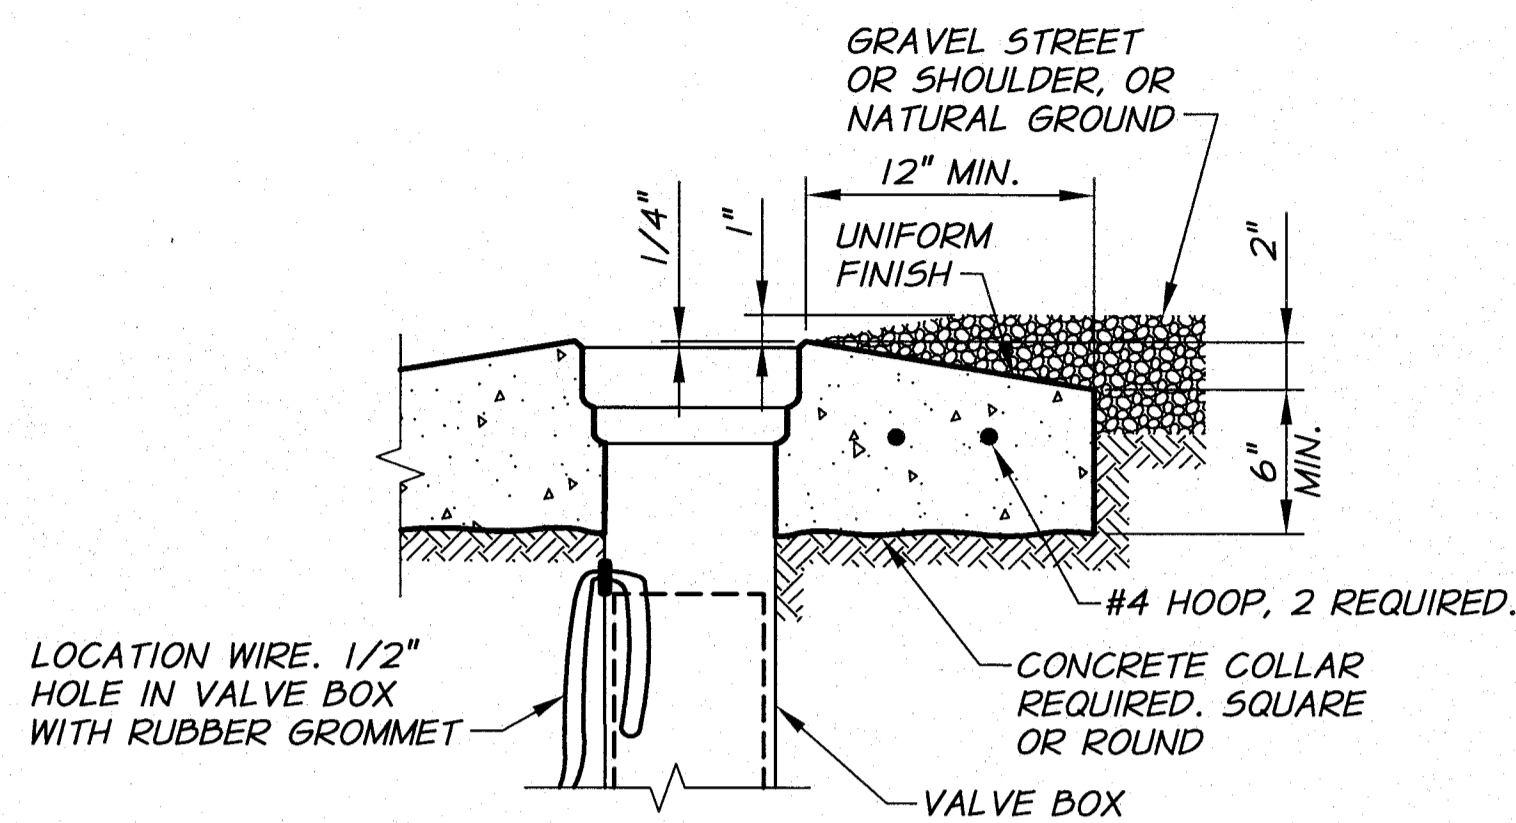


- REQUIREMENTS FOR CONCRETE COLLARS:**
1. CONCRETE : 3/4", 7 SACK, 4000 PSI AT 28 DAYS, 2" TO 4" SLUMP, 4-7% AIR.
 2. COLLAR TO BE FORMED AND UNIFORMLY ROUND.
 3. SMOOTH BROOMED FINISH REQUIRED.
 4. APPLY CONCRETE CURING COMPOUND.
 5. PROTECT FROM TRAFFIC FOR 4 DAYS MIN.

**CONCRETE COLLAR DETAIL
IN GRAVEL STREETS OR NATURAL GROUND**

N.T.S.

NOTE:
CONCRETE COLLAR REQUIRED IF VALVE BOX GRADE IS ADJUSTED AFTER ASPHALT PAVEMENT WORK IS PERFORMED. IF GRADE ADJUSTMENT OCCURS PRIOR TO ASPHALT PAVEMENT WORK THEN CONCRETE COLLAR IS NOT REQUIRED.

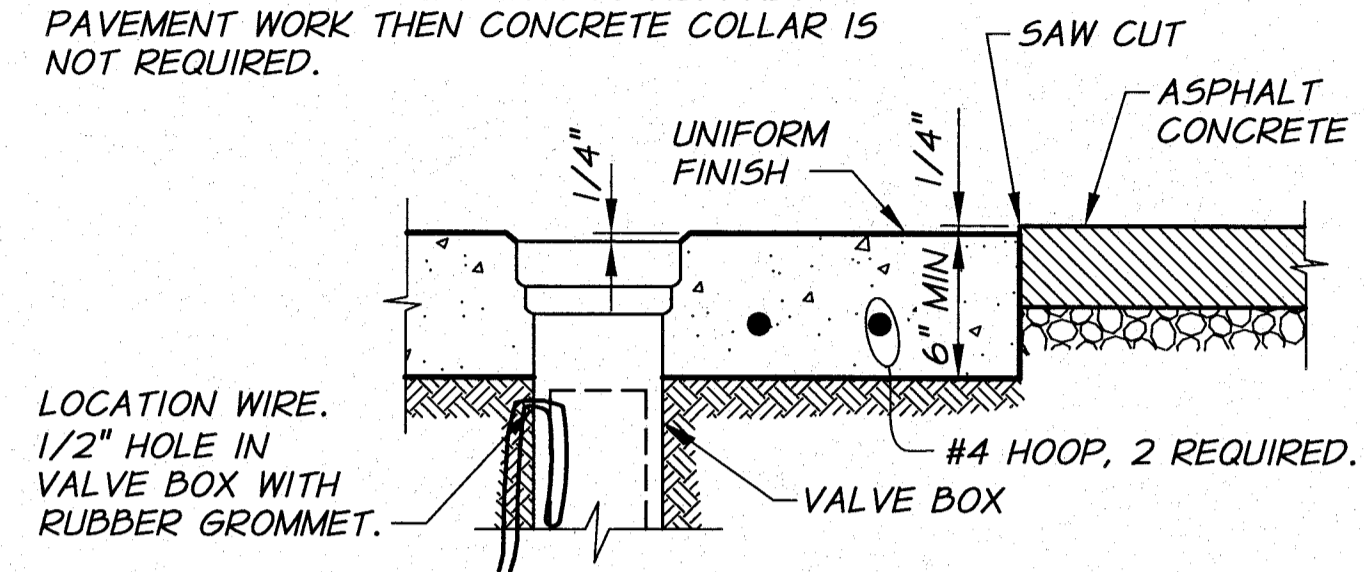


TYPICAL SECTION

- REQUIREMENTS FOR CONCRETE COLLARS:**
1. CONCRETE: 3/4", 7 SACK, 4000 PSI AT 28 DAYS, 2" TO 4" SLUMP, 4-7% AIR.
 2. SMOOTH BROOMED FINISH REQUIRED.
 3. APPLY CONCRETE CURING COMPOUND.
 4. PROTECT FROM TRAFFIC FOR 4 DAYS MINIMUM.


VALVE BOX CONCRETE COLLAR DETAIL

IN ASPHALT PAVEMENT

N.T.S.

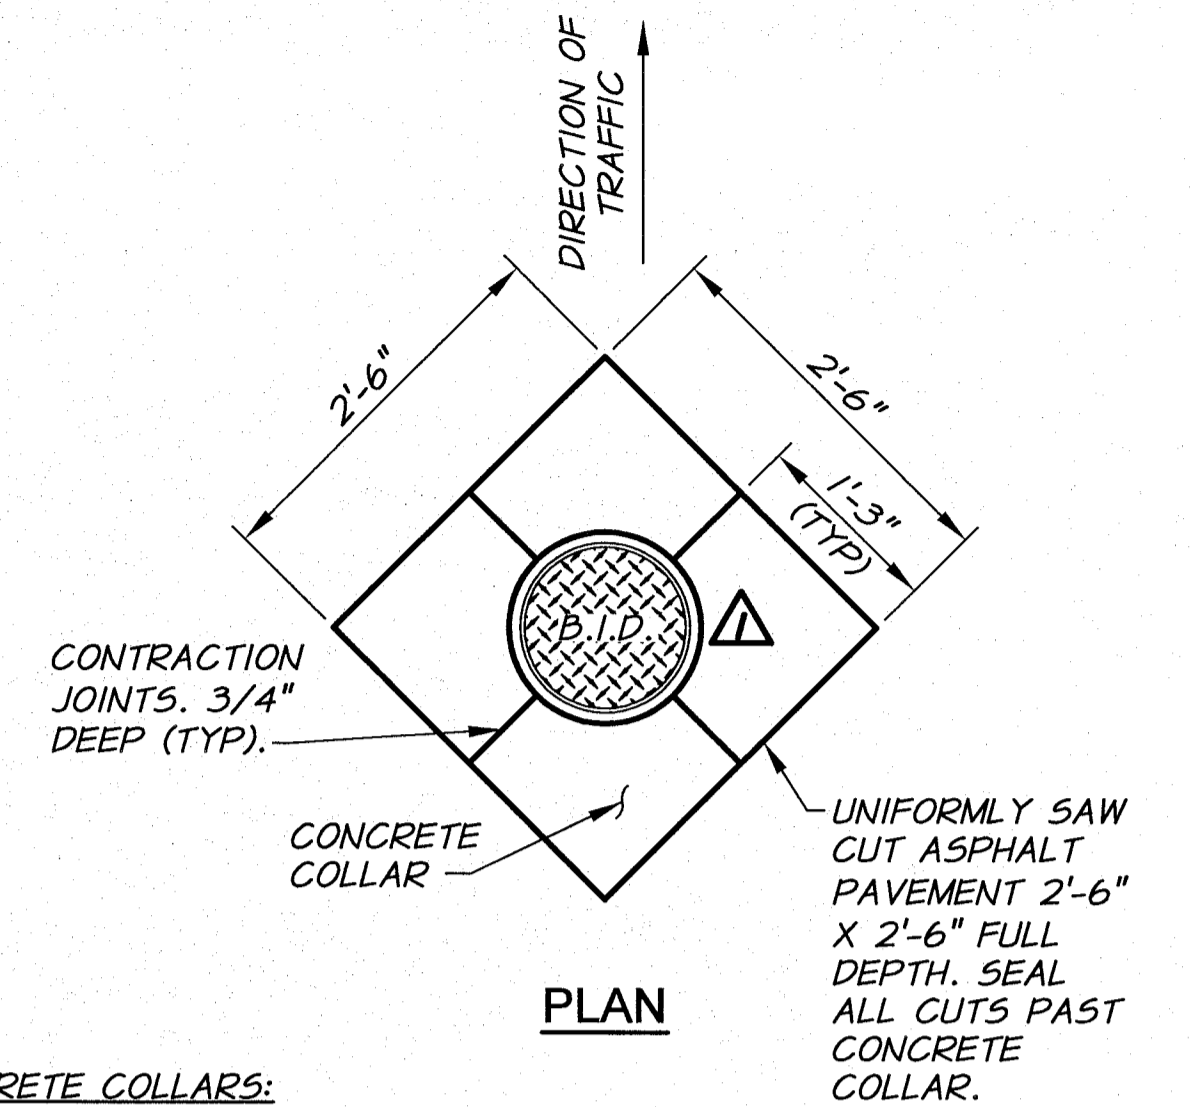


PLAN

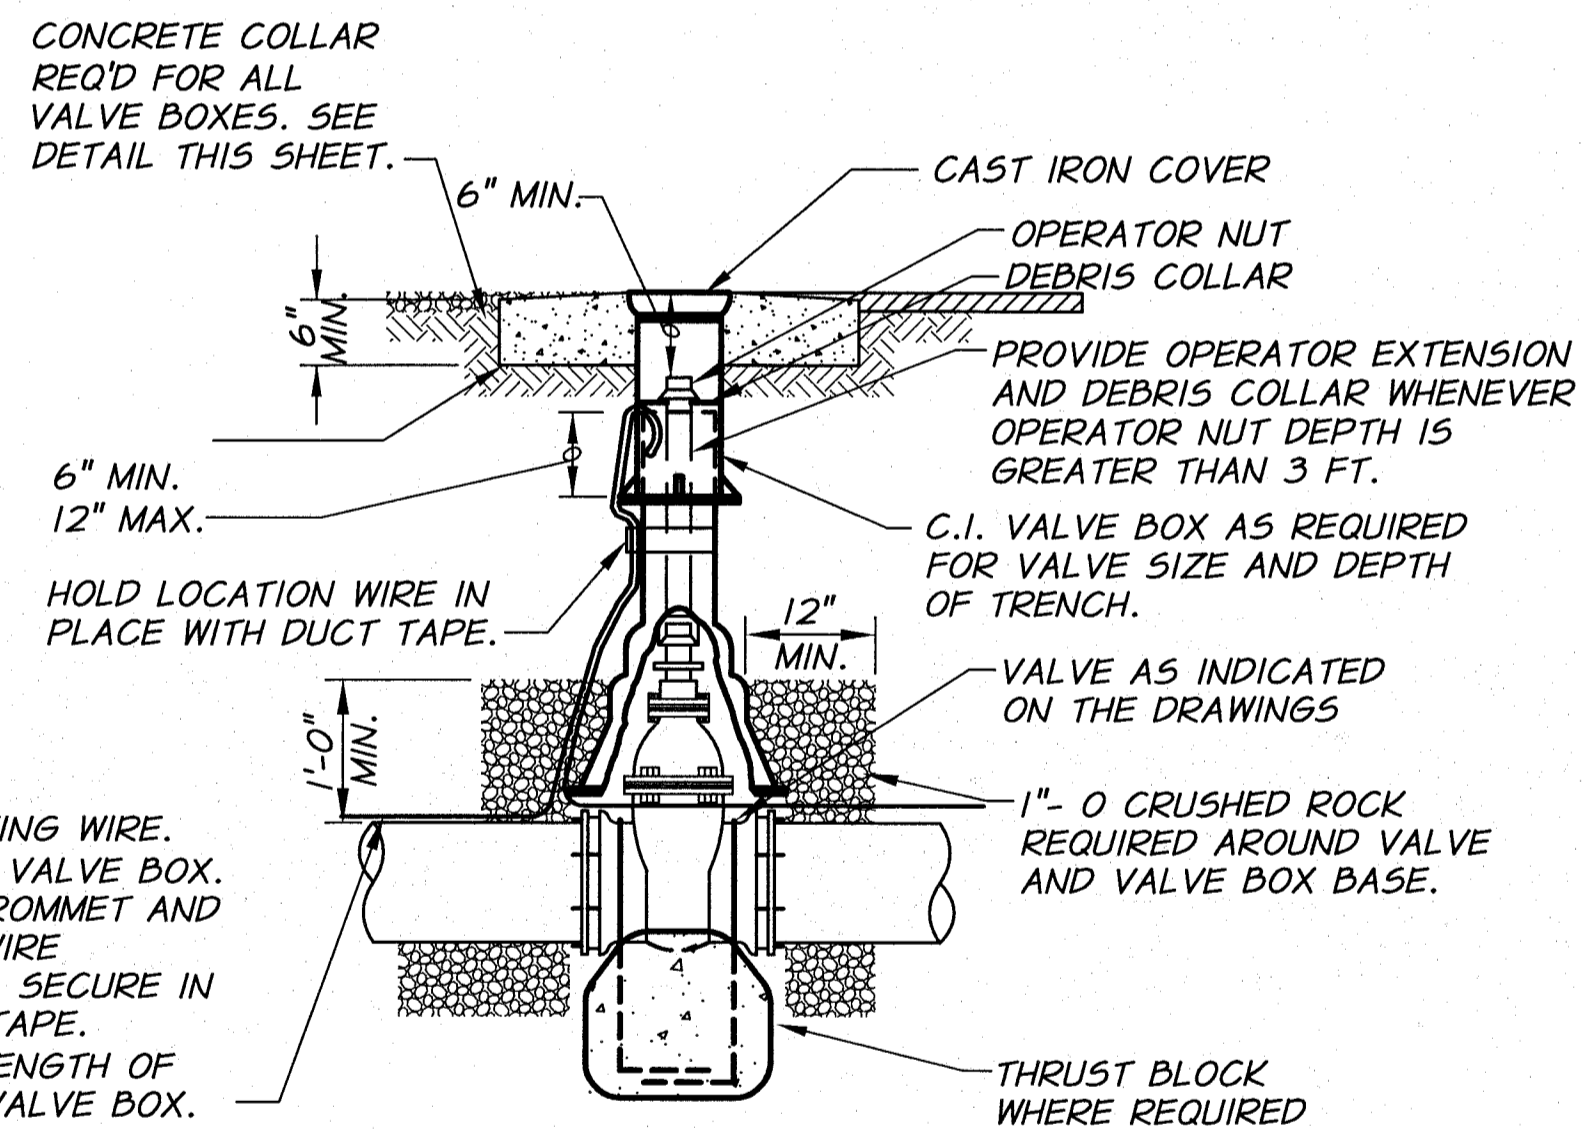


VALVE BOX EXTENSION DETAIL

N.T.S.

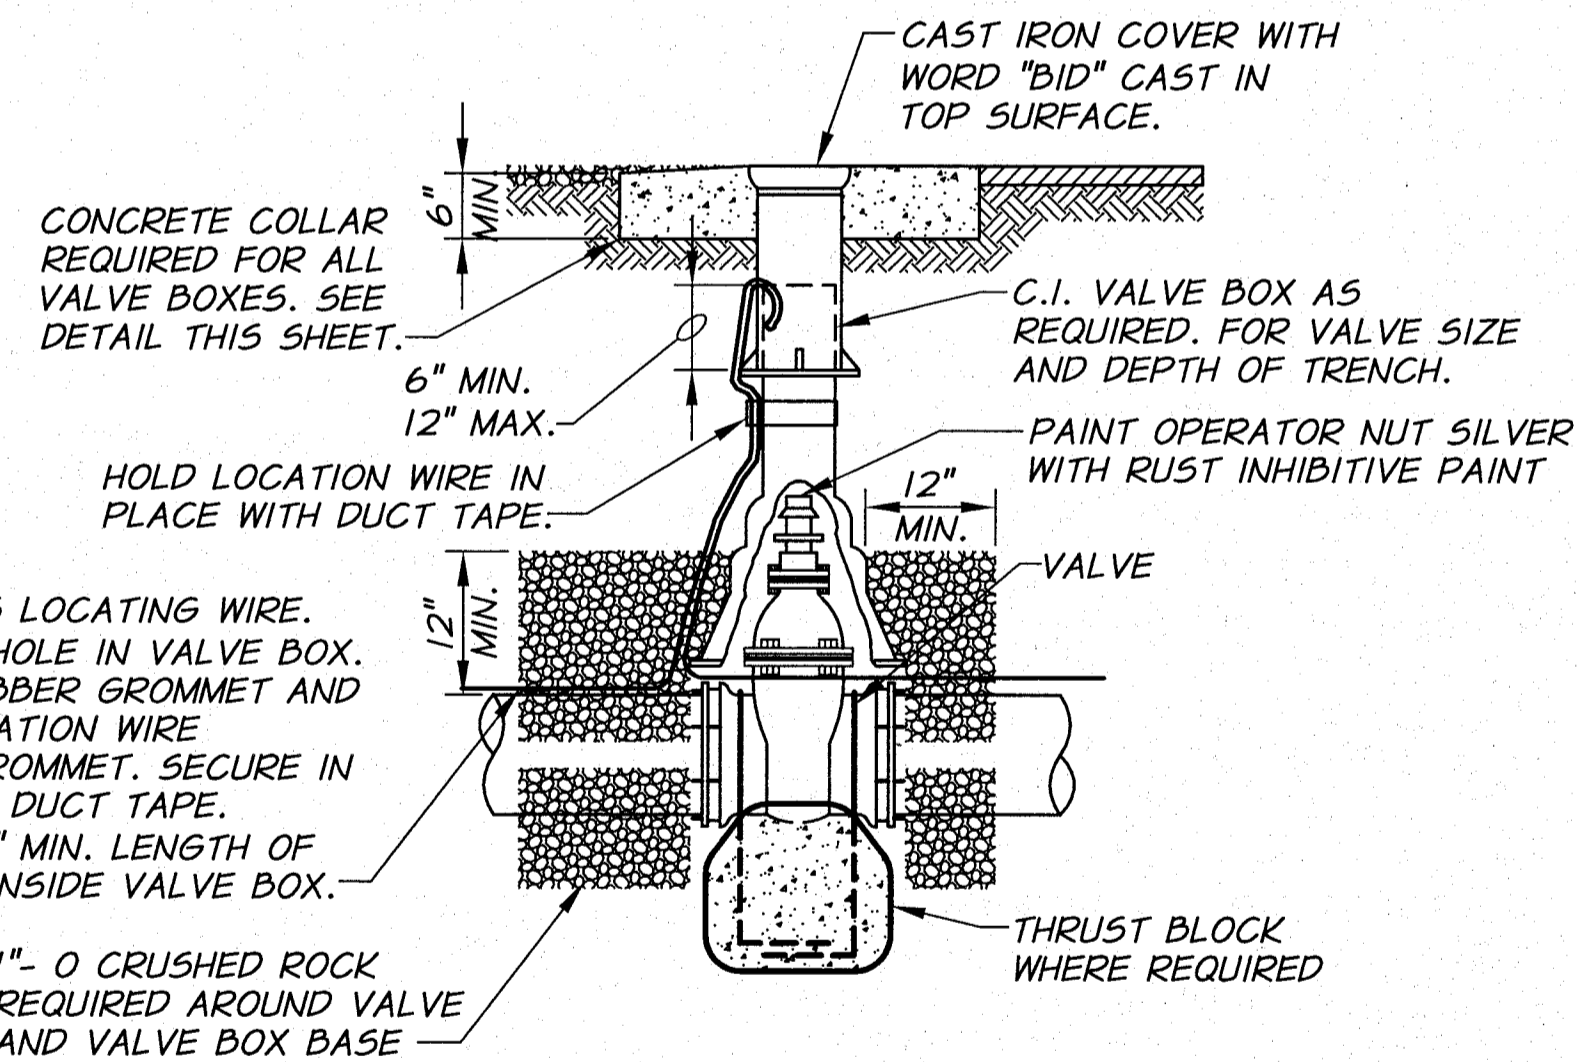

VALVE BOX DETAIL

N.T.S.

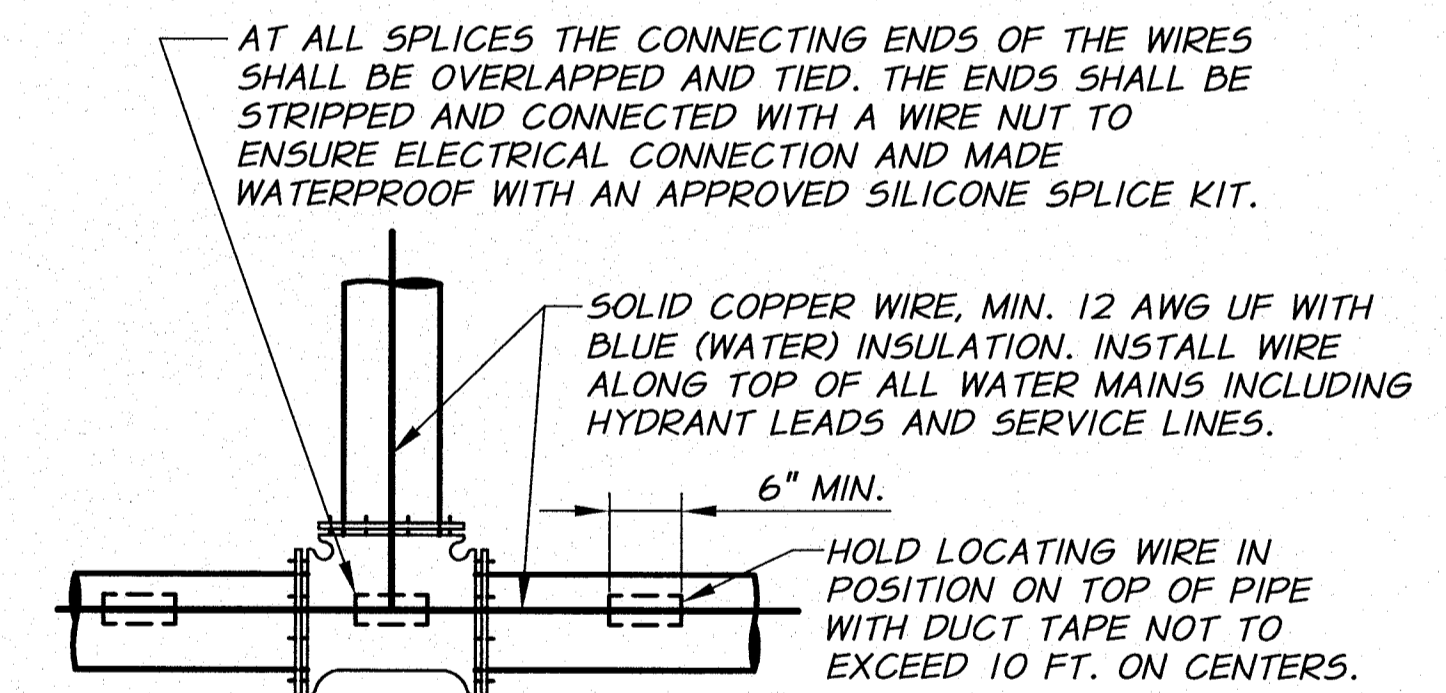

CONTINUOUS LOCATING WIRE DETAIL


N.T.S.



RECORD DRAWING		E.H. 12/11	
DESIGNED BY	R. HARRIS	DATE	2009
DRAWN BY	D. CHRISTMAN	JOB NUMBER	1199-336
REVIEWED BY	H. PERRY	ACAD FILE	IrrgDets-II.dwg
XREFS: TB-BID.dwg			
COPYRIGHT 2009 BY ANDERSON-PERRY & ASSOC., INC.			

RECORD DRAWINGS

These record drawings have been prepared, in part, on the basis of information compiled and furnished by others. They may contain some discrepancies and omissions, and do not necessarily represent "exact" field conditions. The Owner and the Engineer accept no responsibility for their accuracy.


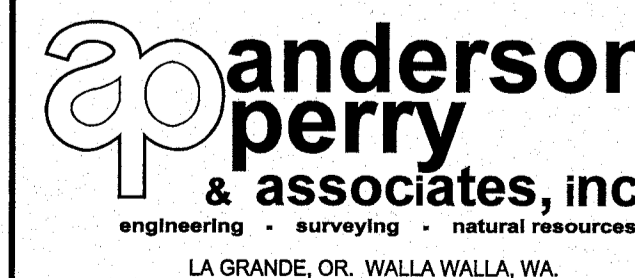


**BENTON IRRIGATION DISTRICT
IRRIGATION SYSTEM IMPROVEMENTS
PHASE I**




MISCELLANEOUS DETAILS II

SHEET

121

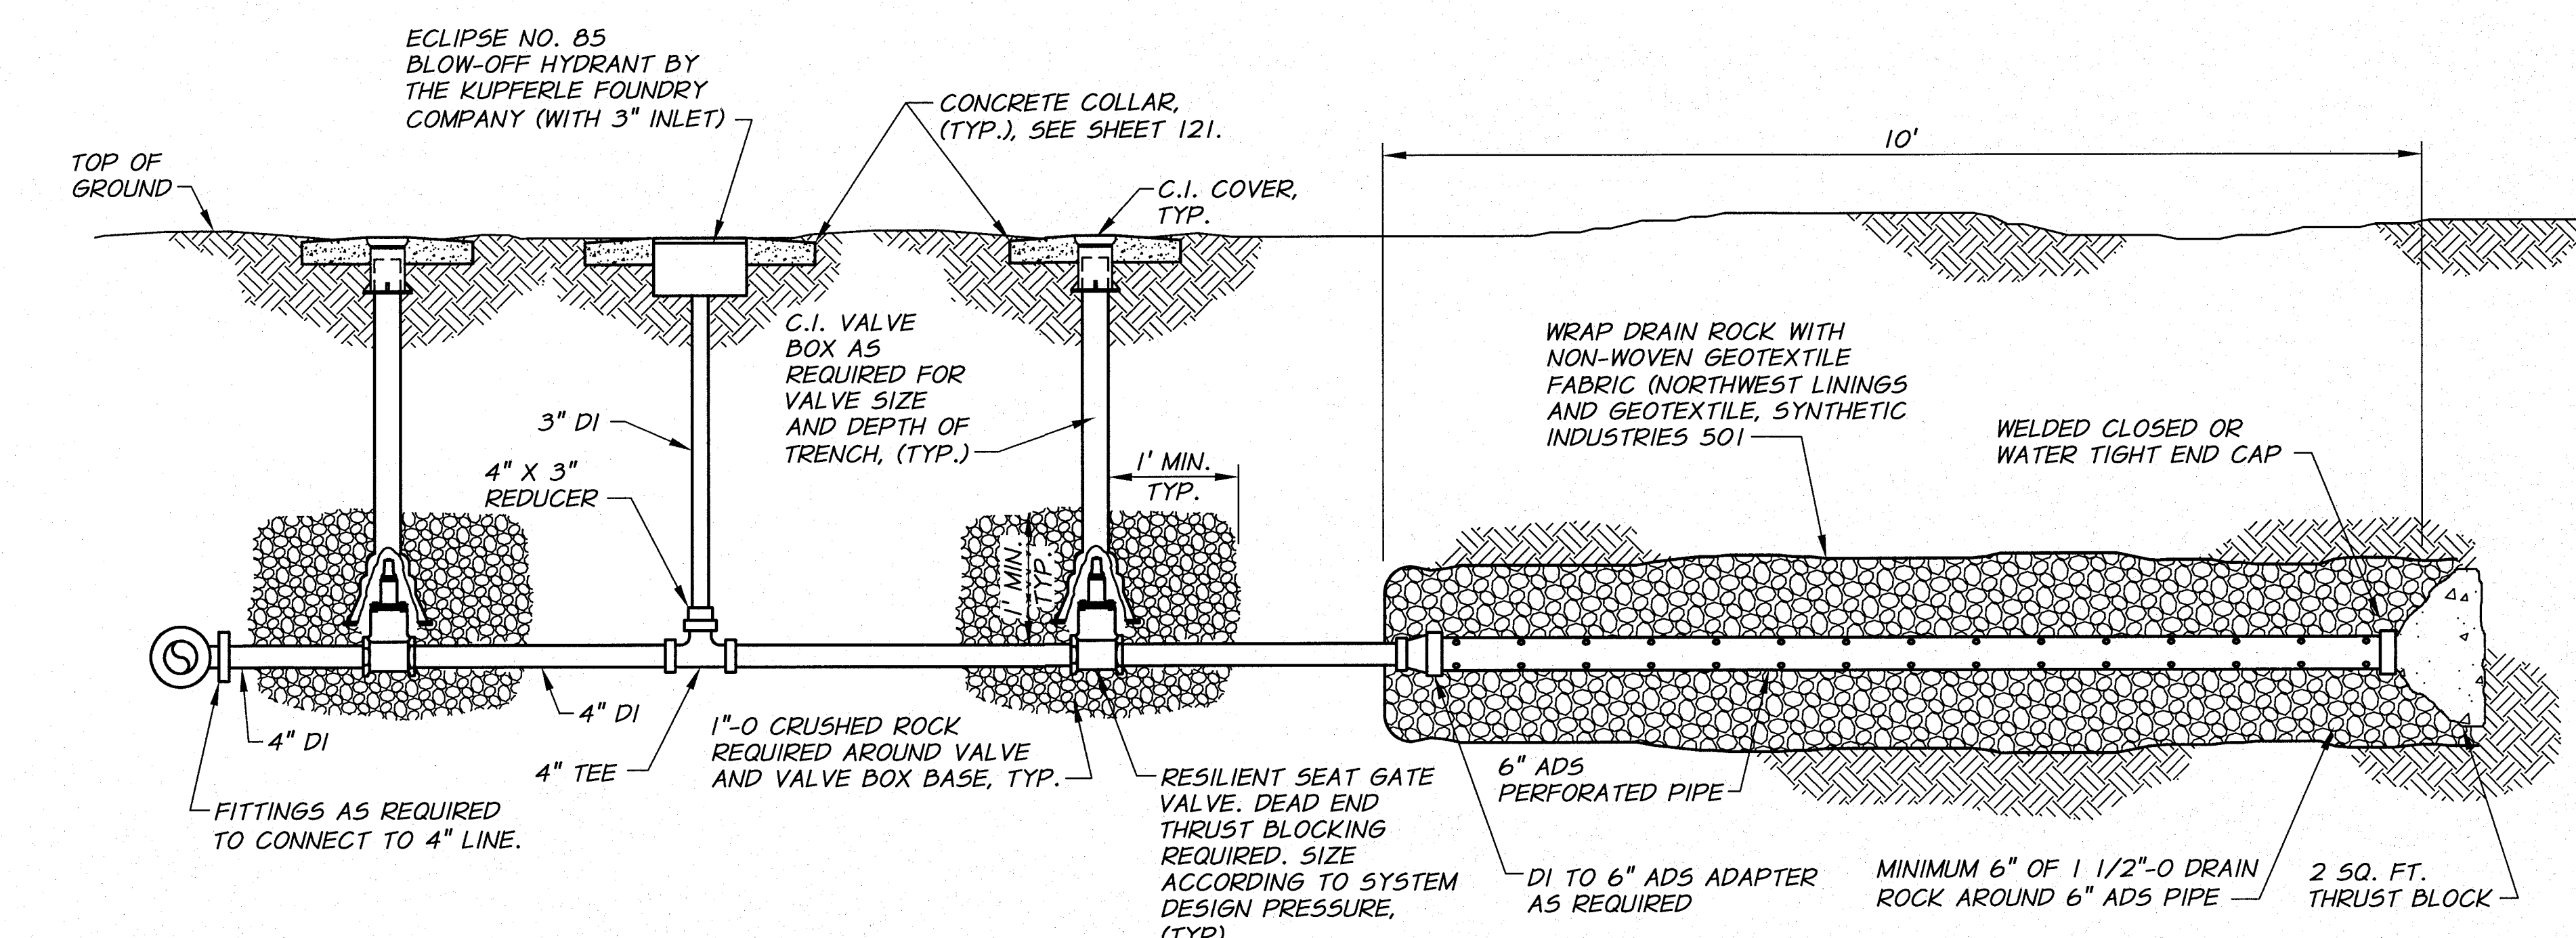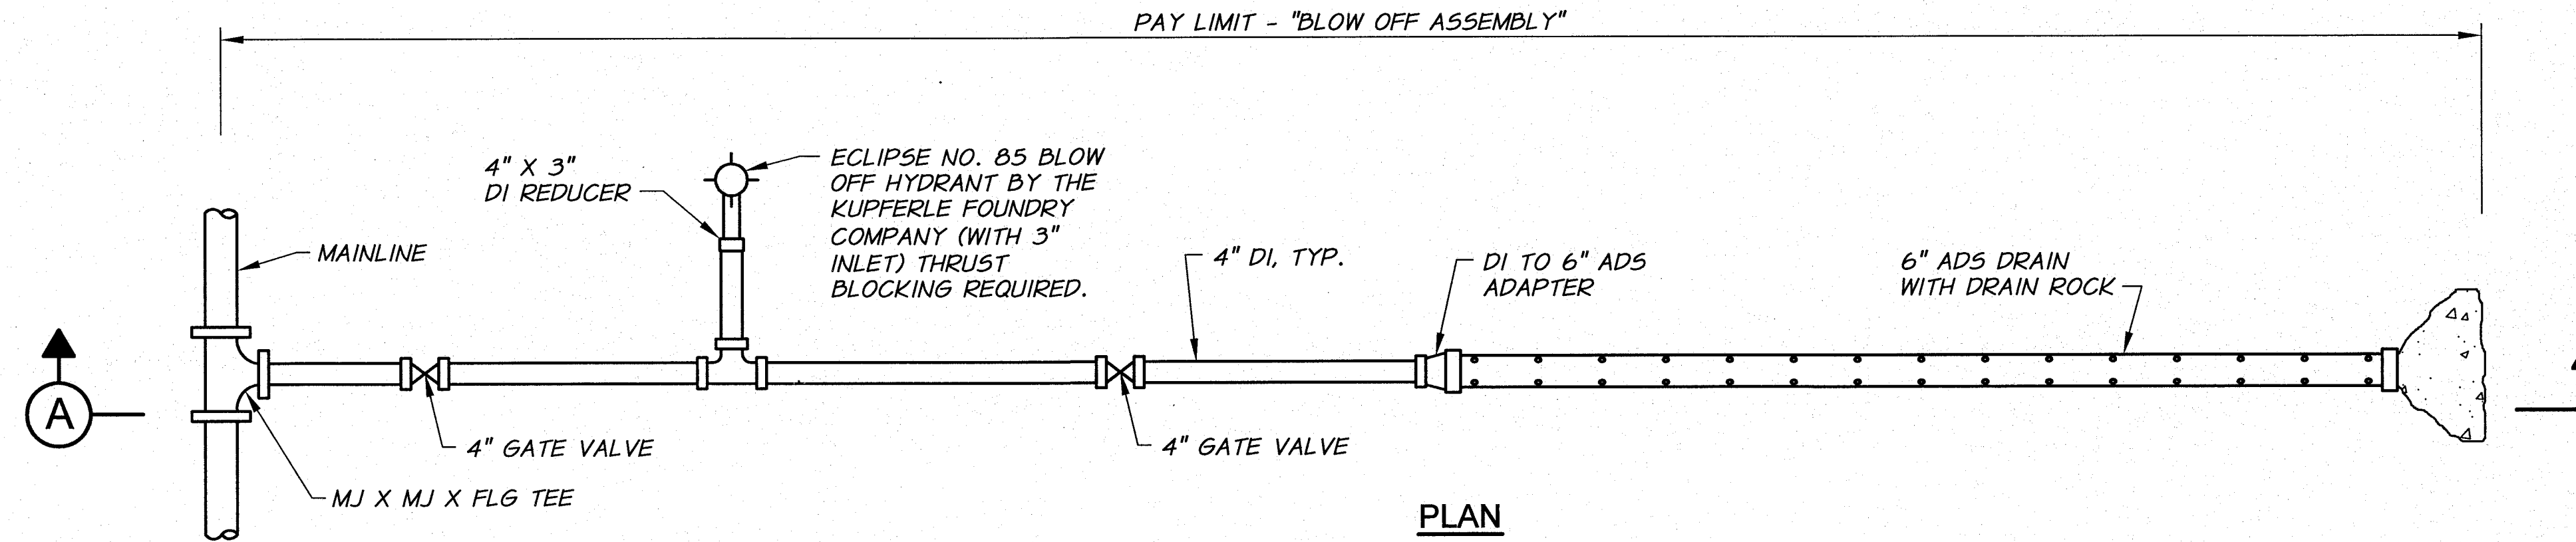


NOTE:
FOR MAIN LINE SIZE LESS THAN 4-INCHES, REDUCE PIPE SIZES TO MATCH MAIN LINE EXCEPT FOR ADS PERFORATED PIPE. PROVIDE FITTINGS AS REQUIRED.

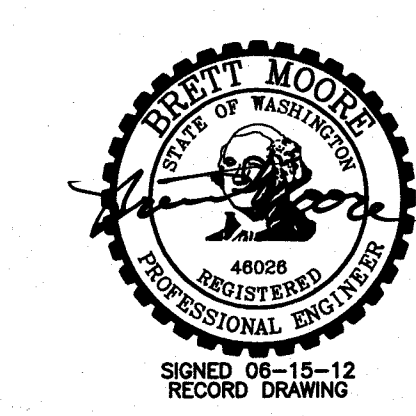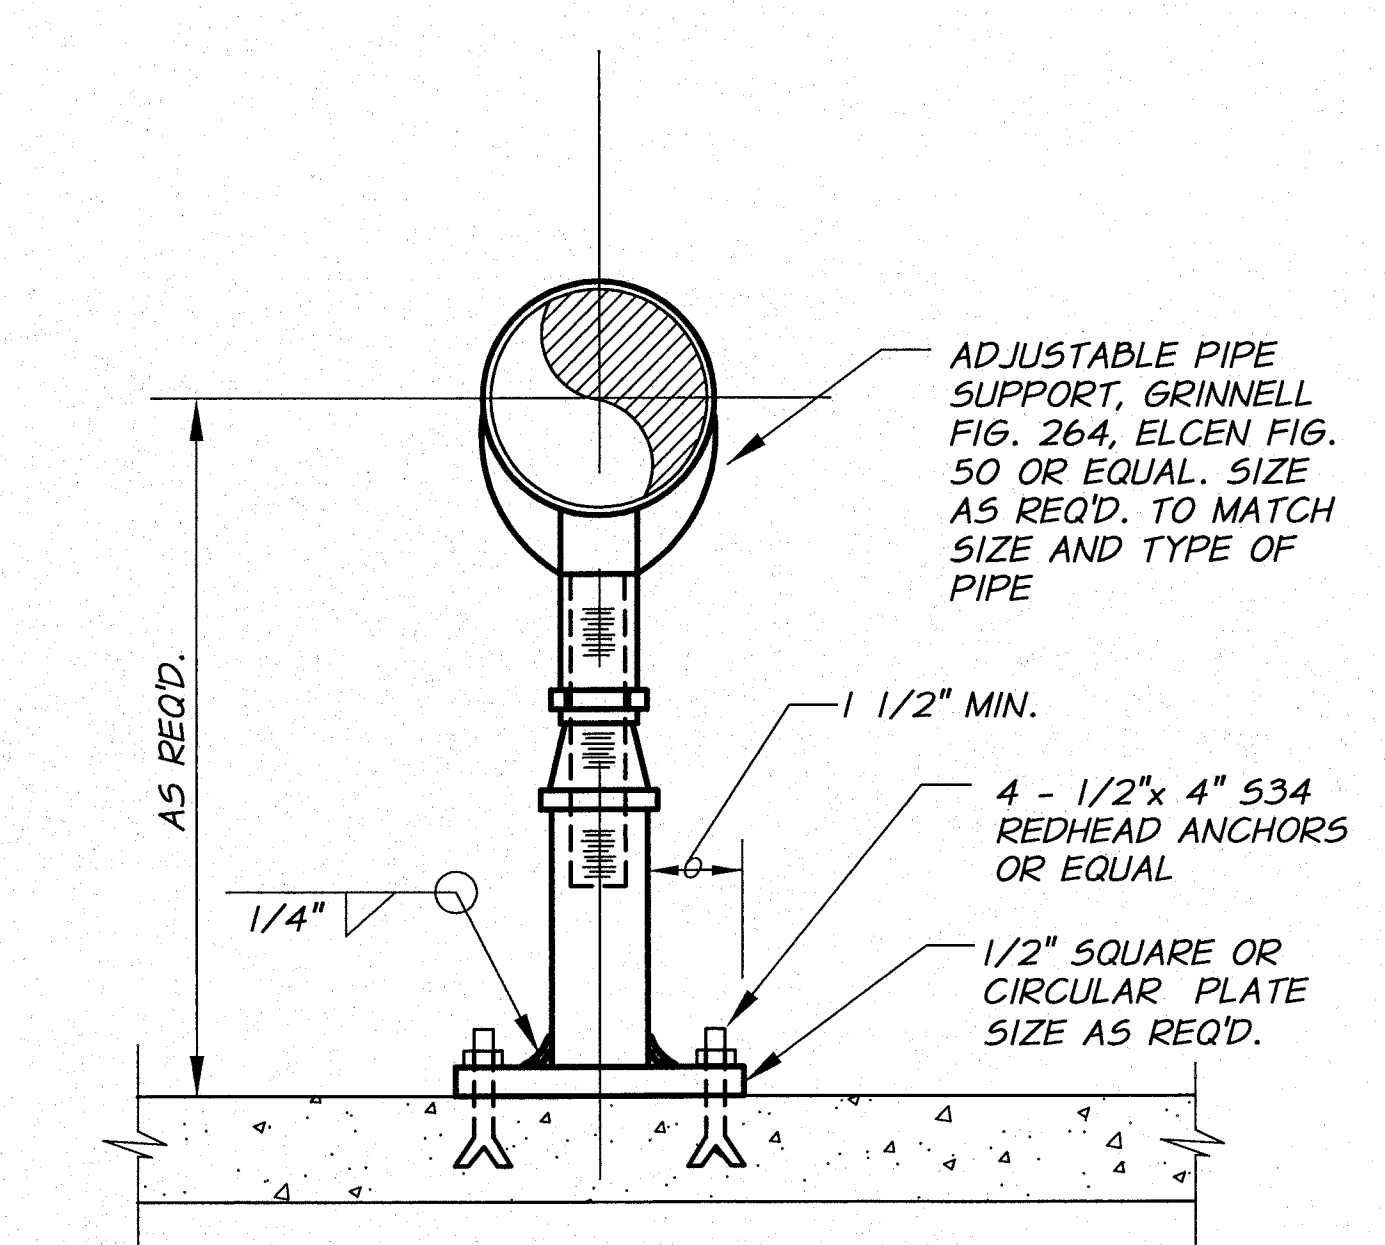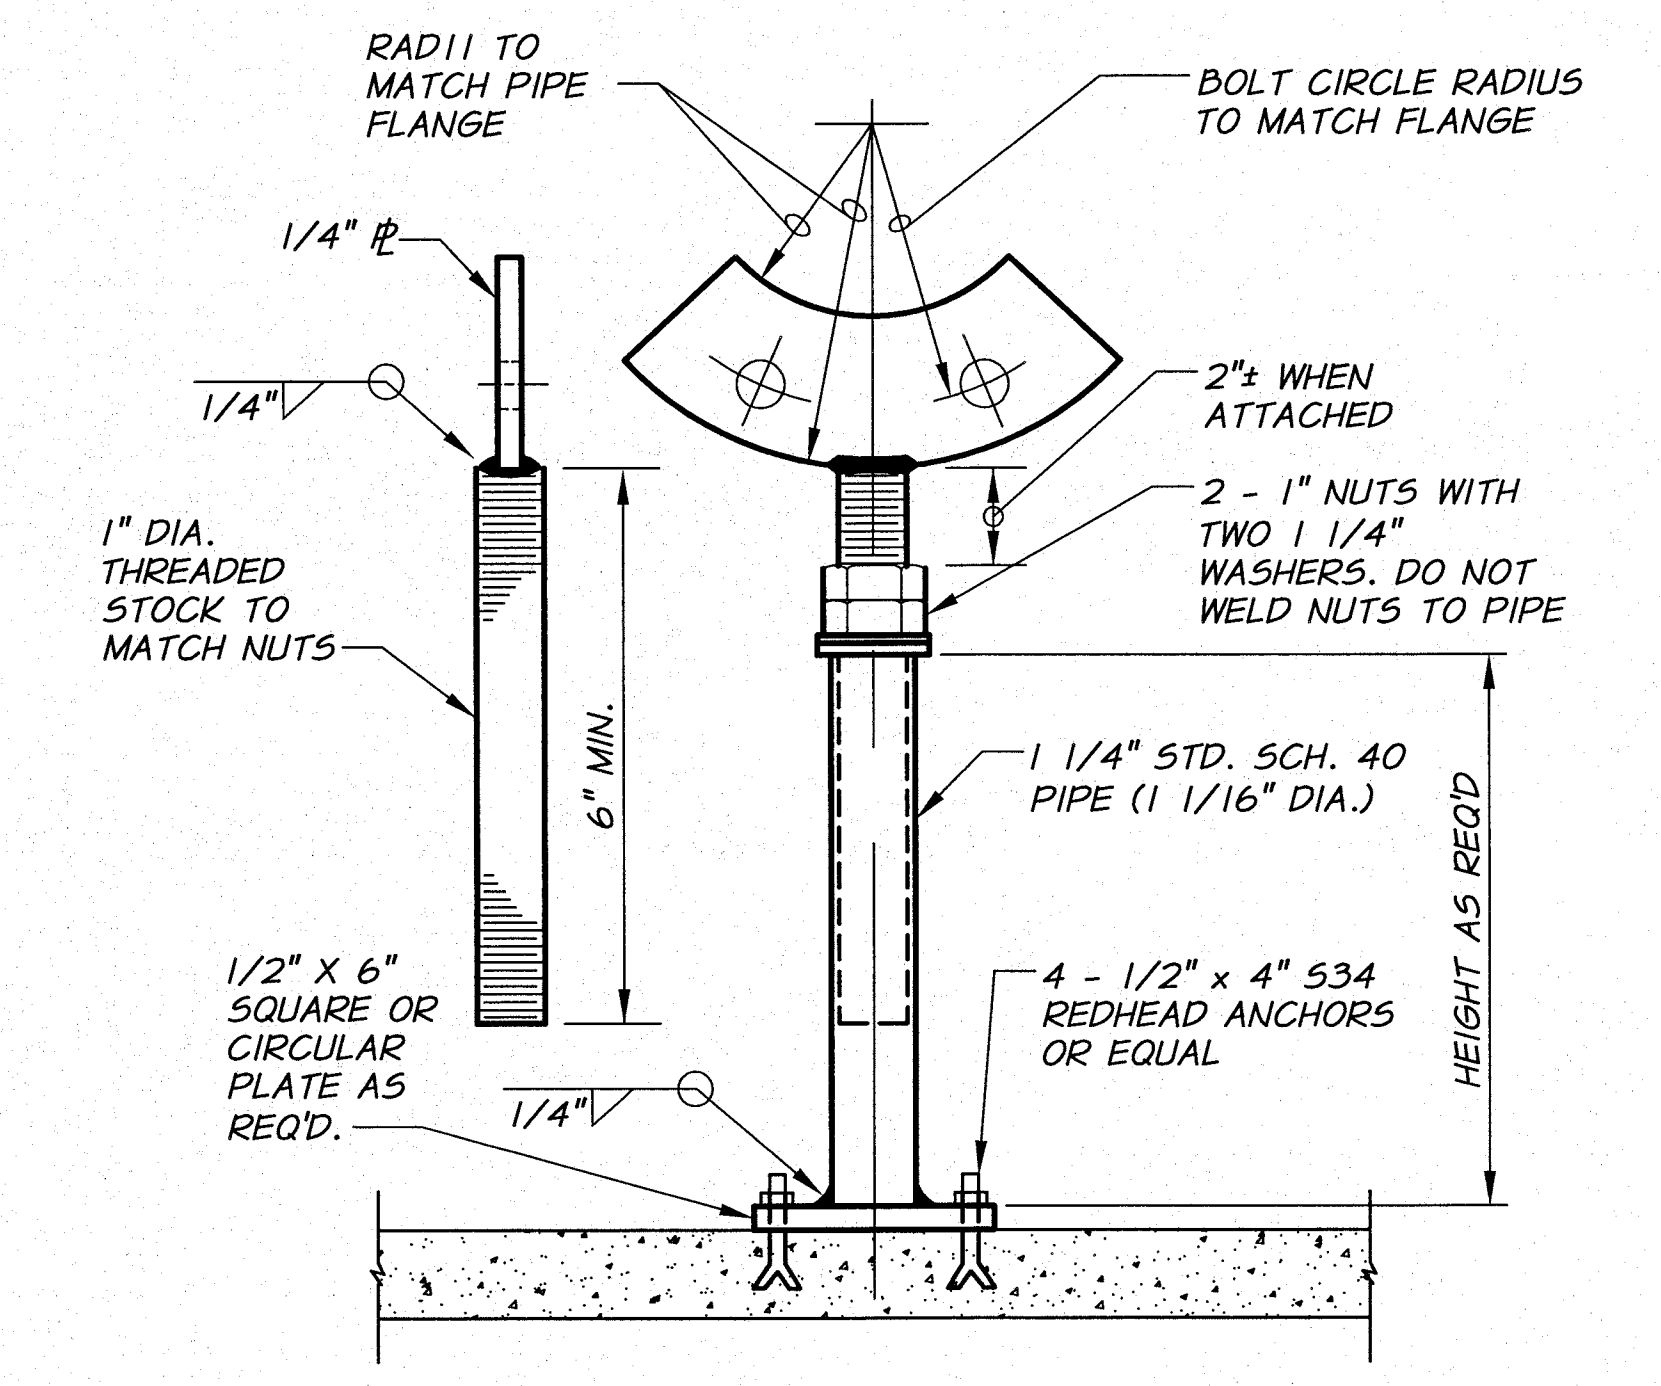

REVISION	BY	DATE	HORIZ. SCALE	NONE	VERT. SCALE
DESIGNED BY	R. HARRIS	XREFS: TB-BID.dwg	JOB NUMBER	1199-336	DATE
DRAWN BY	D. CHRISTMAN		ACAD FILE	lrrgDets-II.dwg	
REVIEWED BY	H. PERRY		COPYRIGHT 2009 BY ANDERSON-PERRY & ASSOC., INC.		


RECORD DRAWINGS
These record drawings have been prepared, in part, on the basis of information compiled and furnished by others. They may contain some discrepancies and omissions, and do not necessarily represent "exact" field conditions. The Owner and the Engineer accept no responsibility for their accuracy.

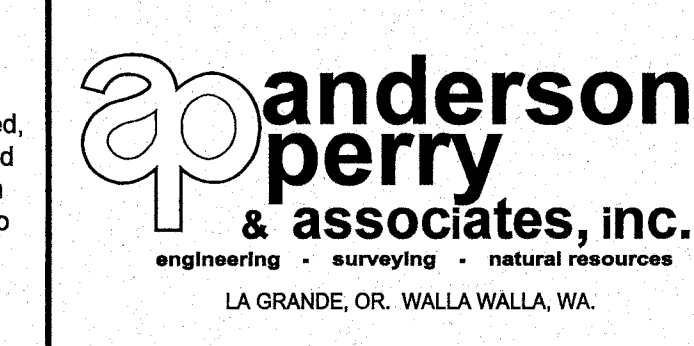


BENTON IRRIGATION DISTRICT
IRRIGATION SYSTEM IMPROVEMENTS
PHASE I
MISCELLANEOUS DETAILS III

SHEET
122


ARCHIVED
ARCHIVED

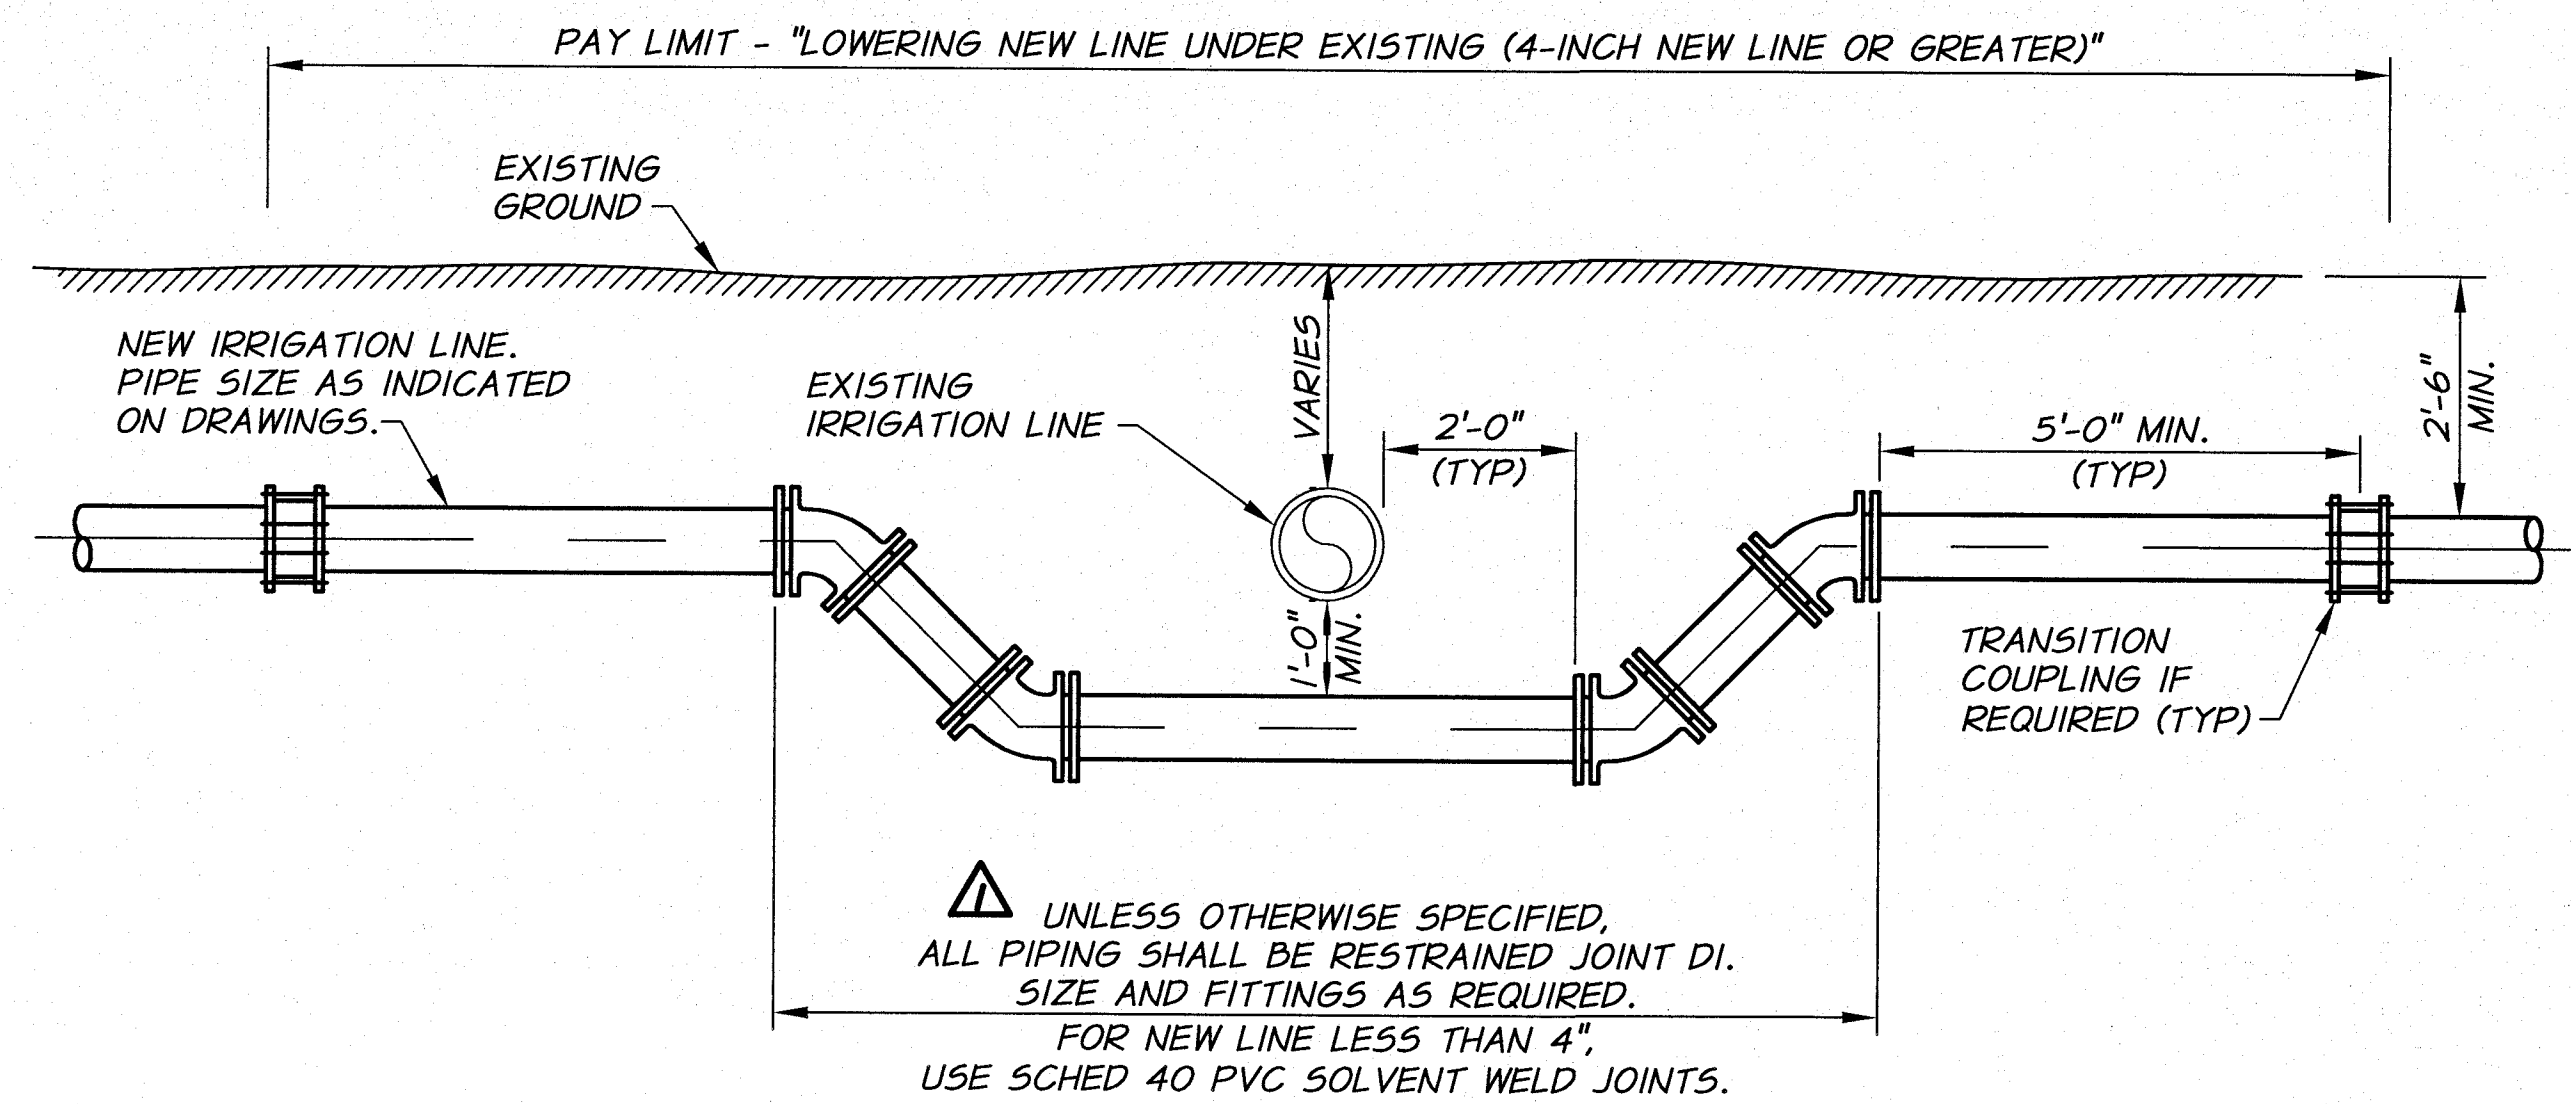

LOWERING NEW IRRIGATION LINE UNDER EXISTING
SECTION
N.T.S.

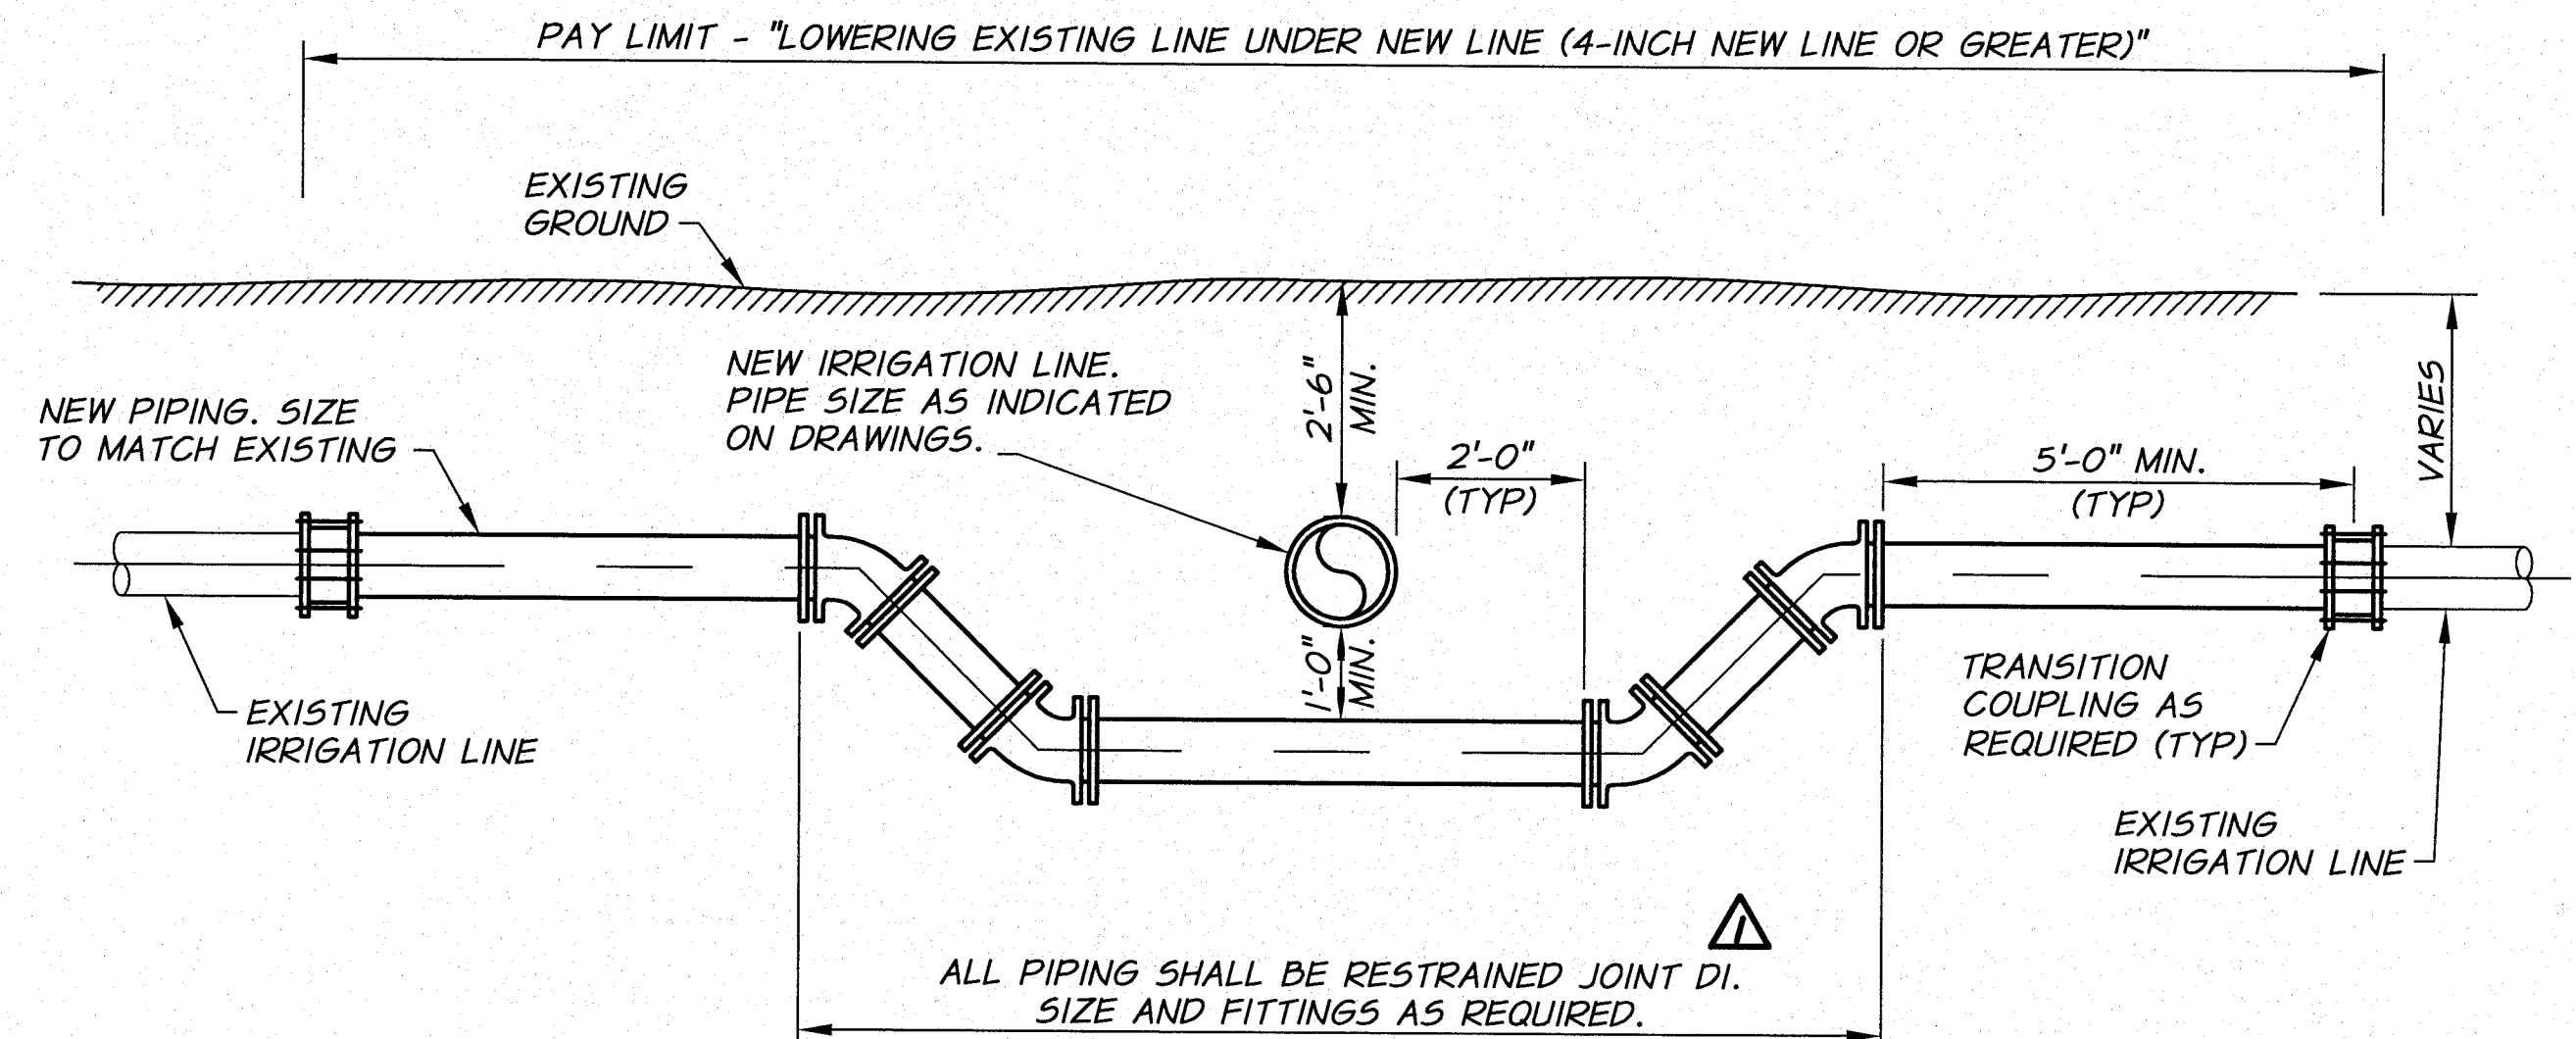


LOWERING EXISTING IRRIGATION LINE UNDER NEW
SECTION
N.T.S.

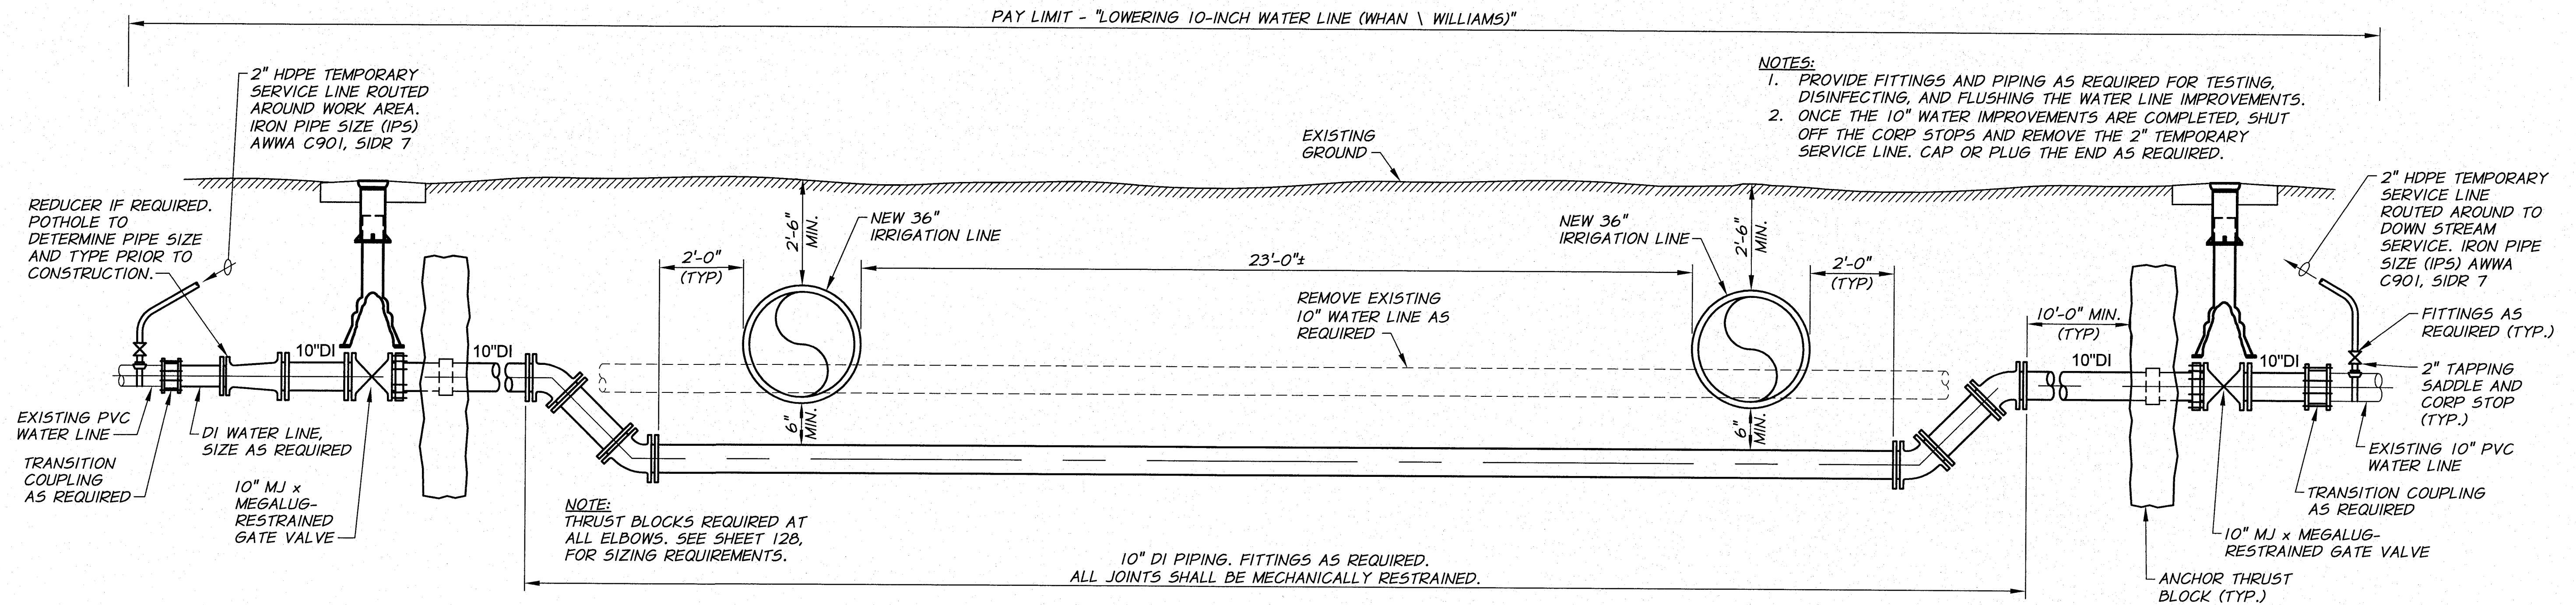

EXISTING 10" WATER LINE UNDER NEW IRRIGATION PIPING
WHAN / WILLIAMS ROAD
N.T.S.


- NOTES:**
1. PROVIDE FITTINGS AND PIPING AS REQUIRED FOR TESTING, DISINFECTING, AND FLUSHING THE WATER LINE IMPROVEMENTS.
 2. ONCE THE 10" WATER IMPROVEMENTS ARE COMPLETED, SHUT OFF THE CORP STOPS AND REMOVE THE 2" TEMPORARY SERVICE LINE. CAP OR PLUG THE END AS REQUIRED.

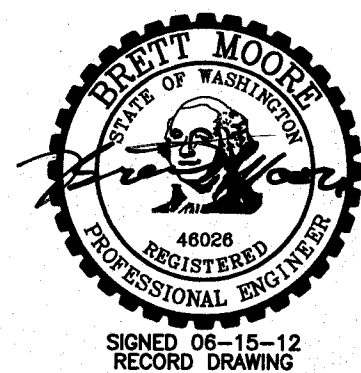

RECORD DRAWING		E.H.	12/11
DESIGNED BY	R. HARRIS	BY	DATE
DRAWN BY	D. CHRISTMAN	HORIZ. SCALE	NONE
REVIEWED BY	H. PERRY	VERT. SCALE	
XREFS: TB-BID.dwg		JOB NUMBER	1199-336
		DATE	2009
		ACAD FILE:	lrrgDets-ll.dwg
COPYRIGHT 2009 BY ANDERSON-PERRY & ASSOC., INC.			

RECORD DRAWINGS

These record drawings have been prepared, in part, on the basis of information compiled and furnished by others. They may contain some discrepancies and omissions, and do not necessarily represent "exact" field conditions. The Owner and the Engineer accept no responsibility for their accuracy.

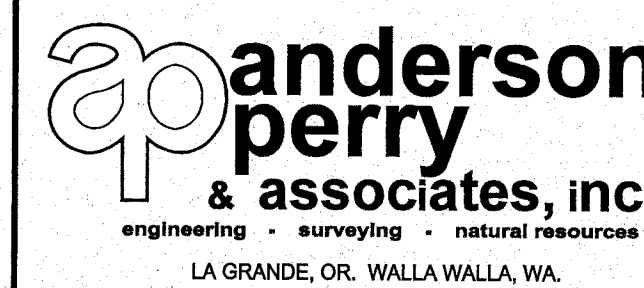


BENTON IRRIGATION DISTRICT
IRRIGATION SYSTEM IMPROVEMENTS
PHASE I


MISCELLANEOUS DETAILS IV

SHEET

123

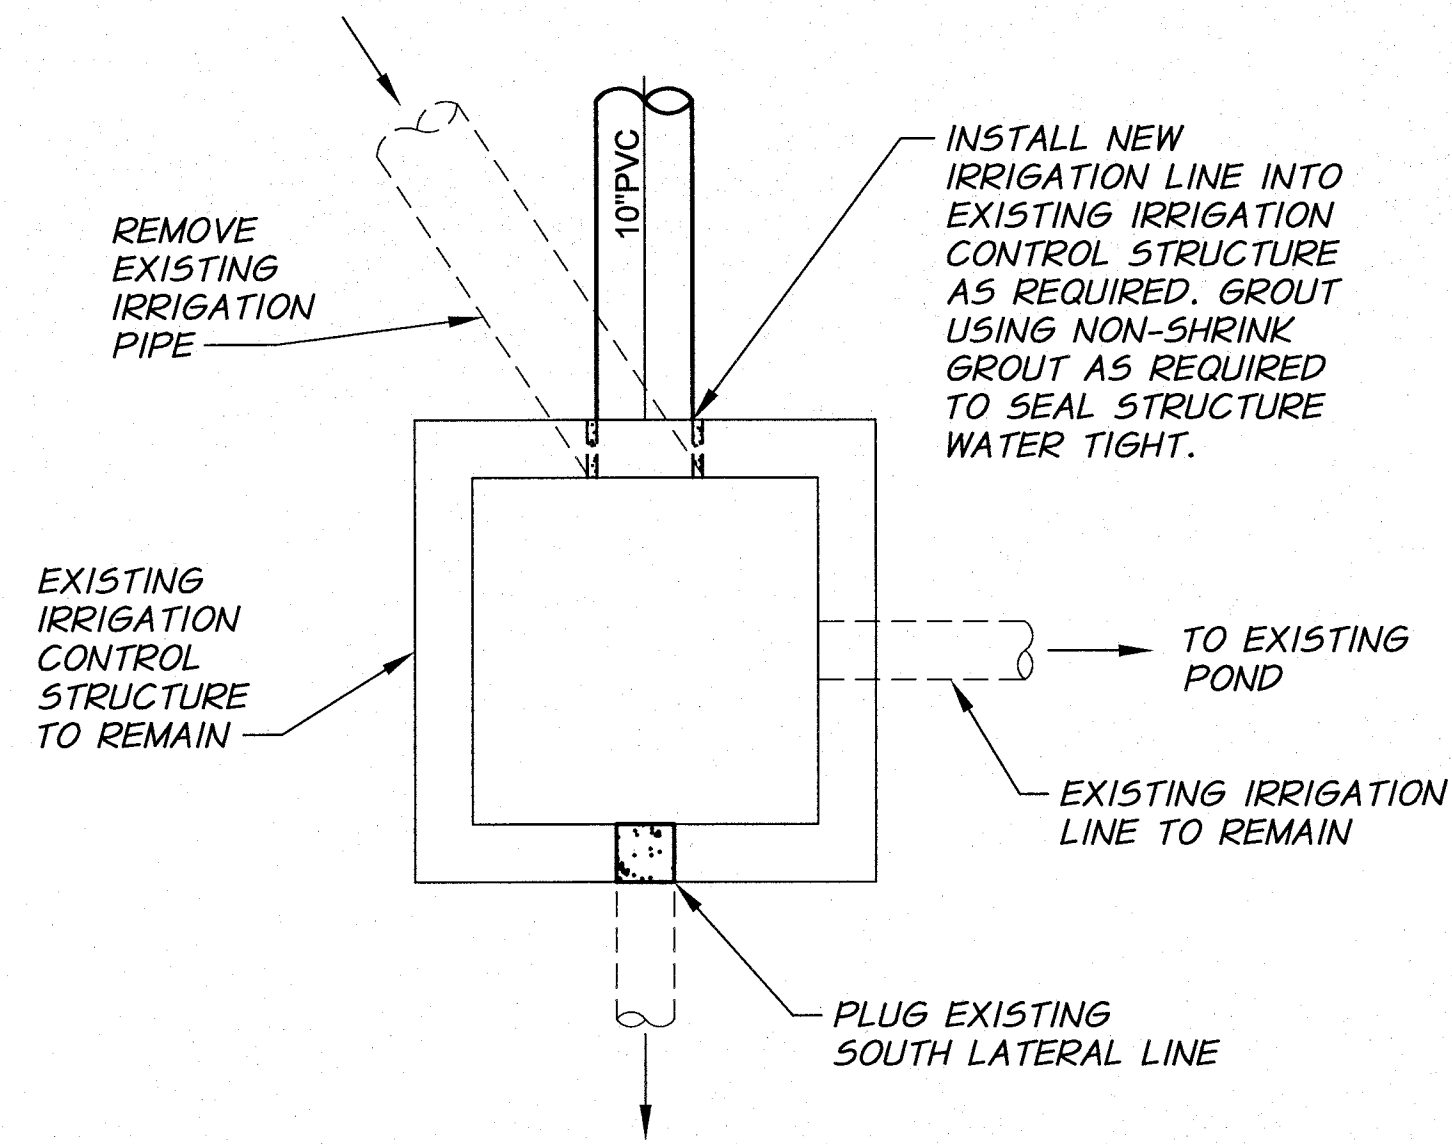


**10" SERVICE CONNECTION
INTO EXISTING STRUCTURE**
N.T.S.
(REF. SHEET 68)

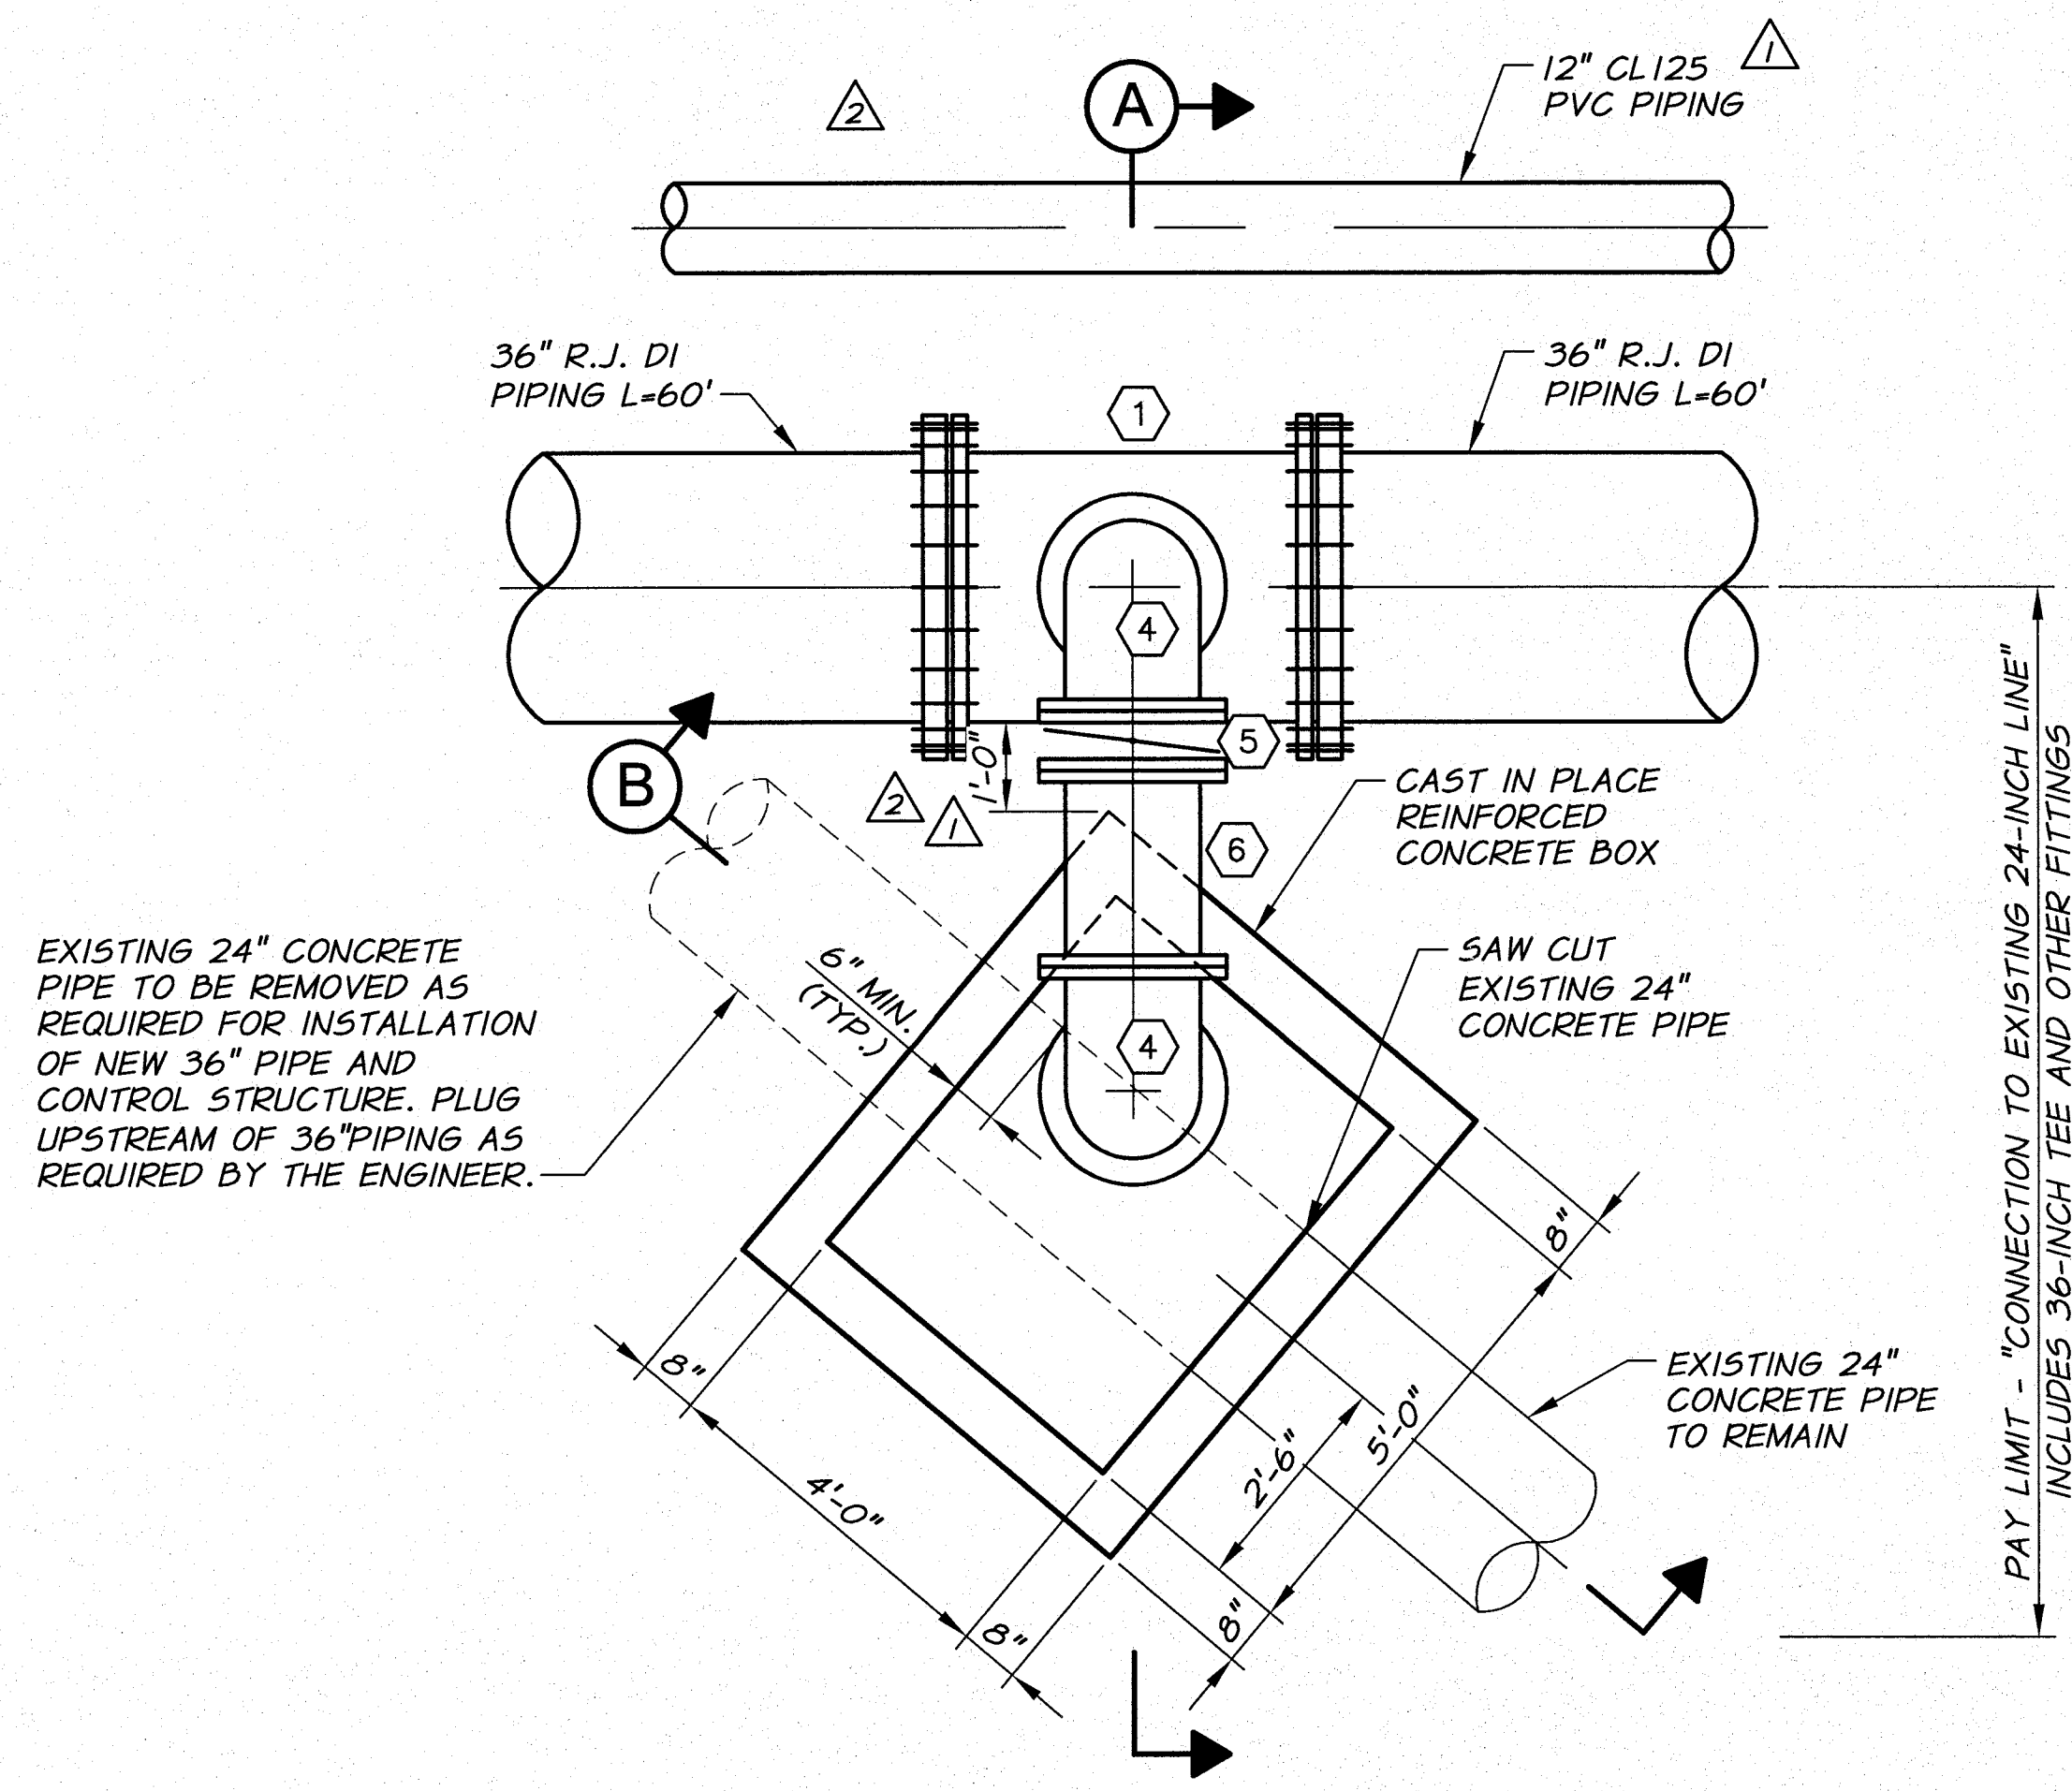


PLAN

- EQUIPMENT SCHEDULE**
- 1 36"x36"x18" MJ TEE. MJ CONNECTIONS TO BE RESTRAINED.
 - 2 18" DI SPOOL, LENGTH AS REQUIRED.
 - 3 18" KWIK FLANGE WITH TWO 5.5. TIE RODS.
 - 4 18" FLG 90° ELBOW
 - 5 18" FLG BUTTERFLY VALVE
 - 6 18" FLG DI SPOOL, LENGTH AS REQUIRED.
 - 7 18" FLGxPE DI SPOOL x 2'-6" LONG.
 - 8 PIPE SUPPORT. SEE DETAIL, SHEET 122.
 - 9 INSTALL EXPANDED METAL GRATING WITH ANGLE IRON FRAME SUPPORT AS REQUIRED BY THE ENGINEER.

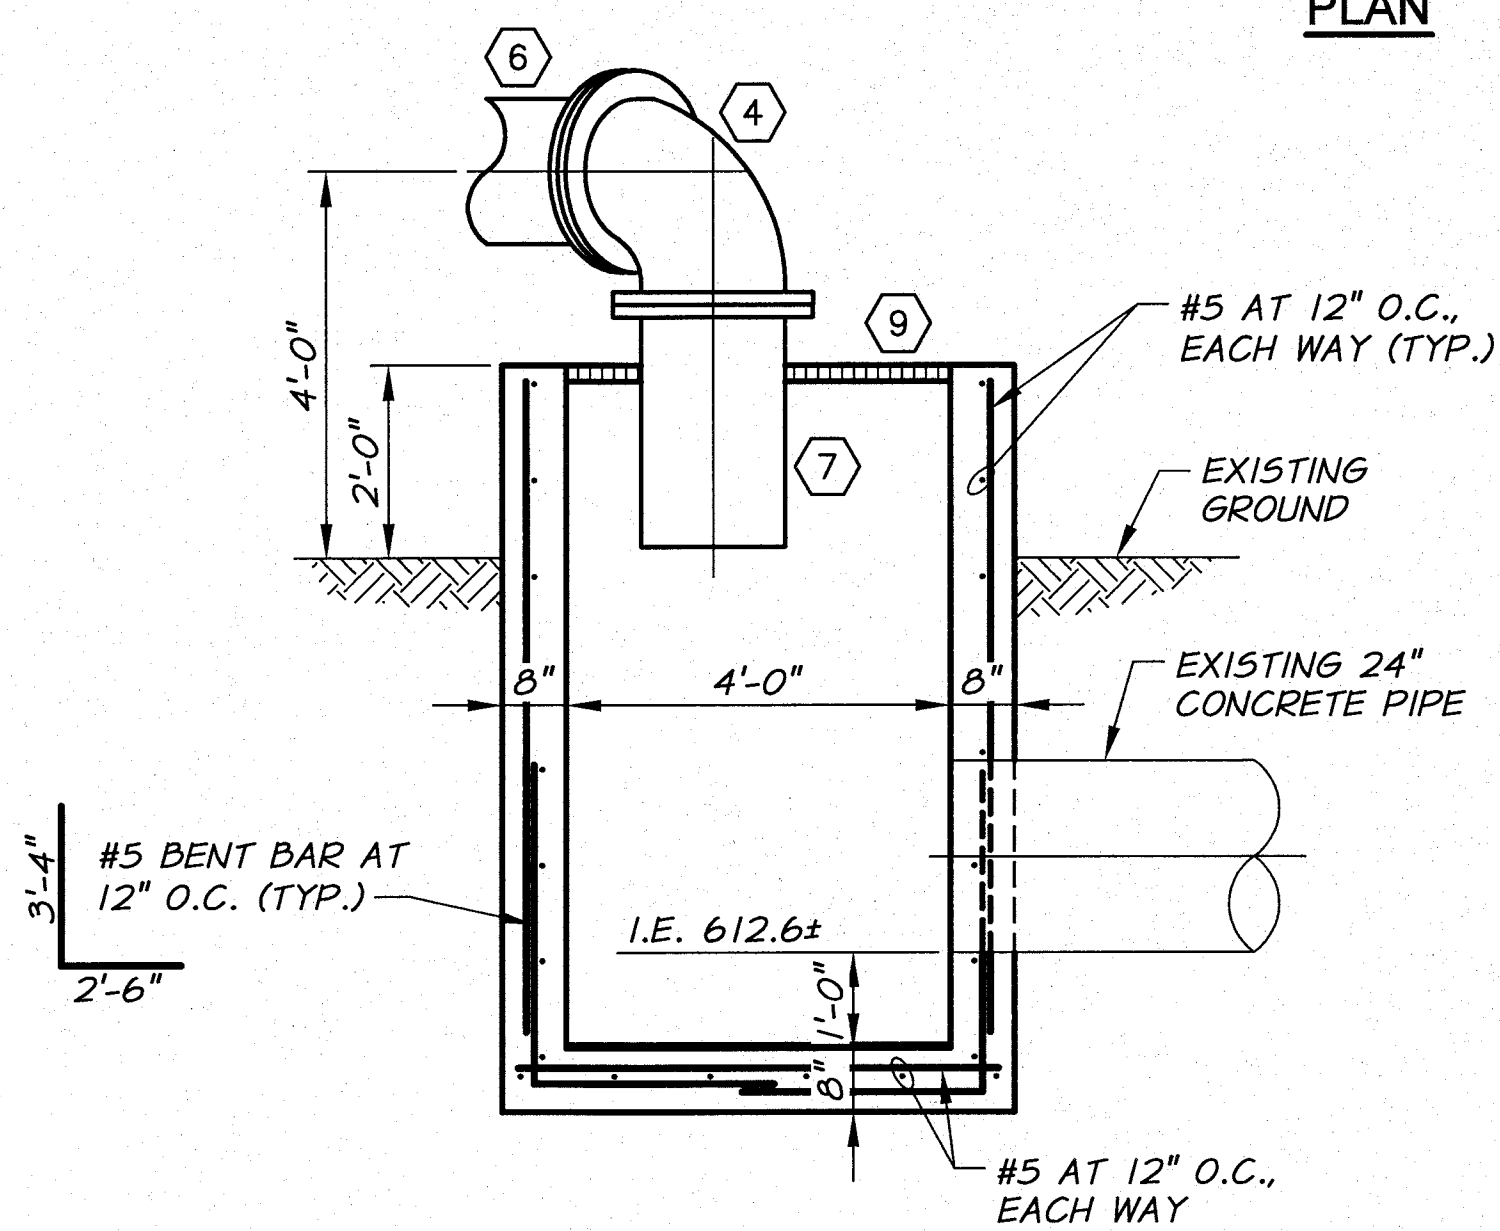

SECTION B

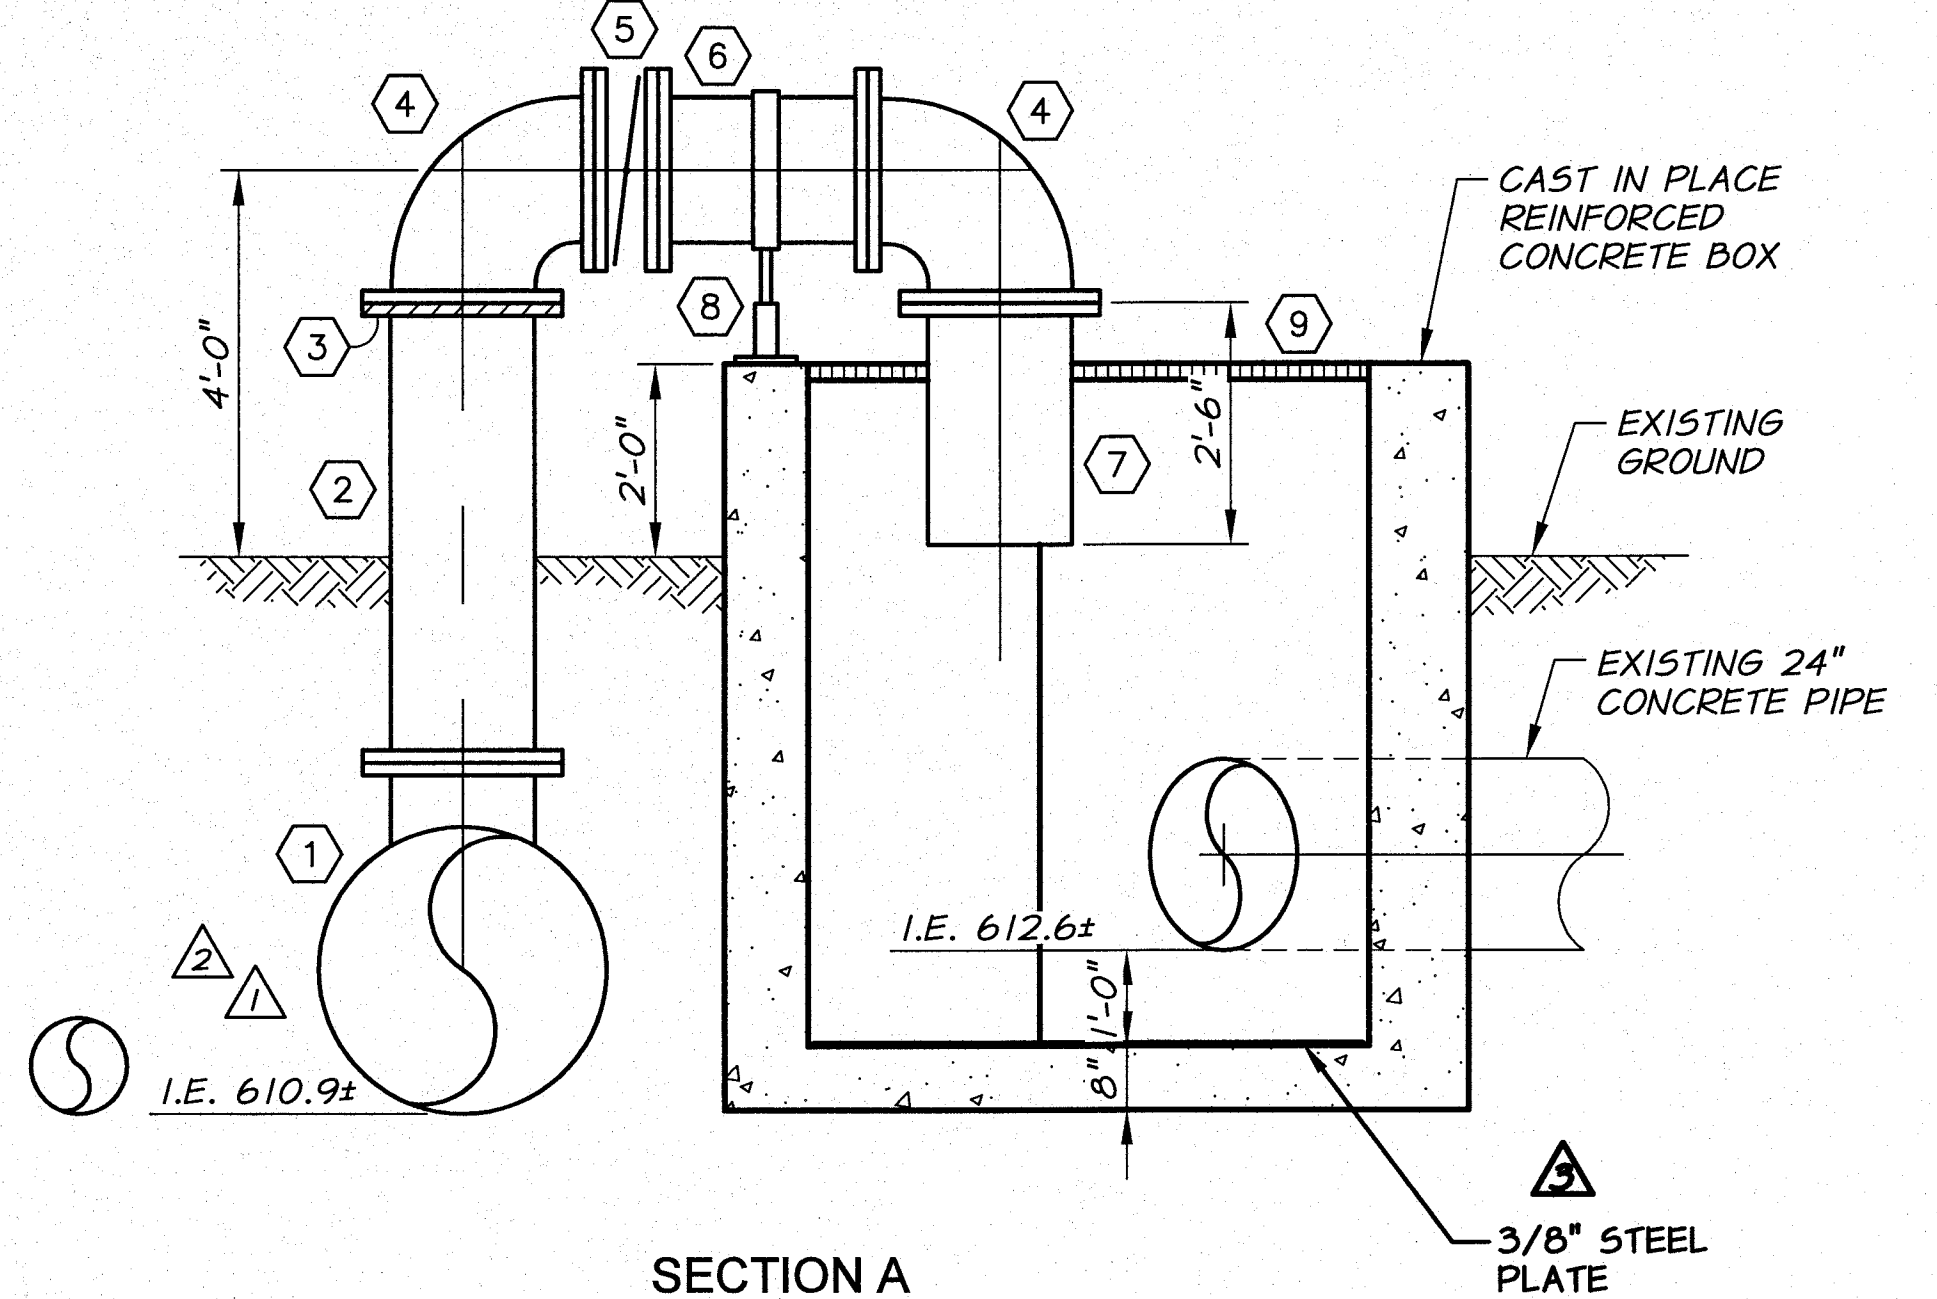


SECTION A

CONNECTION DETAIL
CONNECTION TO EXISTING 24" IRRIGATION LINE
1/2" x 1'-0"
(REF. SHEET 69)




REVISION	BY	DATE	HORIZ. SCALE	AS NOTED	VERT. SCALE
RECORD DRAWING	E.H.	12/11	1/2" = 1'-0"		
DETAIL REVISION	R.H.	2/10			
DETAIL REVISION	R.H.	1/10			
DESIGNED BY	R. HARRIS		XREFS: TB-BID.dwg		
DRAWN BY	D. CHRISTMAN		JOB NUMBER 1199-336		
REVIEWED BY	H. PERRY		DATE 2009		
			ACAD FILE IrrgDets-11.dwg		
	COPYRIGHT 2009 BY ANDERSON-PERRY & ASSOC., INC.				

RECORD DRAWINGS
These record drawings have been prepared, in part, on the basis of information compiled and furnished by others. They may contain some discrepancies and omissions, and do not necessarily represent "exact" field conditions. The Owner and the Engineer accept no responsibility for their accuracy.

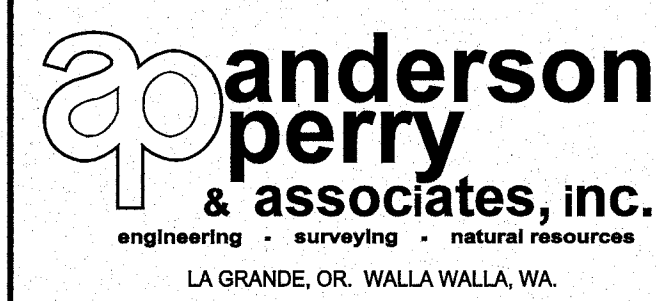



BENTON IRRIGATION DISTRICT
IRRIGATION SYSTEM IMPROVEMENTS
PHASE I
MISCELLANEOUS DETAILS V

METER LOCATION	DISTANCE TO UTILITY POLE
WILLIAMS ROAD 2+00	30 FT. EAST
CORRAL CK. ROAD 1+50	115 FT. EAST
WHAN ROAD 8+40	10 FT. SOUTH

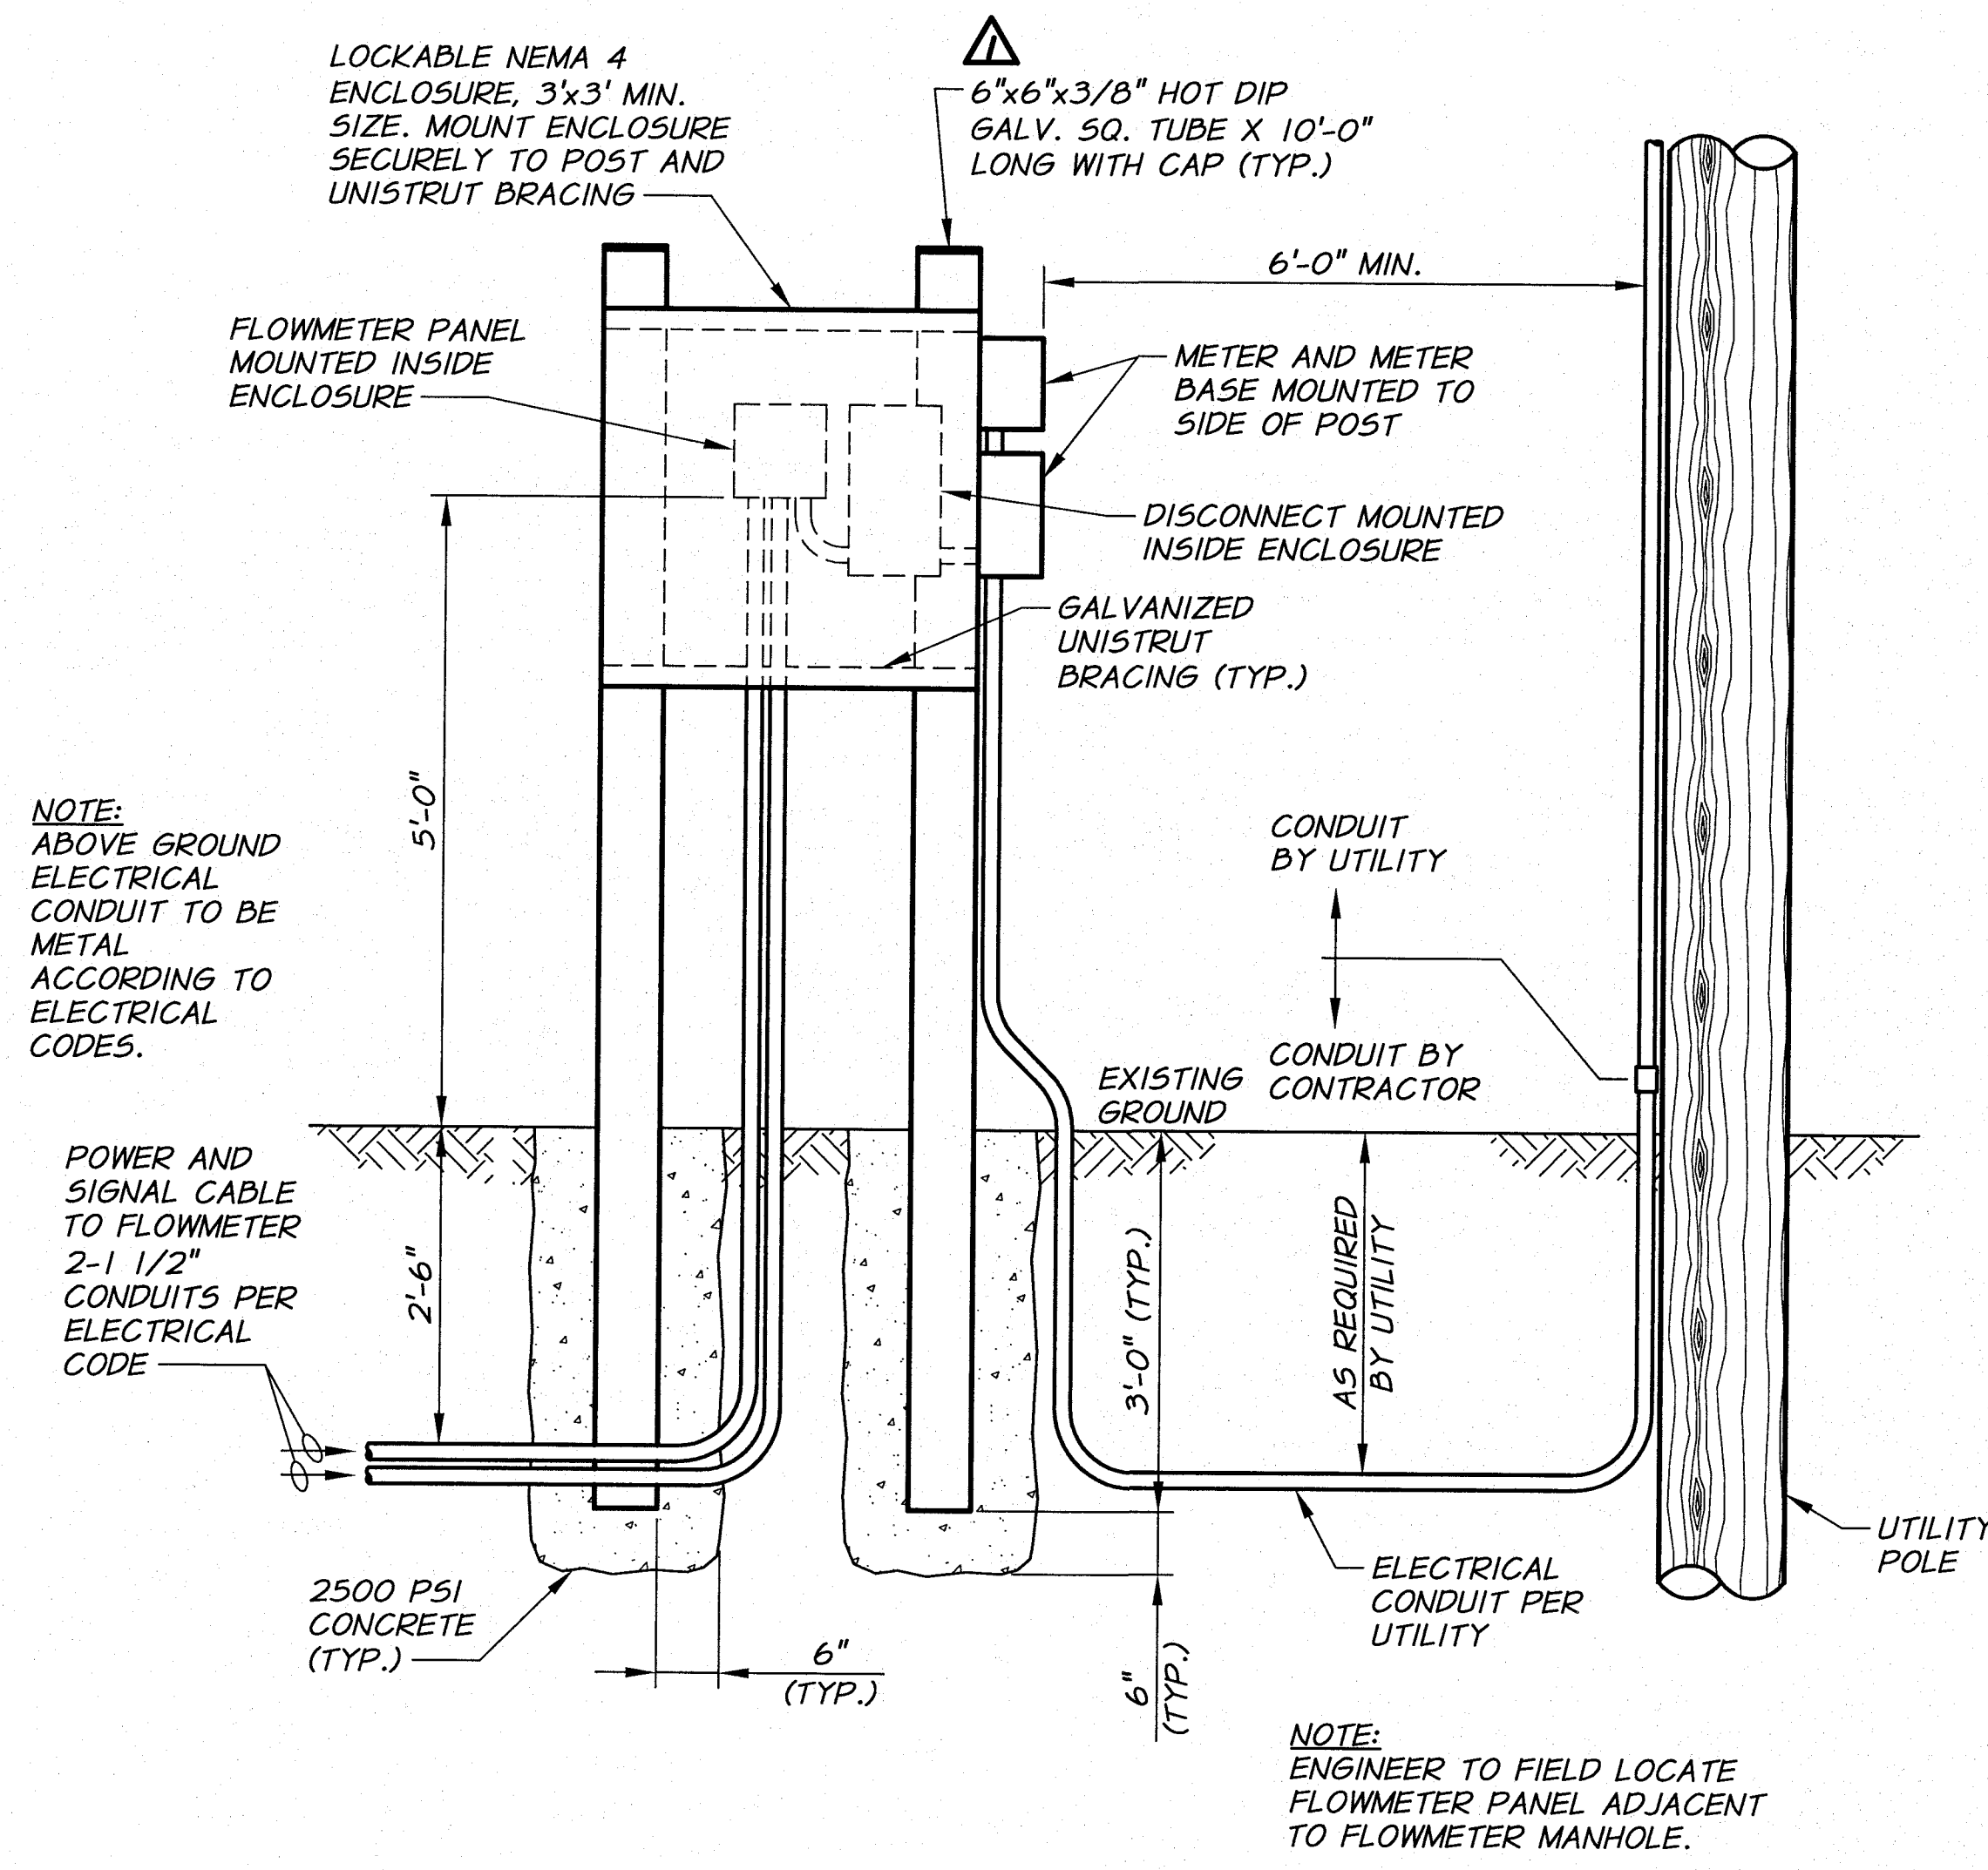


FLOWMETER PANEL DETAIL
3/4"=1'-0"

ALL WORK THIS SHEET UNDER PAY LIMIT - "MAIN LINE FLOWMETER"

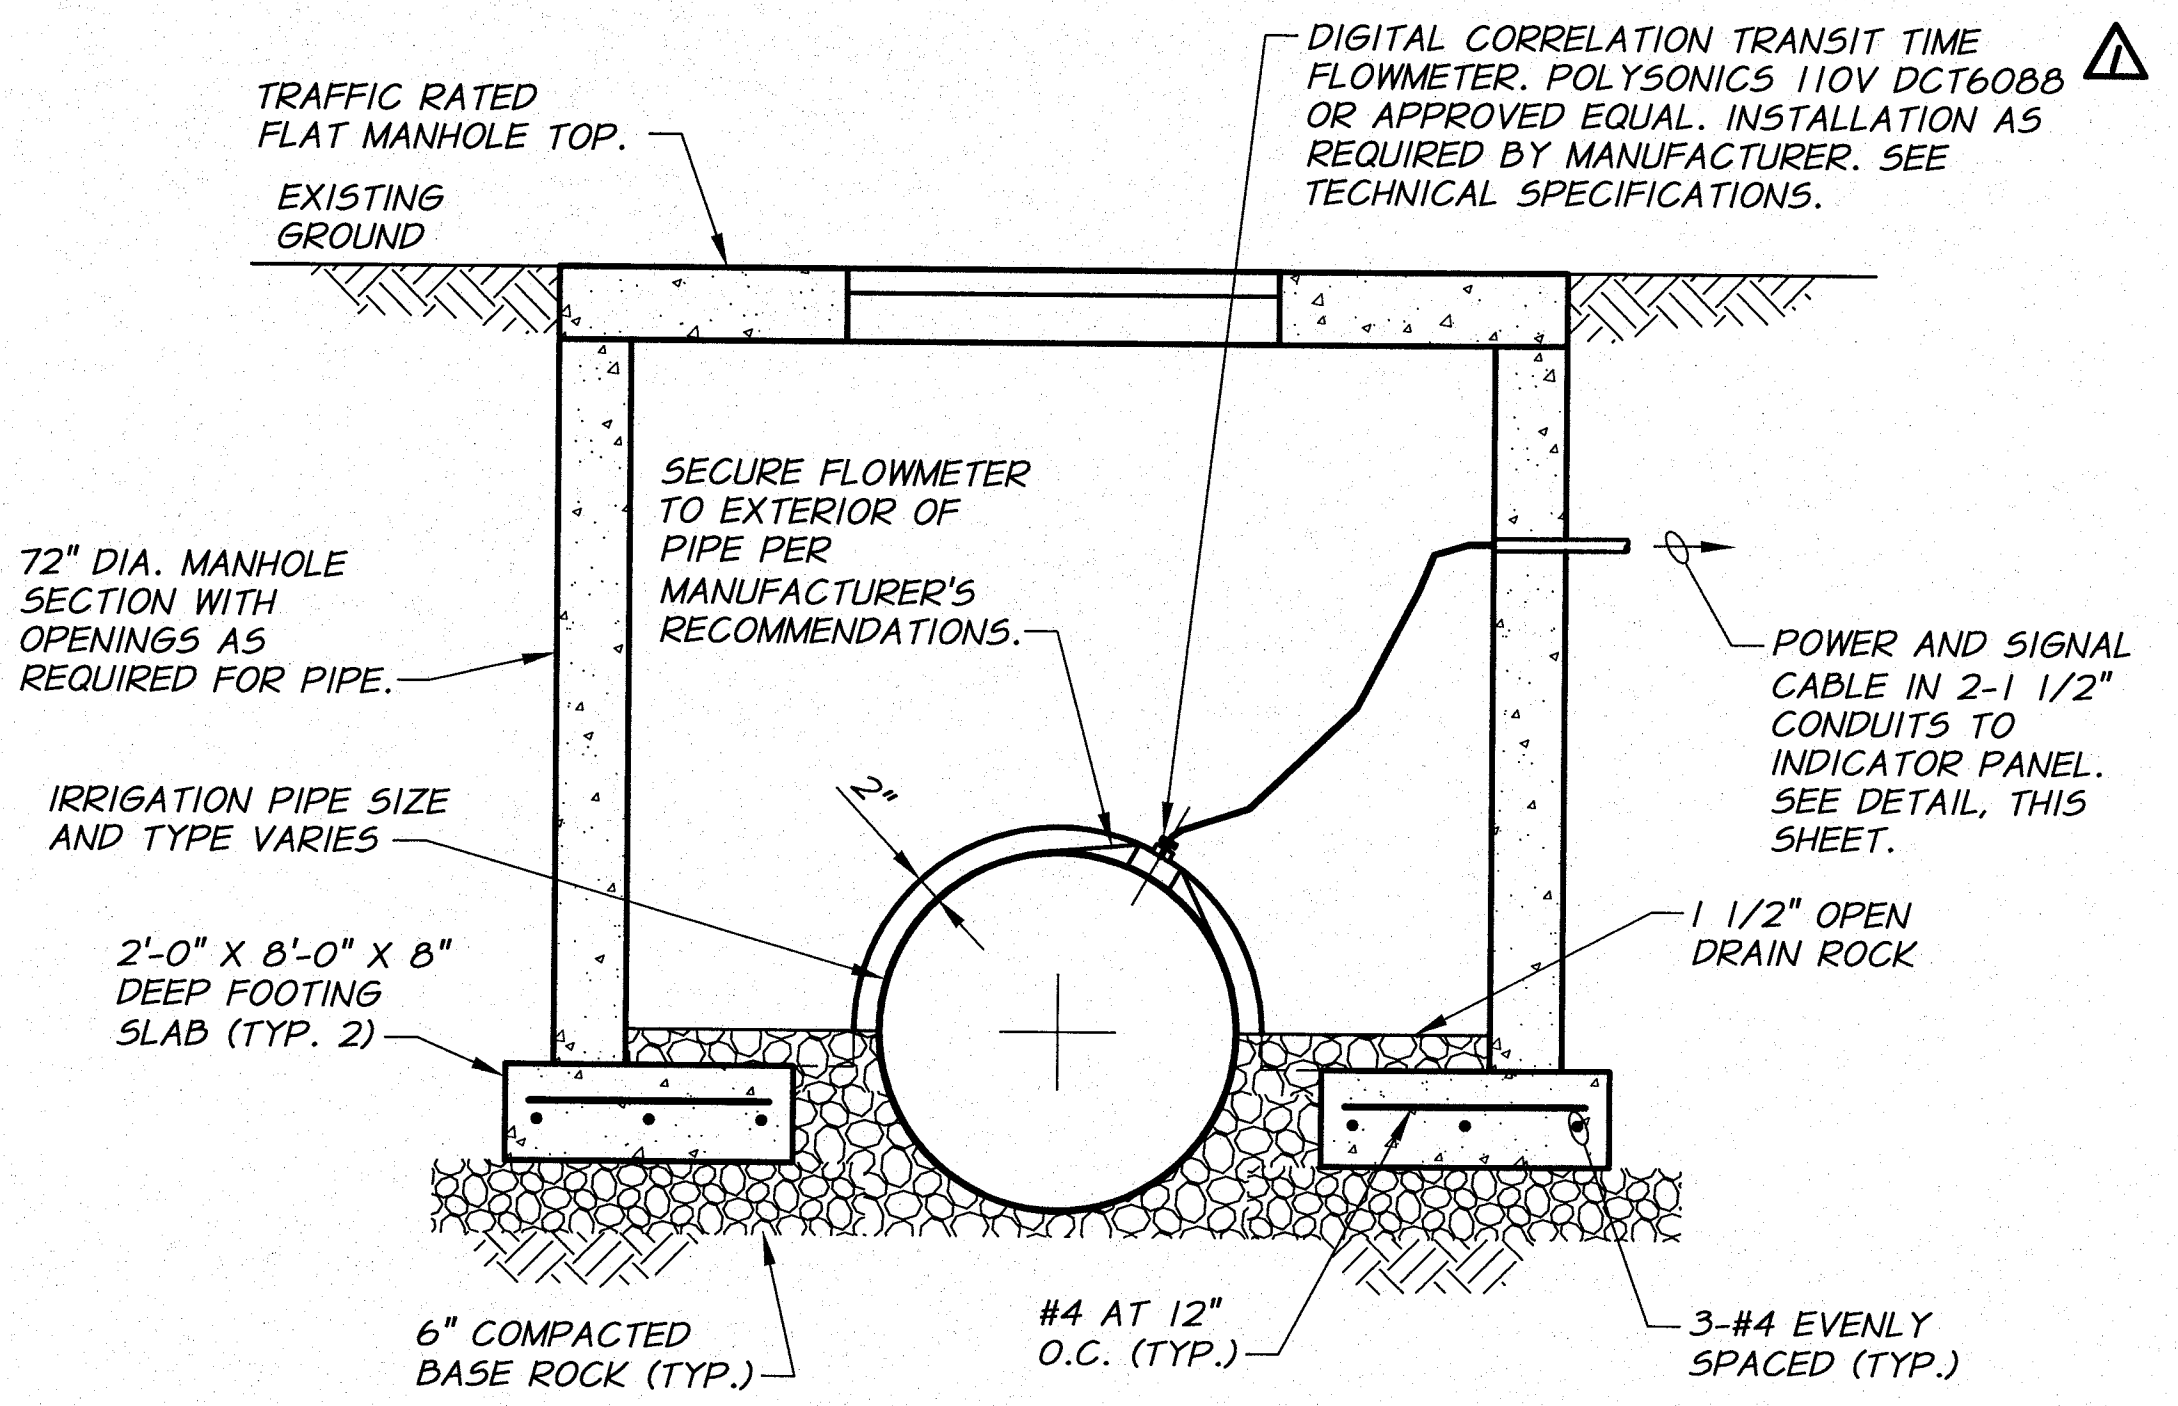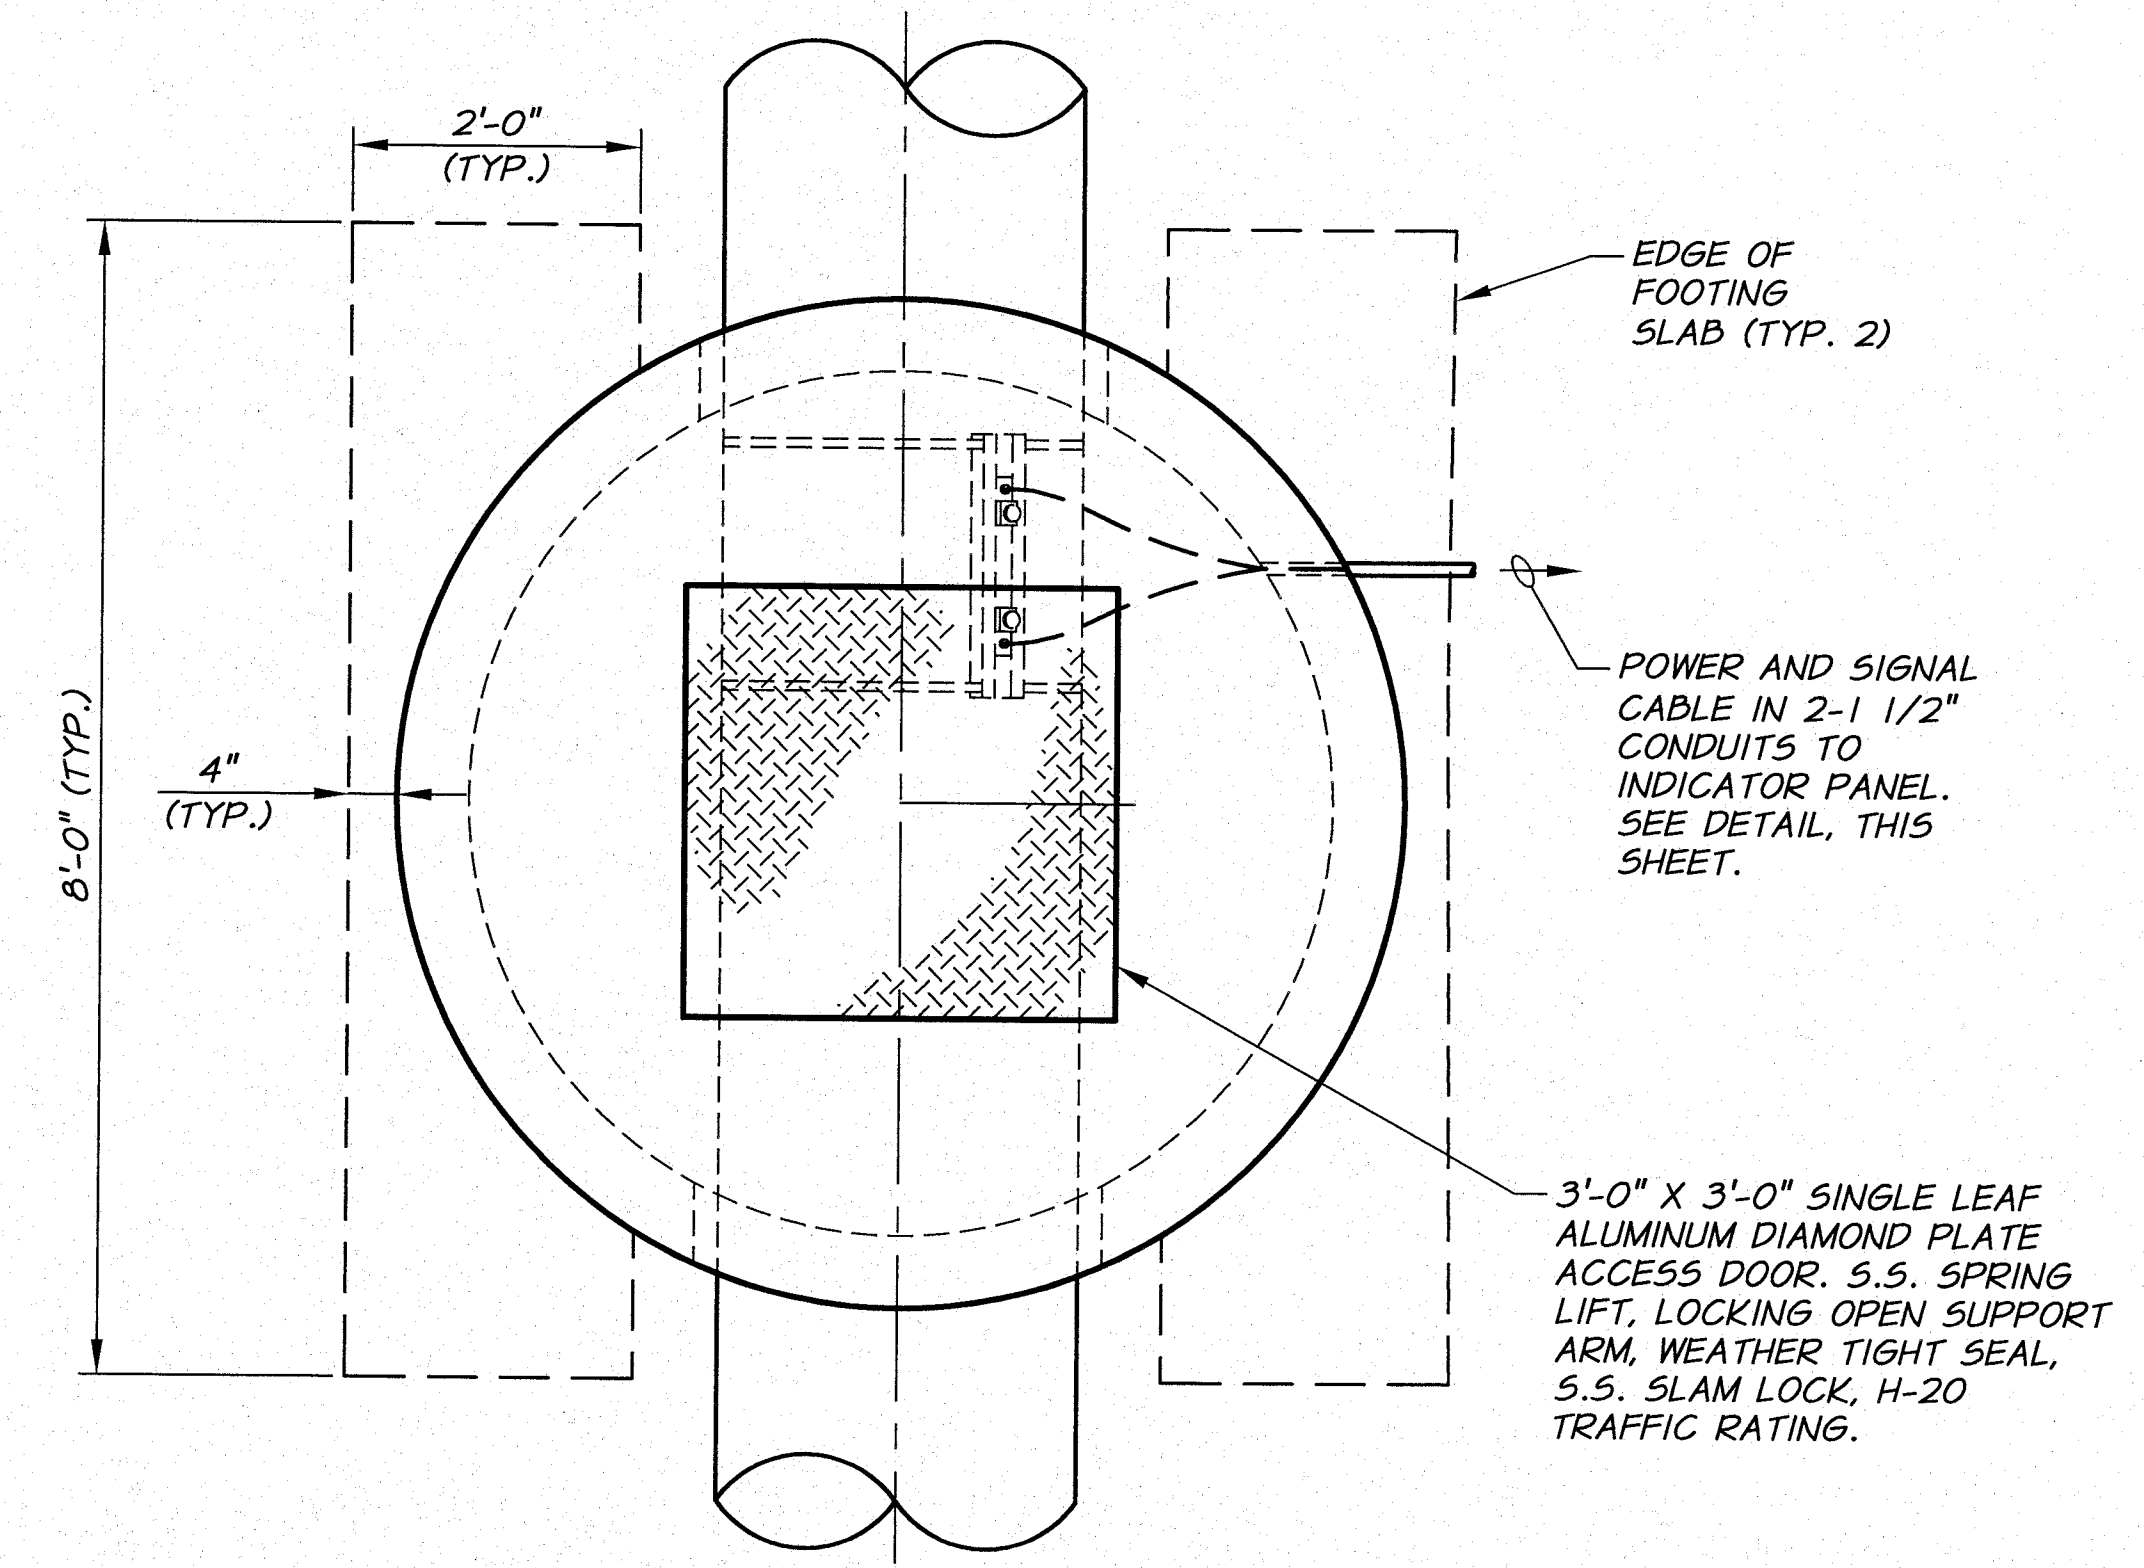


MAIN LINE FLOWMETER DETAIL
3/4"=1'-0"

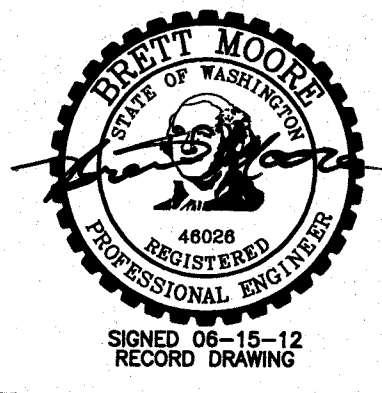


RECORD DRAWING		E.H.	12/11	1 0 1 2 3 4 3/4" = 1'-0"	
DESIGNED BY	R. HARRIS	BY	DATE	HORIZ. SCALE	AS NOTED
DRAWN BY	D. CHRISTMAN			VERT. SCALE	
REVIEWED BY	H. PERRY			JOB NUMBER	1199-336
				DATE	2009
				ACAD FILE:	FlowmeterDets.dwg
COPYRIGHT 2009 BY ANDERSON-PERRY & ASSOC., INC.					

RECORD DRAWINGS
These record drawings have been prepared, in part, on the basis of information compiled and furnished by others. They may contain some discrepancies and omissions, and do not necessarily represent "exact" field conditions. The Owner and the Engineer accept no responsibility for their accuracy.

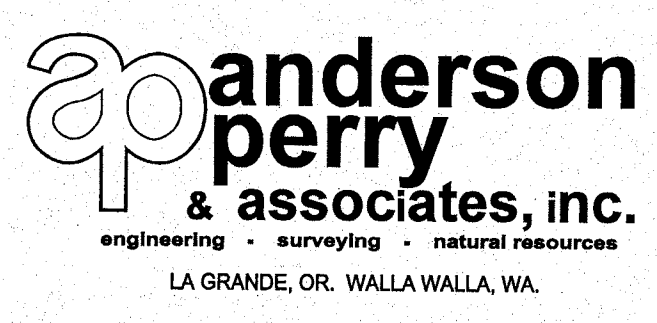

BENTON IRRIGATION DISTRICT
IRRIGATION SYSTEM IMPROVEMENTS
PHASE I
FLOWMETER DETAILS


SHEET
125

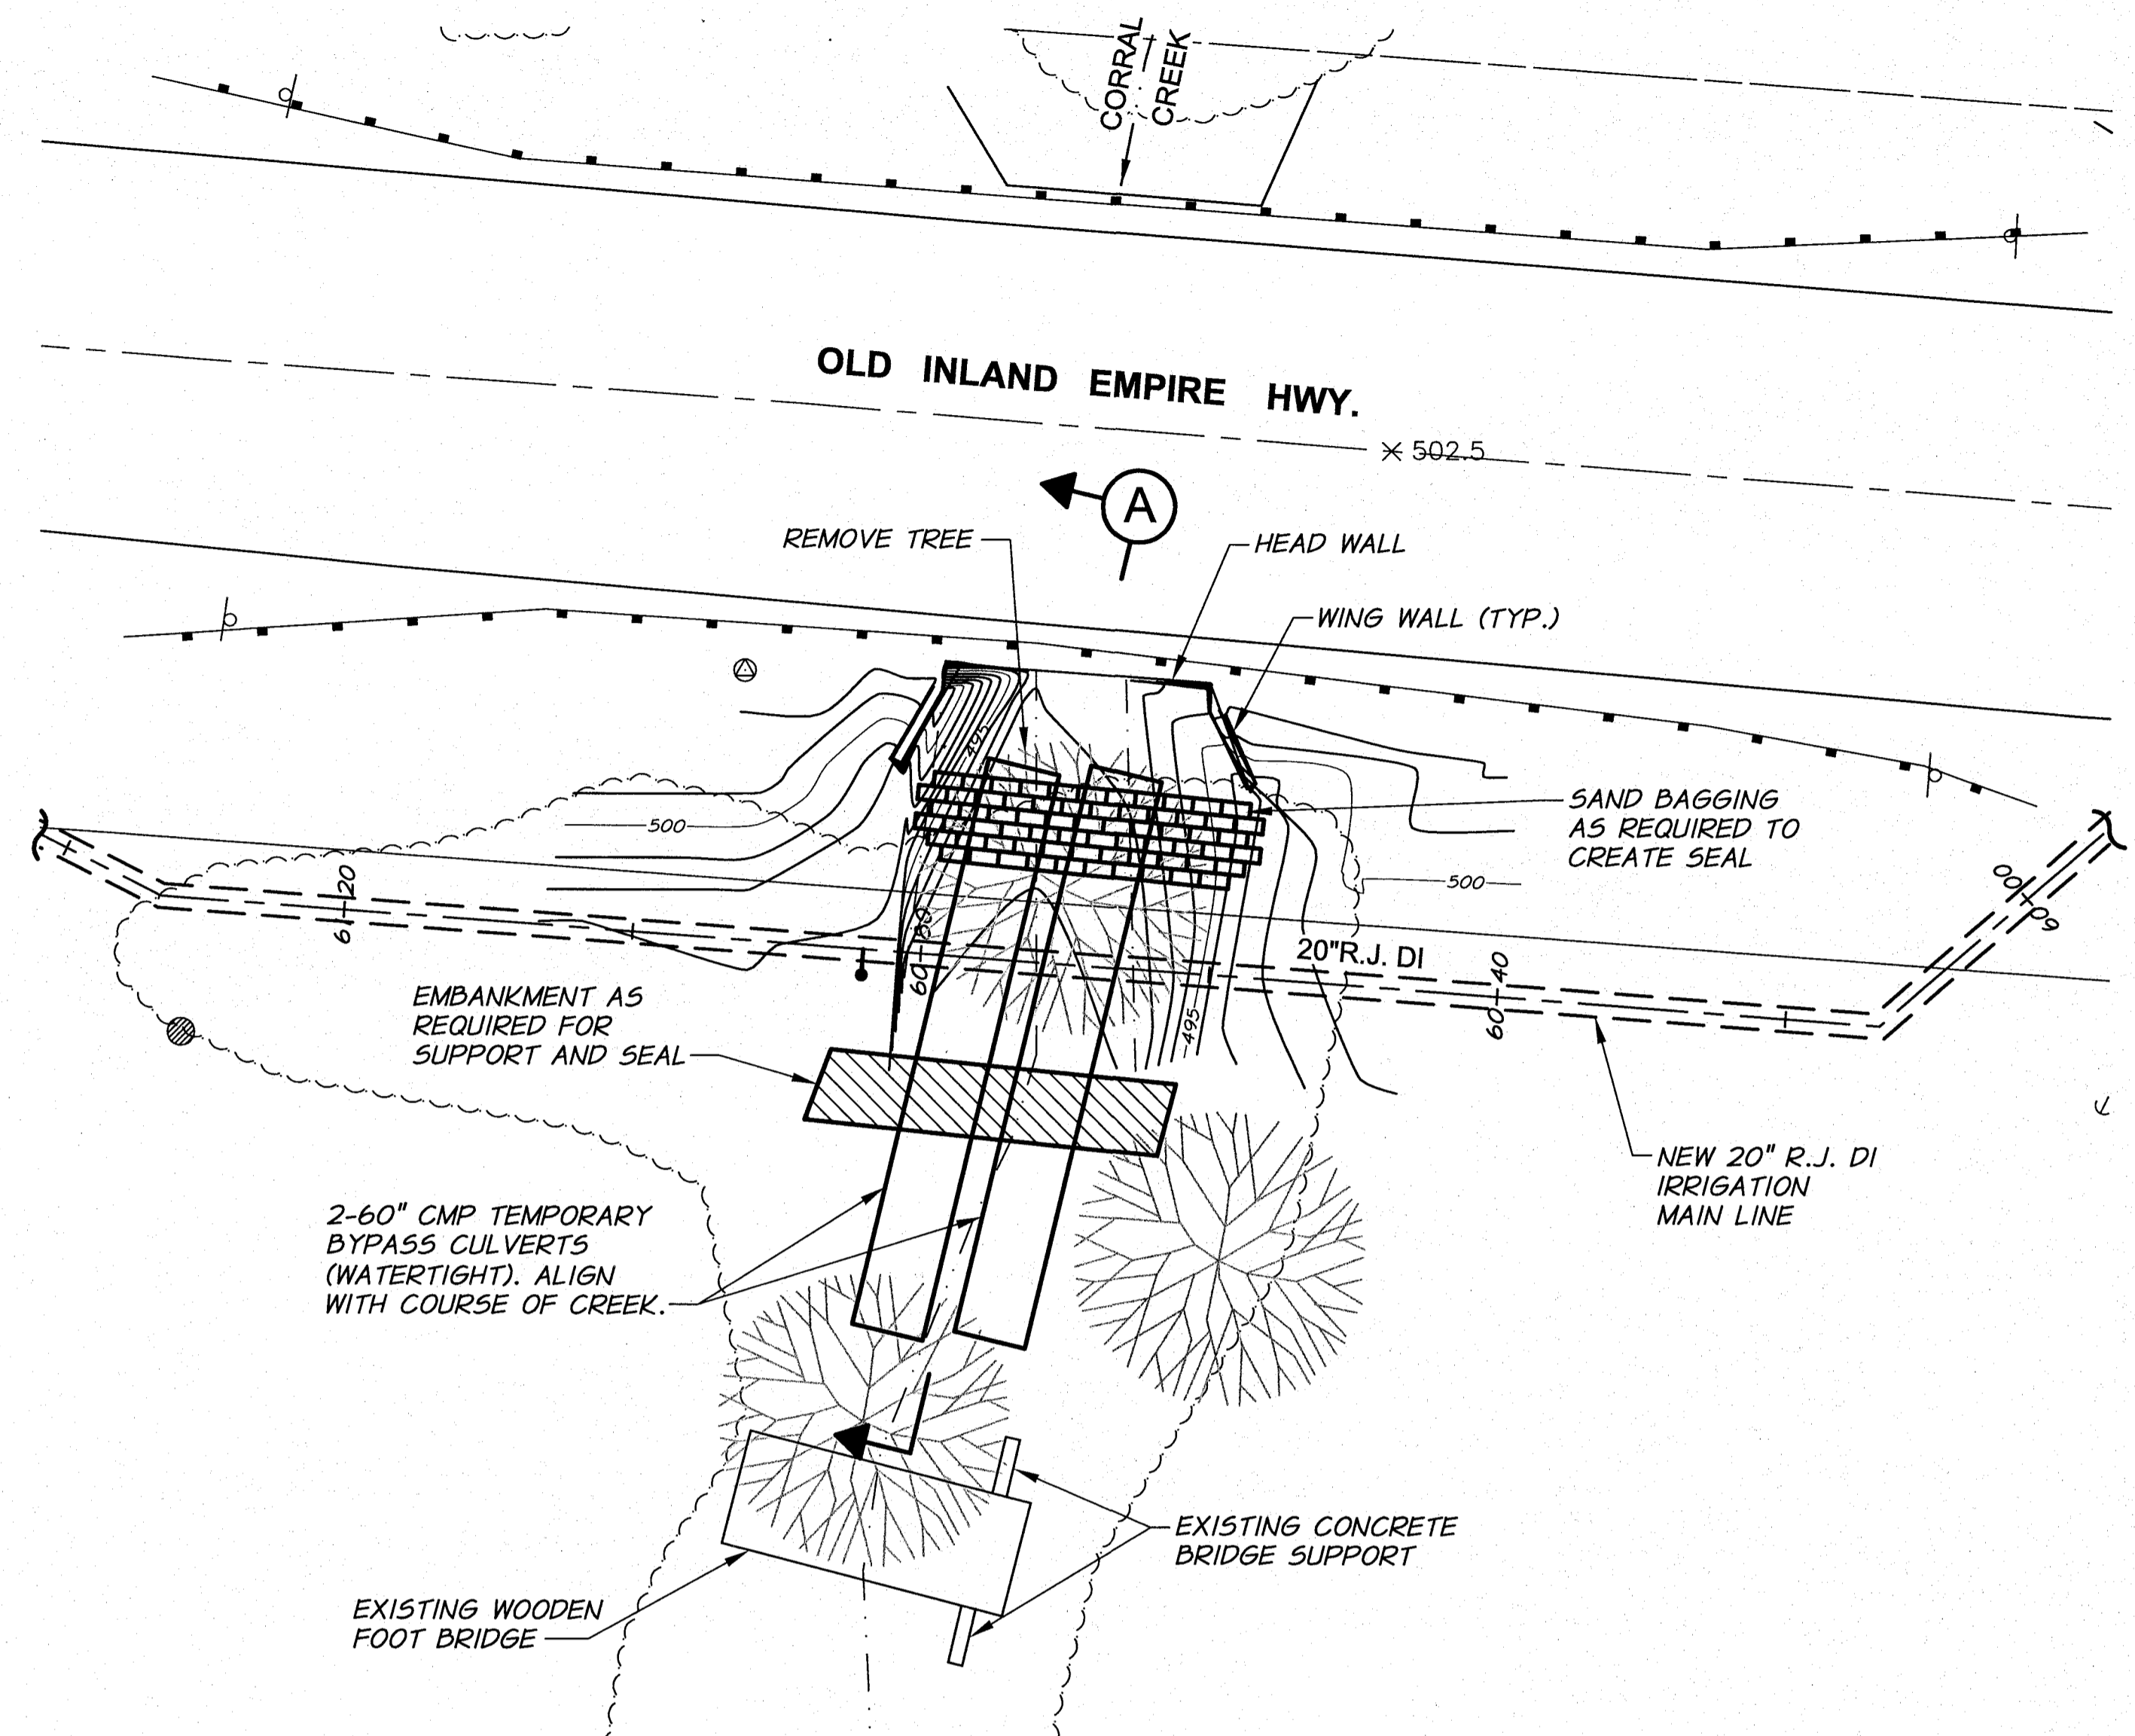


PLAN
1"=10'

GENERAL CONSTRUCTION SEQUENCE


1. PERFORM CROSSING OF CORRAL CREEK DURING AUGUST / SEPTEMBER.
2. CLEAR AND GRUB PRIOR TO INSTALLING CULVERTS, SAND BAGGING, AND EMBANKMENT.
3. PLACE 2-60" CMP CULVERTS AND SAND BAGGING TO DIRECT CREEK FLOW INTO THE CULVERTS AND TO SEAL THE CREEK FLOW FROM THE AREA OF EXCAVATION. PROVIDE EMBANKMENT FOR ADDITIONAL SEAL AND SUPPORT.
4. EXCAVATE TRENCH AND PROVIDE DEWATERING OF THE TRENCH AS REQUIRED. WATER FROM DEWATERING SHALL BE FILTERED THROUGH A GEOTEXTILE FILTER BAG PRIOR TO DISCHARGING INTO THE CREEK.
5. PLACE GEOTEXTILE FABRIC AND DRAIN ROCK PIPE BEDDING.
6. INSTALL RESTRAINED JOINT PIPE AND BACKFILL WITH DRAIN ROCK.
7. OVERLAP GEOTEXTILE FABRIC TO ENCASE BACKFILLED PIPE.
8. PLACE 30" OF 6"-Ø RIVER RUN ROCK.
9. REMOVE TEMPORARY BYPASS AND RESTORE THE SITE AS REQUIRED BY THE ENGINEER.
10. HYDROSEED DISTURBED CREEK BANKS AND DISTURBED AREAS OUTSIDE OF BANKS.
11. RE-VEGETATION OF CORRAL CREEK BY OTHERS.

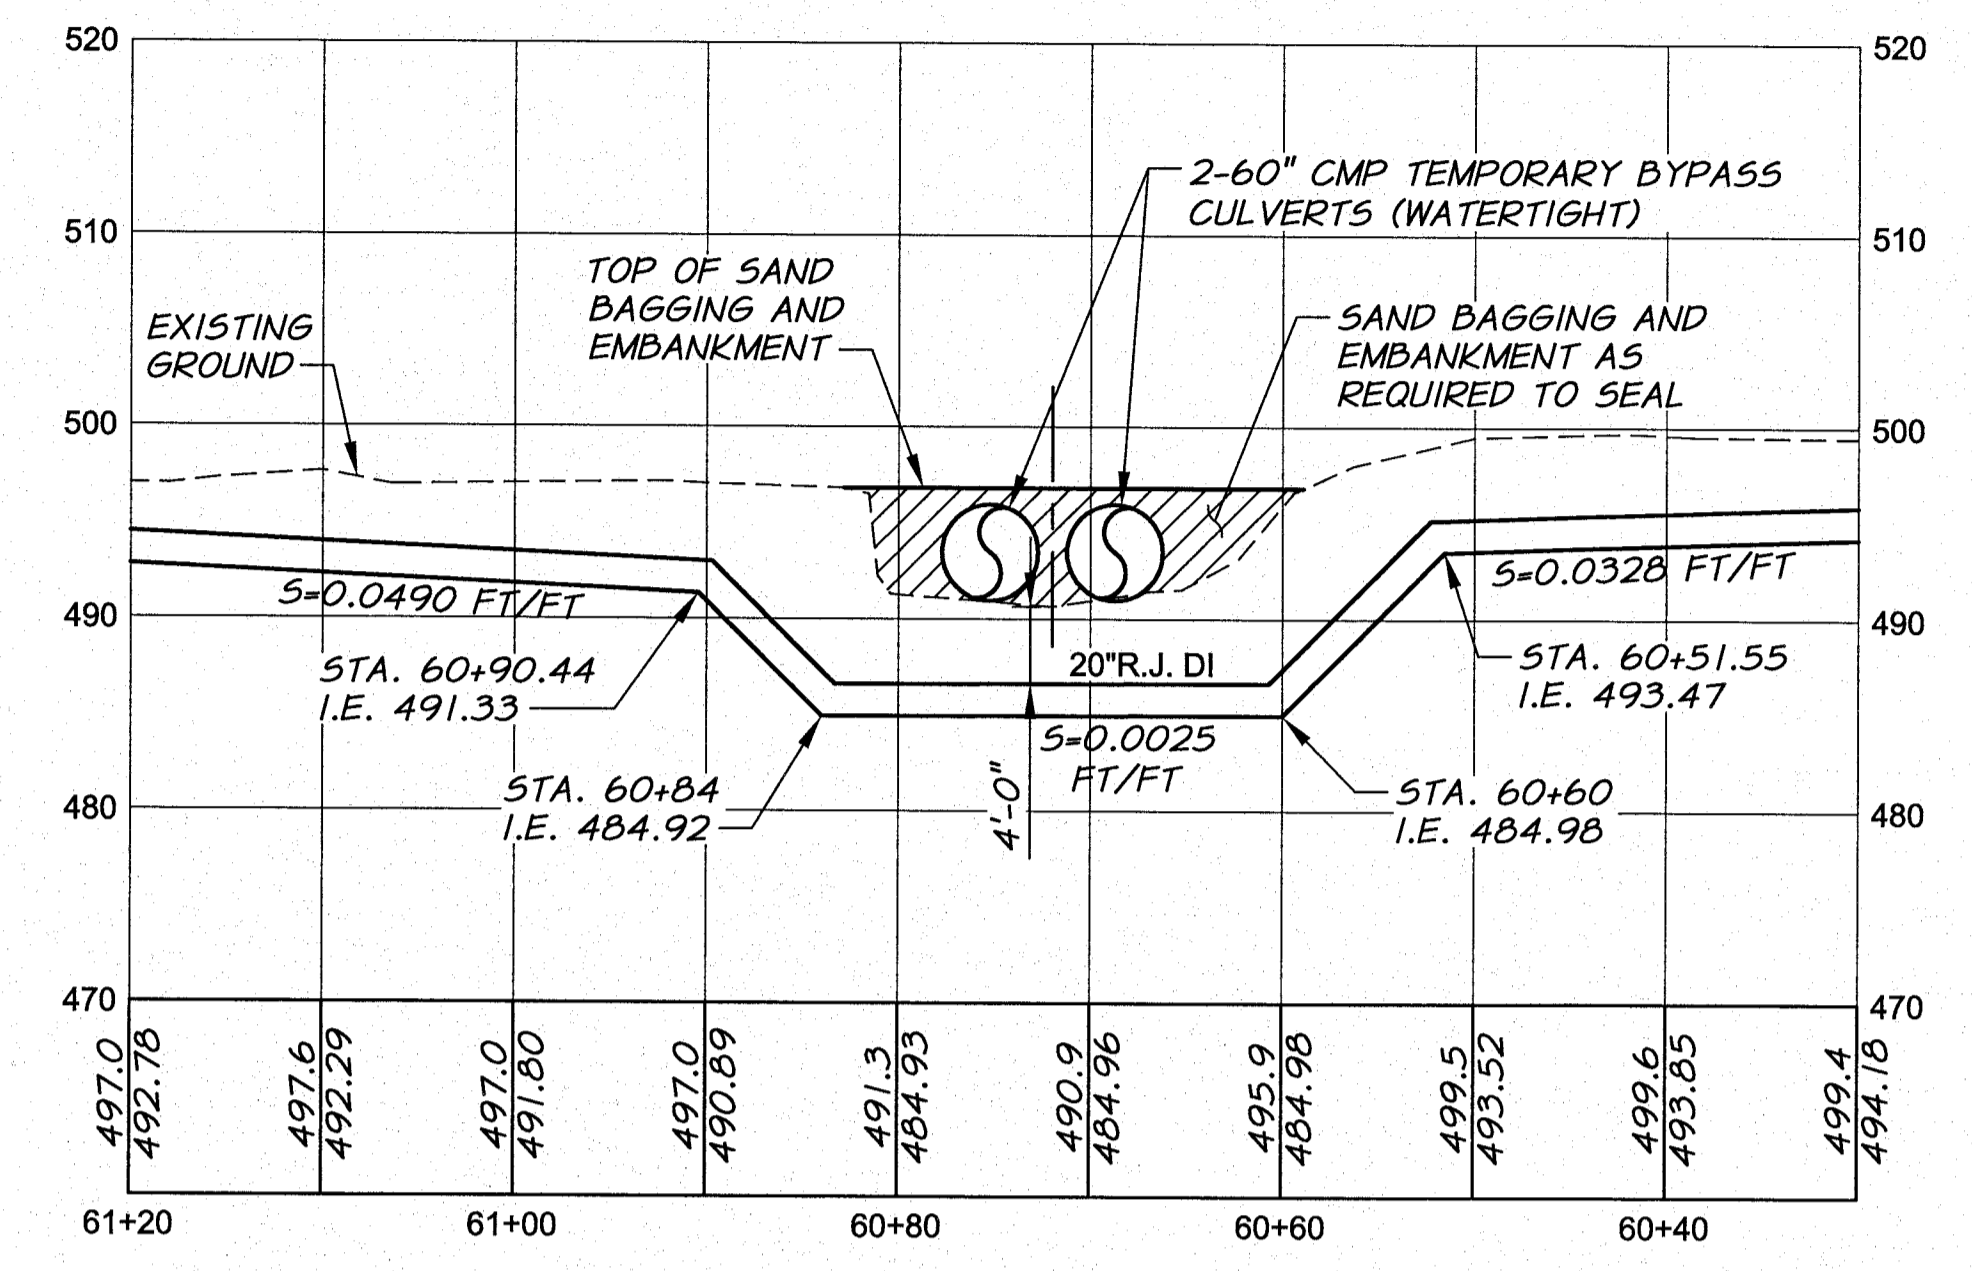

20" R.J. DI PIPE PROFILE
1"=10'

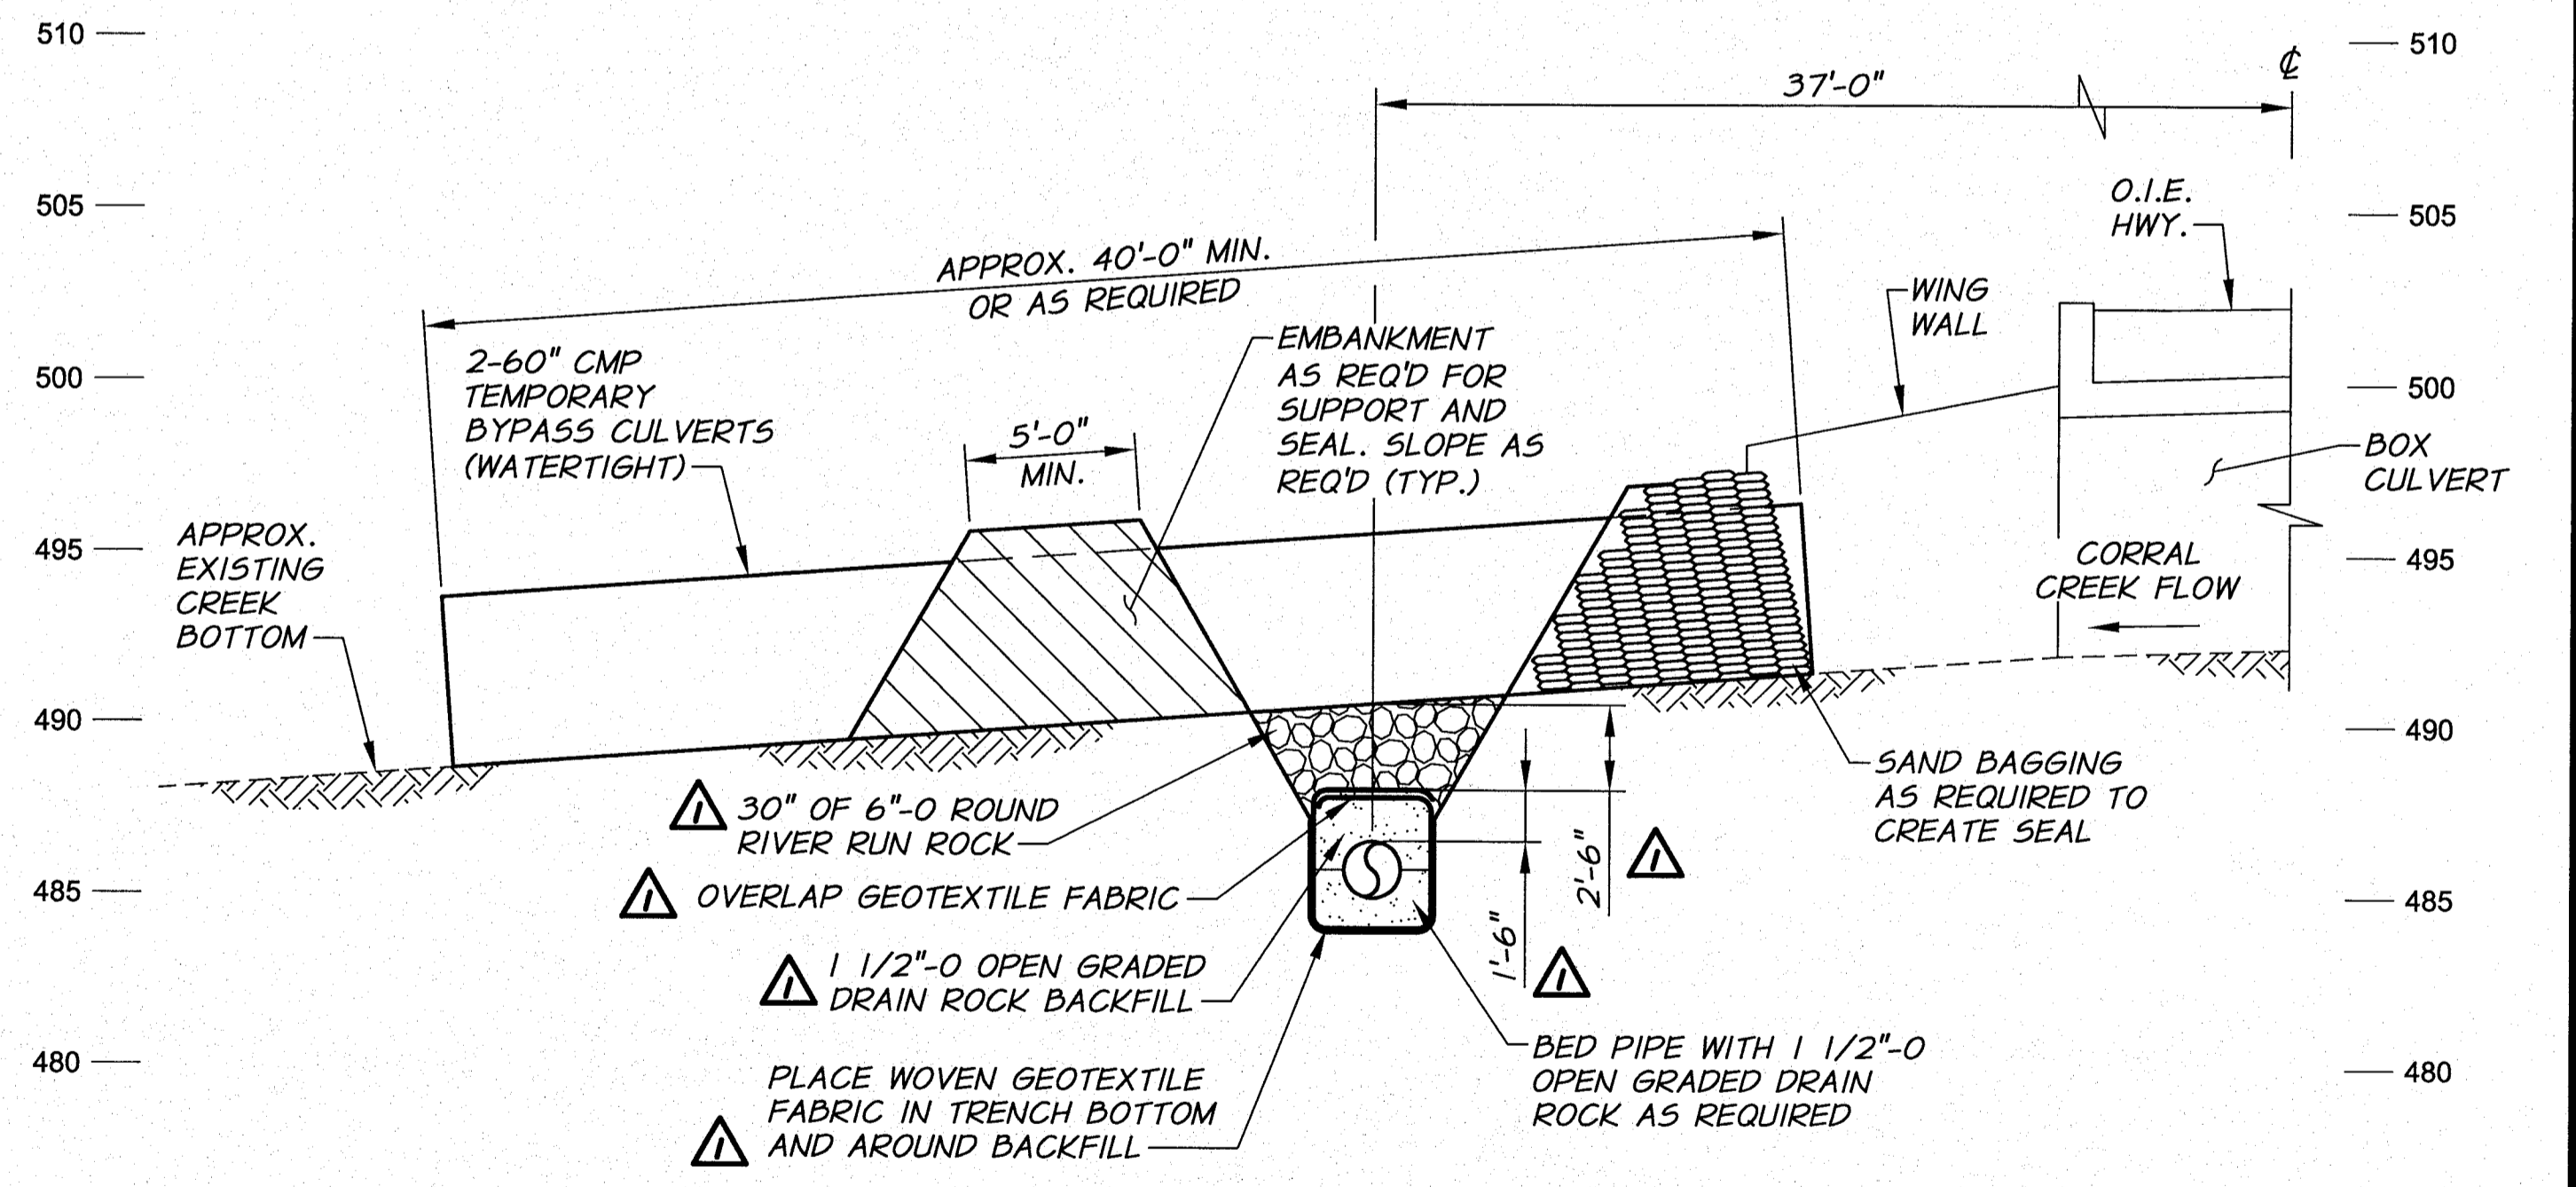


SECTION A
CORRAL CREEK TEMPORARY BYPASS
1"=5'

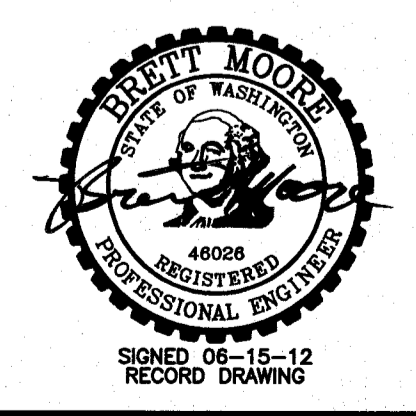

RECORD DRAWING		E.H. 12/11	
DESIGNED BY	R. HARRIS	DATE	12/11
DRAWN BY	D. CHRISTMAN	JOB NUMBER	1199-336
REVIEWED BY	H. PERRY	ACAD FILE	OIE-CulvertDetail.dwg
COPYRIGHT 2009 BY ANDERSON-PERRY & ASSOC., INC.			


RECORD DRAWINGS
These record drawings have been prepared, in part, on the basis of information compiled and furnished by others. They may contain some discrepancies and omissions, and do not necessarily represent "exact" field conditions. The Owner and the Engineer accept no responsibility for their accuracy.

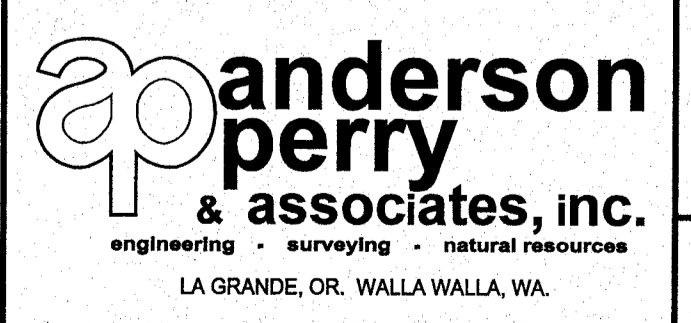

BENTON IRRIGATION DISTRICT
IRRIGATION SYSTEM IMPROVEMENTS
PHASE I
CORRAL CREEK CROSSING DETAILS


ADDITIVE ALTERNATIVE A
SHEET
126

THE TOP 18" OF TOPSOIL IN THE EXCAVATION AREA SHALL BE REMOVED AND STOCKPILED AT A SEPARATE LOCATION FROM GENERAL TRENCH EXCAVATION. THIS TOPSOIL SHALL NOT BE MIXED OR CONTAMINATED WITH ANY OTHER MATERIAL. UPON COMPLETION OF THE TRENCH BACKFILL, AND AFTER ALL ROCKS AND UNSUITABLE MATERIAL HAVE BEEN REMOVED FROM WORK AREA, THE TOPSOIL SHALL BE REPLACED AND GRADED TO MATCH EXISTING GROUND. THE DISTURBED AREA SHALL THEN BE HYDROSEED ACCORDING TO HYDROSEED RESTORATION.

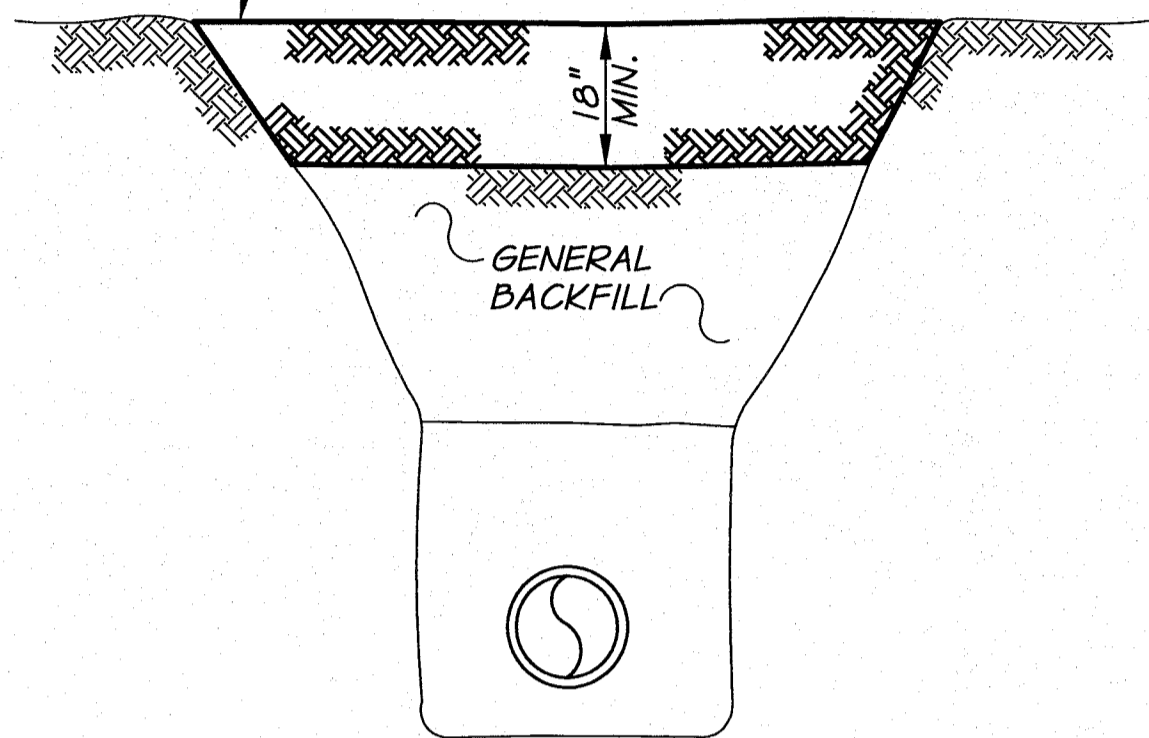


TRENCH RESTORATION
AGRICULTURAL AREAS
N.T.S.

REMOVE DEBRIS AND ROCK WHICH ARE NOT TYPICAL TO THE AREA. REPLACE TOPSOIL EQUAL TO EXISTING OR 6" WHICH EVER IS GREATER. RAKE AND SHAPE TO MATCH EXISTING. HYDROSEED PER HYDROSEED RESTORATION.

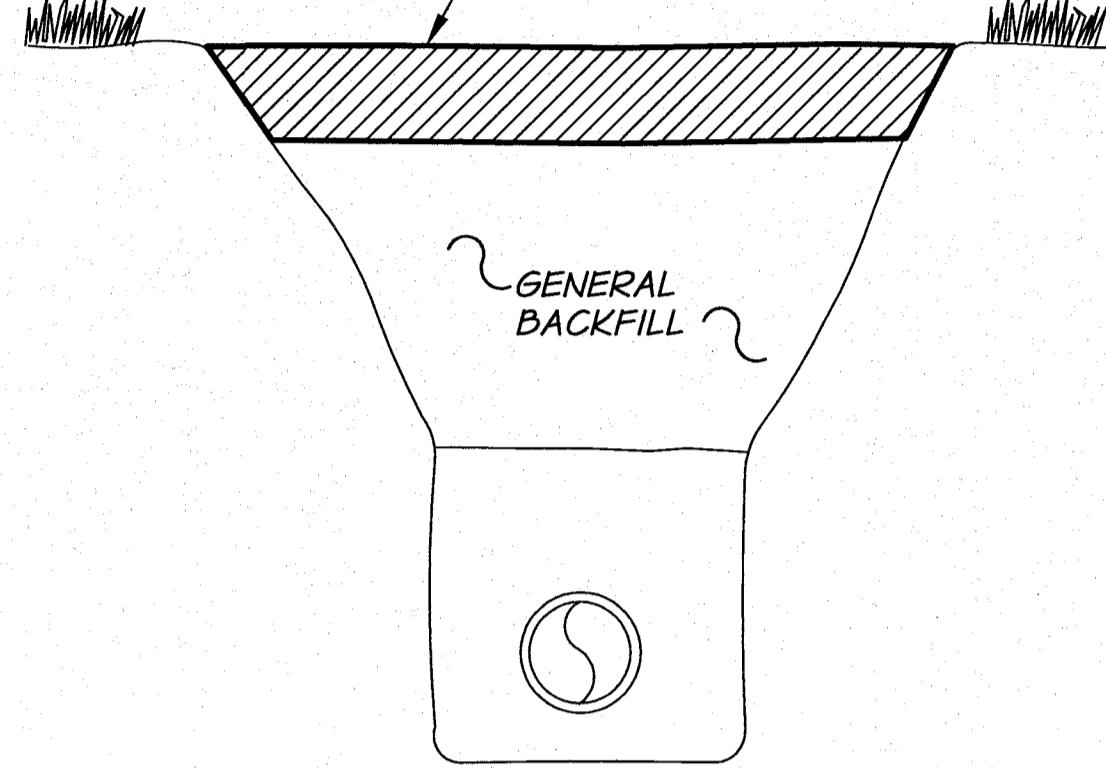


TRENCH RESTORATION
LAWNS & LANDSCAPED AREAS
N.T.S.

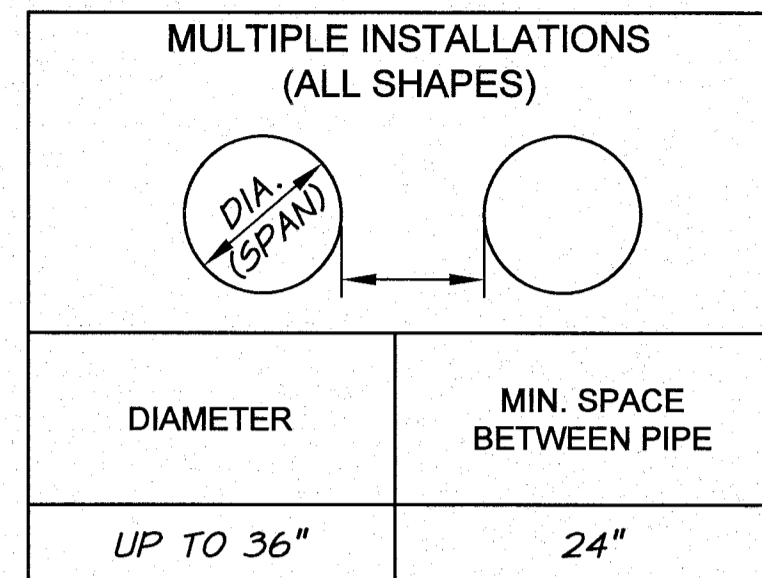


NOTES
1. SURFACING OF PAVED AREAS SHALL COMPLY WITH STREET CUT STANDARD DRAWING.

TRENCH BACKFILL AND BEDDING TABLE			
	ASPHALT SURFACE RESTORATION	GRAVEL STREETS, ROADWAYS, SHOULDERS AND PARKING AREAS	HYDROSEED RESTORATION AND NATURAL AREAS
SURFACE	SURFACING MATCHING EXISTING	3/4"-0 GRAVEL AGGREGATE (FOR THICKNESS SEE DETAIL THIS SHEET)	TOPSOIL OR AS DIRECTED
BASE MATERIAL UNDER SURFACE	3/4"-0 BASE ROCK	GENERAL BACKFILL	TOPSOIL OR AS DIRECTED
GENERAL BACKFILL	3/4"-0 BASE ROCK	GENERAL BACKFILL	GENERAL BACKFILL
SELECT BACKFILL	3/4"-0 BASE ROCK	*3/4"-0 BASE ROCK OR NATIVE	*3/4"-0 BASE ROCK OR NATIVE
BEDDING	3/4"-0 BASE ROCK	*3/4"-0 BASE ROCK OR NATIVE	*3/4"-0 BASE ROCK OR NATIVE


*SEE THE SPECIFICATION FOR USE OF NATIVE SOILS IN LUE OF 3/4"-0 BASE ROCK

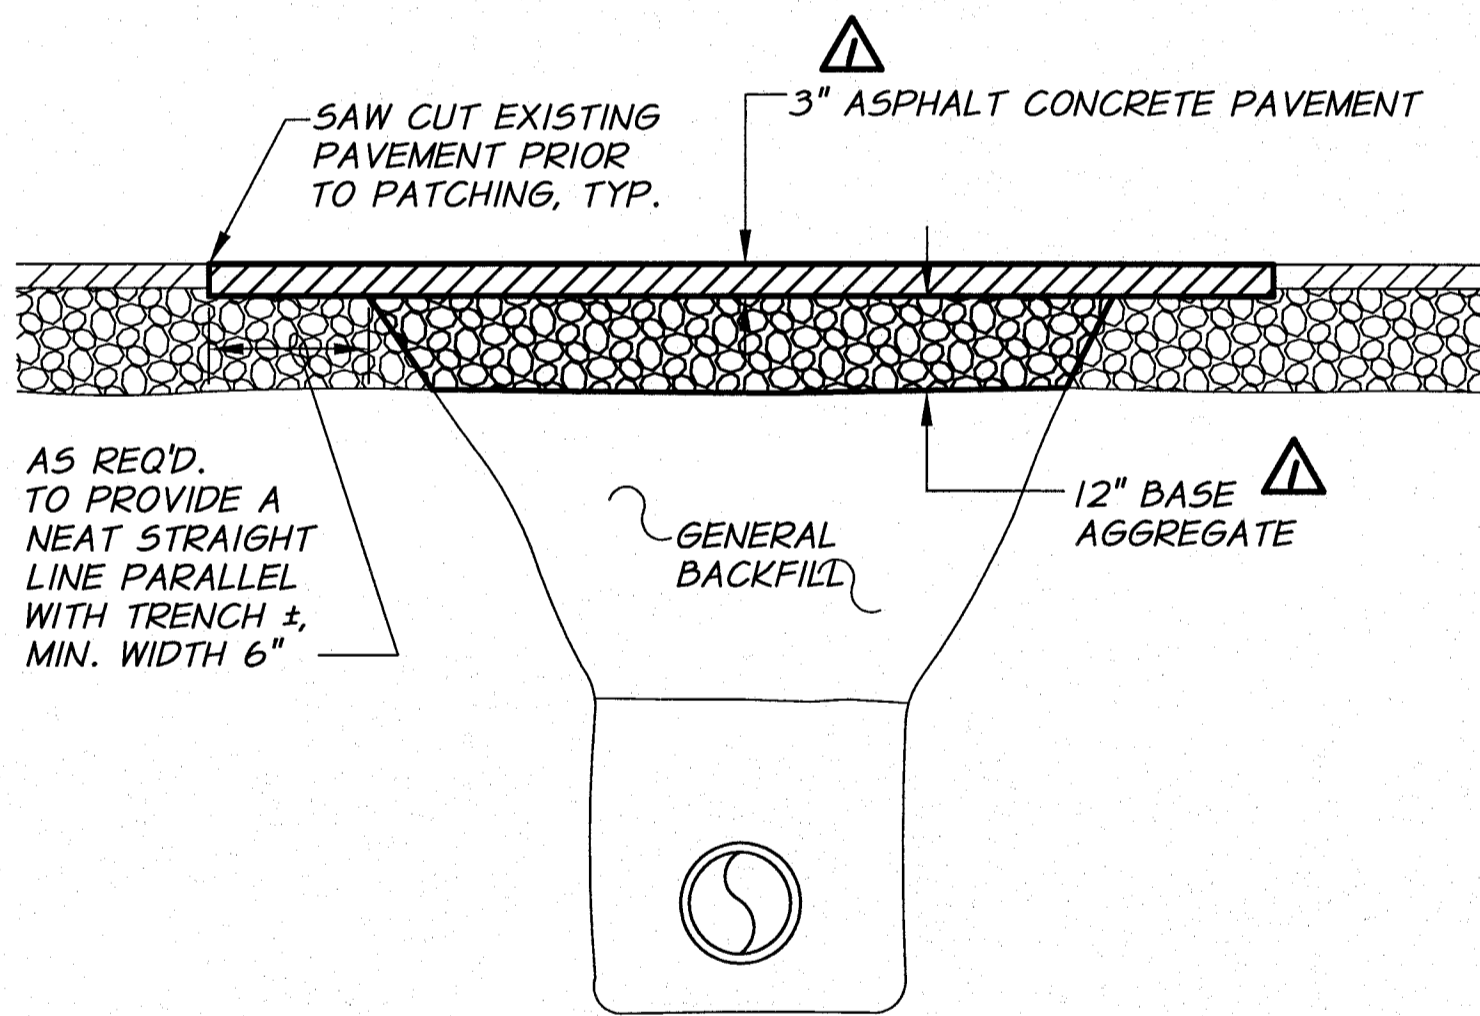


TRENCH RESTORATION
PAVED STREETS AND ROADWAYS
("ASPHALT SURFACE RESTORATION" PAY ITEM)

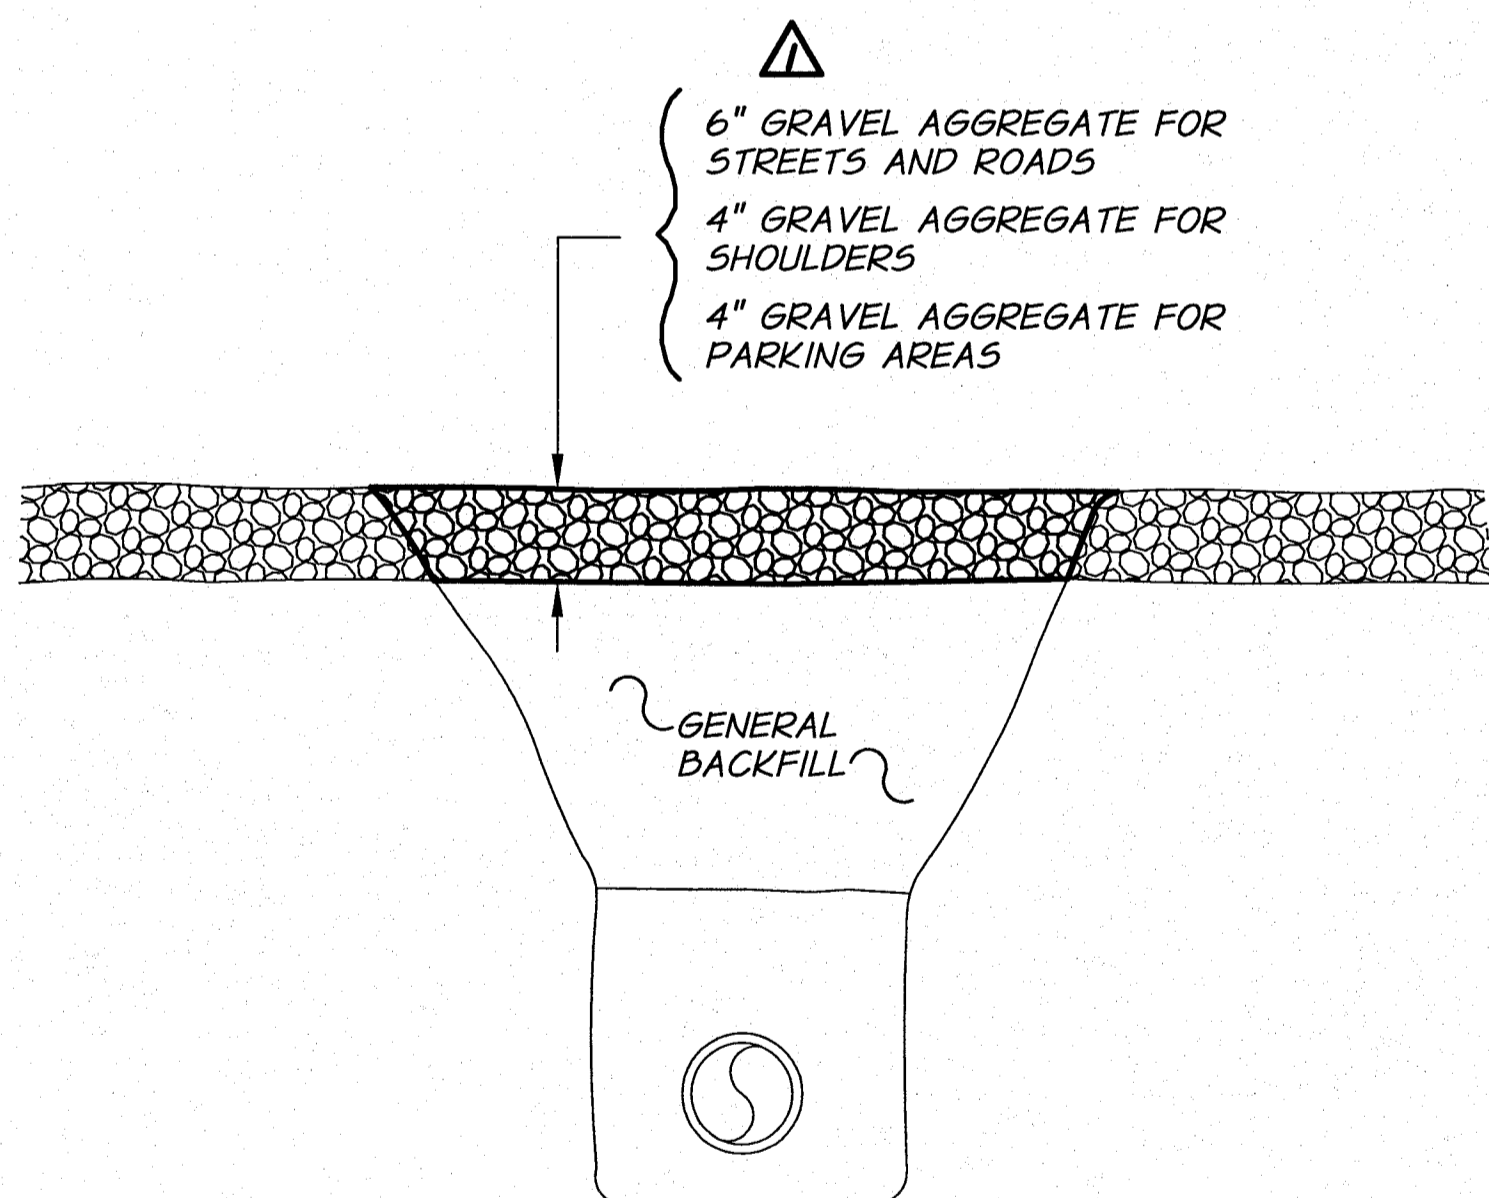

TRENCH RESTORATION
GRAVEL STREETS, ROADWAYS, SHOULDERS, AND PARKING AREAS
("GRAVEL SURFACE RESTORATION" PAY ITEM)
N.T.S.

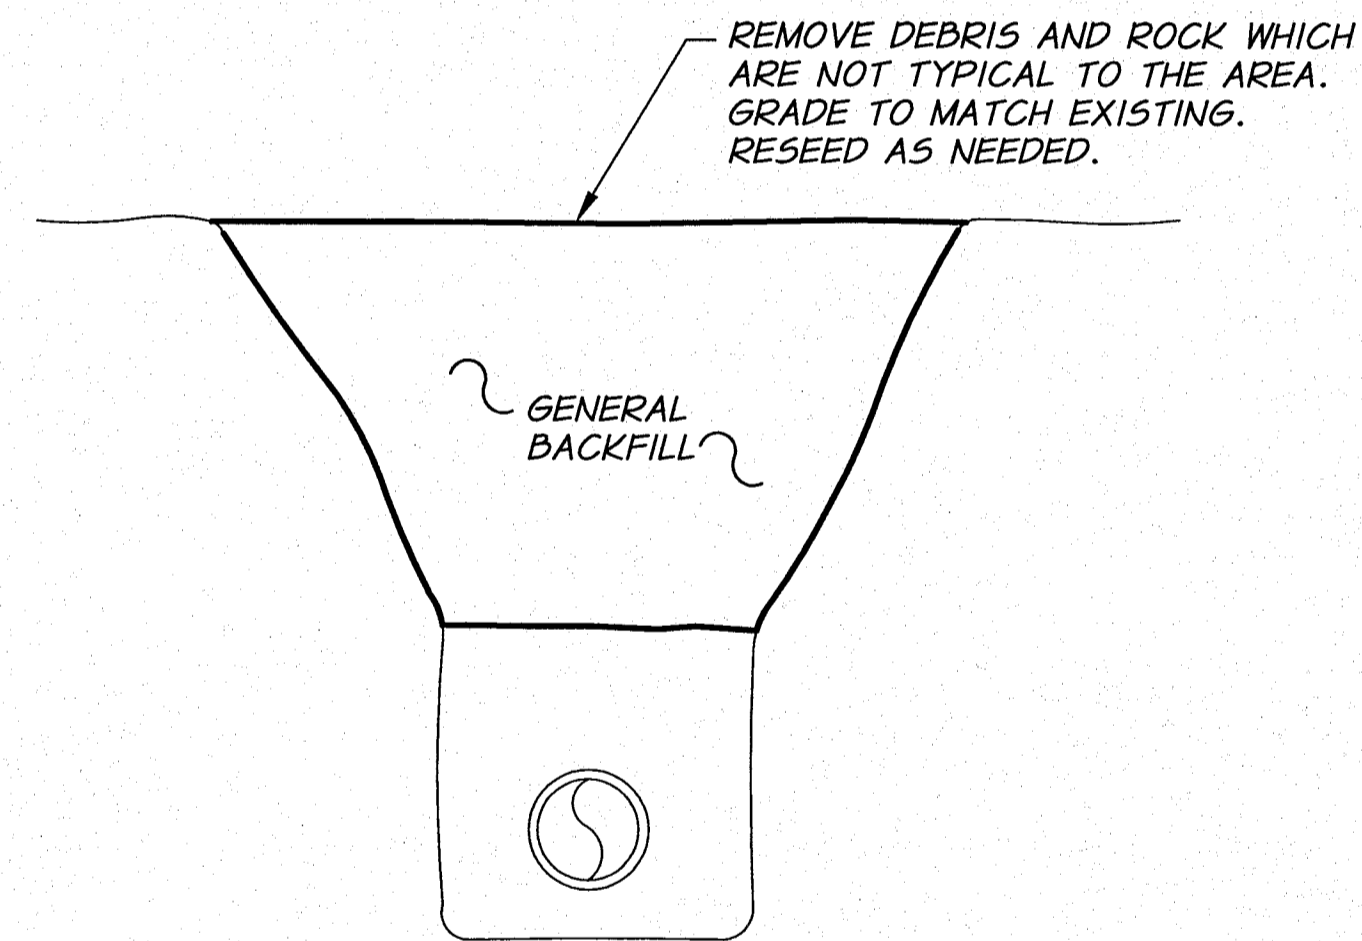

TRENCH RESTORATION
NATURAL AREAS
N.T.S.

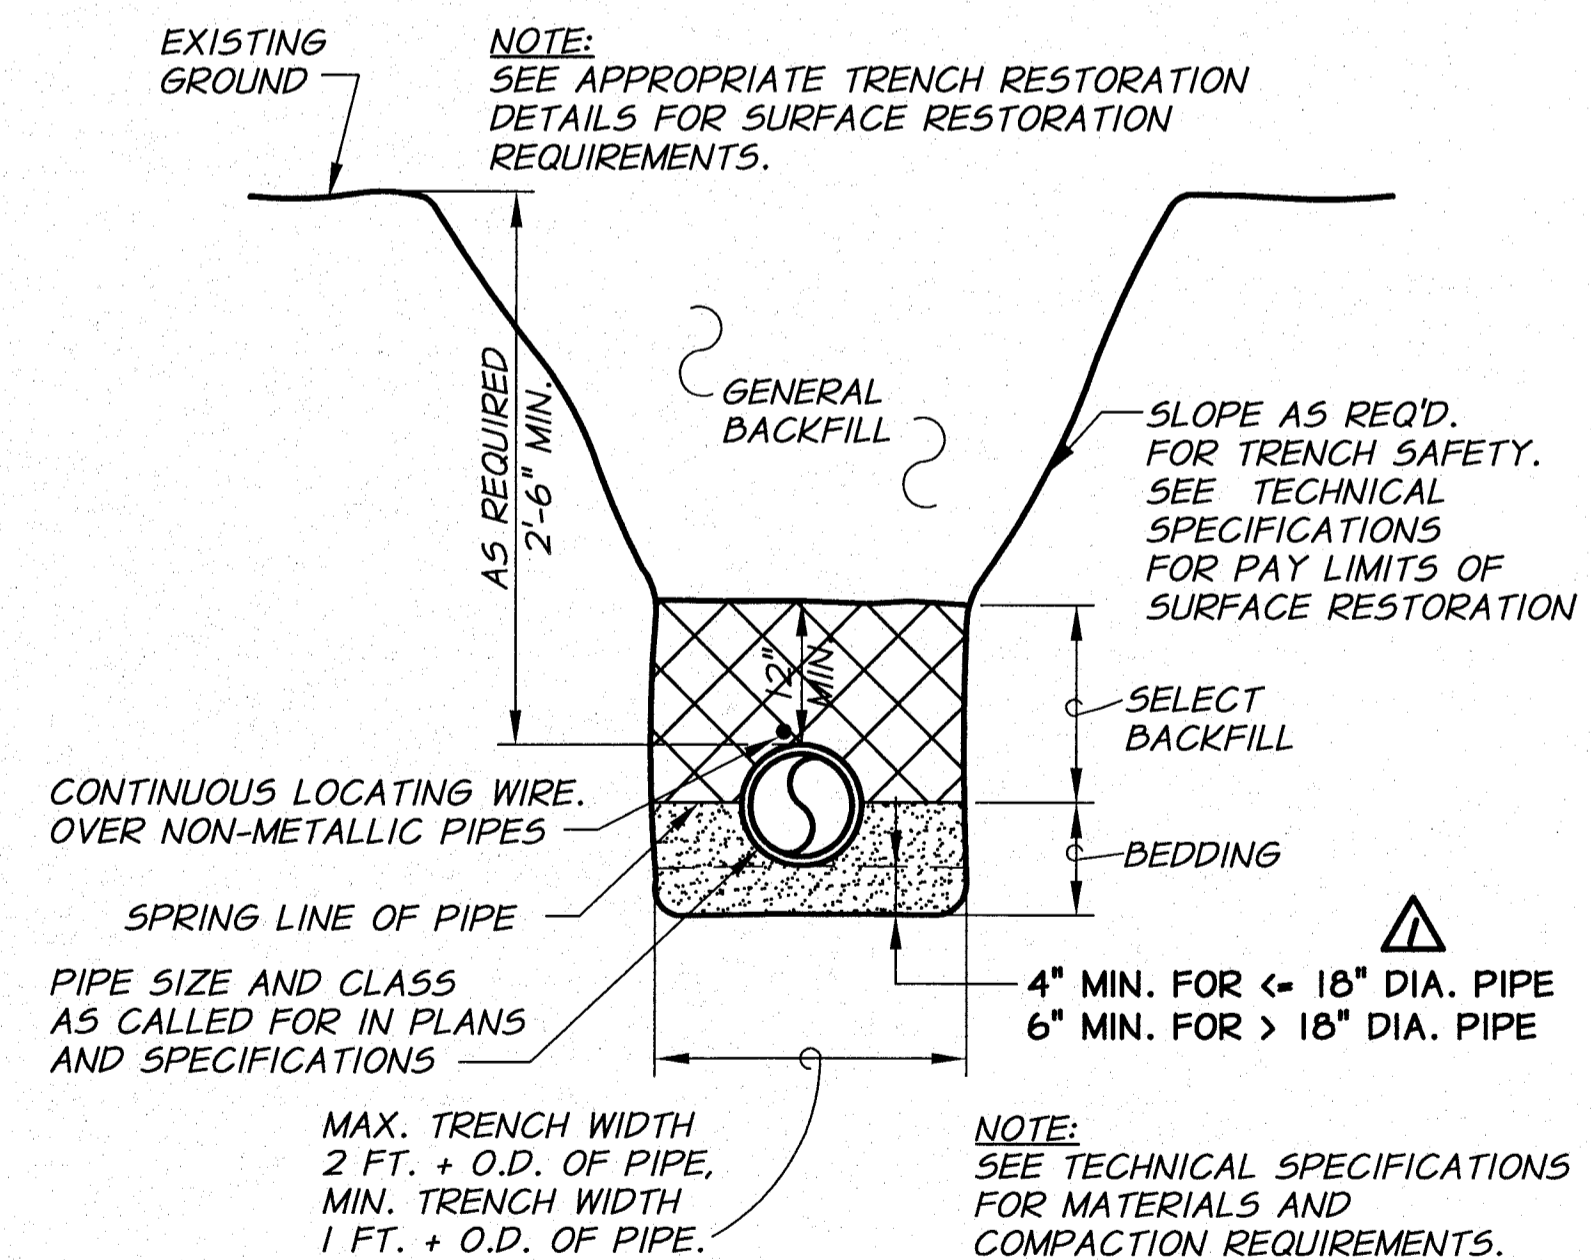


TRENCH EXCAVATION AND BACKFILL
N.T.S.



RECORD DRAWING		BY	E.H.	DATE	12/11
DESIGNED BY	R. HARRIS	XREFS:	TB-BID.dwg		
DRAWN BY	D. CHRISTMAN	JOB NUMBER	1199-336		
REVIEWED BY	H. PERRY	ACAD FILE	TrenchDets.dwg		
COPYRIGHT 2009 BY ANDERSON-PERRY & ASSOC., INC.					

RECORD DRAWINGS
These record drawings have been prepared, in part, on the basis of information compiled and furnished by others. They may contain some discrepancies and omissions, and do not necessarily represent "exact" field conditions. The Owner and the Engineer accept no responsibility for their accuracy.

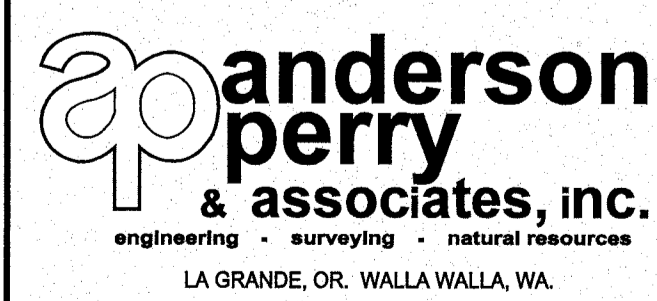

BENTON IRRIGATION DISTRICT
IRRIGATION SYSTEM IMPROVEMENTS
PHASE I
TRENCH DETAILS

SHEET
127

THRUST BLOCK NOTES

- THRUST BLOCKS SHALL BE REQUIRED AT THE FOLLOWING LOCATIONS:
 - ALL CHANGES IN DIRECTION.
 - ALL DEAD-ENDS.
 - ALL VALVES 8-INCHES AND LARGER SHALL BE SIZE FOR CLOSED CONDITION EXCEPTIONS:
 - WHEN RESTRAINED JOINT PIPE IS USED ON BOTH SIDES OF VALVE.
 - WHEN VALVE IS RESTRAINED JOINT CONNECTED TO A FITTING WHICH HAS APPROPRIATE THRUST BLOCKING.
 - AT LOCATIONS SPECIFICALLY CALLED OUT ON THE DRAWINGS.
 - AT TEMPORARY DEAD ENDS DURING PIPE INSTALLATIONS AS REQUIRED FOR TEMPORARY PRESSURE TESTING.
 - AT OTHER LOCATIONS REQUIRED BY THE ENGINEER.
- THRUST BLOCKS SHALL BE SIZED AS REQUIRED BY SOIL CONDITIONS AND DESIGN PRESSURE.
- PLACE CONCRETE AGAINST UNDISTURBED TRENCH WALL.
- CONCRETE SHALL BE 2,500 PSI MINIMUM.
- ALL CONCRETE SHALL BE PLACED SO THAT PIPE, FITTING JOINTS, BOLTS AND NUTS, ETC., WILL BE ACCESSIBLE FOR REPAIRS.
- PLACE ONE LAYER OF VISQUEEN BETWEEN FITTING AND CONCRETE TO FACILITATE FUTURE REMOVAL OF THRUST BLOCK IF REQUIRED.
- ANCHOR RODS SHALL BE 3/4" DIAMETER GALVANIZED STEEL RODS OR #6 EPOXY COATED REINFORCEMENT BAR, AASHTO M284, HAVING AN 18" MINIMUM EMBEDMENT IN CONCRETE.
- IF THE REQUIRED BEARING AREA IS LESS THAN 1 SQUARE FOOT, A THRUST BLOCK SHALL NOT BE REQUIRED.
- ALL THRUST BLOCKS SHALL BE SIZED PER THE FOLLOWING PRESSURES UNLESS OTHERWISE NOTED:

PVC CL 125 PIPE	=	125 PSI
PVC CL 160/165 PIPE	=	160 PSI
16" AND SMALLER DI PIPE	=	160 PSI

DETERMINATION OF THRUST BLOCK BEARING AREA

NOTE: WHEN THRUST BLOCK BEARING AREA IS NOT SPECIFIED ON THE PLANS OR DETERMINED BY THE ENGINEER, THE FOLLOWING PROCEDURE SHALL BE USED TO DETERMINE REQUIRED BEARING AREA.

- DETERMINE THRUST (T) FOR TYPE OF FITTING OR JOINT AND SIZE OF PIPE FROM TABLE NO. 1 OR TABLE NO. 3.
- DETERMINE BEARING CAPACITY (B) OF SOIL FROM TABLE NO. 2.
- DETERMINE REQUIRED BEARING AREA (A) AS FOLLOWS:
 $A = T - B$
 EXAMPLE: DESIGN PRESSURE = 175 PSI
 PIPE = 12"
 FITTING = TEE
 SOIL - SANDY GRAVEL
 FROM TABLE NO. 1: T = 15,050 LB.
 FROM TABLE NO. 2: B = 3000 LB/SQ.FT.
 $A = 15,050 \div 1.75 = 8.8 \text{ SQ.FT.} = 9 \text{ SQ.FT.}$ (ROUND UP TO NEAREST 3,000 WHOLE SQ.FT.)

TABLE NO. 1
THRUST AT FITTINGS IN POUNDS AT 100 PSI OF PRESSURE

PIPE SIZE	TEES AND DEAD ENDS	90° BEND	45° BEND	22 1/2° BEND	11 1/4° BEND
4"	1,680	2,310	1,290	660	340
6"	3,770	5,320	2,890	1,480	750
8"	6,690	9,460	5,120	2,620	1,320
10"	10,440	14,780	8,010	4,090	2,050
12"	15,050	21,280	11,520	5,880	2,960
14"	20,490	28,960	15,680	8,000	4,020
16"	26,750	37,830	20,470	10,440	5,260
18"	33,850	47,870	25,910	13,210	6,640
20"	41,790	59,090	31,980	16,310	8,190
24"	60,170	85,100	46,060	23,490	11,800

NOTE: FOR WATER PRESSURES DIFFERENT THAN 100 PSI, MULTIPLY THRUST FOUND IN TABLE NO. 1 BY REQUIRED PROPORTION.
 EXAMPLE: DESIGN PRESSURE = 175 PSI.
 MULTIPLY VALUE IN TABLE BY 1.75


TABLE NO. 2

SOIL	SAFE BEARING LOAD LB/SQ.FT.
SOFT CLAY	500
SILT	1,000
SAND	2,000
SAND AND GRAVEL	3,000
SAND AND GRAVEL CEMENTED WITH CLAY	4,000
HARD CLAY	4,000

TABLE NO. 3
SIDE THRUST PER 100 LB./SQ.IN. PRESSURE PER DEGREE OF DEFLECTION


PIPE SIZE	SIDE THRUST-LB	PIPE SIZE	SIDE THRUST-LB
4"	N/A	14"	360
6"	N/A	16"	470
8"	N/A	18"	600
10"	190	20"	730
12"	270	24"	1,050

MULTIPLY THRUST BY DEGREE OF DEFLECTION TO OBTAIN TOTAL THRUST

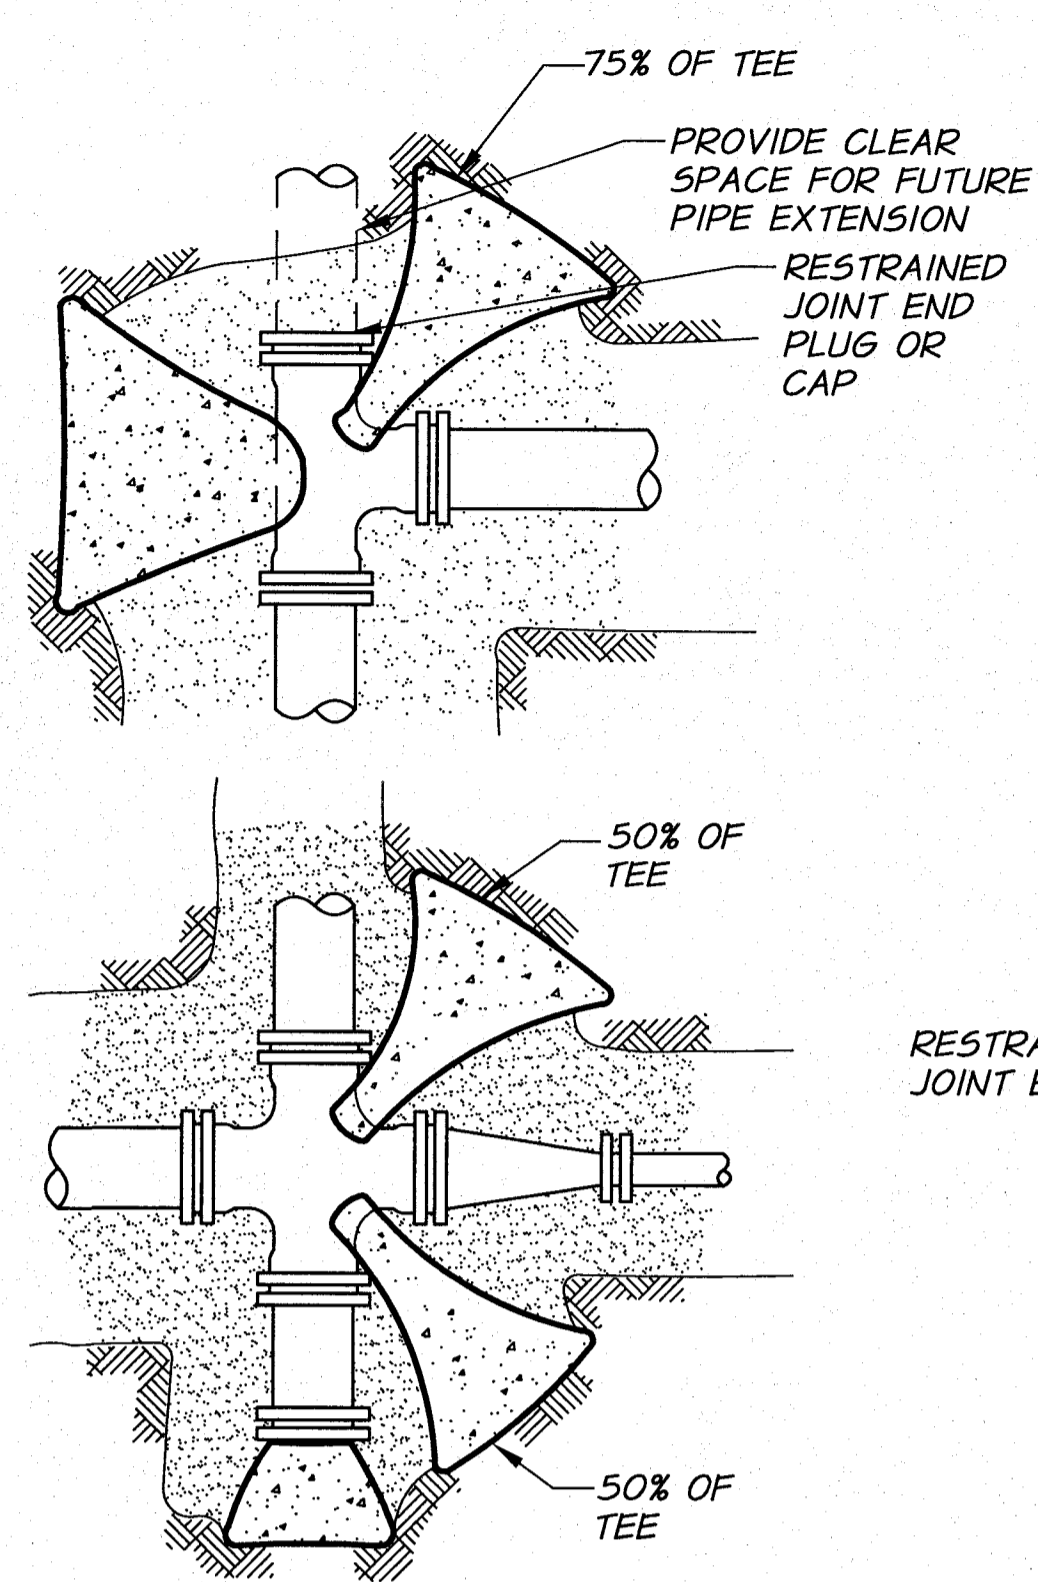



TYPICAL THRUST BLOCK LOCATIONS

PLAN VIEWS

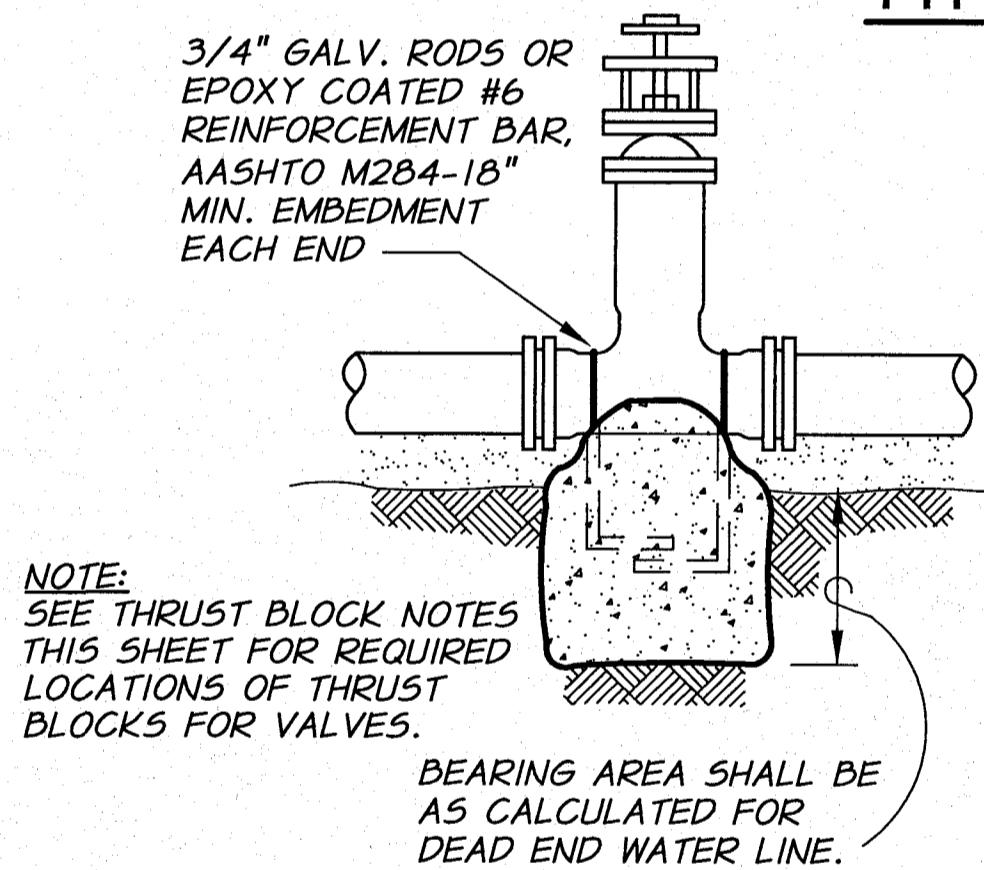


TYPICAL VALVE THRUST BLOCK


NOTE: NOT REQUIRED FOR VALVES WITH FLANGED CONNECTION TO TEE WITH THRUST BLOCK.

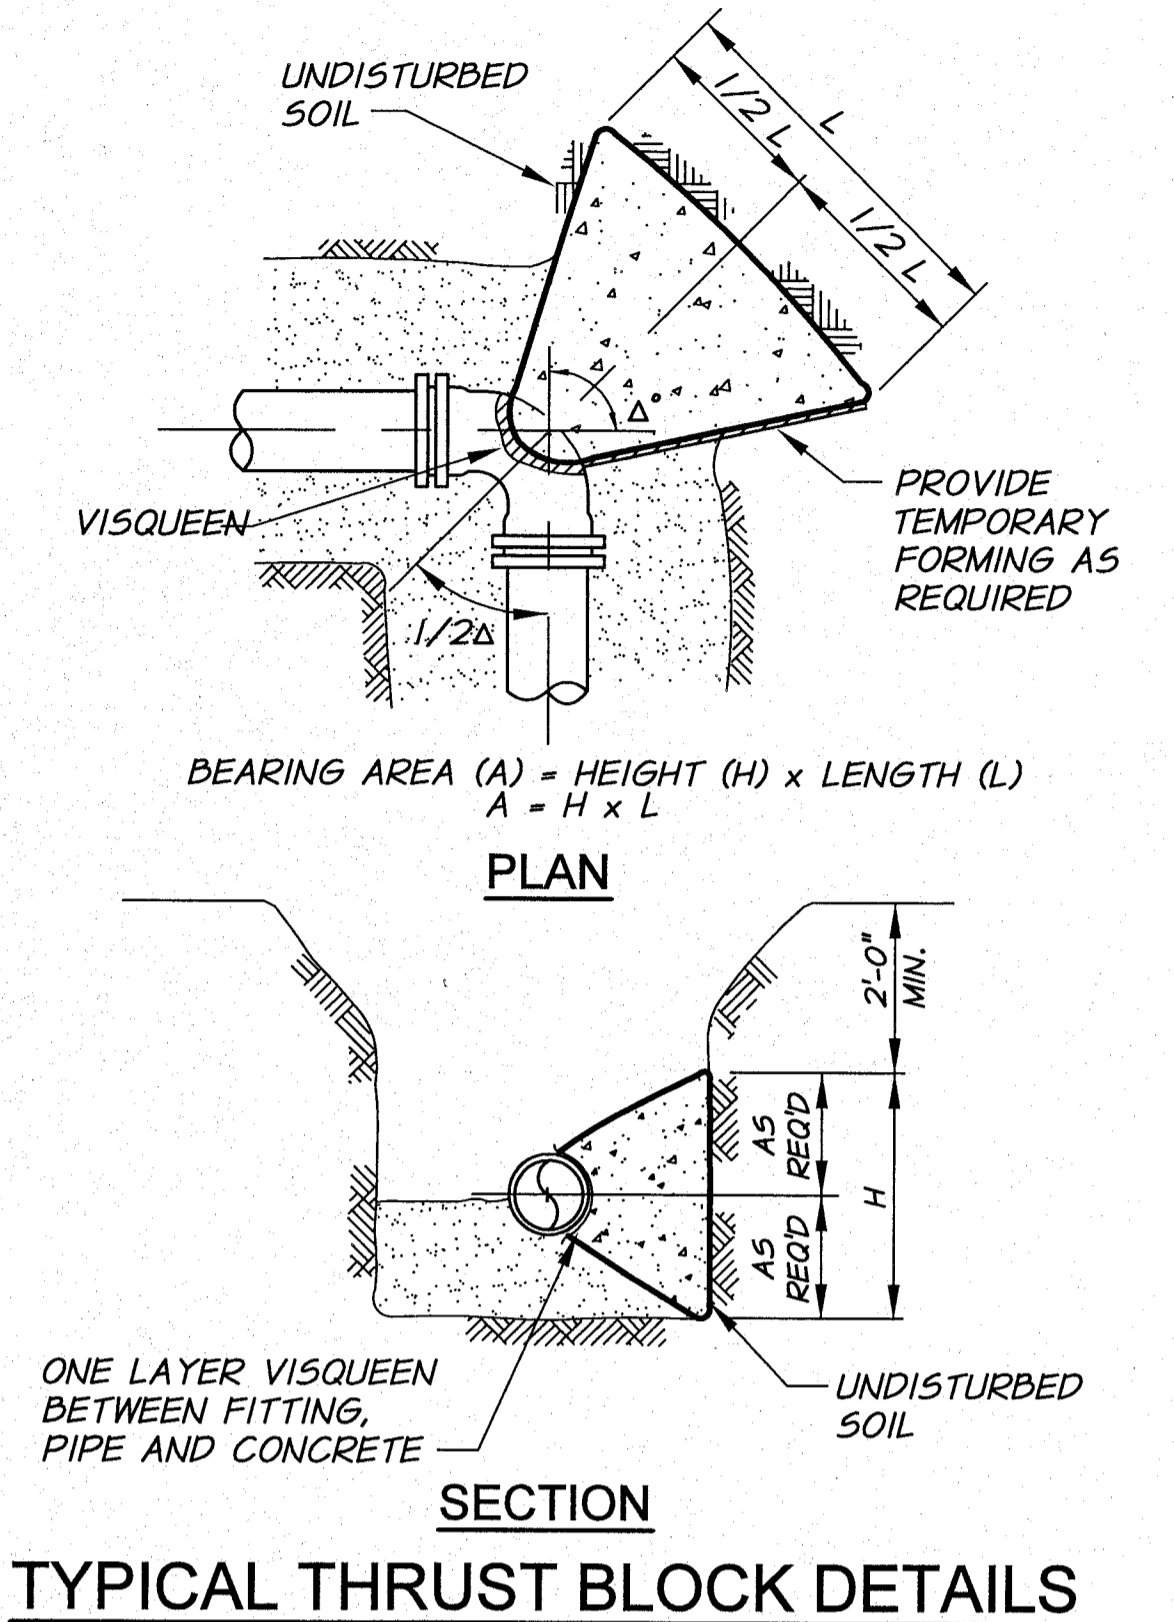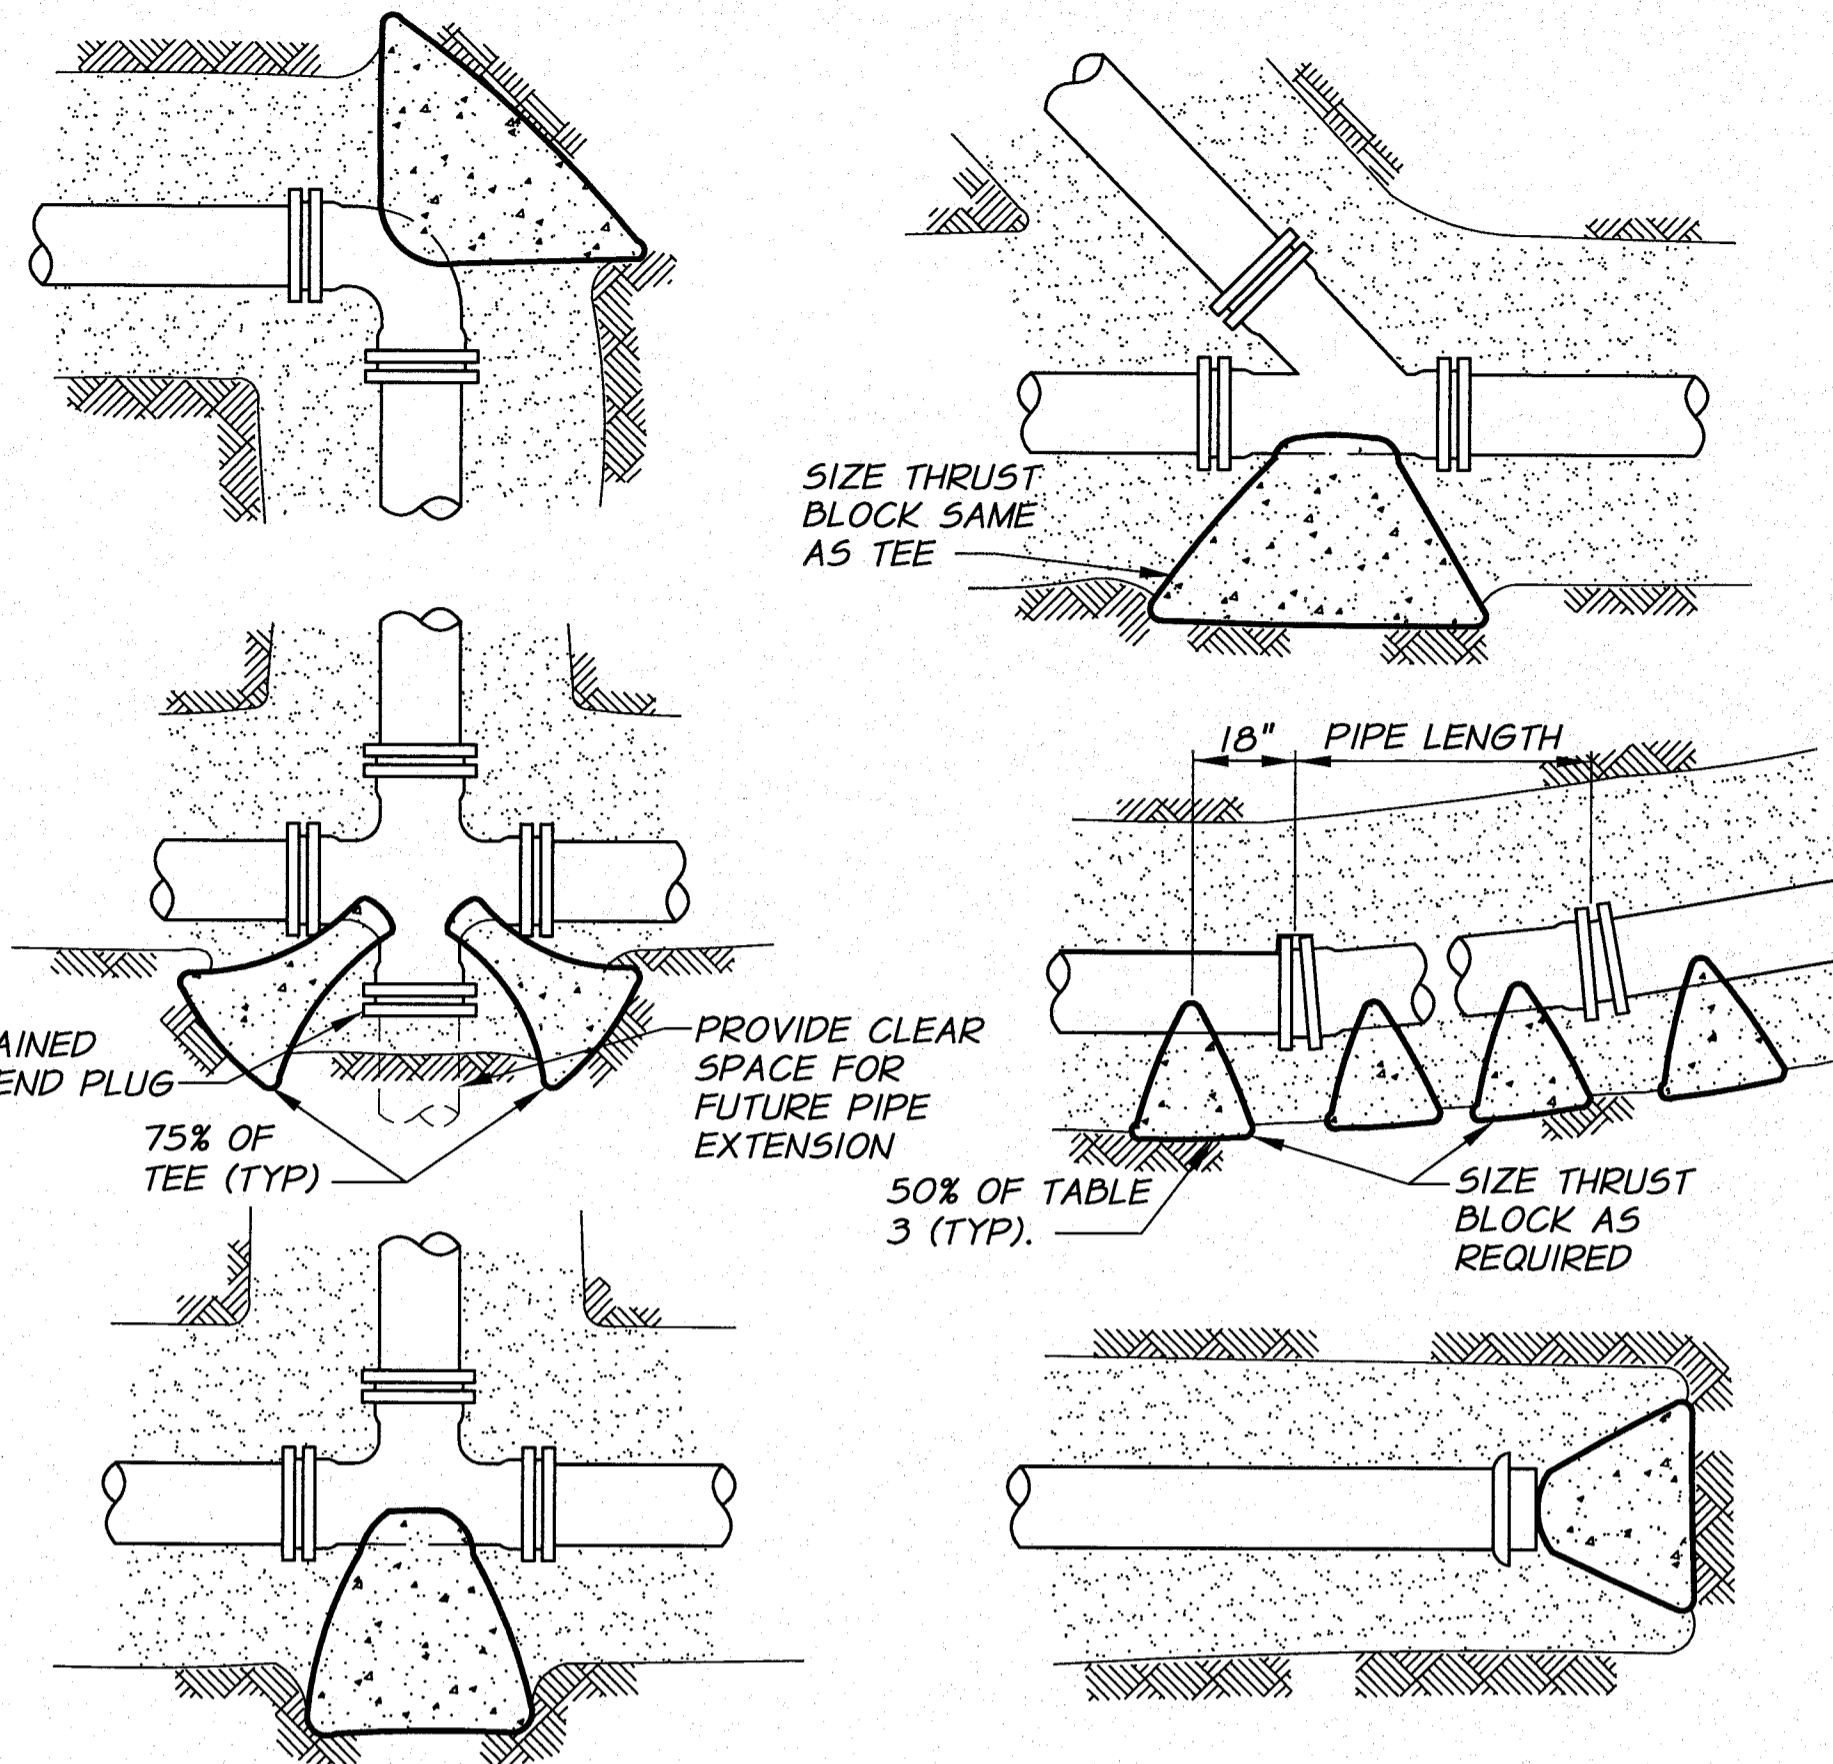

TYPICAL THRUST BLOCK DETAILS

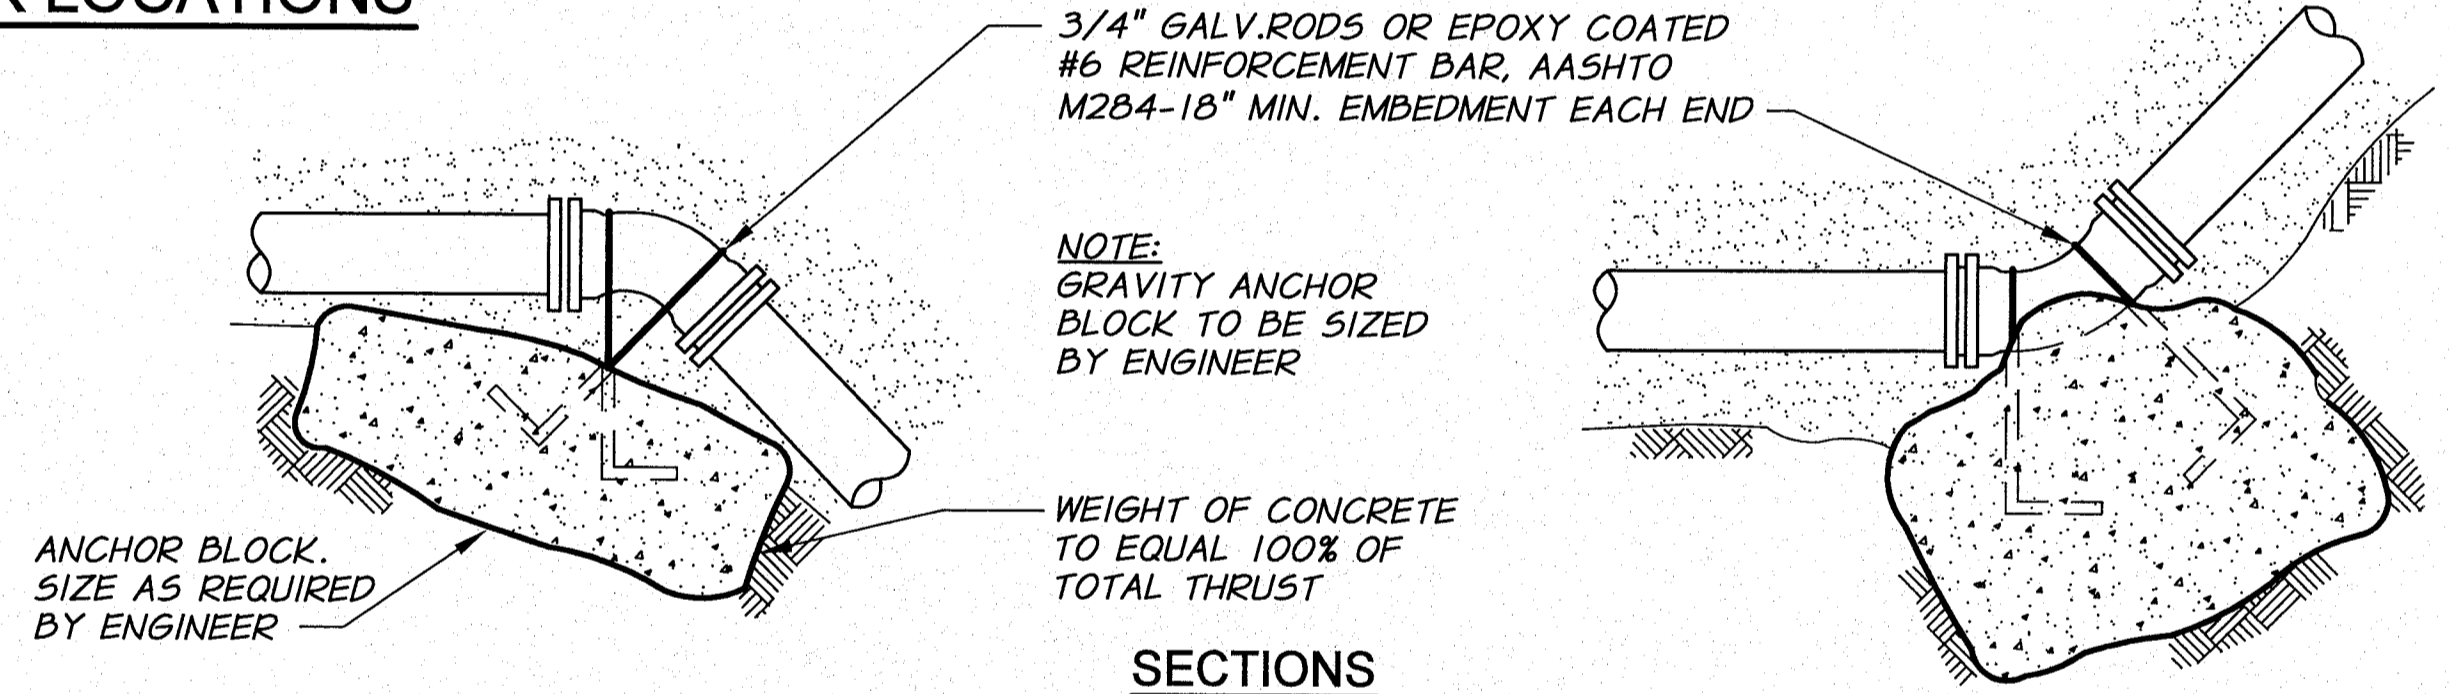

SECTIONS

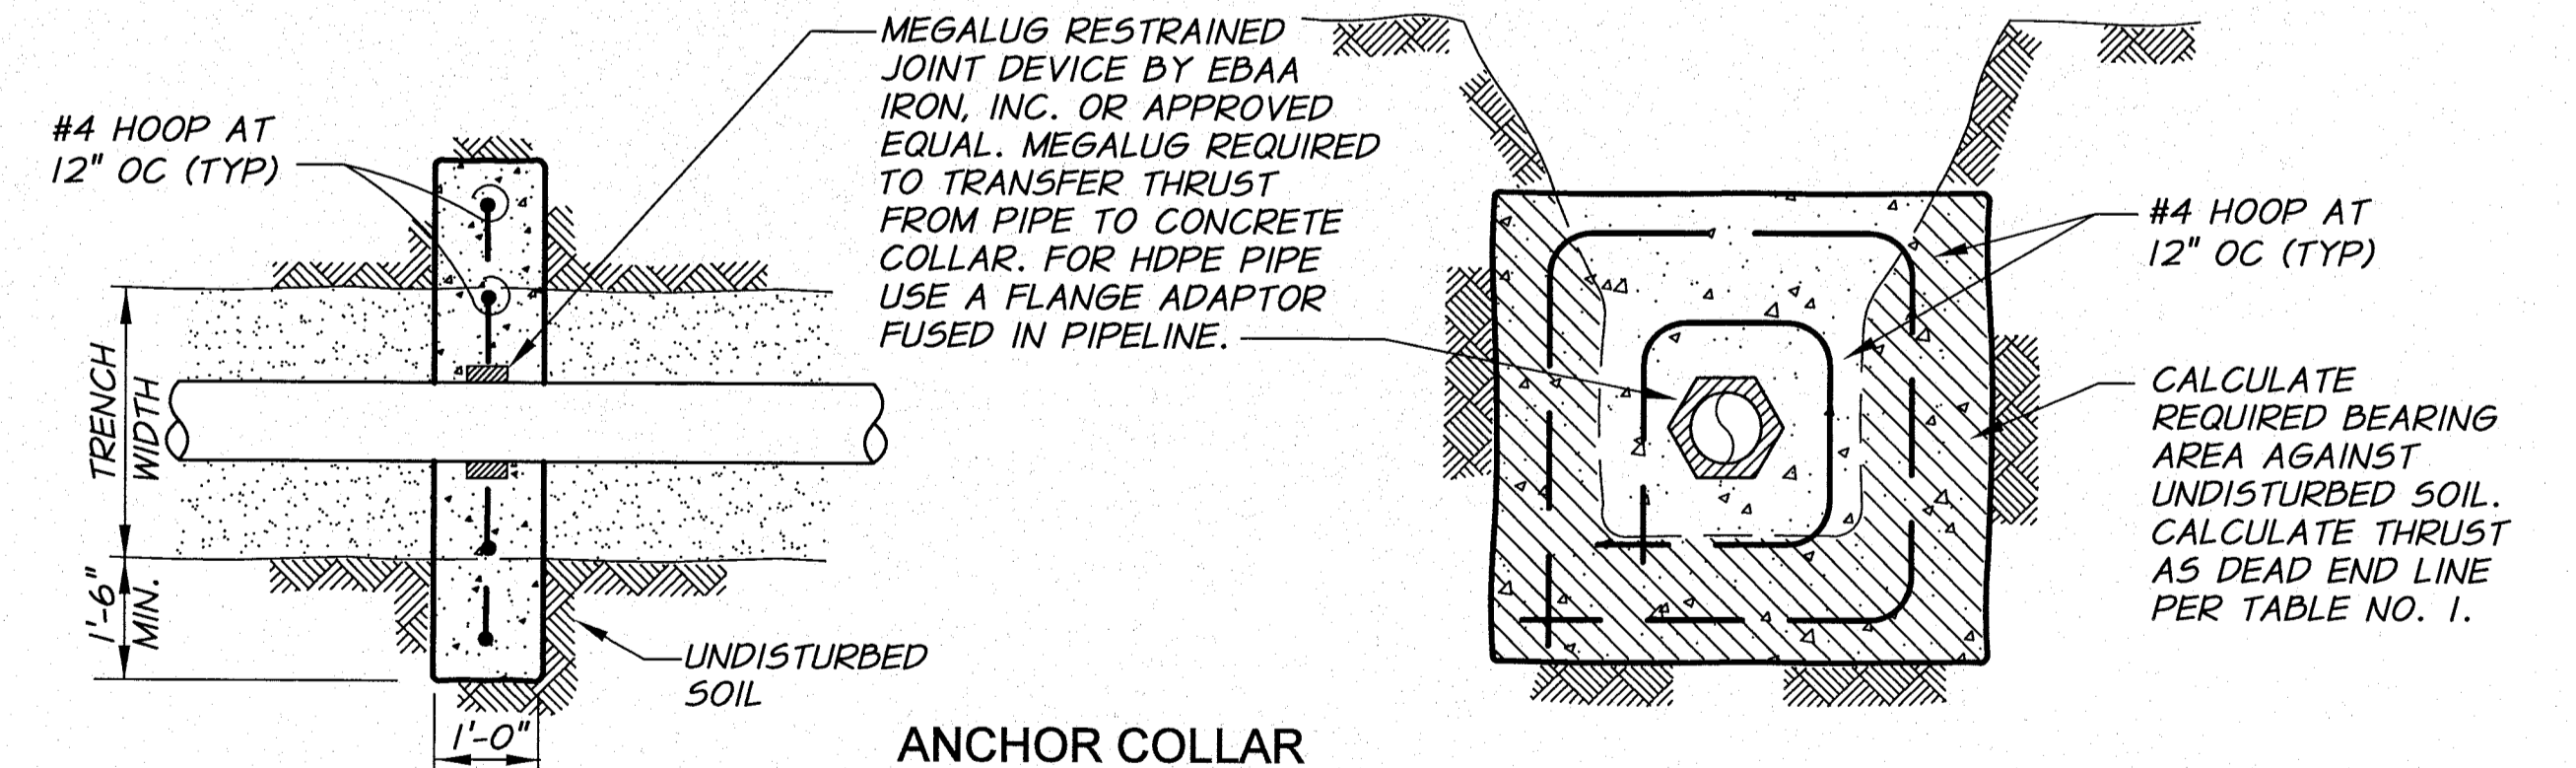


TYPICAL ANCHOR BLOCKS



REVISION	BY	DATE	HORIZ. SCALE	NONE	VERT. SCALE
DESIGNED BY	R. HARRIS	XREFS: TB-BID.dwg	JOB NUMBER	1199-336	DATE
DRAWN BY	D. CHRISTMAN		ACAD FILE	Thrust-ConveySys.dwg	2009
REVIEWED BY	H. PERRY		COPYRIGHT 2009 BY ANDERSON-PERRY & ASSOC., INC.		

RECORD DRAWINGS

These record drawings have been prepared, in part, on the basis of information compiled and furnished by others. They may contain some discrepancies and omissions, and do not necessarily represent "exact" field conditions. The Owner and the Engineer accept no responsibility for their accuracy.

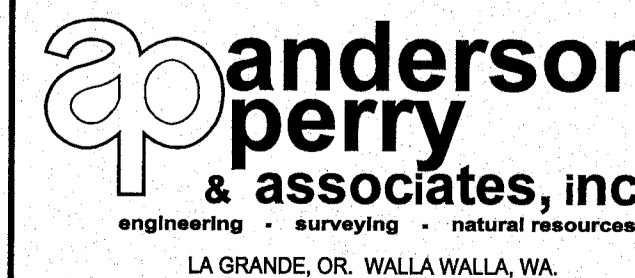

BENTON IRRIGATION DISTRICT
IRRIGATION SYSTEM IMPROVEMENTS
PHASE I

THRUST BLOCK DETAILS

SHEET

128