


| | | | | | |
|---|-------------------|------------------------|-----------|----------------------------------|--|
| RECORD DRAWING | | E.H. 12/11 | | 50 0 50 100 150 SCALE IN FEET | |
| DESIGNED BY R. HARRIS | XREFS: TB-BID.dwg | JOB NUMBER 1199-336 | DATE 2009 | 10 0 20 30 SCALE IN FEET | |
| DRAWN BY D. CHRISTMAN | | ACAD FILE WHAN-PNP.dwg | | HORIZ. SCALE 1"=50' | |
| REVIEWED BY H. PERRY | | | | VERT. SCALE 1"=10' | |
| COPYRIGHT 2009 BY ANDERSON-PERRY & ASSOC., INC. | | | | | |

RECORD DRAWINGS
These record drawings have been prepared, in part, on the basis of information compiled and furnished by others. They may contain some discrepancies and omissions, and do not necessarily represent "exact" field conditions. The Owner and the Engineer accept no responsibility for their accuracy.

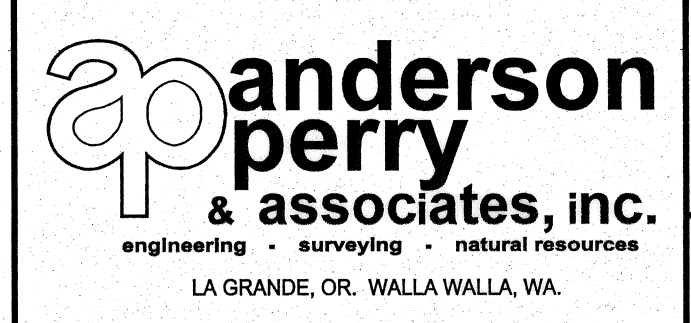

BENTON IRRIGATION DISTRICT
IRRIGATION SYSTEM IMPROVEMENTS
PHASE I
WHAN ROAD PIPING
PLAN AND PROFILE - STA. 4+00 TO 8+00

| | |
|----------|-------|
| BASE BID | SHEET |
| | 4 |

ARCHIVED