

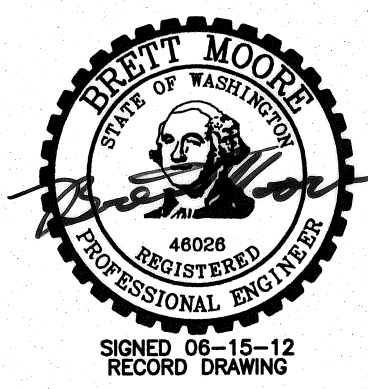



- NOTES:**
1. PROTECT ORCHARD LIMBS AS REQUIRED DURING CONSTRUCTION. EXPENSE FOR DAMAGE TO TREES WILL BE AT CONTRACTOR'S COST AND NO COST TO THE OWNER.
 2. ABANDONED IRRIGATION LINE LOCATED ON ALIGNMENT FROM STA. 7+70 TO 16+70. REMOVE AND PLUG AS REQUIRED.

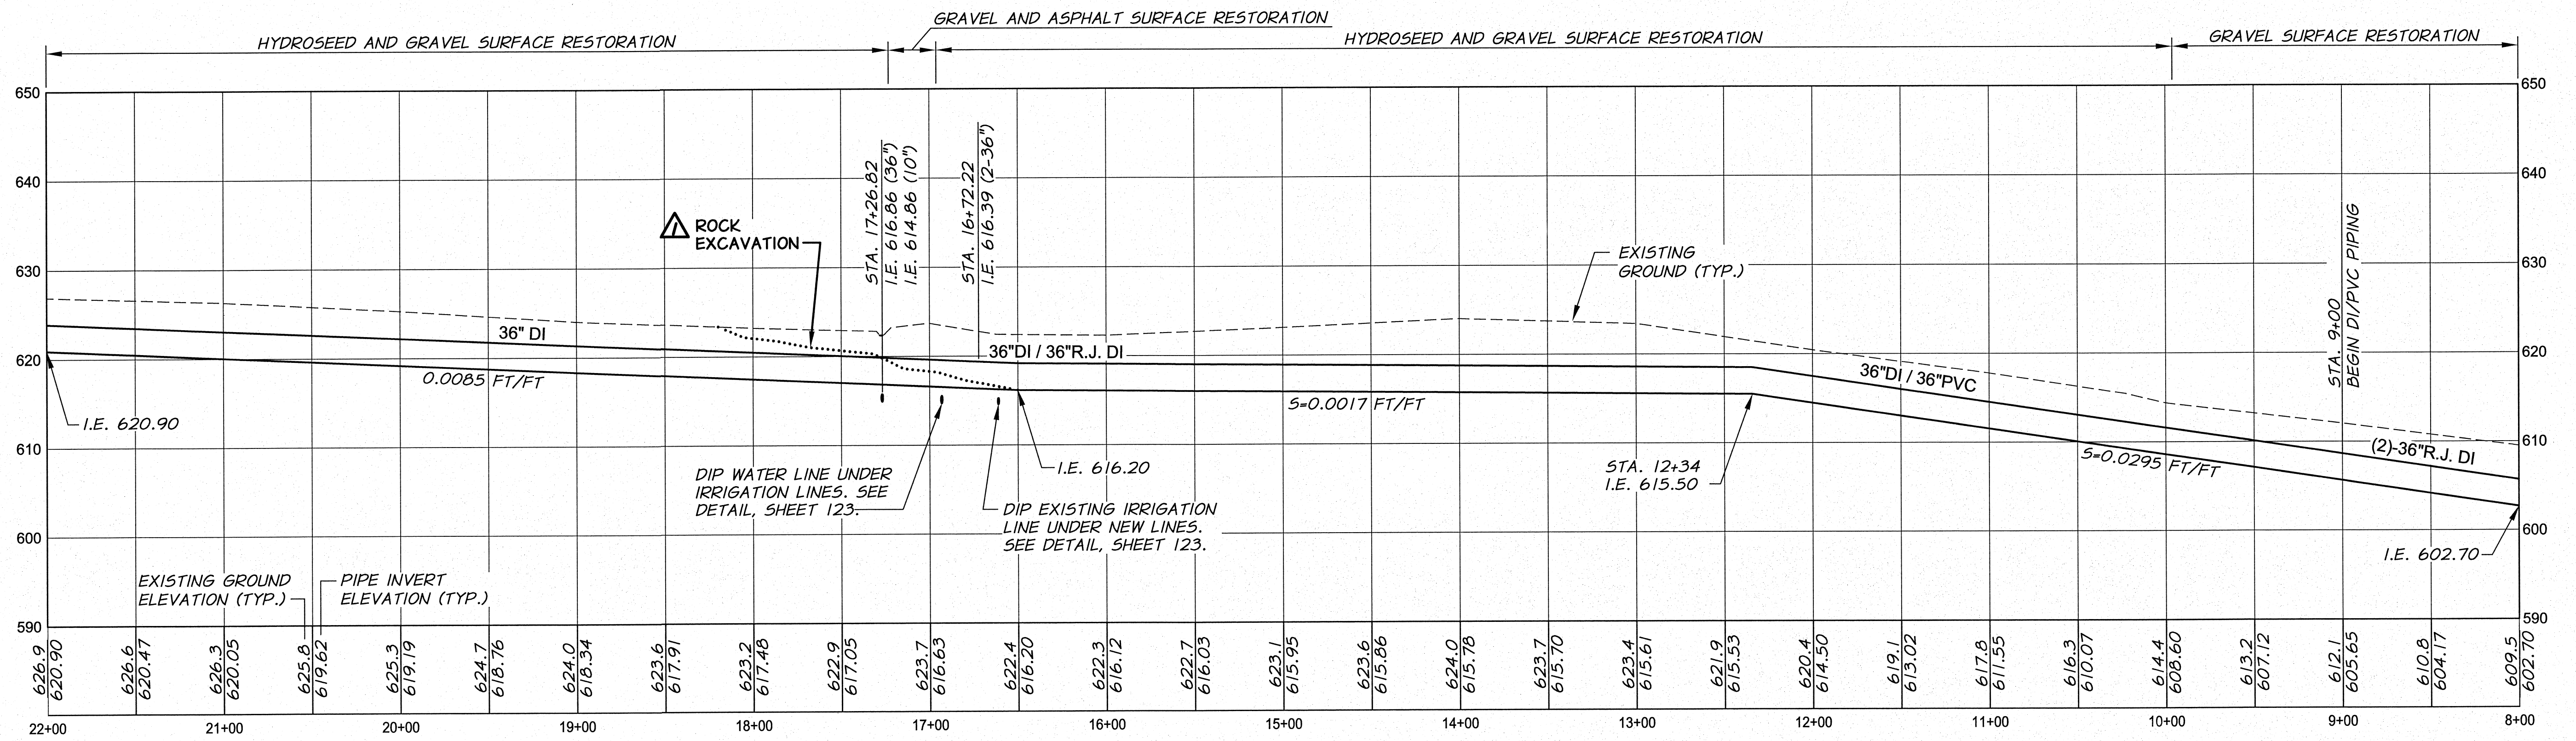

RECORD DRAWING		E.H.	12/11
DESIGNED BY	R. HARRIS	XREFS:	TB-BID.dwg
DRAWN BY	D. CHRISTMAN	JOB NUMBER	1199-336
REVIEWED BY	H. PERRY	DATE	2009
		ACAD FILE	WHAN-PNP.dwg
COPYRIGHT 2009 BY ANDERSON-PERRY & ASSOC., INC.			

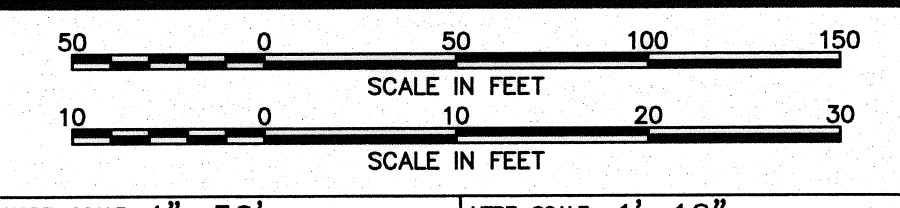

RECORD DRAWINGS
 These record drawings have been prepared, in part, on the basis of information compiled and furnished by others. They may contain some discrepancies and omissions, and do not necessarily represent "exact" field conditions. The Owner and the Engineer accept no responsibility for their accuracy.

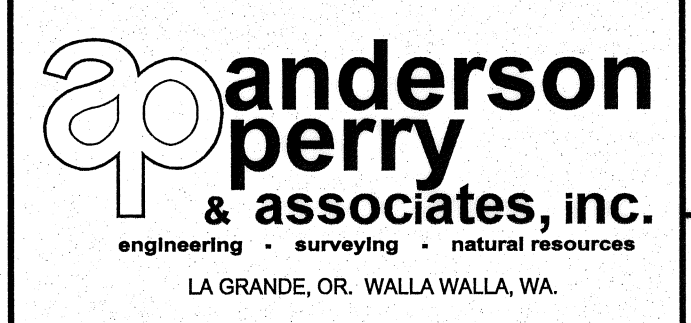

BENTON IRRIGATION DISTRICT
 IRRIGATION SYSTEM IMPROVEMENTS
 PHASE I
 WHAN ROAD PIPING
 PLAN AND PROFILE - STA. 8+00 TO 22+00

BASE BID
 SHEET
5

ARCHIVED