



HYDROSEED AND GRAVEL SURFACE RESTORATION

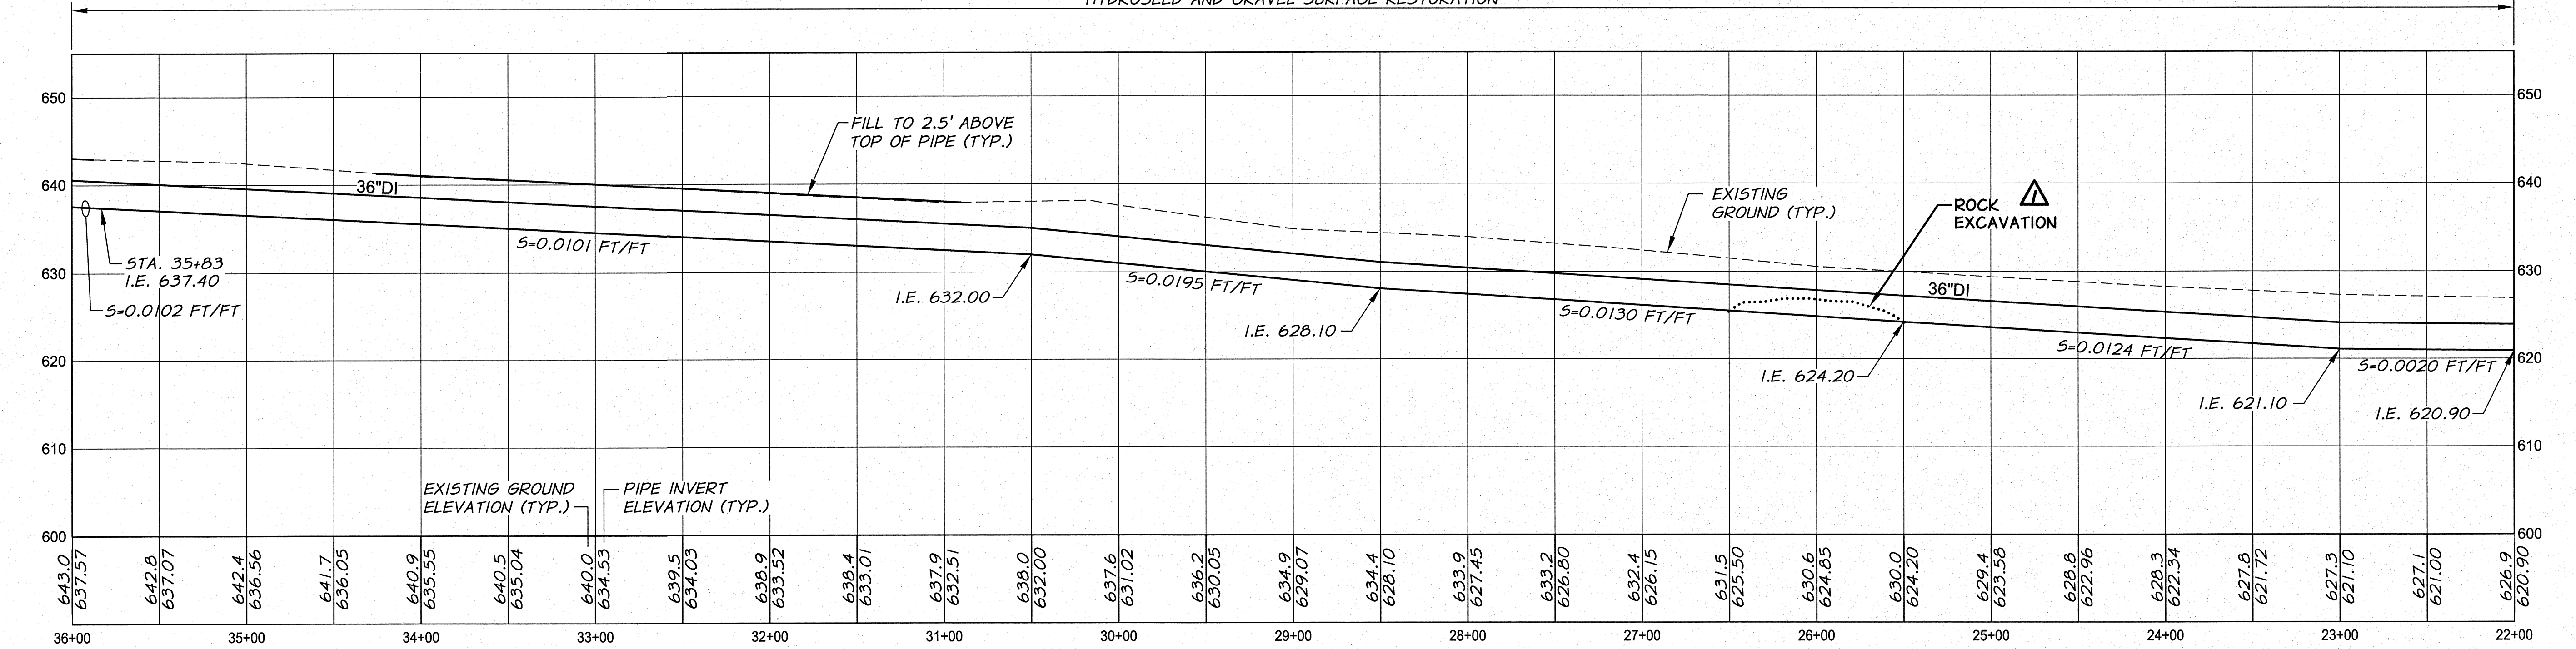

RECORD DRAWING		E.H. 12/11		HORIZ. SCALE 1"=50'		VERT. SCALE	
DESIGNED BY	R. HARRIS	DATE	2009	JOB NUMBER	1199-336	ACAD FILE	WHAN-PNP.dwg
DRAWN BY	D. CHRISTMAN	COPYRIGHT 2009 BY ANDERSON-PERRY & ASSOC., INC.					
REVIEWED BY	H. PERRY	XREFS: TB-BID.dwg					

**RECORD DRAWINGS**  
 These record drawings have been prepared, in part, on the basis of information compiled and furnished by others. They may contain some discrepancies and omissions, and do not necessarily represent "exact" field conditions. The Owner and the Engineer accept no responsibility for their accuracy.

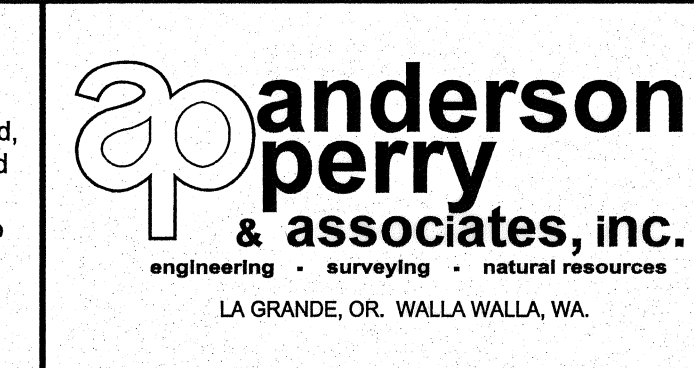

**BENTON IRRIGATION DISTRICT**  
 IRRIGATION SYSTEM IMPROVEMENTS  
 PHASE I  
 WHAN ROAD PIPING  
 PLAN AND PROFILE - STA. 22+00 TO 36+00

BASE BID  
 SHEET  
**6**

