


BASE BID - STA. 0+21 TO 4+00 (30"), STA. 1+50 TO 8+10 (6")  
 ADDITIVE ALTERNATIVE B - STA. 4+00 TO 15+00 (30")



RECORD DRAWING		E.H. 12/11	
DESIGNED BY R. HARRIS	XREFS: TB-BID.dwg	HORIZ. SCALE 1"=50'	VERT. SCALE 1"=10'
DRAWN BY D. CHRISTMAN		JOB NUMBER 1199-336	DATE 2009
REVIEWED BY H. PERRY		ACAD FILE CORRALCRK-PNP.dwg	
COPYRIGHT 2009 BY ANDERSON-PERRY & ASSOC., INC.			

**RECORD DRAWINGS**  
 These record drawings have been prepared, in part, on the basis of information compiled and furnished by others. They may contain some discrepancies and omissions, and do not necessarily represent "exact" field conditions. The Owner and the Engineer accept no responsibility for their accuracy.

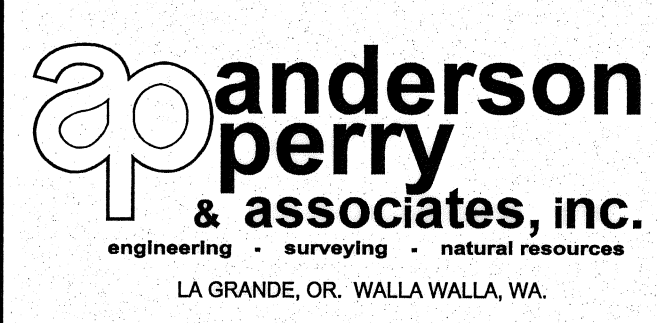

**BENTON IRRIGATION DISTRICT**  
 IRRIGATION SYSTEM IMPROVEMENTS  
 PHASE I  
 CORRAL CREEK ROAD PIPING  
 PLAN AND PROFILE - STA. 1+21 TO 15+00

SHEET  
**8**

ARCHIVED