




BASE BID - STA. 15+20 TO 19+00  
 ADDITIVE ALTERNATIVE A - STA. 19+00 TO 29+00

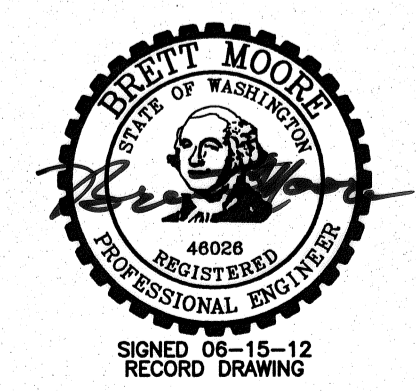

RECORD DRAWING		BY	E.H.	DATE	12/11
DESIGNED BY	R. HARRIS	XREFS:	TB-BID.dwg		
DRAWN BY	D. CHRISTMAN	JOB NUMBER	1199-336		
REVIEWED BY	H. PERRY	DATE	2009		
		ACAD FILE:	CORRALCRK-PNP.dwg		
COPYRIGHT 2009 BY ANDERSON-PERRY & ASSOC., INC.					

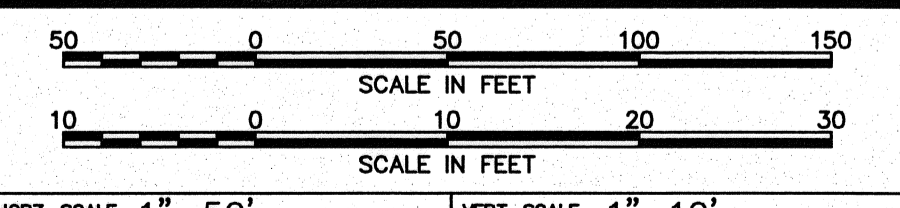

**RECORD DRAWINGS**  
 These record drawings have been prepared, in part, on the basis of information compiled and furnished by others. They may contain some discrepancies and omissions, and do not necessarily represent "exact" field conditions. The Owner and the Engineer accept no responsibility for their accuracy.

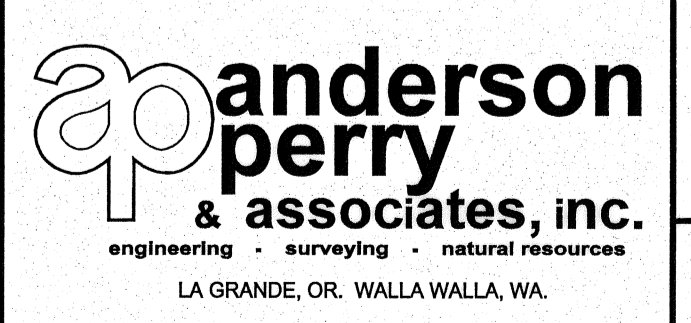

**BENTON IRRIGATION DISTRICT**  
 IRRIGATION SYSTEM IMPROVEMENTS  
 PHASE I

**CORRAL CREEK ROAD PIPING**  
 PLAN AND PROFILE - STA. 15+00 TO 29+00

SHEET **9**

ARCHIVED