


RECORD DRAWING		BY	E.H.	DATE	12/11
DESIGNED BY	R. HARRIS	XREFS:	TB-BID.dwg		
DRAWN BY	R. RASMUSSEN				
REVIEWED BY	H. PERRY				

50 0 50 100 150 SCALE IN FEET	
10 0 10 20 30 SCALE IN FEET	
HORIZ. SCALE	1" = 50'
VERT. SCALE	1" = 10'
JOB NUMBER	1199-336
DATE	2009
ACAD FILE:	EVERT-HORNE-PNP.dwg
COPYRIGHT 2009 BY ANDERSON-PERRY & ASSOC., INC.	

RECORD DRAWINGS

These record drawings have been prepared, in part, on the basis of information compiled and furnished by others. They may contain some discrepancies and omissions, and do not necessarily represent "exact" field conditions. The Owner and the Engineer accept no responsibility for their accuracy.

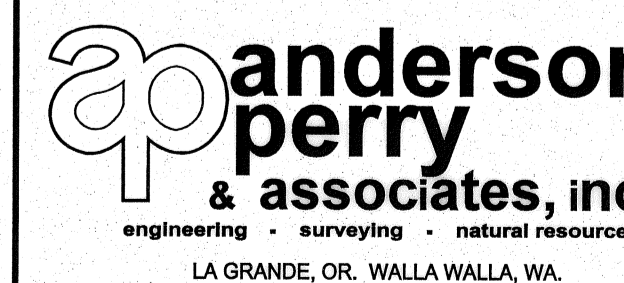

**BENTON IRRIGATION DISTRICT
IRRIGATION SYSTEM IMPROVEMENTS
PHASE I**

**EVERT ROAD TO HORNE ROAD PIPING
PLAN AND PROFILE - STA. 1+00 TO 7+10**

ADDITIVE ALTERNATIVE B

SHEET

105