



ADDITIVE ALTERNATIVE A - STA. 15+00 TO 20+50, STA. 21+70 TO 25+00
 ADDITIVE ALTERNATIVE B - STA. 20+50 TO 21+70

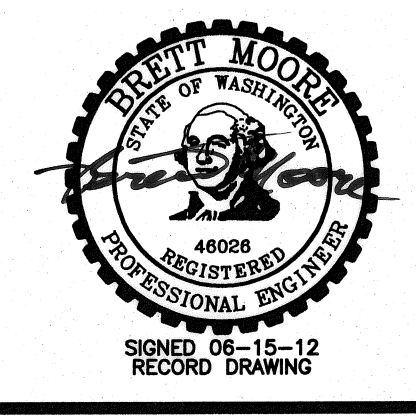

RECORD DRAWING		E.H. 12/11	
DESIGNED BY R. HARRIS	XREFS: TB-BID.dwg	HORIZ. SCALE 1"=50'	VERT. SCALE 1"=10'
DRAWN BY R. RASMUSSEN		JOB NUMBER 1199-336	DATE 2009
REVIEWED BY H. PERRY		ACAD FILE WAGONWHEEL-PNP.dwg	
COPYRIGHT 2009 BY ANDERSON-PERRY & ASSOC., INC.			

RECORD DRAWINGS
 These record drawings have been prepared, in part, on the basis of information compiled and furnished by others. They may contain some discrepancies and omissions, and do not necessarily represent "exact" field conditions. The Owner and the Engineer accept no responsibility for their accuracy.

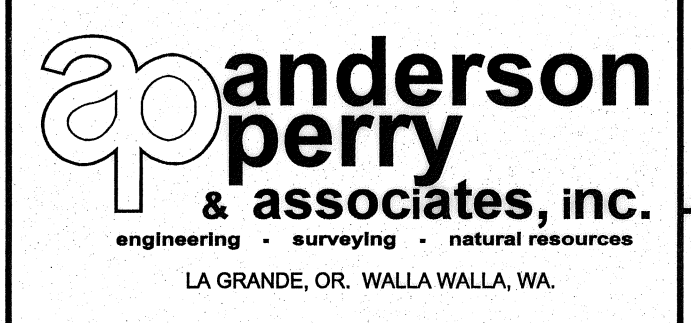

BENTON IRRIGATION DISTRICT
 IRRIGATION SYSTEM IMPROVEMENTS
 PHASE I
 WAGONWHEEL TO MONTANA ROAD PIPING
 PLAN AND PROFILE - STA. 15+00 TO 25+00

SHEET
107