


RECORD DRAWING		E.H. 12/11		50 0 50 100 150	
ADDED SHEET		H.P. 5/10		10 0 10 20 30	
DESIGNED BY	R. HARRIS	DATE	2009	HORIZ. SCALE	1"=50'
DRAWN BY	R. RASMUSSEN	DATE	2009	VERT. SCALE	1"=10'
REVIEWED BY	H. PERRY	JOB NUMBER	1199-336	ACAD FILE	WAGONWHEEL-PNP.dwg
XREFS: TB-BID.dwg					
COPYRIGHT 2009 BY ANDERSON-PERRY & ASSOC., INC.					

**RECORD DRAWINGS**  
 These record drawings have been prepared, in part, on the basis of information compiled and furnished by others. They may contain some discrepancies and omissions, and do not necessarily represent "exact" field conditions. The Owner and the Engineer accept no responsibility for their accuracy.

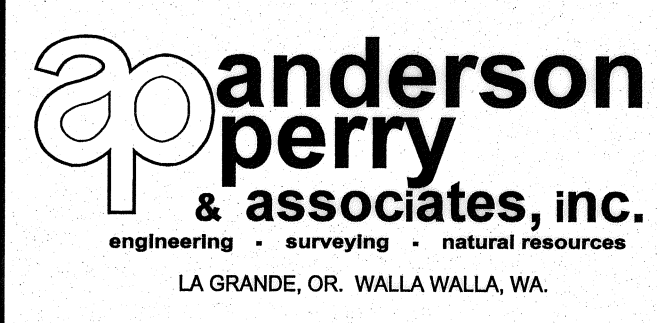

**BENTON IRRIGATION DISTRICT**  
 IRRIGATION SYSTEM IMPROVEMENTS  
 PHASE I  
 WAGONWHEEL TO MONTANA ROAD PIPING  
 PLAN AND PROFILE - STA. 1+00 TO 6+25

ADDITIVE ALTERNATIVE B  
 SHEET  
**107A**