



RECORD DRAWING		E.H. 12/11	
DESIGNED BY R. HARRIS	XREFS: TB-BID.dwg	JOB NUMBER 1199-336	DATE 2009
DRAWN BY R. RASMUSSEN		ACAD FILE WAGONWHEEL-PNP.dwg	
REVIEWED BY H. PERRY		COPYRIGHT 2009 BY ANDERSON-PERRY & ASSOC., INC.	

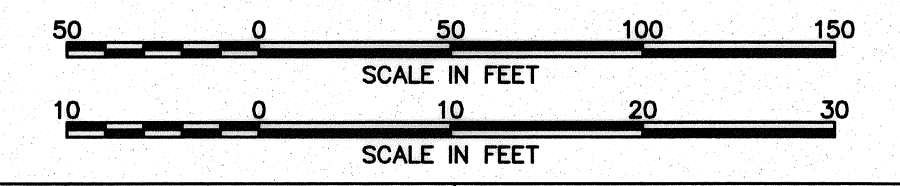

RECORD DRAWINGS
 These record drawings have been prepared, in part, on the basis of information compiled and furnished by others. They may contain some discrepancies and omissions, and do not necessarily represent "exact" field conditions. The Owner and the Engineer accept no responsibility for their accuracy.

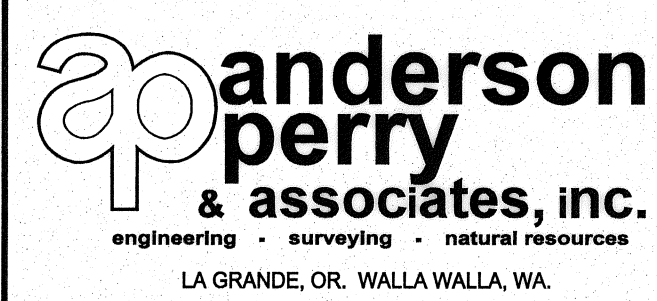

BENTON IRRIGATION DISTRICT
 IRRIGATION SYSTEM IMPROVEMENTS
 PHASE I
 WAGON WHEEL ROAD PIPING
 PLAN AND PROFILE - STA. 1+00 TO 9+55

ADDITIVE ALTERNATIVE A
 SHEET
110