



ADDITIVE ALTERNATIVE B

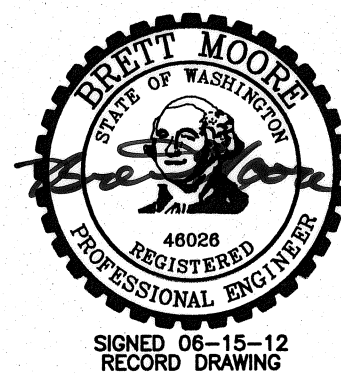

RECORD DRAWING		E.H. 12/11		 SCALE IN FEET	
DESIGNED BY R. HARRIS		XREFS: TB-BID.dwg		 SCALE IN FEET	
DRAWN BY D. CHRISTMAN		JOB NUMBER 1199-336		DATE 2009	
REVIEWED BY H. PERRY		ACAD FILE: NOREROZA.dwg		COPYRIGHT 2009 BY ANDERSON-PERRY & ASSOC., INC.	

**RECORD DRAWINGS**

These record drawings have been prepared, in part, on the basis of information compiled and furnished by others. They may contain some discrepancies and omissions, and do not necessarily represent "exact" field conditions. The Owner and the Engineer accept no responsibility for their accuracy.

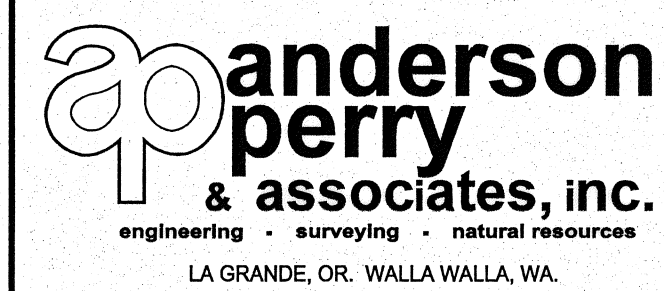

**BENTON IRRIGATION DISTRICT**  
IRRIGATION SYSTEM IMPROVEMENTS  
PHASE I

EAST ROZA NORTH PIPING  
PLAN AND PROFILE - STA. 27+00 TO 30+90

SHEET

13

ARCHIVED