


RECORD DRAWING		BY	E.H.	DATE	12/11
DESIGNED BY	R. HARRIS	XREFS: TB-BID.dwg			
DRAWN BY	D. CHRISTMAN	JOB NUMBER	1199-336	DATE	2009
REVIEWED BY	H. PERRY	ACAD FILE	EROZA-PNP.dwg		

SCALE IN FEET	
0 50 100 150	
SCALE IN FEET	
0 10 20 30	
HORIZ. SCALE	1"=50'
VERT. SCALE	1"=10'
COPYRIGHT 2009 BY ANDERSON-PERRY & ASSOC., INC.	

RECORD DRAWINGS

These record drawings have been prepared, in part, on the basis of information compiled and furnished by others. They may contain some discrepancies and omissions, and do not necessarily represent "exact" field conditions. The Owner and the Engineer accept no responsibility for their accuracy.

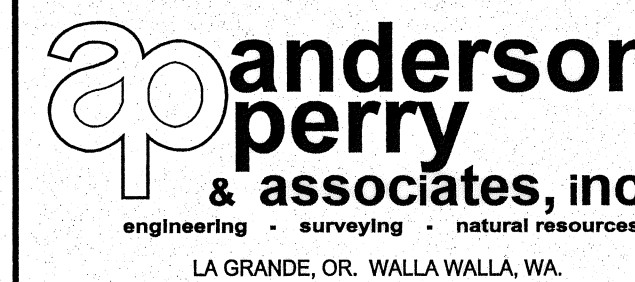

BENTON IRRIGATION DISTRICT
IRRIGATION SYSTEM IMPROVEMENTS
PHASE I

EAST ROZA ROAD PIPING
PLAN AND PROFILE - STA. 15+50 TO 26+75

ADDITIVE ALTERNATIVE B

SHEET

17

ARCHIVED