


RECORD DRAWING		E.H. 12/11	
DESIGNED BY	R. HARRIS	XREFS: TB-BID.dwg	
DRAWN BY	D. CHRISTMAN	JOB NUMBER	1199-336
REVIEWED BY	H. PERRY	ACAD FILE	EROZA-PNP.dwg
		DATE	
		2009	
COPYRIGHT 2009 BY ANDERSON-PERRY & ASSOC., INC.			

**RECORD DRAWINGS**

These record drawings have been prepared, in part, on the basis of information compiled and furnished by others. They may contain some discrepancies and omissions, and do not necessarily represent "exact" field conditions. The Owner and the Engineer accept no responsibility for their accuracy.

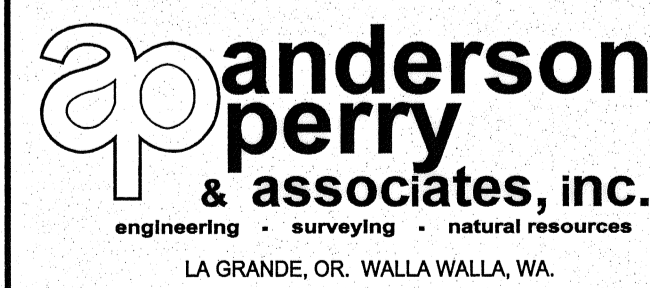

**BENTON IRRIGATION DISTRICT  
IRRIGATION SYSTEM IMPROVEMENTS  
PHASE I**

**EAST ROZA ROAD PIPING  
PLAN AND PROFILE - STA. 1+00 TO 7+20**

ADDITIVE ALTERNATIVE B

SHEET

**18**

ARCHIVED