


RECORD DRAWING		E.H. 12/11	
DESIGNED BY	R. HARRIS	XREFS:	TB-BID.dwg
DRAWN BY	D. CHRISTMAN	JOB NUMBER	1199-336
REVIEWED BY	H. PERRY	ACAD FILE	WHITMORE-PNP.dwg
		DATE 2009	
COPYRIGHT 2009 BY ANDERSON-PERRY & ASSOC., INC.			

RECORD DRAWINGS

These record drawings have been prepared, in part, on the basis of information compiled and furnished by others. They may contain some discrepancies and omissions, and do not necessarily represent "exact" field conditions. The Owner and the Engineer accept no responsibility for their accuracy.

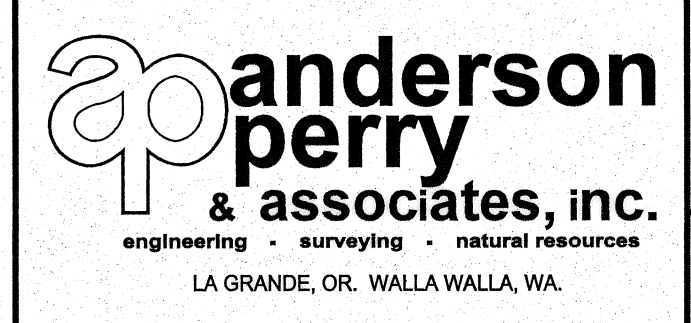

**BENTON IRRIGATION DISTRICT
IRRIGATION SYSTEM IMPROVEMENTS
PHASE I**

**WHITMORE STREET PIPING
PLAN AND PROFILE - STA. 15+00 TO 24+86**

ADDITIVE ALTERNATIVE B
SHEET
20