


BASE BID - STA. 1+40 TO 10+50
 ADDITIVE ALTERNATIVE A - STA. 10+50 TO 12+00



DESIGNED BY	R. HARRIS	XREFS: TB-BID.dwg
DRAWN BY	D. CHRISTMAN	
REVIEWED BY	H. PERRY	
JOB NUMBER	1199-336	DATE 2009
ACAD FILE	WILLIAMS_WEST-PNP.dwg	
COPYRIGHT 2009 BY ANDERSON-PERRY & ASSOC., INC.		

RECORD DRAWINGS
 These record drawings have been prepared, in part, on the basis of information compiled and furnished by others. They may contain some discrepancies and omissions, and do not necessarily represent "exact" field conditions. The Owner and the Engineer accept no responsibility for their accuracy.

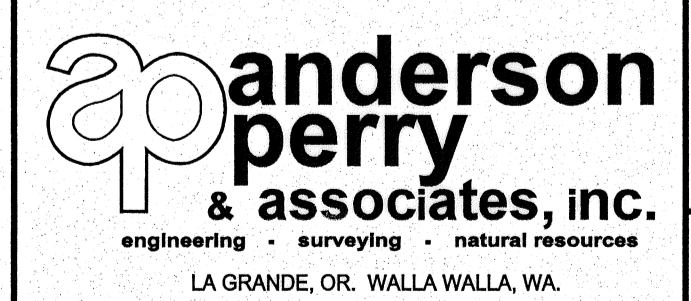

BENTON IRRIGATION DISTRICT
 IRRIGATION SYSTEM IMPROVEMENTS
 PHASE I
 WILLIAMS ROAD PIPING
 PLAN AND PROFILE STA. 1+40 TO 12+00

SHEET
30