



ADDITIVE ALTERNATIVE A

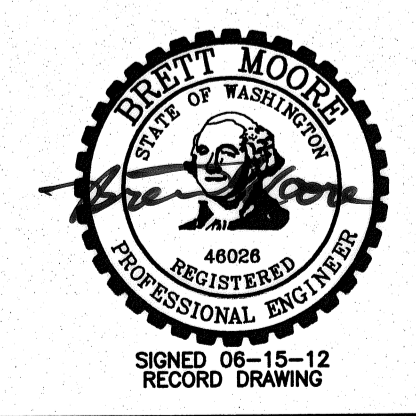

RECORD DRAWING		E.H. 12/11		SCALE IN FEET 0 50 100 150	
DESIGNED BY	R. HARRIS	DATE	2009	SCALE IN FEET 0 10 20 30	
DRAWN BY	D. CHRISTMAN	JOB NUMBER	1199-336		
REVIEWED BY	H. PERRY	ACAD FILE	WILLIAMS_WEST-PNP.dwg		
		COPYRIGHT 2009 BY ANDERSON-PERRY & ASSOC., INC.			

**RECORD DRAWINGS**  
 These record drawings have been prepared, in part, on the basis of information compiled and furnished by others. They may contain some discrepancies and omissions, and do not necessarily represent "exact" field conditions. The Owner and the Engineer accept no responsibility for their accuracy.

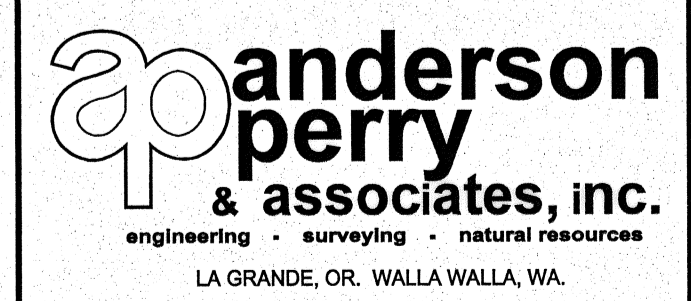

**BENTON IRRIGATION DISTRICT**  
 IRRIGATION SYSTEM IMPROVEMENTS  
 PHASE I  
 WILLIAMS ROAD PIPING  
 PLAN AND PROFILE - STA. 12+00 TO 21+00

SHEET  
**31**