


| | | | |
|--------------------------|-------------------|---|--------------|
| RECORD DRAWING | | E.H. 12/11 | |
| DESIGNED BY R. HARRIS | XREFs: TB-BID.dwg | JOB NUMBER 1199-336 | DATE 2009 |
| DRAWN BY D. CHRISTMAN | | ACAD FILE WHITMORE-CORRALCK-PNP.dwg | |
| REVIEWED BY H. PERRY | | COPYRIGHT 2009 BY ANDERSON-PERRY & ASSOC., INC. | |

RECORD DRAWINGS

These record drawings have been prepared, in part, on the basis of information compiled and furnished by others. They may contain some discrepancies and omissions, and do not necessarily represent "exact" field conditions. The Owner and the Engineer accept no responsibility for their accuracy.

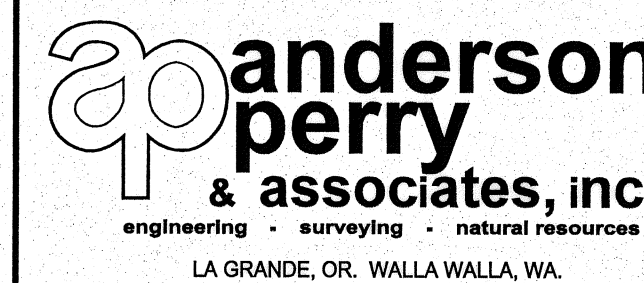

BENTON IRRIGATION DISTRICT IRRIGATION SYSTEM IMPROVEMENTS PHASE I

WHITMORE ROAD TO CORRAL CREEK ROAD PIPING
PLAN AND PROFILE - STA. 1+00 TO 7+00

ADDITIVE ALTERNATIVE A

SHEET
35

ARCHIVED