



<b>RECORD DRAWING</b>		BY: E.H.	DATE: 12/11
DESIGNED BY: R. HARRIS	XREFS: TB-BID.dwg		
DRAWN BY: D. CHRISTMAN	JOB NUMBER: 1199-336	DATE: 2009	
REVIEWED BY: H. PERRY	ACAD FILE: EMPIRE-PNP.dwg		

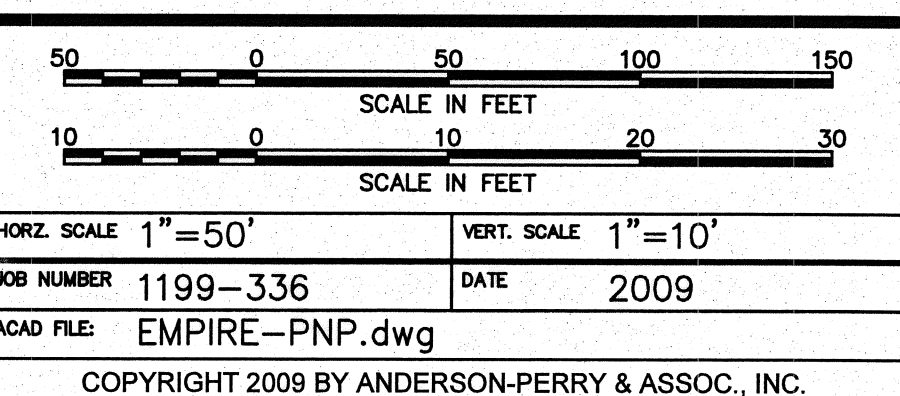

**RECORD DRAWINGS**  
 These record drawings have been prepared, in part, on the basis of information compiled and furnished by others. They may contain some discrepancies and omissions, and do not necessarily represent "exact" field conditions. The Owner and the Engineer accept no responsibility for their accuracy.

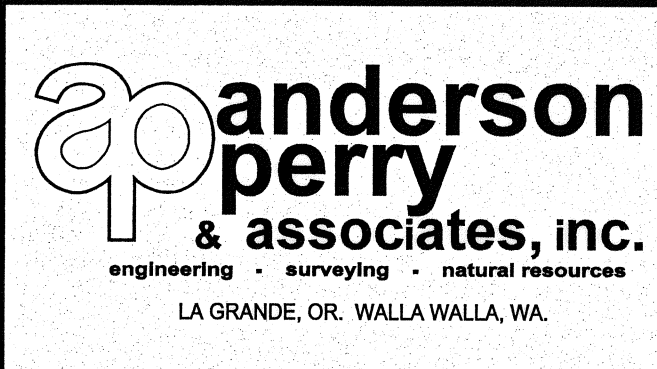

**BENTON IRRIGATION DISTRICT**  
 IRRIGATION SYSTEM IMPROVEMENTS  
 PHASE I  
 EMPIRE DRIVE PIPING  
 PLAN AND PROFILE - STA. 1+00 TO 11+48

BASE BID  
 SHEET  
**39**