


DESIGNED BY	R. HARRIS	XREFS: TB-BID.dwg	HORIZ. SCALE	1"=50'	VERT. SCALE	1"=10'
DRAWN BY	D. CHRISTMAN		JOB NUMBER	1199-336	DATE	2009
REVIEWED BY	H. PERRY		ACAD FILE	WESTMAIN-PNP.dwg	COPYRIGHT 2009 BY ANDERSON-PERRY & ASSOC., INC.	

RECORD DRAWINGS
 These record drawings have been prepared, in part, on the basis of information compiled and furnished by others. They may contain some discrepancies and omissions, and do not necessarily represent "exact" field conditions. The Owner and the Engineer accept no responsibility for their accuracy.

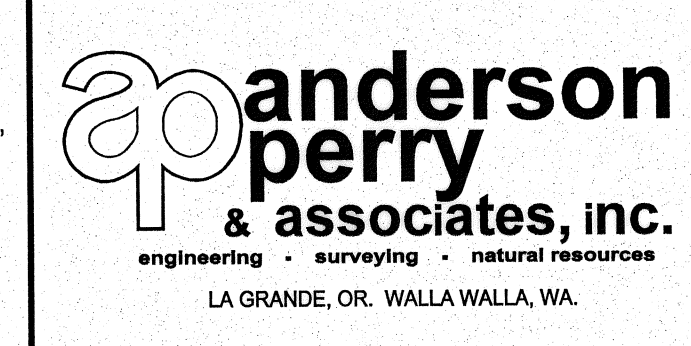

BENTON IRRIGATION DISTRICT
 IRRIGATION SYSTEM IMPROVEMENTS
 PHASE I
 WEST MAIN LINE
 PLAN AND PROFILE - STA. 28+00 TO 41+00

ADDITIVE ALTERNATIVE A
 SHEET
40

ARCHIVED