



ADDITIVE ALTERNATIVE A

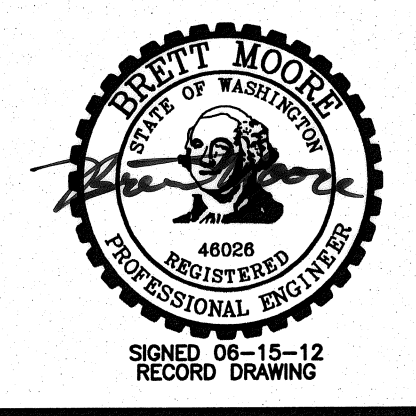

REVISION	BY	DATE	HORIZ. SCALE 1"=50'	VERT. SCALE 1"=10'
DESIGNED BY R. HARRIS			XREFS: TB-BID.dwg	
DRAWN BY D. CHRISTMAN			JOB NUMBER 1199-336	DATE 2009
REVIEWED BY H. PERRY			ACAD FILE WESTMAIN-PNP.dwg	
COPYRIGHT 2009 BY ANDERSON-PERRY & ASSOC., INC.				

RECORD DRAWINGS
 These record drawings have been prepared, in part, on the basis of information compiled and furnished by others. They may contain some discrepancies and omissions, and do not necessarily represent "exact" field conditions. The Owner and the Engineer accept no responsibility for their accuracy.

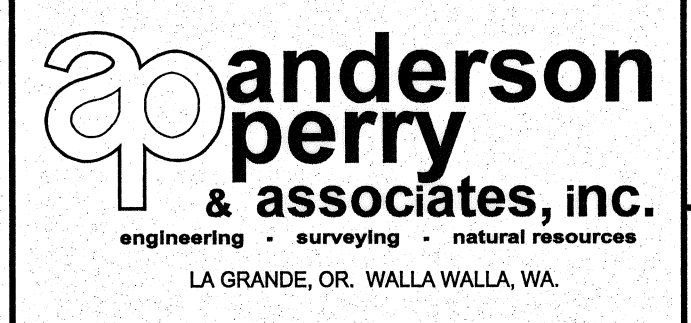

BENTON IRRIGATION DISTRICT
 IRRIGATION SYSTEM IMPROVEMENTS
 PHASE I
 WEST MAIN LINE
 PLAN AND PROFILE - STA. 41+00 TO 55+00

SHEET
41

ARCHIVED