



ADDITIVE ALTERNATIVE A

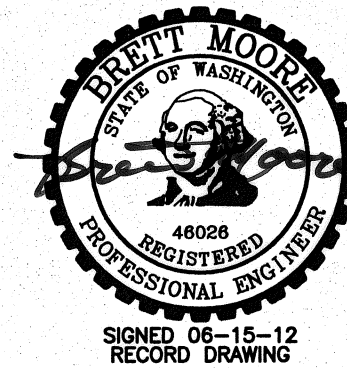

<b>RECORD DRAWING</b>		BY	E.H.	DATE	12/11
DESIGNED BY	R. HARRIS	XREFS:	TB-BID.dwg		
DRAWN BY	D. CHRISTMAN	JOB NUMBER	1199-336		
REVIEWED BY	H. PERRY	ACAD FILE	HIGHLAND-PNP.dwg		
		DATE	2009		

HORIZ. SCALE	1" = 50'
VERT. SCALE	1" = 10'
COPYRIGHT 2009 BY ANDERSON-PERRY & ASSOC., INC.	

**RECORD DRAWINGS**  
 These record drawings have been prepared, in part, on the basis of information compiled and furnished by others. They may contain some discrepancies and omissions, and do not necessarily represent "exact" field conditions. The Owner and the Engineer accept no responsibility for their accuracy.

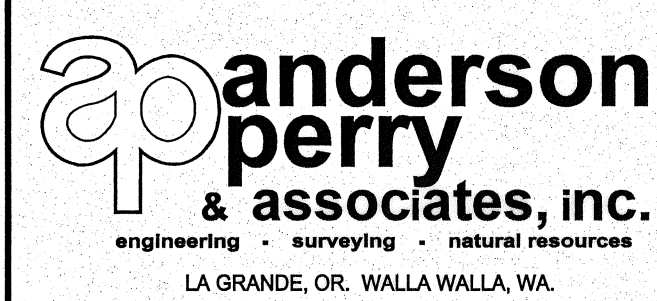

**BENTON IRRIGATION DISTRICT**  
 IRRIGATION SYSTEM IMPROVEMENTS  
 PHASE I  
 HIGHLAND EXTENSION ROAD PIPING  
 PLAN AND PROFILE - STA. 14+00 TO 26+00

SHEET  
**45**