



REVISION	BY	DATE	HORIZ. SCALE 1"=50'	VERT. SCALE 1"=10'
DESIGNED BY R. HARRIS	XREFS: TB-BID.dwg		JOB NUMBER 1199-336	DATE 2009
DRAWN BY D. CHRISTMAN			ACAD FILE HIGHLAND-PNP.dwg	
REVIEWED BY H. PERRY			COPYRIGHT 2009 BY ANDERSON-PERRY & ASSOC., INC.	

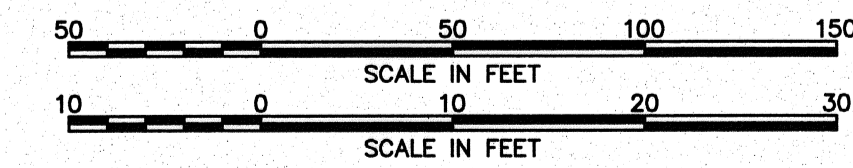

RECORD DRAWINGS

These record drawings have been prepared, in part, on the basis of information compiled and furnished by others. They may contain some discrepancies and omissions, and do not necessarily represent "exact" field conditions. The Owner and the Engineer accept no responsibility for their accuracy.

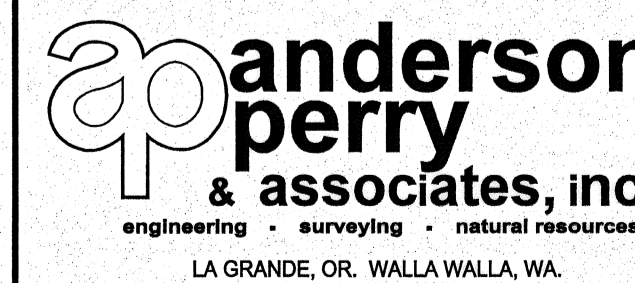

**BENTON IRRIGATION DISTRICT
IRRIGATION SYSTEM IMPROVEMENTS
PHASE I**

**HIGHLAND EXTENSION ROAD PIPING
PLAN AND PROFILE - STA. 1+00 TO 14+00**

ADDITIVE ALTERNATIVE A

SHEET

50

C:\BENTON\LD\1199_336_PRESSURE_PIPE\HIGHLAND-PNP.dwg, HERR, TX, 6/19/2012 1:34:47 PM