



ADDITIVE ALTERNATIVE A - STA. 11+00 TO 11+50
 ADDITIVE ALTERNATIVE B - STA. 11+50 TO 22+00

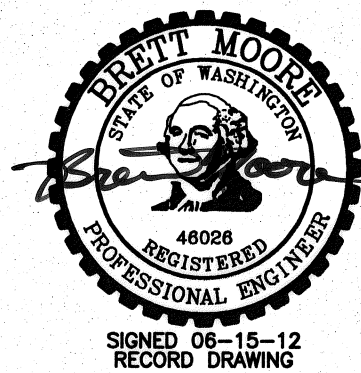

RECORD DRAWING		E.H. 12/11	
DESIGNED BY	R. HARRIS	XREFS:	TB-BID.dwg
DRAWN BY	R. RASMUSSEN		
REVIEWED BY	H. PERRY		
JOB NUMBER 1199-336		DATE 2009	
ACAD FILE WHAN-EVERT-PNP.dwg		COPYRIGHT 2009 BY ANDERSON-PERRY & ASSOC., INC.	

RECORD DRAWINGS

These record drawings have been prepared, in part, on the basis of information compiled and furnished by others. They may contain some discrepancies and omissions, and do not necessarily represent "exact" field conditions. The Owner and the Engineer accept no responsibility for their accuracy.

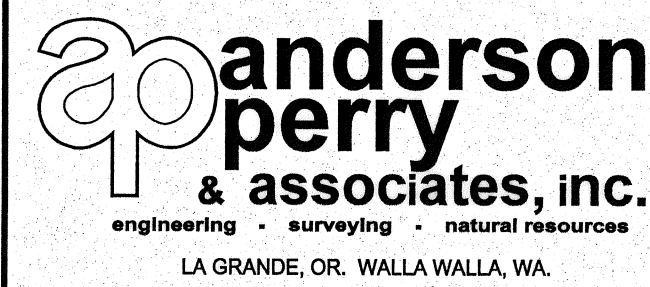

BENTON IRRIGATION DISTRICT
 IRRIGATION SYSTEM IMPROVEMENTS
 PHASE I

WHAN ROAD TO EVERT ROAD PIPING
 PLAN AND PROFILE - STA. 11+00 TO 22+00

SHEET

53