



DESIGNED BY	R. HARRIS	DATE	
DRAWN BY	R. RASMUSSEN	DATE	2009
REVIEWED BY	H. PERRY	DATE	

BY		DATE	
XREFS: TB-BID.dwg		JOB NUMBER	1199-336
		ACAD FILE	WHAN-EVERT-PNP.dwg
COPYRIGHT 2009 BY ANDERSON-PERRY & ASSOC., INC.			

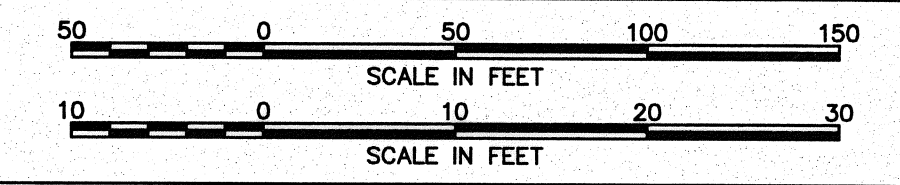

RECORD DRAWINGS
 These record drawings have been prepared, in part, on the basis of information compiled and furnished by others. They may contain some discrepancies and omissions, and do not necessarily represent "exact" field conditions. The Owner and the Engineer accept no responsibility for their accuracy.

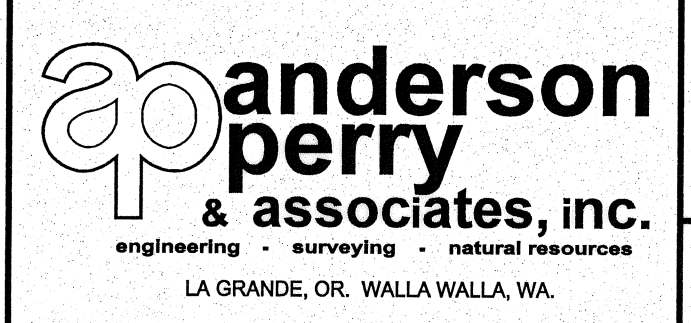

BENTON IRRIGATION DISTRICT
 IRRIGATION SYSTEM IMPROVEMENTS
 PHASE I
 WHAN ROAD TO EVERT ROAD PIPING
 PLAN AND PROFILE - STA. 40+00 TO 51+59

ADDITIVE ALTERNATIVE B

SHEET
56