


REVISION		BY		DATE		HORIZ. SCALE 1"=50'		VERT. SCALE 1"=10'	
RECORD DRAWING		E.H.		12/11		SCALE IN FEET		SCALE IN FEET	
DESIGNED BY R. HARRIS		XREFS: TB-BID.dwg		JOB NUMBER 1199-336		DATE 2009			
DRAWN BY R. RASMUSSEN				ACAD FILE: EVERT-PNP.dwg					
REVIEWED BY H. PERRY				COPYRIGHT 2009 BY ANDERSON-PERRY & ASSOC., INC.					

**RECORD DRAWINGS**  
 These record drawings have been prepared, in part, on the basis of information compiled and furnished by others. They may contain some discrepancies and omissions, and do not necessarily represent "exact" field conditions. The Owner and the Engineer accept no responsibility for their accuracy.

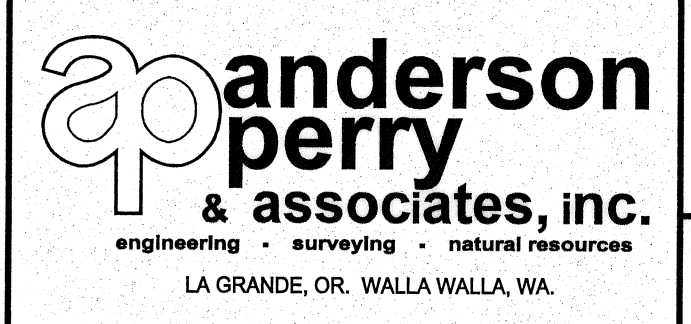

**BENTON IRRIGATION DISTRICT**  
 IRRIGATION SYSTEM IMPROVEMENTS  
 PHASE I  
 WHAN ROAD TO EVERT ROAD PIPING  
 PLAN AND PROFILE - STA. 11+00 TO 17+21

ADDITIVE ALTERNATIVE B

SHEET  
**58**

C:\BENTON\101199\_136\_PRESSURE\_IMPROVEMENT.dwg, PLOT: 11/19/2012 2:31:50 PM