


RECORD DRAWING		BY: E.H.	DATE: 12/11
DESIGNED BY: R. HARRIS	XREFS: TB-BID.dwg		
DRAWN BY: R. RASMUSSEN	JOB NUMBER: 1199-336	DATE: 2009	
REVIEWED BY: H. PERRY	ACAD FILE: WHAN-EVERT-PNP.dwg	COPYRIGHT 2009 BY ANDERSON-PERRY & ASSOC., INC.	

RECORD DRAWINGS

These record drawings have been prepared, in part, on the basis of information compiled and furnished by others. They may contain some discrepancies and omissions, and do not necessarily represent "exact" field conditions. The Owner and the Engineer accept no responsibility for their accuracy.

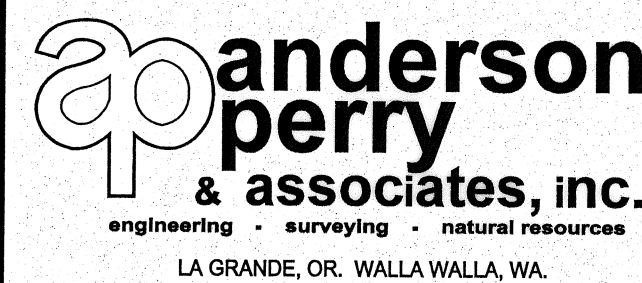

**BENTON IRRIGATION DISTRICT
IRRIGATION SYSTEM IMPROVEMENTS
PHASE I**

WHAN ROAD TO EVERT ROAD PIPING
PLAN AND PROFILE - STA. 1+00 TO 8+30

ADDITIVE ALTERNATIVE B

SHEET

60