


REVISION	BY	DATE
RECORD DRAWING	E.H.	12/11
DESIGNED BY	R. HARRIS	
DRAWN BY	R. RASMUSSEN	
REVIEWED BY	H. PERRY	

HORIZ. SCALE	1"=50'
VERT. SCALE	1"=10'
JOB NUMBER	1199-336
DATE	2009
ACAD FILE	WHAN-EVERT-PNP.dwg
COPYRIGHT 2009 BY ANDERSON-PERRY & ASSOC., INC.	

**RECORD DRAWINGS**  
 These record drawings have been prepared, in part, on the basis of information compiled and furnished by others. They may contain some discrepancies and omissions, and do not necessarily represent "exact" field conditions. The Owner and the Engineer accept no responsibility for their accuracy.

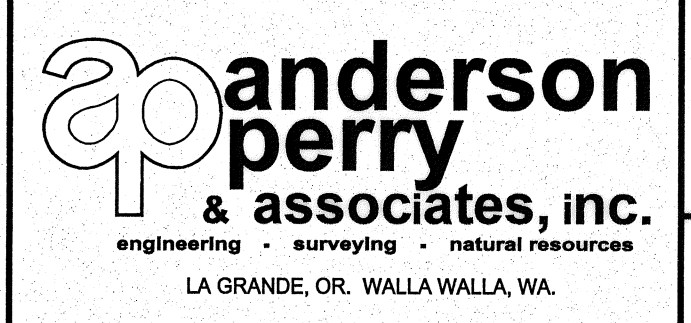

**BENTON IRRIGATION DISTRICT**  
 IRRIGATION SYSTEM IMPROVEMENTS  
 PHASE I  
 WHAN ROAD TO EVERT ROAD PIPING  
 PLAN AND PROFILE - STA. 1+50 TO 5+46

ADDITIONAL ALTERNATIVE B  
 SHEET  
**61**

C:\BENTON\1199\_336\_PIPING\WHAN-EVERT-PNP.dwg, SHEET 61, 12/11/2009 3:38:04 PM