


| | | | | | |
|----------------|--------------|--------|------------|------|-------|
| RECORD DRAWING | | BY | E.H. | DATE | 12/11 |
| DESIGNED BY | R. HARRIS | XREFS: | TB-BID.dwg | | |
| DRAWN BY | R. RASMUSSEN | | | | |
| REVIEWED BY | H. PERRY | | | | |

| | | | |
|---|--------------------|-------------|--------|
| HORIZ. SCALE | 1"=50' | VERT. SCALE | 1"=10' |
| JOB NUMBER | 1199-336 | DATE | 2009 |
| ACAD FILE | WHAN-EVERT-PNP.dwg | | |
| COPYRIGHT 2009 BY ANDERSON-PERRY & ASSOC., INC. | | | |

RECORD DRAWINGS

These record drawings have been prepared, in part, on the basis of information compiled and furnished by others. They may contain some discrepancies and omissions, and do not necessarily represent "exact" field conditions. The Owner and the Engineer accept no responsibility for their accuracy.

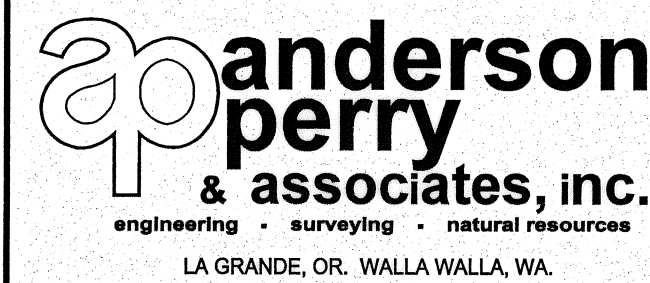

**BENTON IRRIGATION DISTRICT
IRRIGATION SYSTEM IMPROVEMENTS
PHASE I**

WHAN ROAD TO EVERT ROAD PIPING
PLAN AND PROFILE - STA. 0+98 TO 8+28

ADDITIVE ALTERNATIVE B

SHEET

62

C:\BENTON\11199_336_PIPING\WHAN-EVERT-PNP.dwg, SHEET, 6/19/2012 3:29:50 PM