


RECORD DRAWING		E.H. 12/11
DESIGNED BY R. HARRIS	XREFS: TB-BID.dwg	DATE
DRAWN BY R. RASMUSSEN		DATE
REVIEWED BY H. PERRY		

HORIZ. SCALE 1"=50'	VERT. SCALE 1"=10'
JOB NUMBER 1199-336	DATE 2009
ACAD FILE DAVIS-EVERT-PNP.dwg	
COPYRIGHT 2009 BY ANDERSON-PERRY & ASSOC., INC.	

RECORD DRAWINGS
These record drawings have been prepared, in part, on the basis of information compiled and furnished by others. They may contain some discrepancies and omissions, and do not necessarily represent "exact" field conditions. The Owner and the Engineer accept no responsibility for their accuracy.

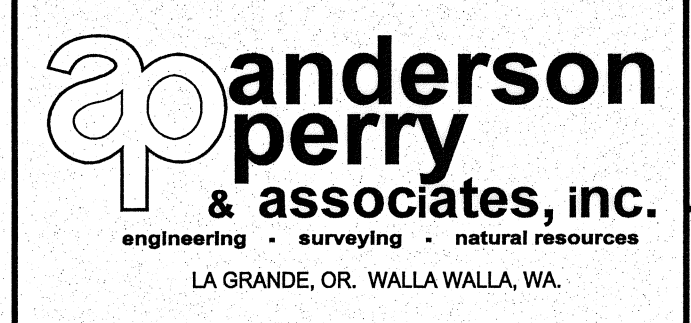

BENTON IRRIGATION DISTRICT
IRRIGATION SYSTEM IMPROVEMENTS
PHASE I
DAVIS ROAD TO EVERT ROAD PIPING
PLAN AND PROFILE - STA. 27+00 TO 40+00