



EXISTING IRRIGATION LINE TO BE ABANDONED WITH ADDITIVE ALTERNATIVE B. REMOVE AND PLUG AS REQUIRED FOR NEW LINE INSTALLATION.

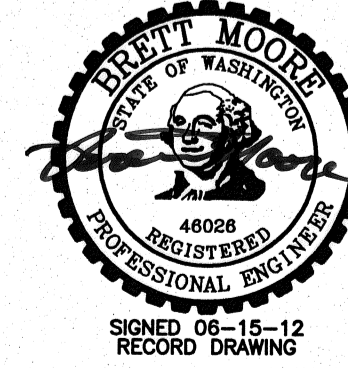

RECORD DRAWING		BY: E.H.	DATE: 12/11
DESIGNED BY: R. HARRIS	XREFS: TB-BID.dwg		
DRAWN BY: R. RASMUSSEN	JOB NUMBER: 1199-336		
REVIEWED BY: H. PERRY	DATE: 2009		
ACAD FILE: DAVIS-EVERT-PNP.dwg		SCALE IN FEET: 1"=50'	
COPYRIGHT 2009 BY ANDERSON-PERRY & ASSOC., INC.		SCALE IN FEET: 1"=10'	

RECORD DRAWINGS
 These record drawings have been prepared, in part, on the basis of information compiled and furnished by others. They may contain some discrepancies and omissions, and do not necessarily represent "exact" field conditions. The Owner and the Engineer accept no responsibility for their accuracy.

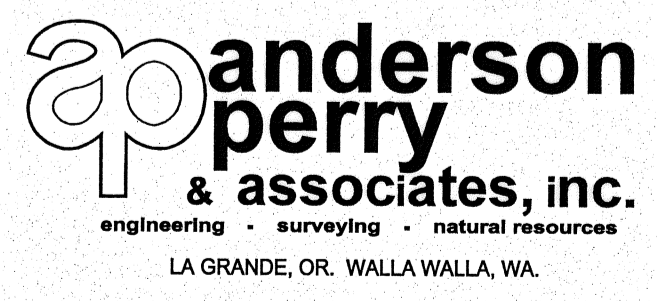

BENTON IRRIGATION DISTRICT
 IRRIGATION SYSTEM IMPROVEMENTS
 PHASE I
 DAVIS ROAD TO EVERT ROAD PIPING
 PLAN AND PROFILE - STA. 40+00 TO 48+71

ADDITIVE ALTERNATIVE A

SHEET

66