


RECORD DRAWING		E.H.	12/11
HORZ. ALIGNMENT ADJUSTMENT		R.H.	1/10
DESIGNED BY	R. HARRIS	DATE	2009
DRAWN BY	R. RASMUSSEN	DATE	2009
REVIEWED BY	H. PERRY	DATE	2009
XREFS: TB-BID.dwg		JOB NUMBER 1199-336	
ACAD FILE: WILLIAMS_EAST-PNP.dwg		DATE: 2009	
COPYRIGHT 2009 BY ANDERSON-PERRY & ASSOC., INC.			

RECORD DRAWINGS
 These record drawings have been prepared, in part, on the basis of information compiled and furnished by others. They may contain some discrepancies and omissions, and do not necessarily represent "exact" field conditions. The Owner and the Engineer accept no responsibility for their accuracy.

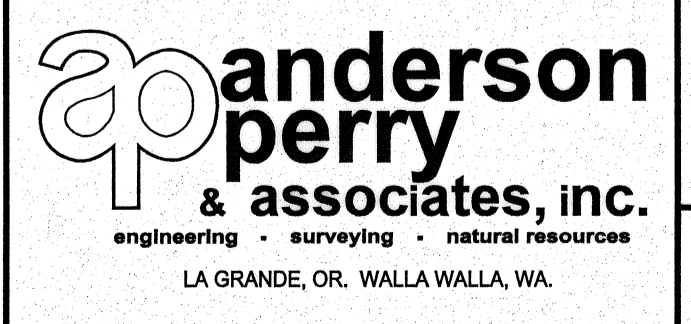

BENTON IRRIGATION DISTRICT
 IRRIGATION SYSTEM IMPROVEMENTS
 PHASE I
 WILLIAMS ROAD PIPING
 PLAN AND PROFILE - STA. 1+00 TO 14+00

BASE BID
 SHEET
68