


REVISION	BY	DATE	HORIZ. SCALE 1"=50'	VERT. SCALE 1"=10'
RECORD DRAWING	E.H.	12/11	1"=50'	1"=10'
HORIZ. ALIGNMENT ADJUSTMENT	R.H.	2/10	1"=50'	1"=10'
HORIZ. ALIGNMENT ADJUSTMENT	R.H.	1/10	1"=50'	1"=10'
DESIGNED BY	R. HARRIS			
DRAWN BY	D. CHRISTMAN			
REVIEWED BY	H. PERRY			

JOB NUMBER	1199-336	DATE	2009
ACAD FILE	WILLIAMS_EAST-PNP.dwg		
COPYRIGHT 2009 BY ANDERSON-PERRY & ASSOC., INC.			

RECORD DRAWINGS
 These record drawings have been prepared, in part, on the basis of information compiled and furnished by others. They may contain some discrepancies and omissions, and do not necessarily represent "exact" field conditions. The Owner and the Engineer accept no responsibility for their accuracy.

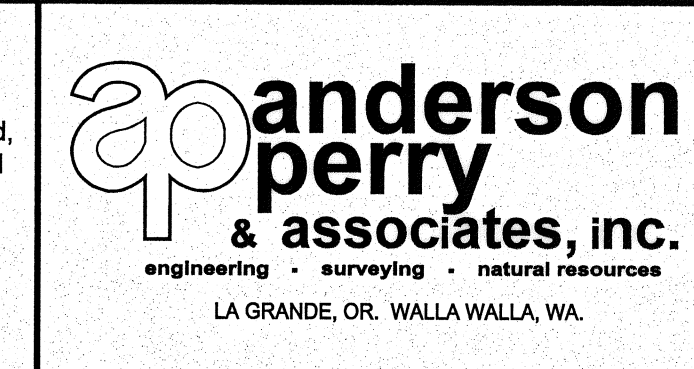

BENTON IRRIGATION DISTRICT
 IRRIGATION SYSTEM IMPROVEMENTS
 PHASE I
 WILLIAMS ROAD PIPING
 PLAN AND PROFILE - STA. 14+00 TO 28+00

BASE BID
 SHEET
69