



RECORD DRAWING		BY	E.H.	DATE	12/11
DESIGNED BY	R. HARRIS	XREFS:	TB-BID.dwg	JOB NUMBER	1199-336
DRAWN BY	D. CHRISTMAN	ACAD FILE	WILLIAMS_EAST-PNP.dwg	DATE	2009
REVIEWED BY	H. PERRY	COPYRIGHT 2009 BY ANDERSON-PERRY & ASSOC., INC.			

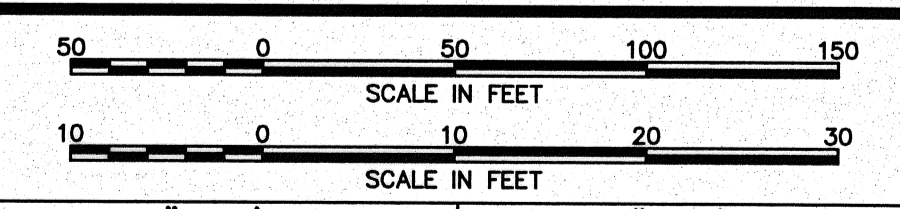

**RECORD DRAWINGS**  
 These record drawings have been prepared, in part, on the basis of information compiled and furnished by others. They may contain some discrepancies and omissions, and do not necessarily represent "exact" field conditions. The Owner and the Engineer accept no responsibility for their accuracy.

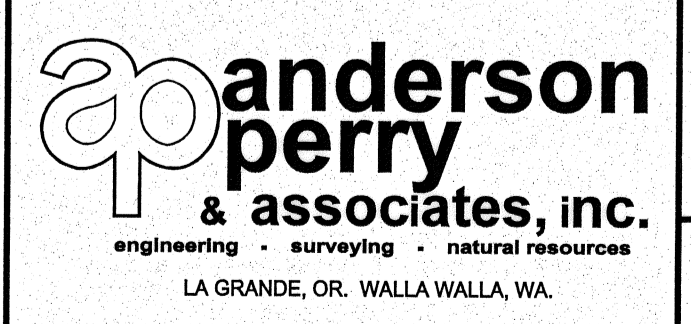

**BENTON IRRIGATION DISTRICT**  
 IRRIGATION SYSTEM IMPROVEMENTS  
 PHASE I  
 WILLIAMS ROAD PIPING  
 PLAN AND PROFILE - STA. 28+00 TO 41+35

BASE BID SHEET  
**70**