



RECORD DRAWING		BY	E.H.	DATE	12/11
DESIGNED BY	R. HARRIS	XREFS:	TB-BID.dwg		
DRAWN BY	D. CHRISTMAN	JOB NUMBER	1199-336	DATE	2009
REVIEWED BY	H. PERRY	ACAD FILE:	WILLIAMS_SOUTH-PNP.dwg		
COPYRIGHT 2009 BY ANDERSON-PERRY & ASSOC., INC.					

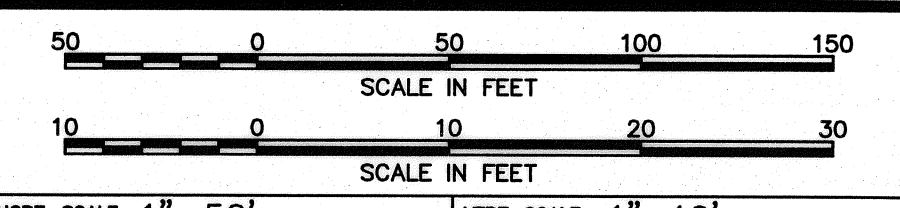

**RECORD DRAWINGS**  
These record drawings have been prepared, in part, on the basis of information compiled and furnished by others. They may contain some discrepancies and omissions, and do not necessarily represent "exact" field conditions. The Owner and the Engineer accept no responsibility for their accuracy.

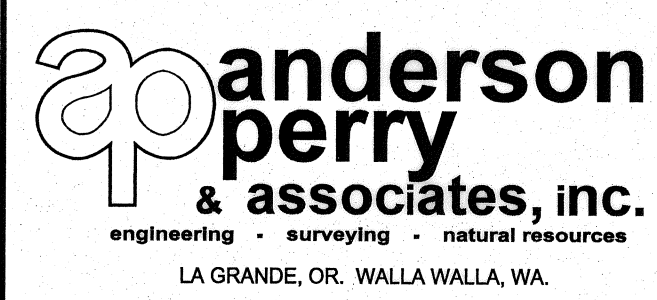

**BENTON IRRIGATION DISTRICT**  
IRRIGATION SYSTEM IMPROVEMENTS  
PHASE I  
**WILLIAMS ROAD SOUTH PIPING**  
PLAN AND PROFILE - STA. 0+49 TO 15+00

BASE BID
SHEET
<b>71</b>