



| | | | | | |
|-----------------------|--------------|------------|---------------------------------------|------|-------|
| RECORD DRAWING | | BY | E.H. | DATE | 12/11 |
| DESIGNED BY | R. HARRIS | XREFS: | TB-BID.dwg | | |
| DRAWN BY | R. RASMUSSEN | JOB NUMBER | 1199-336 | | |
| REVIEWED BY | H. PERRY | DATE | 2009 | | |
| | | ACAD FILE: | HIGHLAND-ACCORD-PNP.dwg | | |
| | | COPYRIGHT | 2009 BY ANDERSON-PERRY & ASSOC., INC. | | |

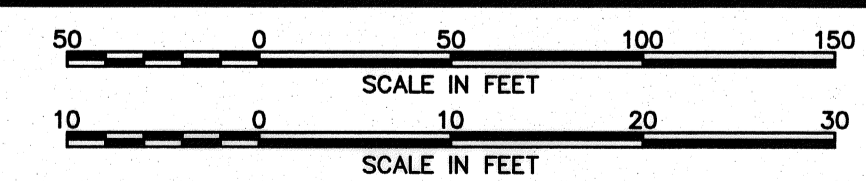

RECORD DRAWINGS

These record drawings have been prepared, in part, on the basis of information compiled and furnished by others. They may contain some discrepancies and omissions, and do not necessarily represent "exact" field conditions. The Owner and the Engineer accept no responsibility for their accuracy.

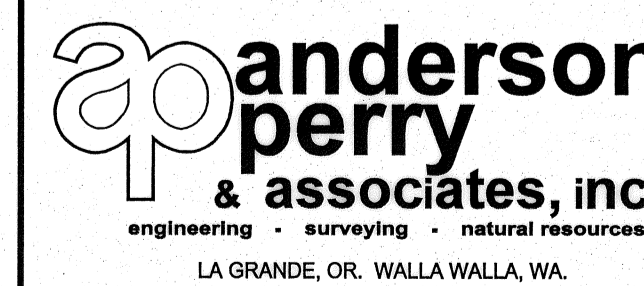

BENTON IRRIGATION DISTRICT
IRRIGATION SYSTEM IMPROVEMENTS
PHASE I

HIGHLAND ROAD TO ACORD ROAD PIPING
PLAN AND PROFILE - STA. 15+00 TO 29+00

ADDITIVE ALTERNATIVE B

SHEET

77

ARCHIVED