



HYDROSEED SURFACE RESTORATION

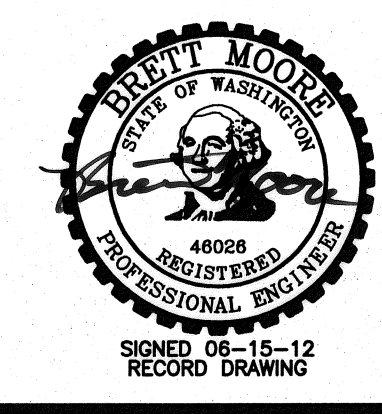

RECORD DRAWING		BY	E.H.	DATE	12/11
DESIGNED BY	R. HARRIS	XREFS: TB-BID.dwg			
DRAWN BY	R. RASMUSSEN	JOB NUMBER	1199-336	DATE	2009
REVIEWED BY	H. PERRY	ACAD FILE	HIGHLAND-ACCORD-PNP.dwg		
COPYRIGHT 2009 BY ANDERSON-PERRY & ASSOC., INC.					

**RECORD DRAWINGS**  
 These record drawings have been prepared, in part, on the basis of information compiled and furnished by others. They may contain some discrepancies and omissions, and do not necessarily represent "exact" field conditions. The Owner and the Engineer accept no responsibility for their accuracy.

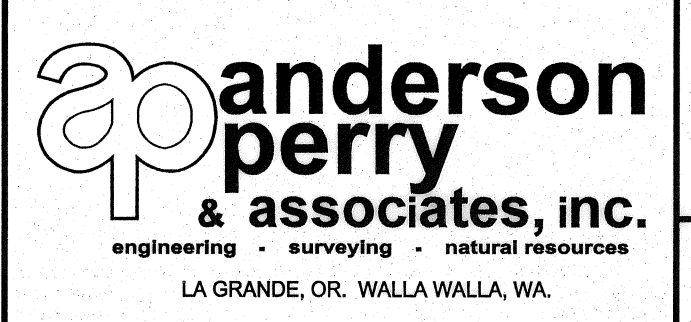

**BENTON IRRIGATION DISTRICT**  
 IRRIGATION SYSTEM IMPROVEMENTS  
 PHASE I  
 HIGHLAND ROAD TO ACORD ROAD PIPING  
 PLAN AND PROFILE - STA. 57+00 TO 71+00

ADDITIVE ALTERNATIVE B  
 SHEET  
**80**

ARCHIVED