


REVISION	BY	DATE
RECORD DRAWING	E.H.	12/11
DESIGNED BY	R. PARRIS	
DRAWN BY	R. RASMUSSEN	
REVIEWED BY	H. PERRY	

XREFS: TB-BID.dwg	JOB NUMBER: 1199-336	DATE: 2009
ACAD FILE: HIGHLAND-ACCORD-PNP.dwg	COPYRIGHT 2009 BY ANDERSON-PERRY & ASSOC., INC.	

RECORD DRAWINGS
 These record drawings have been prepared, in part, on the basis of information compiled and furnished by others. They may contain some discrepancies and omissions, and do not necessarily represent "exact" field conditions. The Owner and the Engineer accept no responsibility for their accuracy.

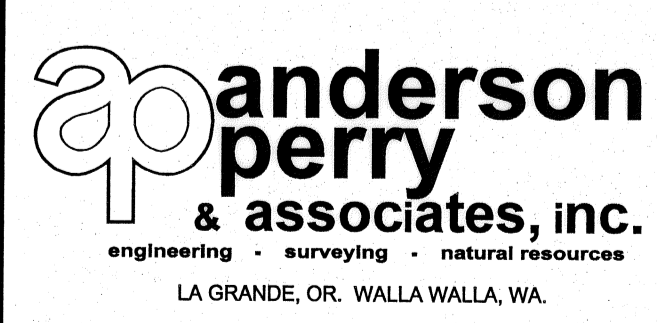

BENTON IRRIGATION DISTRICT
 IRRIGATION SYSTEM IMPROVEMENTS
 PHASE I
 HIGHLAND ROAD TO ACORD ROAD PIPING
 PLAN AND PROFILE - STA. 71+00 TO 85+00

ADDITIVE ALTERNATIVE A
 SHEET
81

ARCHIVED