



RECORD DRAWING		BY	E.H.	DATE	12/11
DESIGNED BY	R. HARRIS	XREFS:	TB-BID.dwg		
DRAWN BY	R. RASMUSSEN	JOB NUMBER	1199-336		
REVIEWED BY	H. PERRY	ACAD FILE	HIGHLAND-ACCORD-SUBS.dwg		
		DATE	2009		

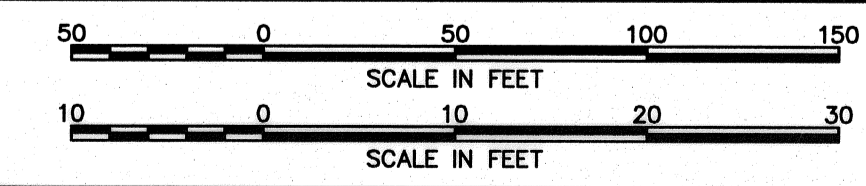

HORZ. SCALE 1"=50'  
 VERT. SCALE 1"=10'  
 JOB NUMBER 1199-336  
 DATE 2009  
 ACAD FILE HIGHLAND-ACCORD-SUBS.dwg  
 COPYRIGHT 2009 BY ANDERSON-PERRY & ASSOC., INC.

**RECORD DRAWINGS**

These record drawings have been prepared, in part, on the basis of information compiled and furnished by others. They may contain some discrepancies and omissions, and do not necessarily represent "exact" field conditions. The Owner and the Engineer accept no responsibility for their accuracy.

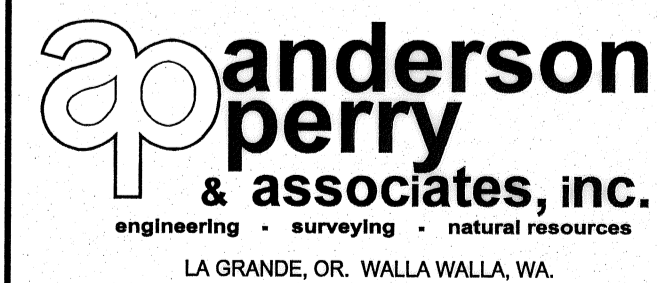

**BENTON IRRIGATION DISTRICT  
 IRRIGATION SYSTEM IMPROVEMENTS  
 PHASE I**

HIGHLAND ROAD TO ACORD ROAD PIPING  
 PLAN AND PROFILE - STA. 1+00 TO 7+80

ADDITIVE ALTERNATIVE B

SHEET

**83**

ARCHIVED