


REVISION	BY	DATE
RECORD DRAWING	E.H.	12/11
DESIGNED BY	R. HARRIS	
DRAWN BY	R. RASMUSSEN	
REVIEWED BY	H. PERRY	

JOB NUMBER	1199-336
DATE	2009
ACAD FILE	HIGHLAND-ACCORD-SUBS.dwg
COPYRIGHT 2009 BY ANDERSON-PERRY & ASSOC., INC.	

**RECORD DRAWINGS**  
 These record drawings have been prepared, in part, on the basis of information compiled and furnished by others. They may contain some discrepancies and omissions, and do not necessarily represent "exact" field conditions. The Owner and the Engineer accept no responsibility for their accuracy.

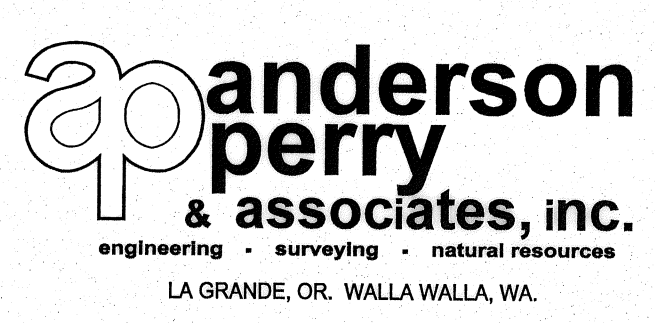

**BENTON IRRIGATION DISTRICT**  
 IRRIGATION SYSTEM IMPROVEMENTS  
 PHASE I  
 HIGHLAND ROAD TO ACORD ROAD PIPING  
 PLAN AND PROFILE - STA. 6+00 TO 18+50

ADDITIVE ALTERNATIVE B  
 SHEET  
**91**