


RECORD DRAWING		BY	E.H.	DATE	4/12
DESIGNED BY	R. HARRIS	XREFs: TB-BID.dwg			
DRAWN BY	D. CHRISTMAN				
REVIEWED BY	J. HOLLOPETER				

HORIZ. SCALE	1" = 50'
VERT. SCALE	1" = 10'
JOB NUMBER	1199-336
DATE	2010
ACAD FILE:	EVRT-HRN-SB3.dwg
COPYRIGHT 2010 BY ANDERSON-PERRY & ASSOC., INC.	

RECORD DRAWINGS
 These record drawings have been prepared, in part, on the basis of information compiled and furnished by others. They may contain some discrepancies and omissions, and do not necessarily represent "exact" field conditions. The Owner and the Engineer accept no responsibility for their accuracy.

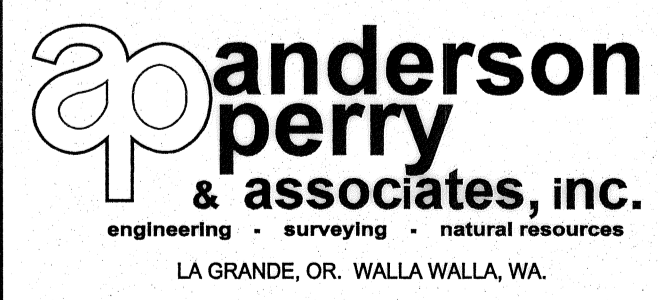

BENTON IRRIGATION DISTRICT
 IRRIGATION SYSTEM IMPROVEMENTS
 PHASE 2A
 NORTH EAST - HORNE DR. PIPING
 STA. 1+00 TO STA. 12+04

SHEET
3

ARCHIVED