


WORK ITEMS

- (C) EXISTING IRRIGATION LINE ALONG ALIGNMENT TO BE ABANDONED. REMOVE AND PLUG AS REQUIRED FOR NEW LINE INSTALLATION.
- (E) UNDERGROUND TELEPHONE ALONG ALIGNMENT. COORDINATE WITH UTILITY PRIOR TO, AND DURING CONSTRUCTION.


NOTE:
 MAINTAIN 2.5' MIN. COVER AND GRADE TO DRAIN AWAY FROM MAIN LINE

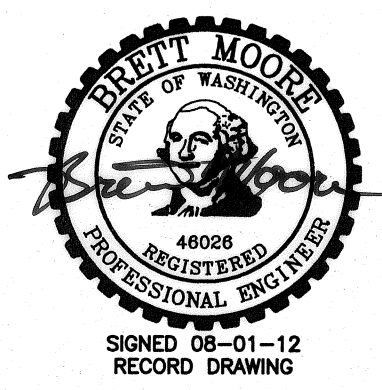

REVISION		BY	DATE
RECORD DRAWING		E.H.	4/12
DESIGNED BY	XREFS: TB-BID.dwg		
DRAWN BY	E. ARNTZ		
REVIEWED BY	J. HOLLOPETER		

50 0 50 100 150	
SCALE IN FEET	
10 0 20 30	
SCALE IN FEET	
HORIZ. SCALE 1"=50'	VERT. SCALE 1"=10'
JOB NUMBER 1199-336	DATE 2010
ACAD FILE: North_East_A.dwg	
COPYRIGHT 2010 BY ANDERSON-PERRY & ASSOC., INC.	

RECORD DRAWINGS
 These record drawings have been prepared, in part, on the basis of information compiled and furnished by others. They may contain some discrepancies and omissions, and do not necessarily represent "exact" field conditions. The Owner and the Engineer accept no responsibility for their accuracy.

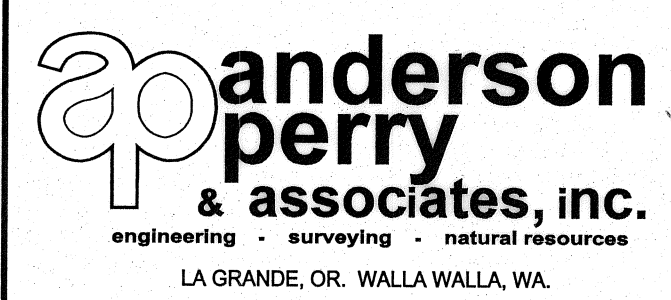

BENTON IRRIGATION DISTRICT
 IRRIGATION SYSTEM IMPROVEMENTS
 PHASE 2A
 NORTH EAST - HARRISON LOOP NORTH PIPING
 STA. 1+00 TO STA. 9+60

SHEET
7