


RECORD DRAWING		E.H. 4/12	
DESIGNED BY R. HARRIS	XREFS: TB-BID.dwg	JOB NUMBER 1199-336	DATE 2010
DRAWN BY E. ARNTZ		ACAD FILE North_East_A.dwg	
REVIEWED BY J. HOLLOPETER		COPYRIGHT 2010 BY ANDERSON-PERRY & ASSOC., INC.	

**RECORD DRAWINGS**  
 These record drawings have been prepared, in part, on the basis of information compiled and furnished by others. They may contain some discrepancies and omissions, and do not necessarily represent "exact" field conditions. The Owner and the Engineer accept no responsibility for their accuracy.

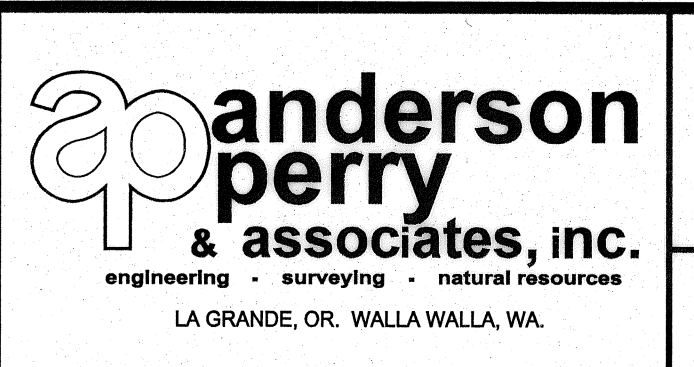

**BENTON IRRIGATION DISTRICT**  
 IRRIGATION SYSTEM IMPROVEMENTS  
 PHASE 2A  
 NORTH EAST - HORNE ROAD NORTH PIPING  
 STA. 1+00 TO STA. 13+00

SHEET  
**10**