



NOTE:  
 MAINTAIN 2.5' MIN. COVER  
 AND GRADE TO DRAIN  
 AWAY FROM AIR/VAC VALVE

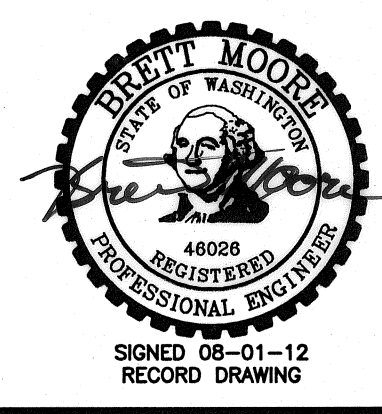

REVISION		BY		DATE		HORIZ. SCALE 1"=50'		VERT. SCALE 1"=10'	
RECORD DRAWING		E.H.		4/12		50 0 50 100 150		SCALE IN FEET	
DESIGNED BY R. HARRIS		XREFs: TB-BID.dwg		JOB NUMBER 1199-336		DATE 2010		10 0 10 20 30	
DRAWN BY E. ARNTZ				ACAD FILE: North_East_A.dwg				SCALE IN FEET	
REVIEWED BY J. HOLLOPETER				COPYRIGHT 2010 BY ANDERSON-PERRY & ASSOC., INC.					

**RECORD DRAWINGS**  
 These record drawings have been prepared, in part, on the basis of information compiled and furnished by others. They may contain some discrepancies and omissions, and do not necessarily represent "exact" field conditions. The Owner and the Engineer accept no responsibility for their accuracy.

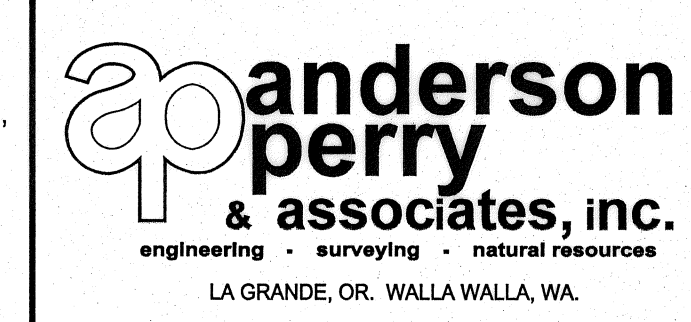

**BENTON IRRIGATION DISTRICT**  
 IRRIGATION SYSTEM IMPROVEMENTS  
 PHASE 2A  
 NORTH EAST - HORNE DRIVE NORTH PIPING  
 STA. 1+00 TO STA. 4+50

SHEET  
**13**

ARCHIVED