



- WORK ITEMS**
- (A) EXISTING IRRIGATION LINE ALONG OR CROSSING ALIGNMENT. EXACT LOCATION UNKNOWN. REMOVE AND PLUG AS REQUIRED FOR NEW LINE INSTALLATION.

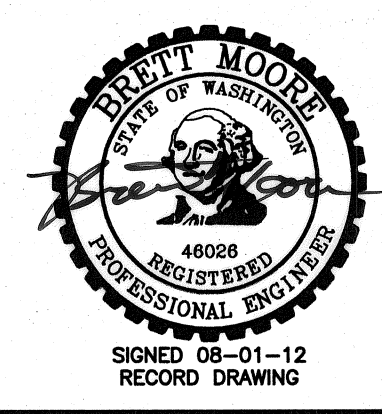

ADDENDUM NO. 1	R.H.	9/10	50 0 50 100 150 SCALE IN FEET	10 0 20 30 SCALE IN FEET
DESIGNED BY R. HARRIS	DATE	DATE	HORIZ. SCALE 1"=50'	VERT. SCALE 1"=10'
DRAWN BY E. ARNTZ	DATE	DATE	JOB NUMBER 1199-336	DATE 2010
REVIEWED BY J. HOLLOPETER	DATE	DATE	ACAD FILE: North_East_B.dwg	
COPYRIGHT 2010 BY ANDERSON-PERRY & ASSOC., INC.				

RECORD DRAWINGS
These record drawings have been prepared, in part, on the basis of information compiled and furnished by others. They may contain some discrepancies and omissions, and do not necessarily represent "exact" field conditions. The Owner and the Engineer accept no responsibility for their accuracy.

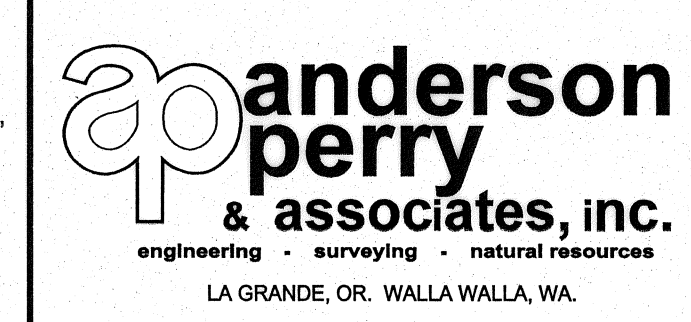

BENTON IRRIGATION DISTRICT
IRRIGATION SYSTEM IMPROVEMENTS
PHASE 2A
NORTH EAST - HORNE TO HIGHLAND EXT. PIPING
STA. 11+00 TO STA. 23+00