



**NOTE:**  
 MAINTAIN 2.5' MIN. COVER  
 AND GRADE TO DRAIN BACK  
 TO MAIN LINE (WEST) AND  
 AWAY FROM MAIN LINE (EAST)

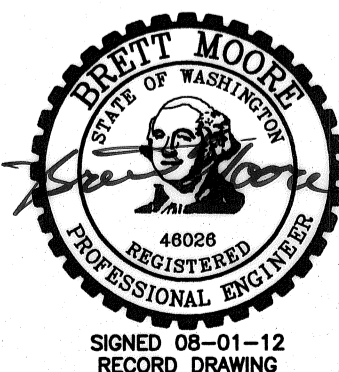

REVISION	BY	DATE	HORIZ. SCALE 1"=50'	VERT. SCALE 1"=10'
DESIGNED BY	R. HARRIS		JOB NUMBER	1199-336
DRAWN BY	E. ARNTZ		DATE	2010
REVIEWED BY	J. HOLLOPETER		ACAD FILE:	North_East_B.dwg
			COPYRIGHT 2010 BY ANDERSON-PERRY & ASSOC., INC.	

**RECORD DRAWINGS**

These record drawings have been prepared, in part, on the basis of information compiled and furnished by others. They may contain some discrepancies and omissions, and do not necessarily represent "exact" field conditions. The Owner and the Engineer accept no responsibility for their accuracy.

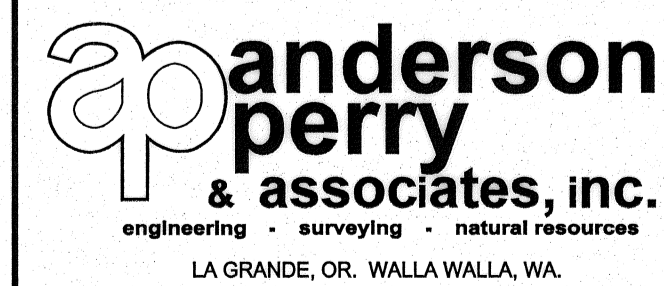

**BENTON IRRIGATION DISTRICT  
 IRRIGATION SYSTEM IMPROVEMENTS  
 PHASE 2A**

**NORTH EAST - HORNE TO HIGHLAND EXT. PIPING  
 STA. 1+00 TO 4+50 (WEST) AND STA. 1+00 TO 4+20 (EAST)**

SHEET

**17**