


WORK ITEMS


- (A) EXISTING IRRIGATION LINE ALONG OR CROSSING ALIGNMENT. EXACT LOCATION UNKNOWN. REMOVE AND PLUG AS REQUIRED FOR NEW LINE INSTALLATION.

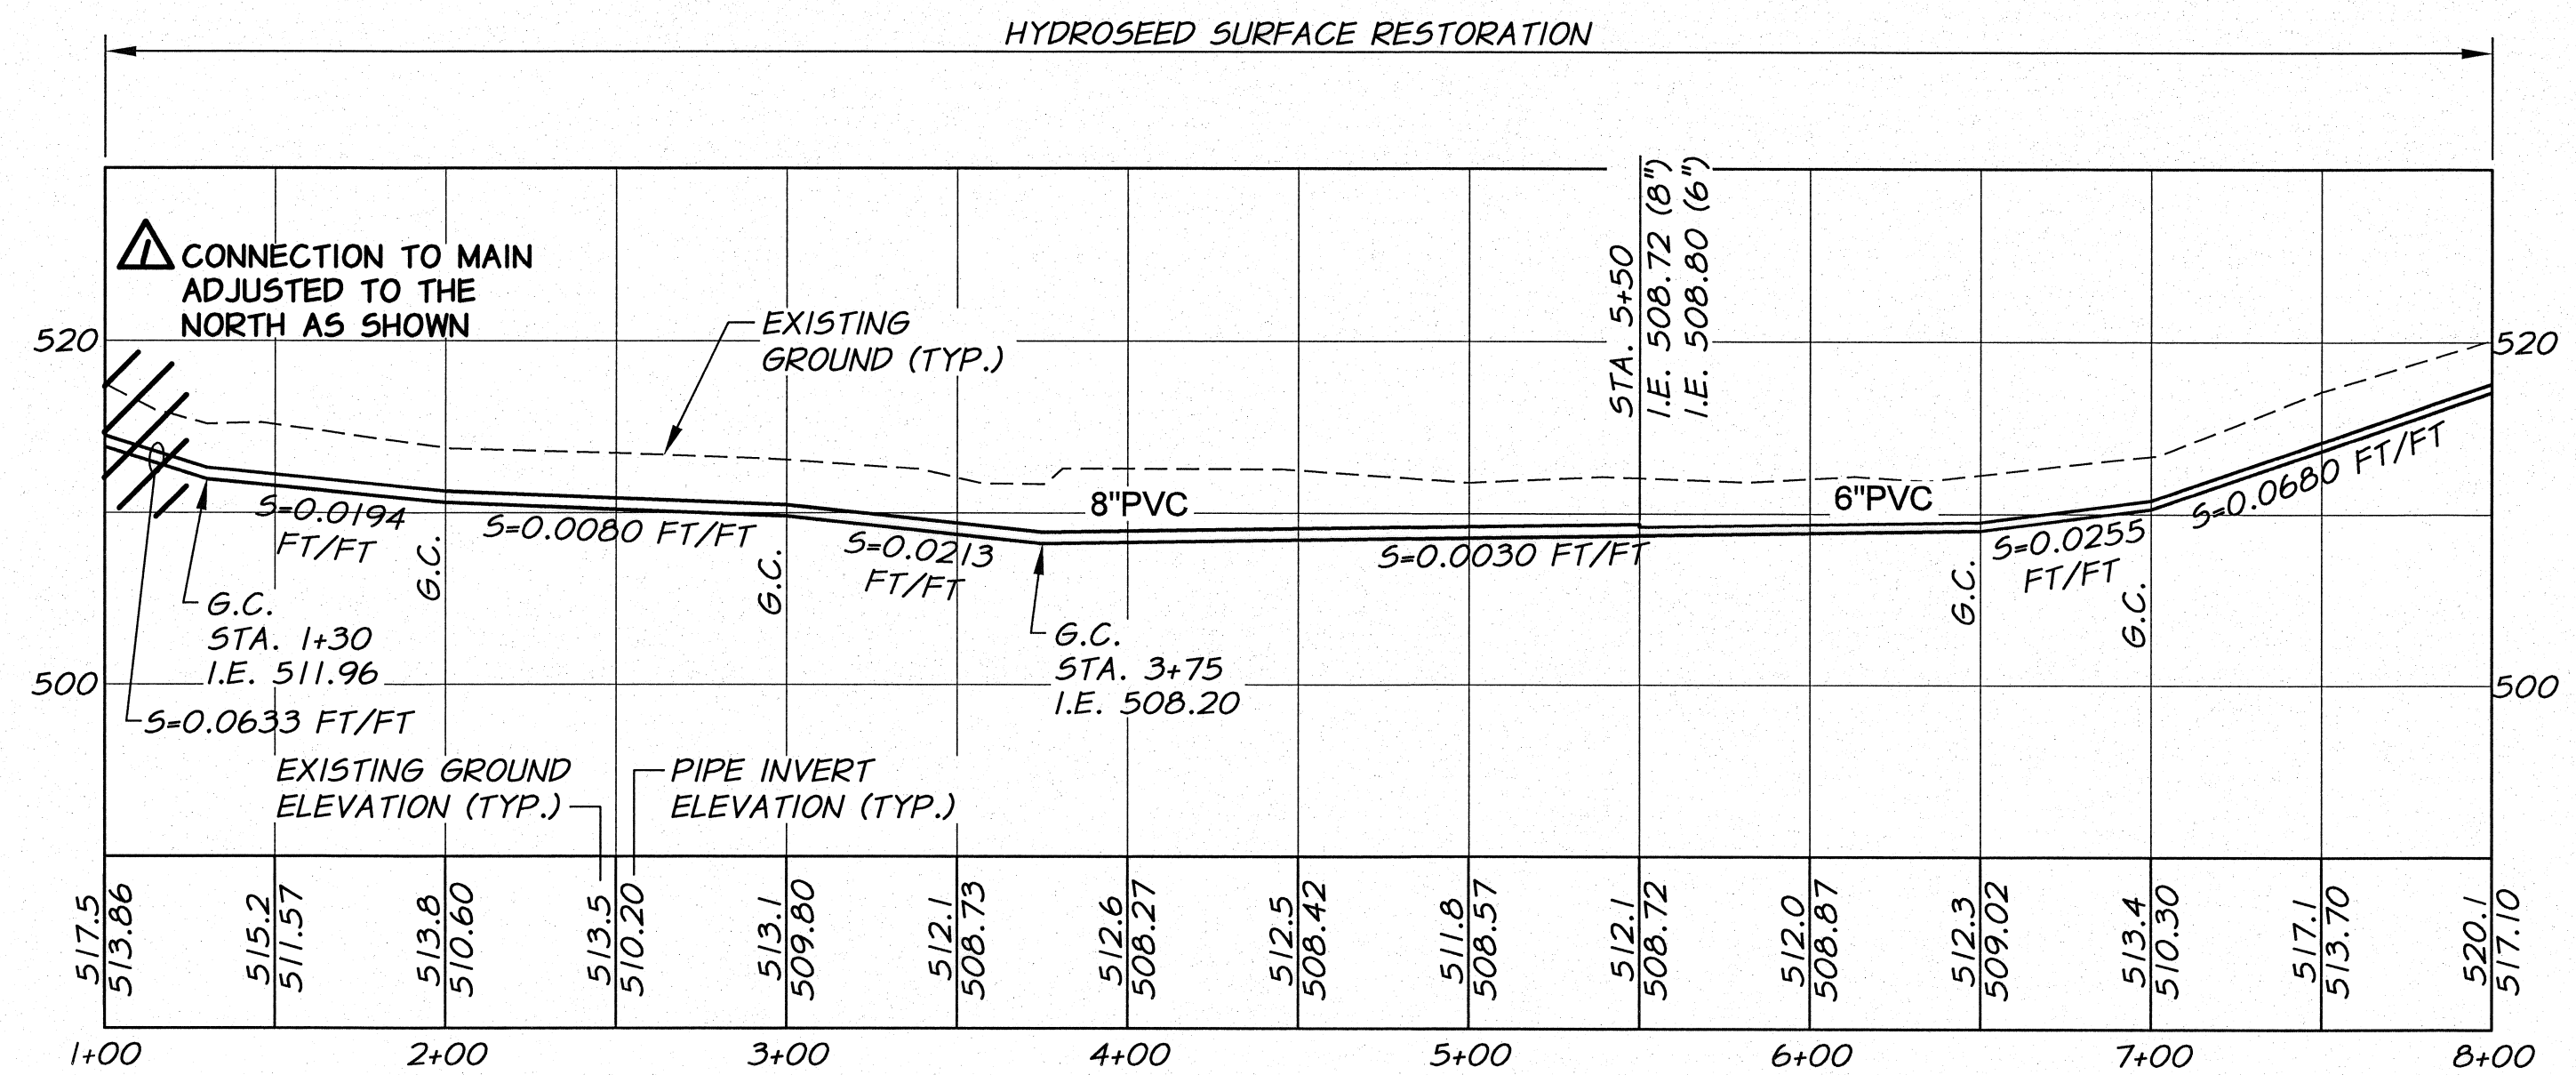

| | | | | | | | | | |
|---------------------------|--|-------------------|--|-------------------------------------------------|--|----------------------------|--|--------------------------|--|
| REVISION | | BY | | DATE | | HORIZ. SCALE 1"=50' | | VERT. SCALE 1"=10' | |
| RECORD DRAWING | | E.H. | | 4/12 | | SCALE IN FEET 0 50 100 150 | | SCALE IN FEET 0 10 20 30 | |
| DESIGNED BY R. HARRIS | | XREFS: TB-BID.dwg | | JOB NUMBER 1199-336 | | DATE 2010 | | | |
| DRAWN BY E. ARNTZ | | | | ACAD FILE: North_East_B.dwg | | | | | |
| REVIEWED BY J. HOLLOPETER | | | | COPYRIGHT 2010 BY ANDERSON-PERRY & ASSOC., INC. | | | | | |

RECORD DRAWINGS

These record drawings have been prepared, in part, on the basis of information compiled and furnished by others. They may contain some discrepancies and omissions, and do not necessarily represent "exact" field conditions. The Owner and the Engineer accept no responsibility for their accuracy.

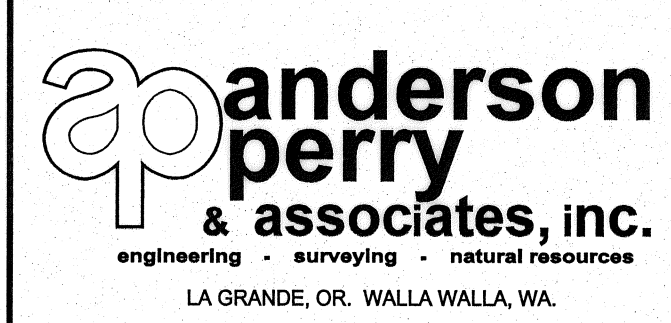

**BENTON IRRIGATION DISTRICT
IRRIGATION SYSTEM IMPROVEMENTS
PHASE 2A**

**NORTH EAST - HORNE TO HIGHLAND EXT. PIPING
STA. 1+00 TO STA. 8+00**

SHEET
19