
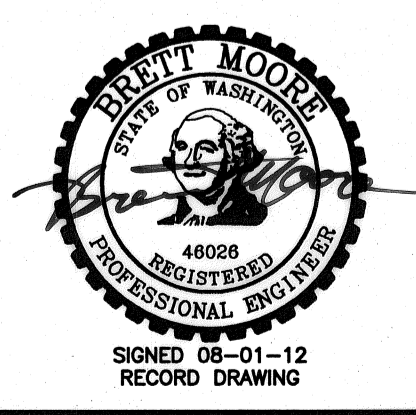


WORK ITEMS


- (A) EXISTING IRRIGATION LINE ALONG OR CROSSING ALIGNMENT. EXACT LOCATION UNKNOWN. REMOVE AND PLUG AS REQUIRED FOR NEW LINE INSTALLATION.
- (C) EXISTING IRRIGATION LINE ALONG ALIGNMENT TO BE ABANDONED. REMOVE AND PLUG AS REQUIRED FOR NEW LINE INSTALLATION.

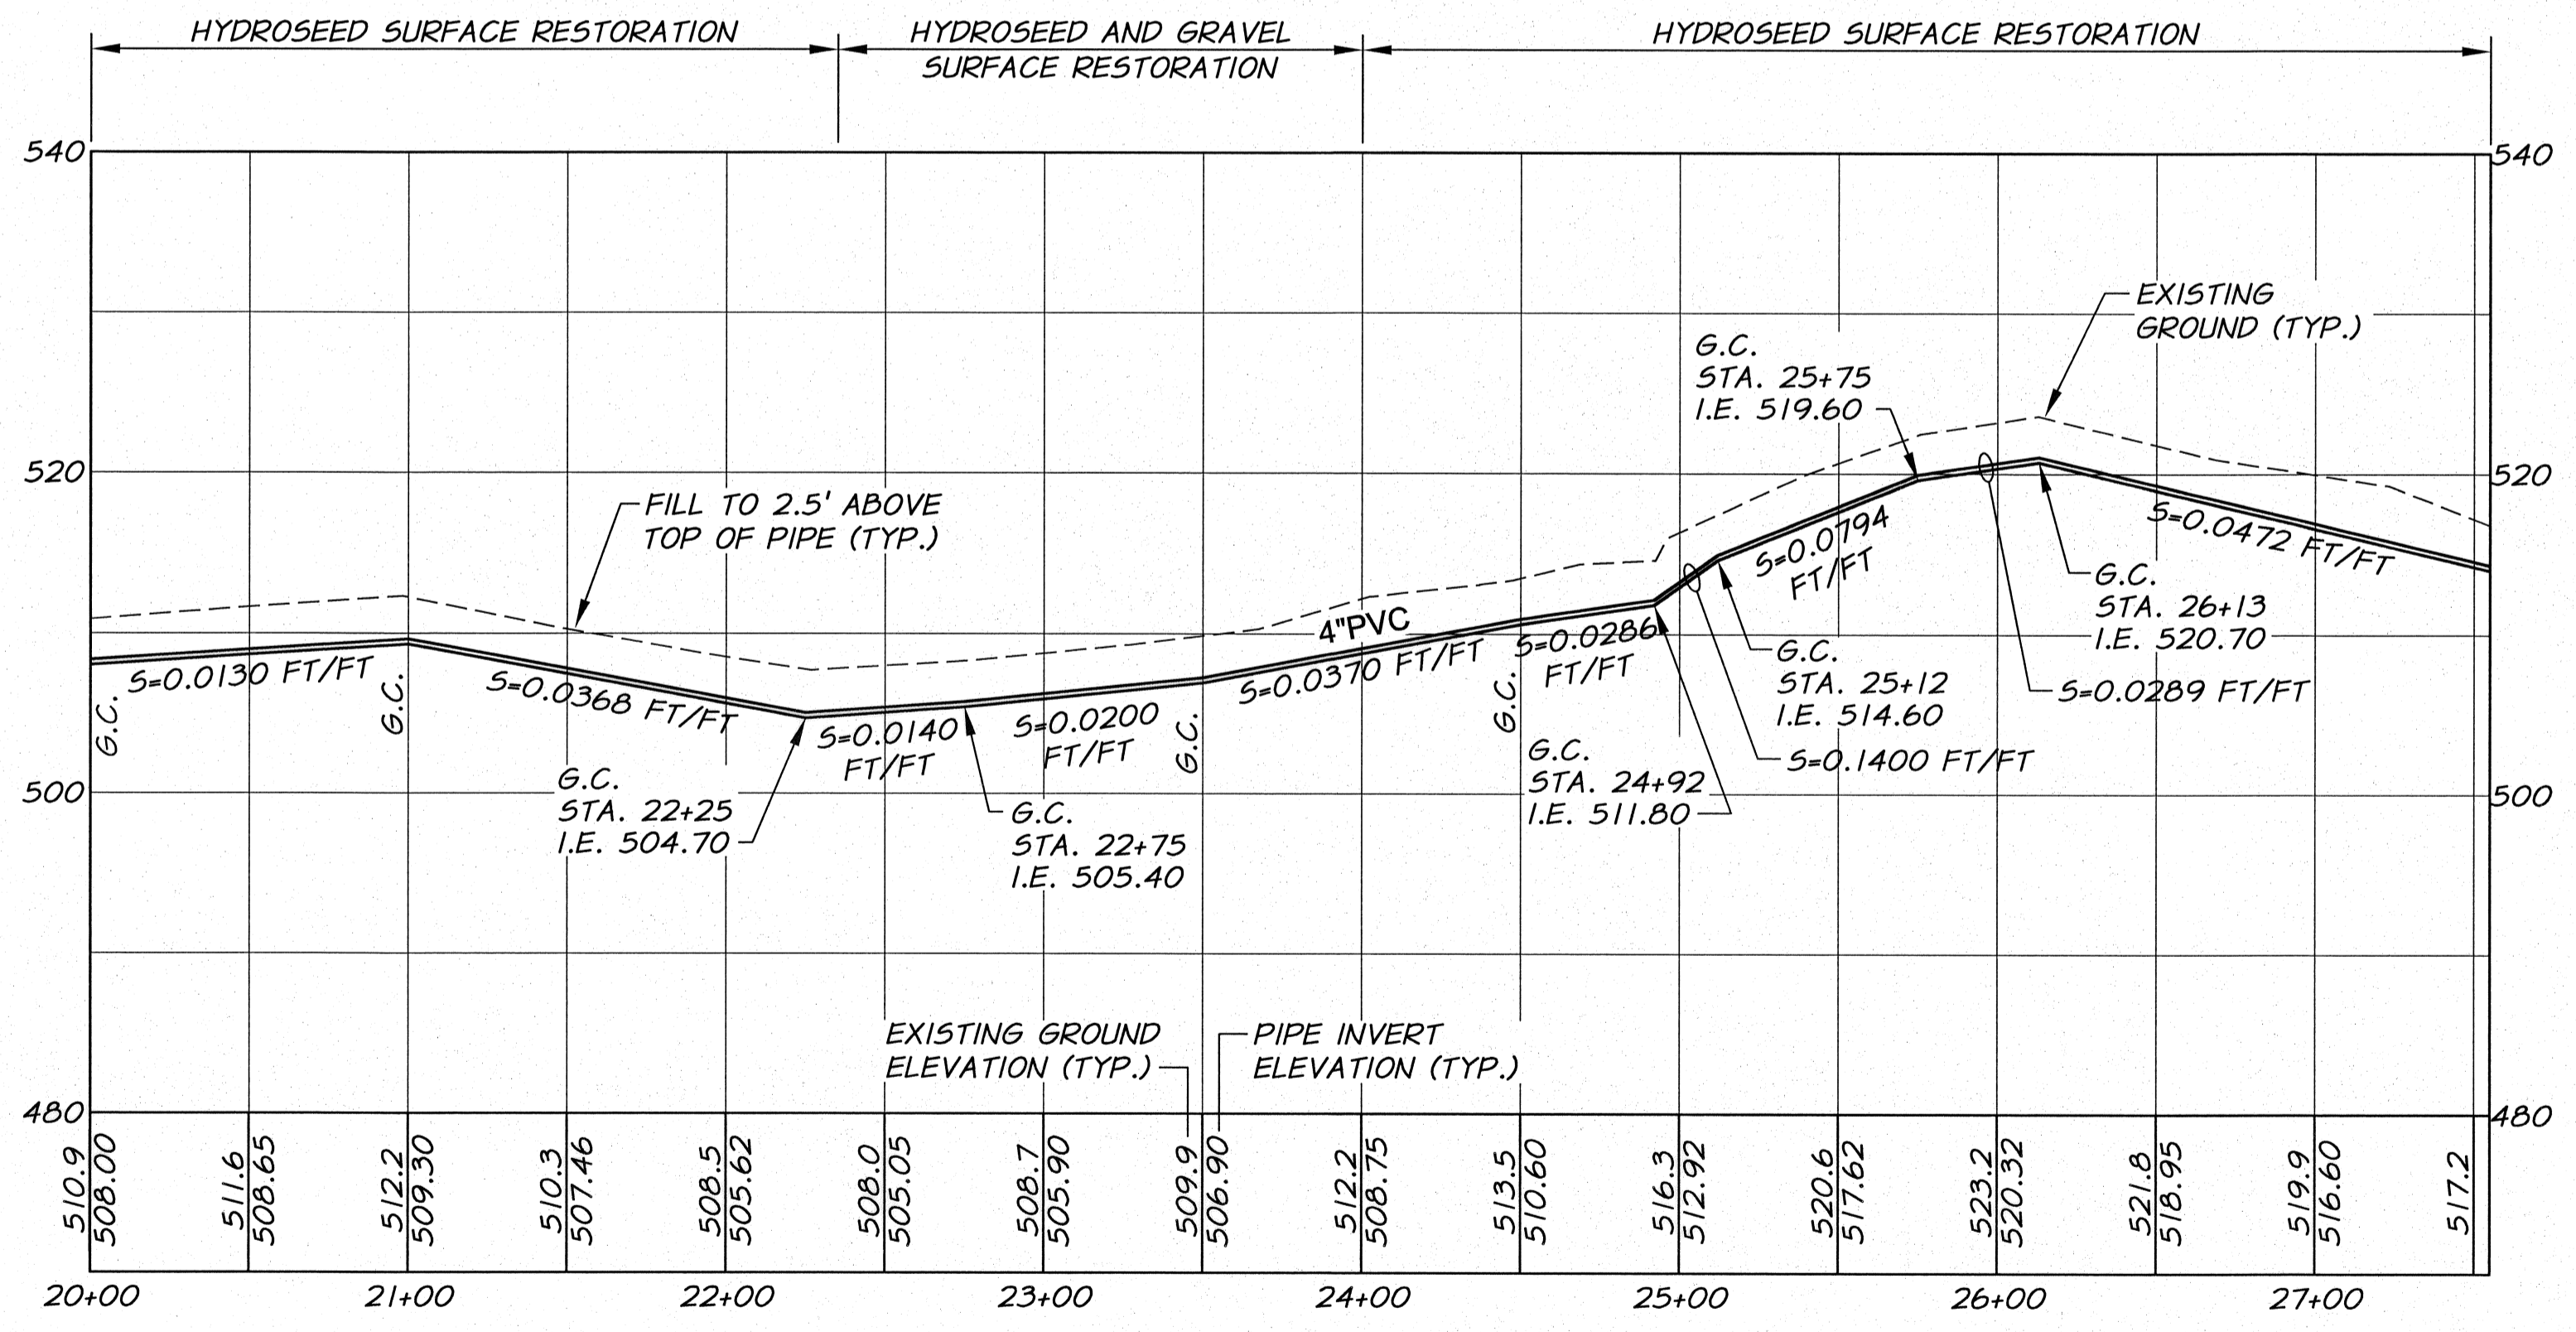

DESIGNED BY	R. HARRIS	BY		DATE	
DRAWN BY	E. ARNTZ	DATE	2010		
REVIEWED BY	J. HOLLOPETER	DATE	2010		
XREFS: TB-BID.dwg		JOB NUMBER	1199-336		
		ACAD FILE:	North_East_B.dwg		
COPYRIGHT 2010 BY ANDERSON-PERRY & ASSOC., INC.					

RECORD DRAWINGS

These record drawings have been prepared, in part, on the basis of information compiled and furnished by others. They may contain some discrepancies and omissions, and do not necessarily represent "exact" field conditions. The Owner and the Engineer accept no responsibility for their accuracy.

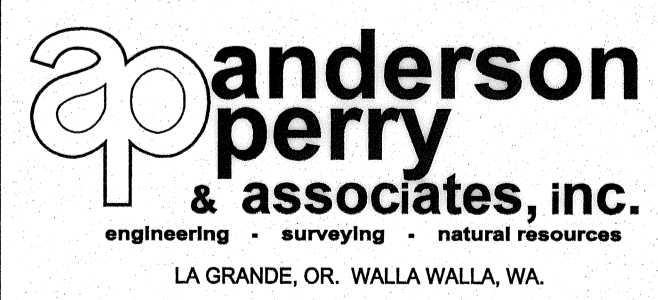

**BENTON IRRIGATION DISTRICT
IRRIGATION SYSTEM IMPROVEMENTS
PHASE 2A**

**NORTH EAST - HORNE TO HIGHLAND EXT. PIPING
STA. 20+00 TO STA. 27+55**

SHEET
21