
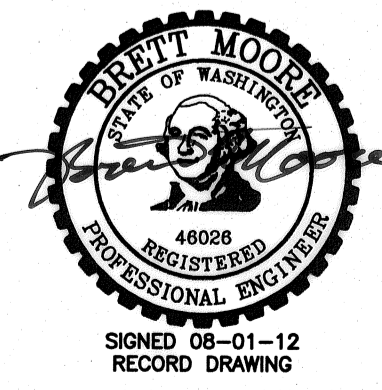


**WORK ITEMS**

(D) REMOVE CONTROL GATE, PIPING, AND CONCRETE STRUCTURE FROM CANAL OUTLET. RESTORE CANAL BANK WITH COMPACTED GENERAL BACKFILL MATERIAL. SHAPE BANK TO MATCH EXISTING. PAID UNDER "IRRIGATION CONTROL STRUCTURE REMOVAL" BID ITEM.

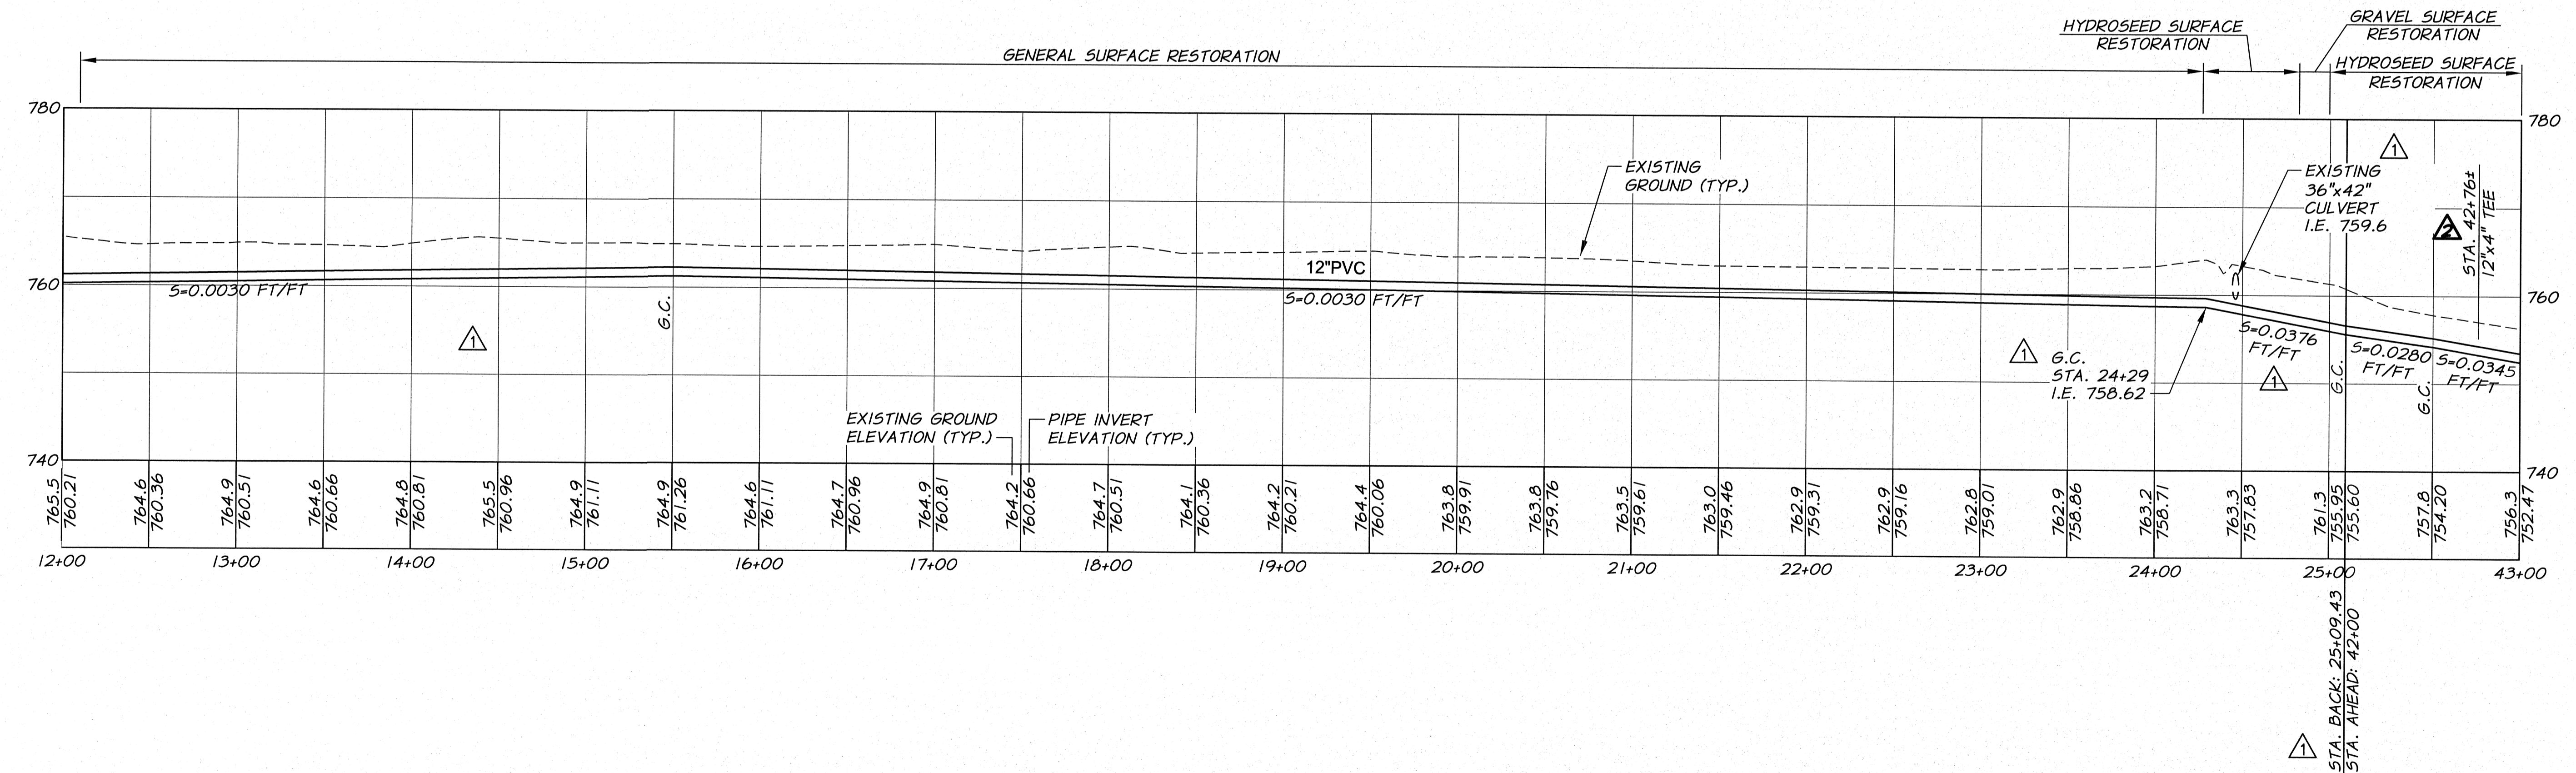


REVISION	BY	DATE
RECORD DRAWING	E.H.	4/12
ADDENDUM NO. 1	R.H.	9/10
DESIGNED BY	R. HARRIS	
DRAWN BY	E. ARNTZ	
REVIEWED BY	J. HOLLOPETER	
XREFS: TB-BID.dwg		

HORIZ. SCALE	1"=50'
VERT. SCALE	1"=10'
JOB NUMBER	1199-336
DATE	2010
ACAD FILE	North_A.dwg
COPYRIGHT 2010 BY ANDERSON-PERRY & ASSOC., INC.	

**RECORD DRAWINGS**

These record drawings have been prepared, in part, on the basis of information compiled and furnished by others. They may contain some discrepancies and omissions, and do not necessarily represent "exact" field conditions. The Owner and the Engineer accept no responsibility for their accuracy.

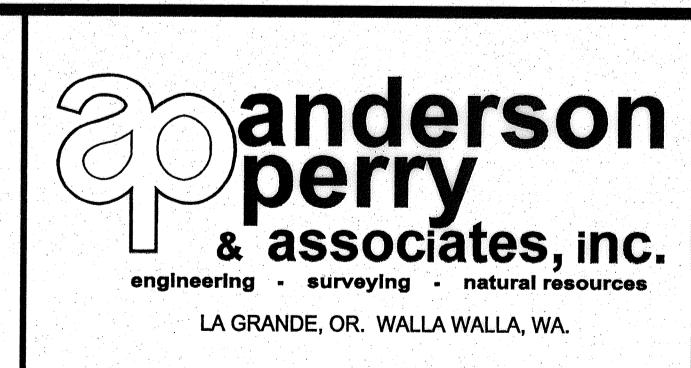

**BENTON IRRIGATION DISTRICT**  
**IRRIGATION SYSTEM IMPROVEMENTS**  
**PHASE 2A**

NORTH - MORGAN TO SUNRISE PIPING  
 STA. 29+00 TO STA. 43+00

SHEET  
**36**