

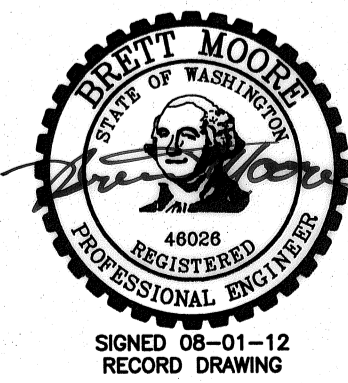


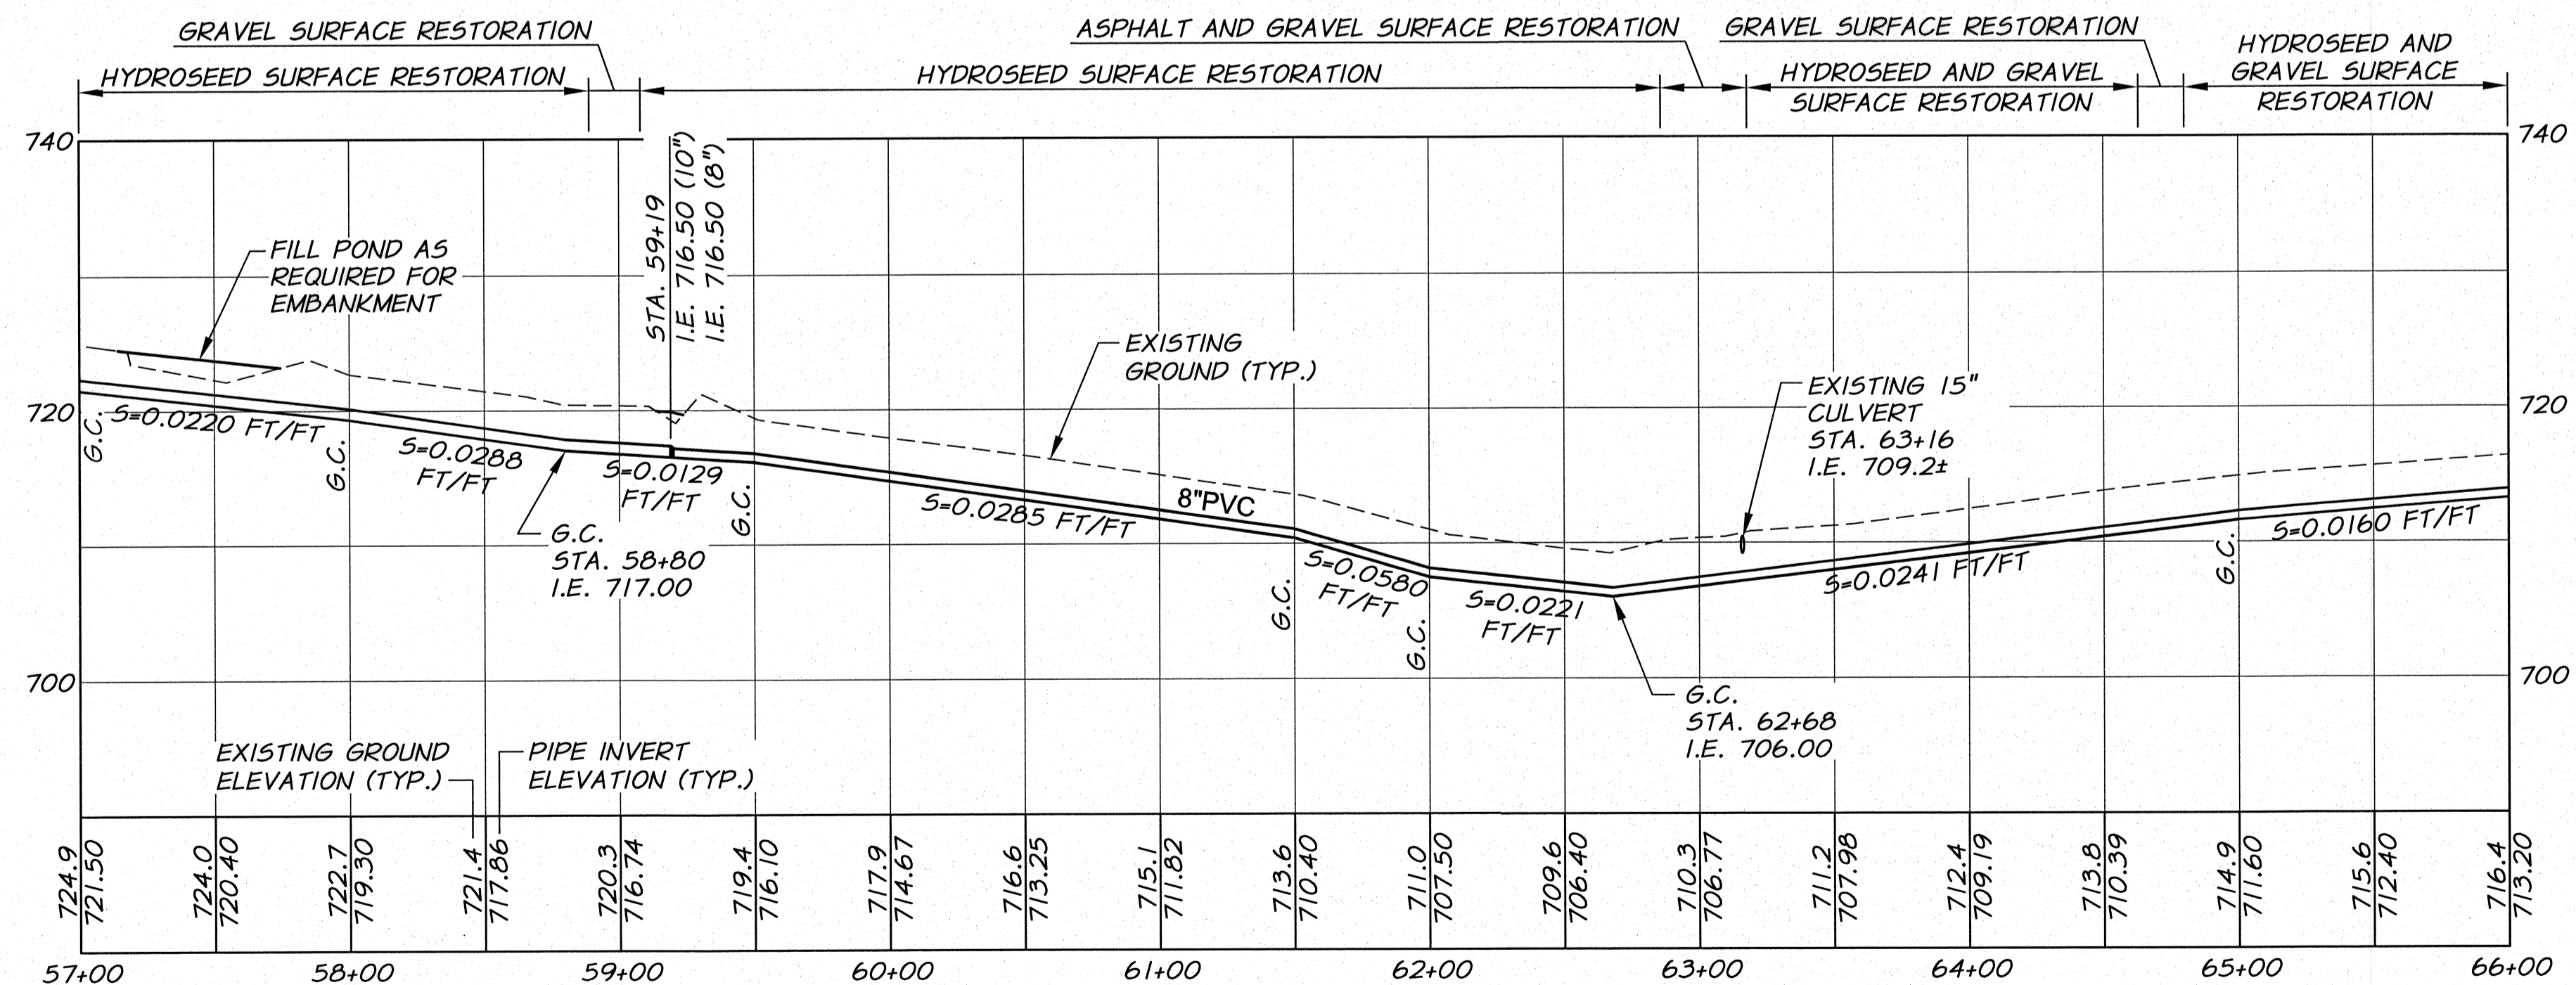

**WORK ITEMS**

- (A) EXISTING IRRIGATION LINE ALONG OR CROSSING ALIGNMENT. EXACT LOCATION UNKNOWN. REMOVE AND PLUG AS REQUIRED FOR NEW LINE INSTALLATION.

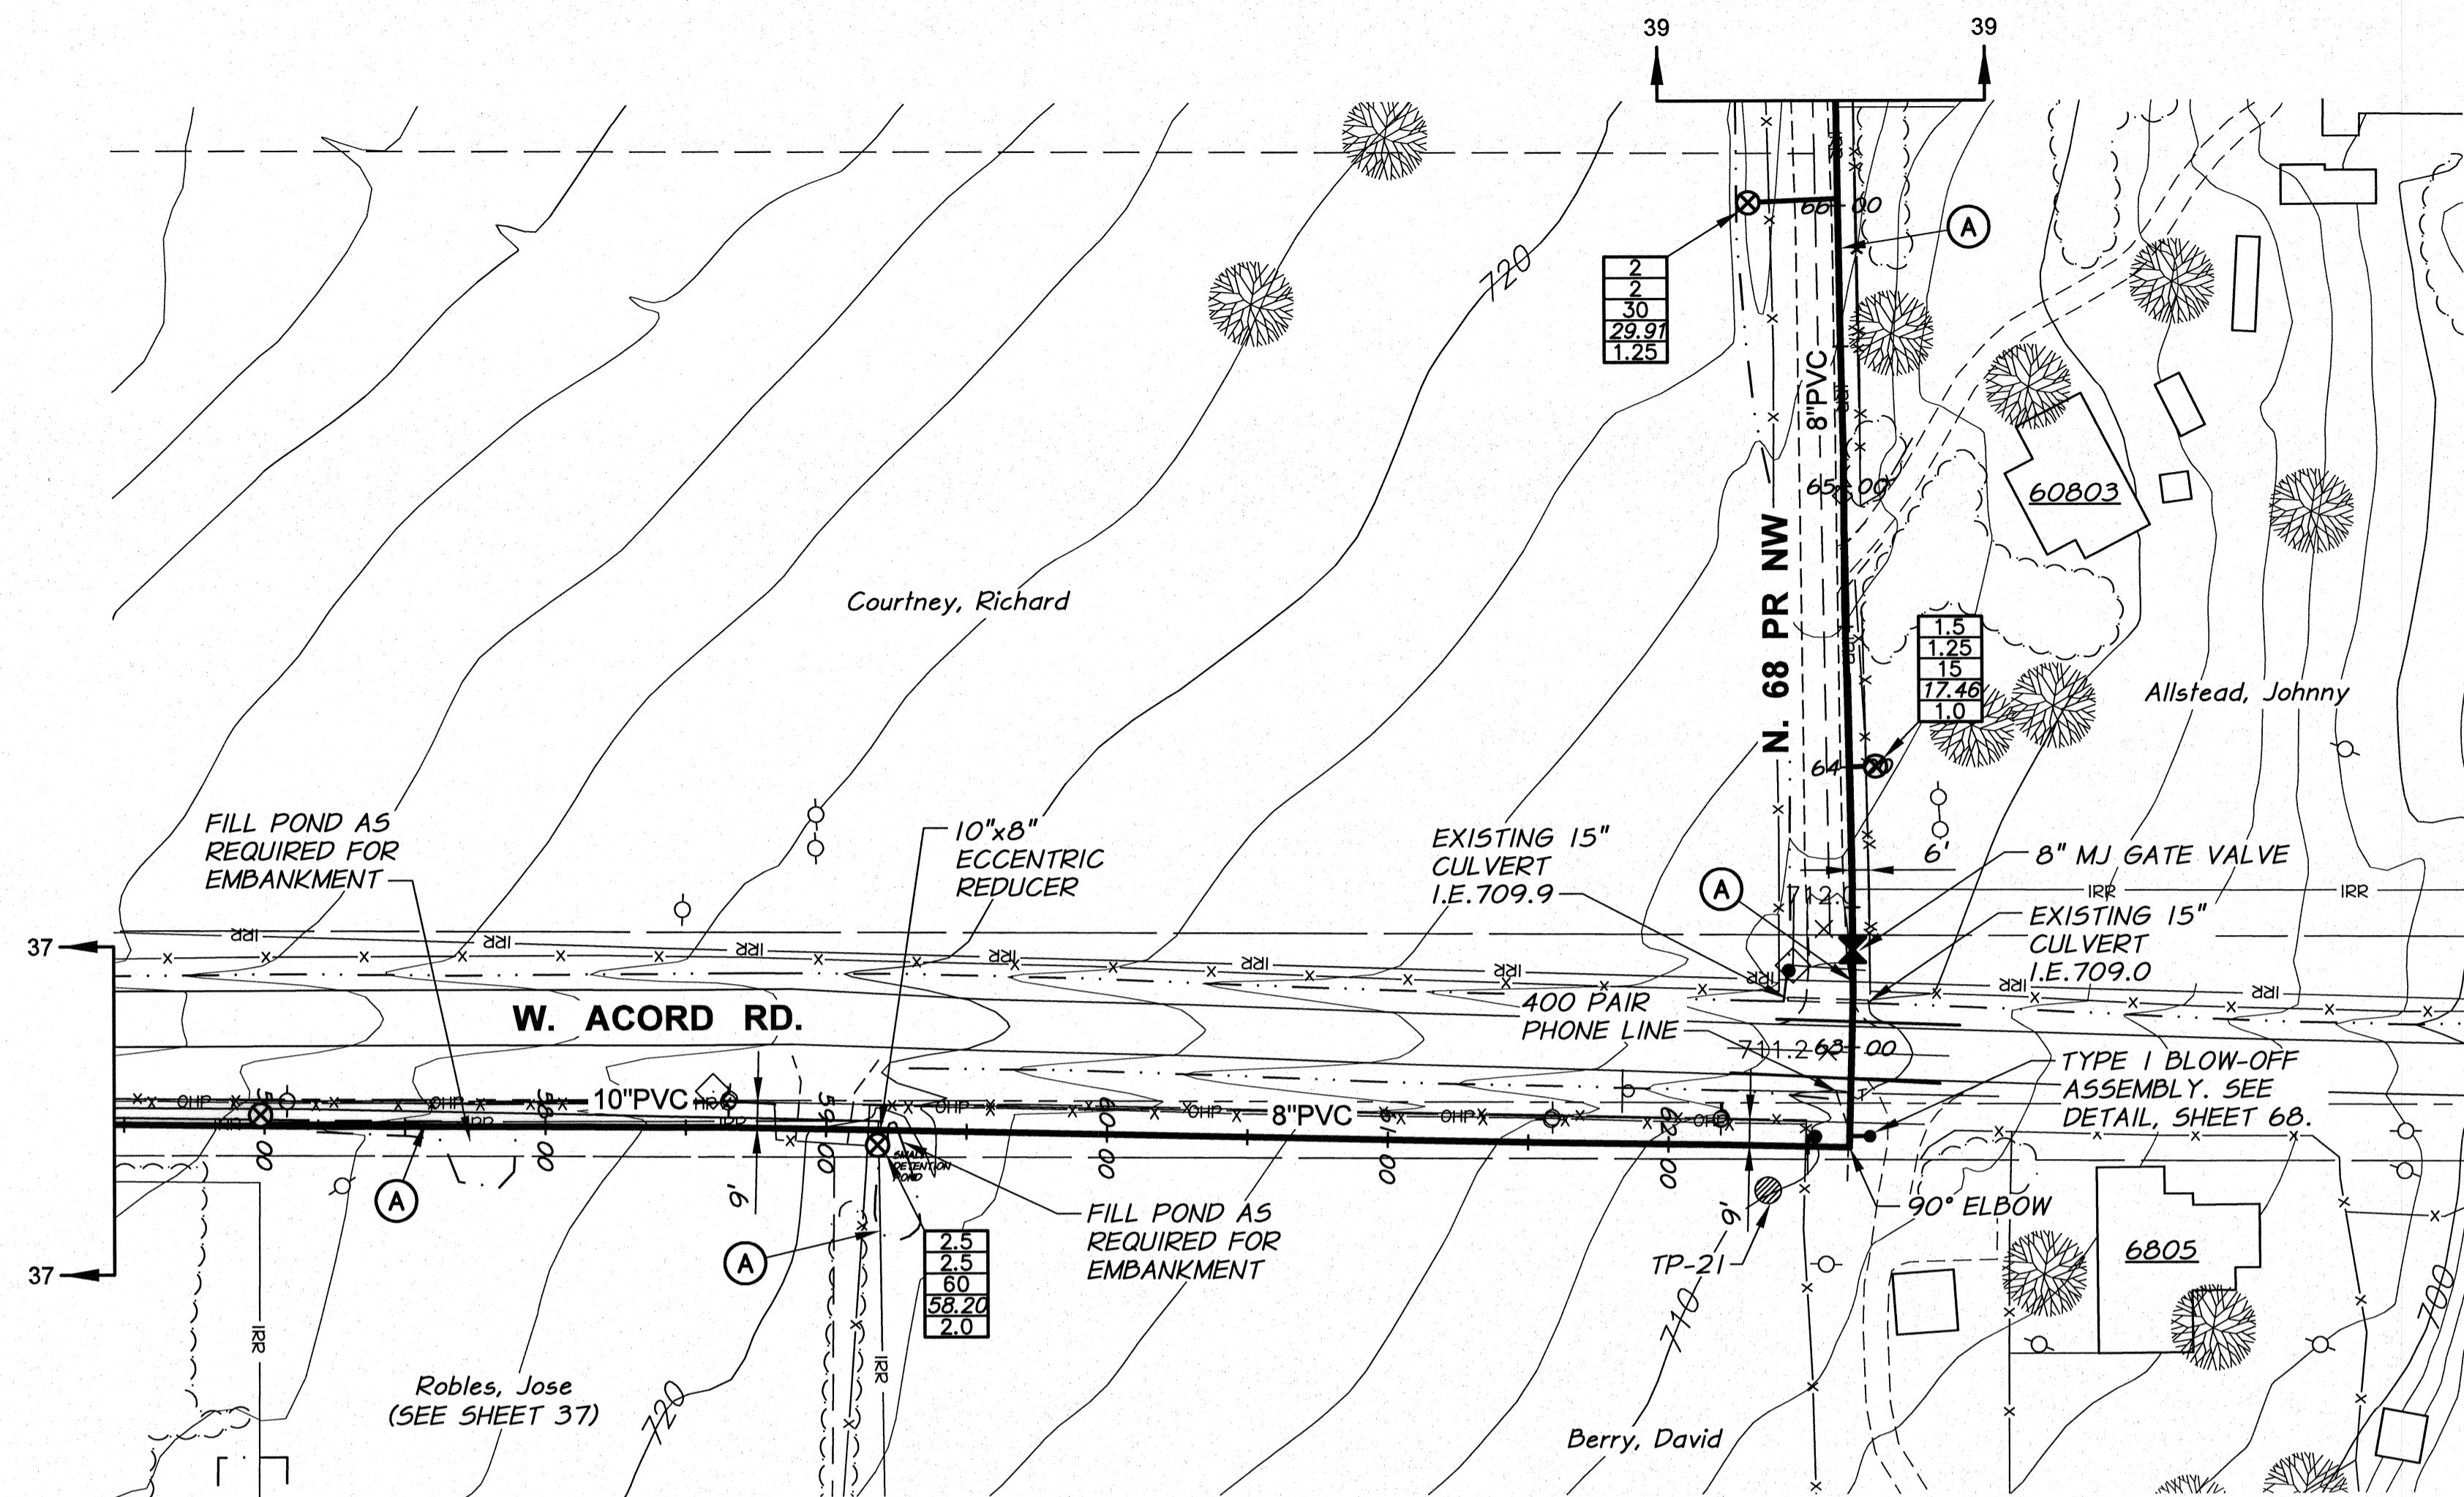


REVISION	BY	DATE	DESIGNED BY	DATE
			R. HARRIS	
			DRAWN BY	DATE
			E. ARNTZ	
			REVIEWED BY	DATE
			J. HOLLOPETER	

HORIZ. SCALE	1" = 50'
VERT. SCALE	1" = 10'
JOB NUMBER	1199-336
DATE	2010
ACAD FILE	North_A.dwg
COPYRIGHT 2010 BY ANDERSON-PERRY & ASSOC., INC.	

**RECORD DRAWINGS**

These record drawings have been prepared, in part, on the basis of information compiled and furnished by others. They may contain some discrepancies and omissions, and do not necessarily represent "exact" field conditions. The Owner and the Engineer accept no responsibility for their accuracy.

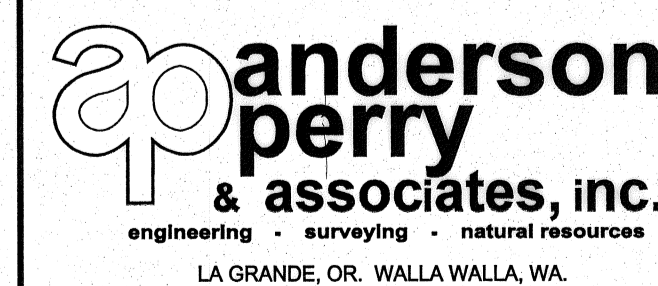

**BENTON IRRIGATION DISTRICT  
IRRIGATION SYSTEM IMPROVEMENTS  
PHASE 2A**

NORTH - MORGAN TO SUNRISE PIPING  
STA. 57+00 TO STA. 66+00

SHEET

**38**

ARCHIVED