

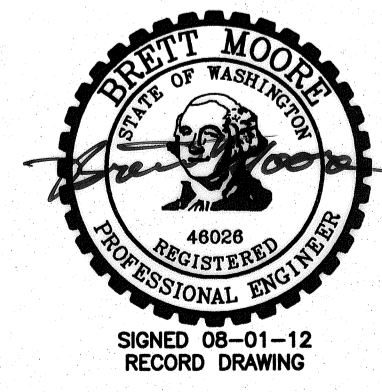


**WORK ITEMS**

(D) REMOVE CONTROL GATE, PIPING, AND CONCRETE STRUCTURE FROM CANAL OUTLET. RESTORE CANAL BANK WITH COMPACTED GENERAL BACKFILL MATERIAL. SHAPE BANK TO MATCH EXISTING. PAID UNDER "IRRIGATION CONTROL STRUCTURE REMOVAL" BID ITEM.

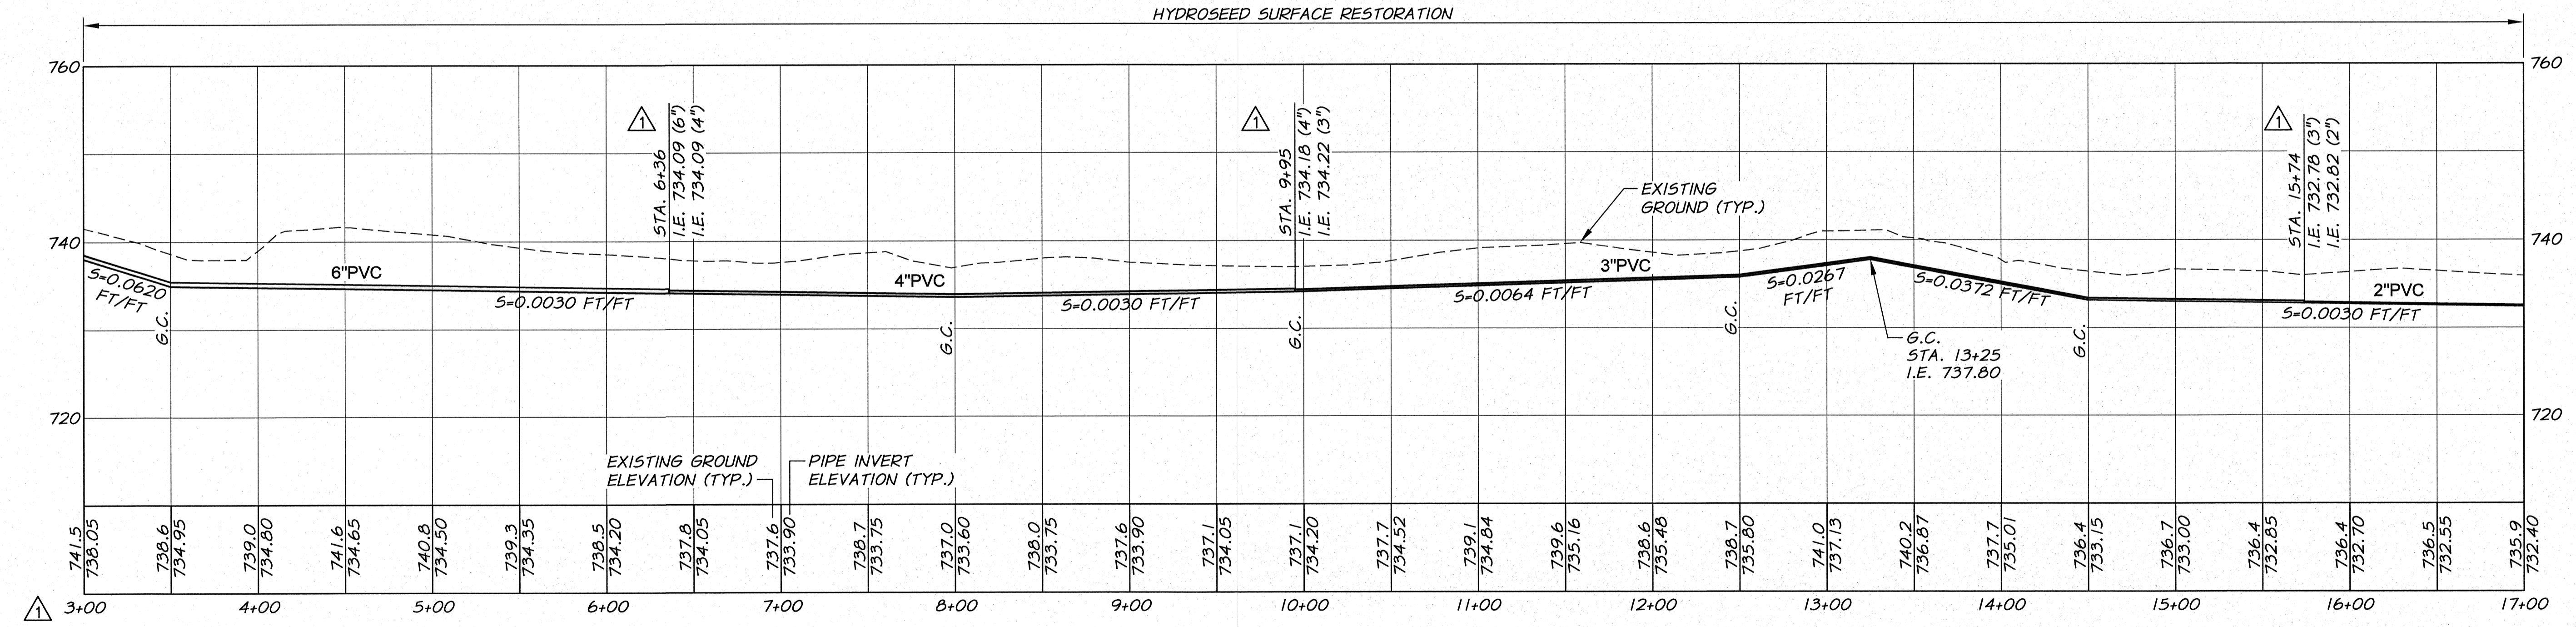


RECORD DRAWING		E.H.	4/12
ADDENDUM NO. 1		R.H.	9/10
DESIGNED BY	R. HARRIS	DATE	
DRAWN BY	E. ARNTZ	JOB NUMBER	1199-336
REVIEWED BY	J. HOLLOPETER	DATE	2010
XREFS: TB-BID.dwg		ACAD FILE	North_B.dwg

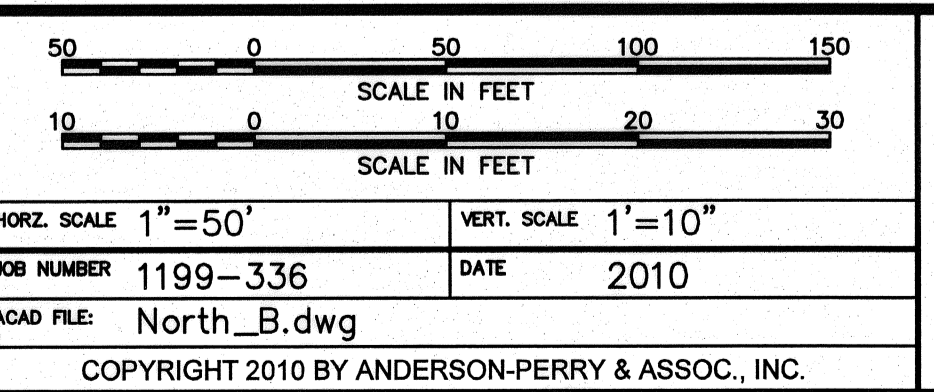

**RECORD DRAWINGS**

These record drawings have been prepared, in part, on the basis of information compiled and furnished by others. They may contain some discrepancies and omissions, and do not necessarily represent "exact" field conditions. The Owner and the Engineer accept no responsibility for their accuracy.

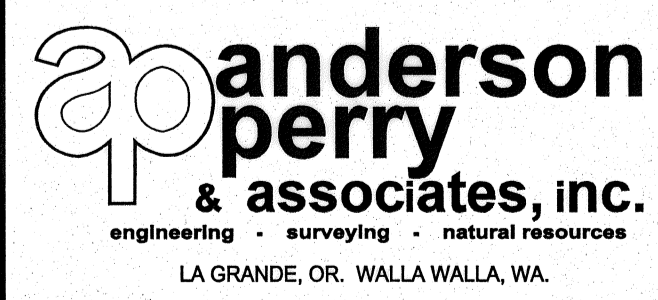

**BENTON IRRIGATION DISTRICT**  
 IRRIGATION SYSTEM IMPROVEMENTS  
 PHASE 2A

NORTH - MORGAN TO SUNRISE PIPING  
 STA. 3+00 TO STA. 17+00

SHEET  
**43**